


MONUMENTATION MAP FOR
LEWIS HOMES - SMOKE RANCH ESTATES
CUT NO. 3 DUPLEXES
A PORTION OF THE SW 1/4 OF THE SW 1/4 OF SECTION 13,
T20S, R30E, M.D.M. CITY OF LAS VEGAS, STATE OF NEVADA

SCALE 1" = 50'

LEWIS HOMES -
SMOKE RANCH EST. NO. 1
BK. PG.

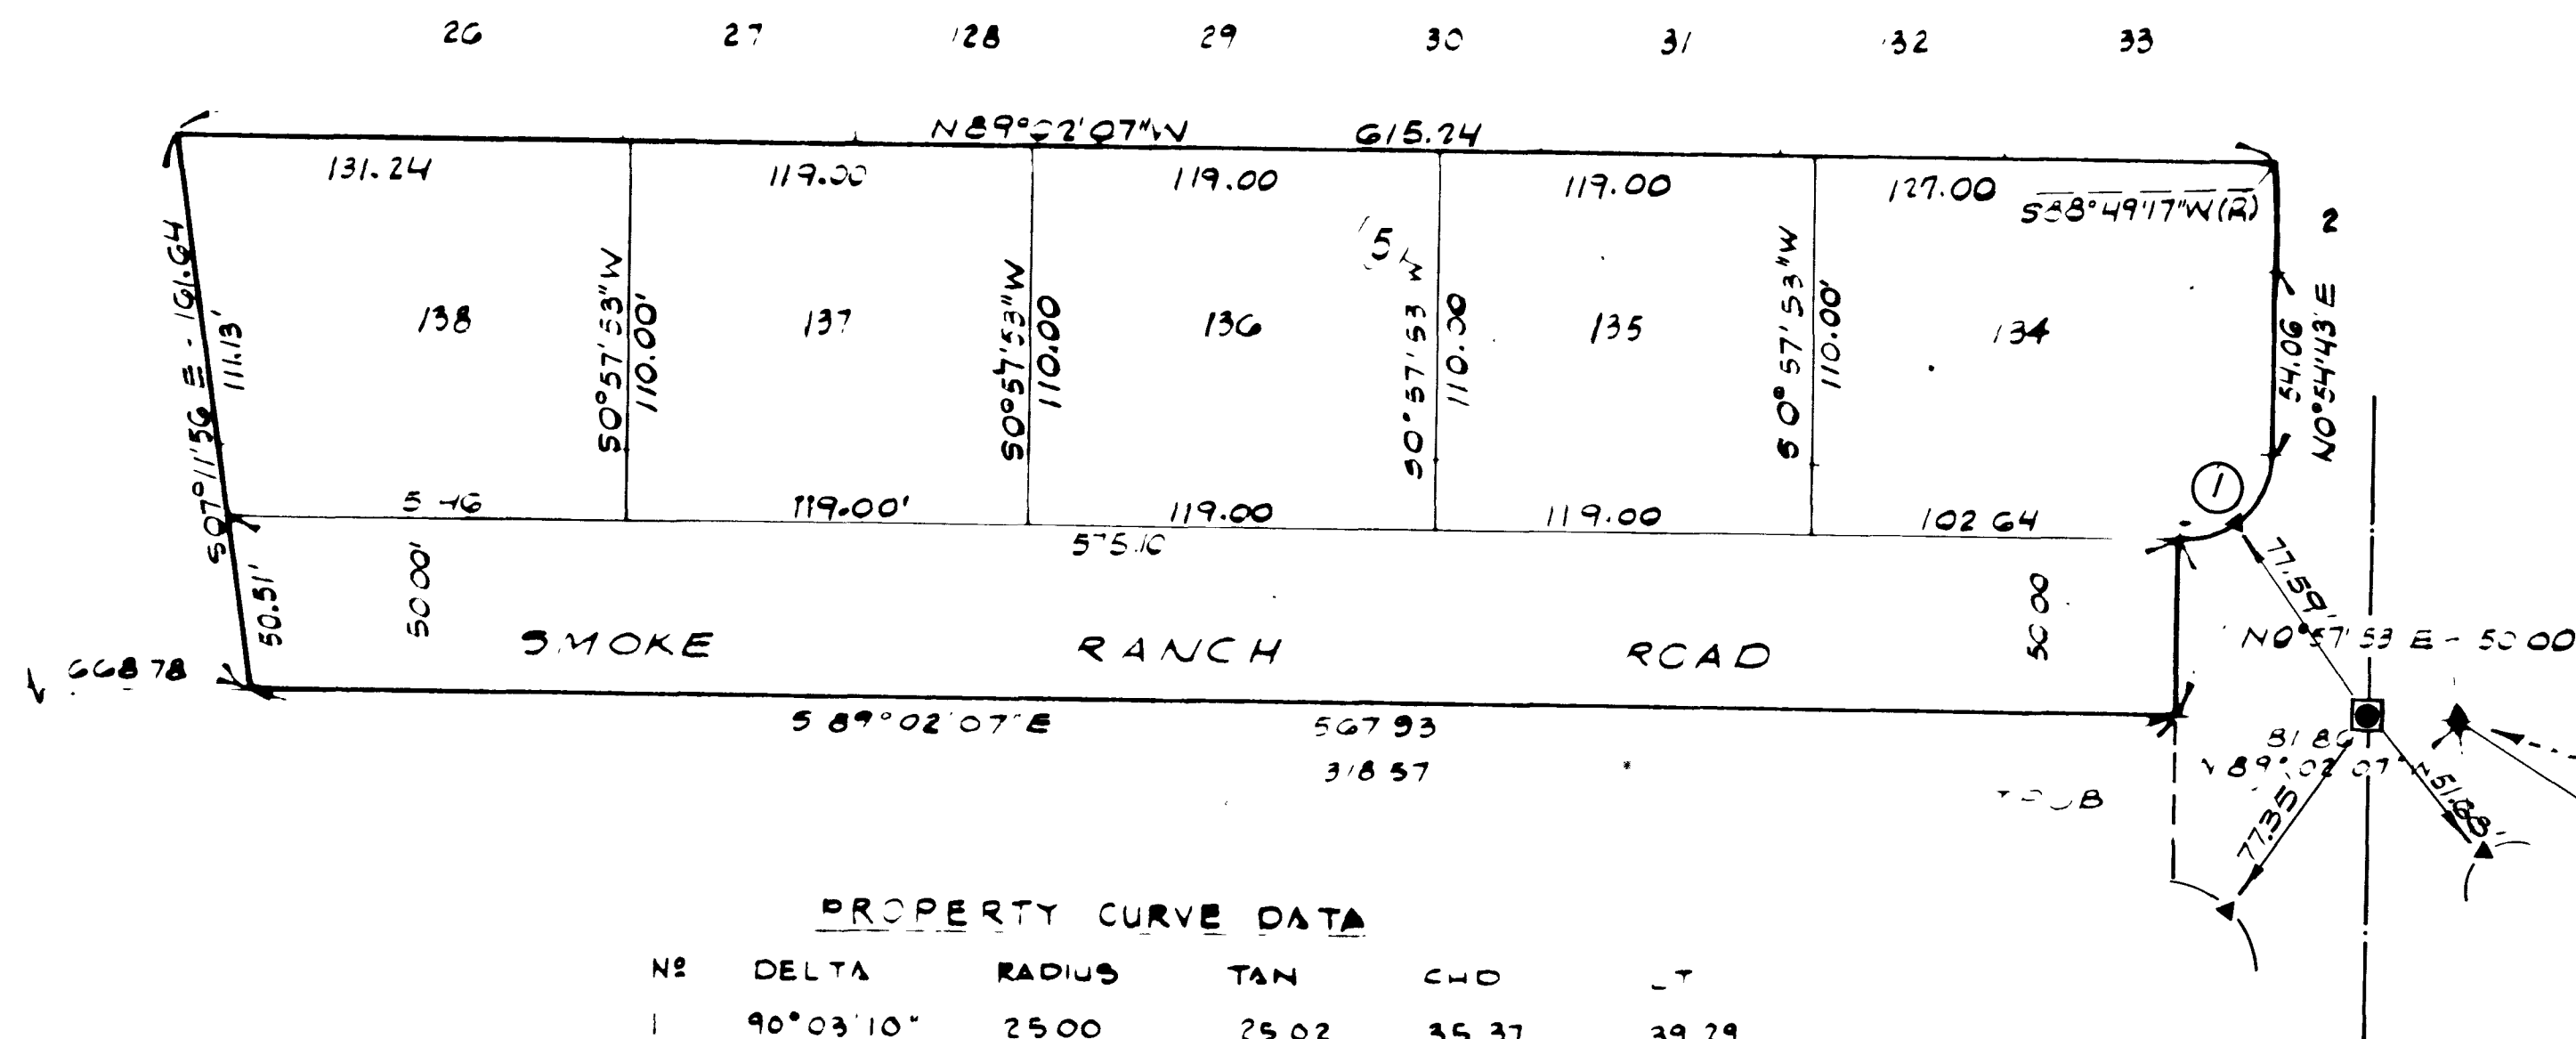

LEGEND FOR MONUMENT TIES

- ▲ BRASS CAP TIES IN TOP OF CURB
- 5/8" REBAR W/AL CAP.
- SET CONC. MON. & BRASS CAP.

NOTE:

1. ALL FRONT E'S ARE SAWCUT IN TOP OF CURB.

SURVEYOR'S CERTIFICATE

THIS IS TO CERTIFY THAT THE MONUMENT HAS BEEN SET AND TIES ESTABLISHED AS SHOWN HEREON.

William T. Cuddy 8-29-78
WILLIAM T. CUDDY DATE
R.L.S. NO. 2897

W/16 COR
NO. CONC MON &
5/8" CAP W/ RLS # 2897
PER L.H. SMOKE RANCH
EST. NO. 1

CHARLESTON HEIGHTS UNIT NO. 50-E
BOOK 14 PAGE 70

FD CLY. SIC NO. 2324
FLUBA N. AC

ALVD. JONES

PROPERTY CURVE DATA

NO	DELTA	RADIUS	TAN	CHD	LT
1	90°03'10"	25.00	25.02	35.37	39.29
2	02°05'26"	847.72	5.47	30.93	30.93

LEGEND


- ▲ POINTS FOUND AS SHOWN
- 34 LOT NO.
- 3 BLOCK NO.
- 1 CURVE DATA NO.

NOTES

1. SETBACK LINE - 20' FRONT YARD & 5' SIDEYARD ABUTTING ALL RW LINES
2. 5' UTILITY EASEMENT IN BACK OF AND ABUTTING ALL RW LINES
3. ALL LOTS HAVE A 3' UTILITY EASEMENT ALONG EACH SIDE OF EACH SIDE LOT LINE NOT ABUTTING RW

MONUMENTATION MAP FOR
LEWIS HOMES - SMOKE RANCH ESTATES


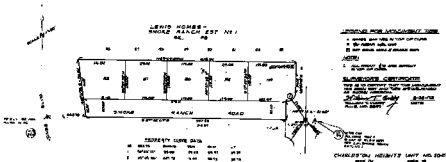







