


LEWIS HOMES ~ MEADOW VISTA ~ UNIT NO. 3

MONUMENT TIE MHP
ALL TIE POINTS ARE LEAD AND
BRASS NAIL IN TOP OF CURB
SHEET 1 OF 1

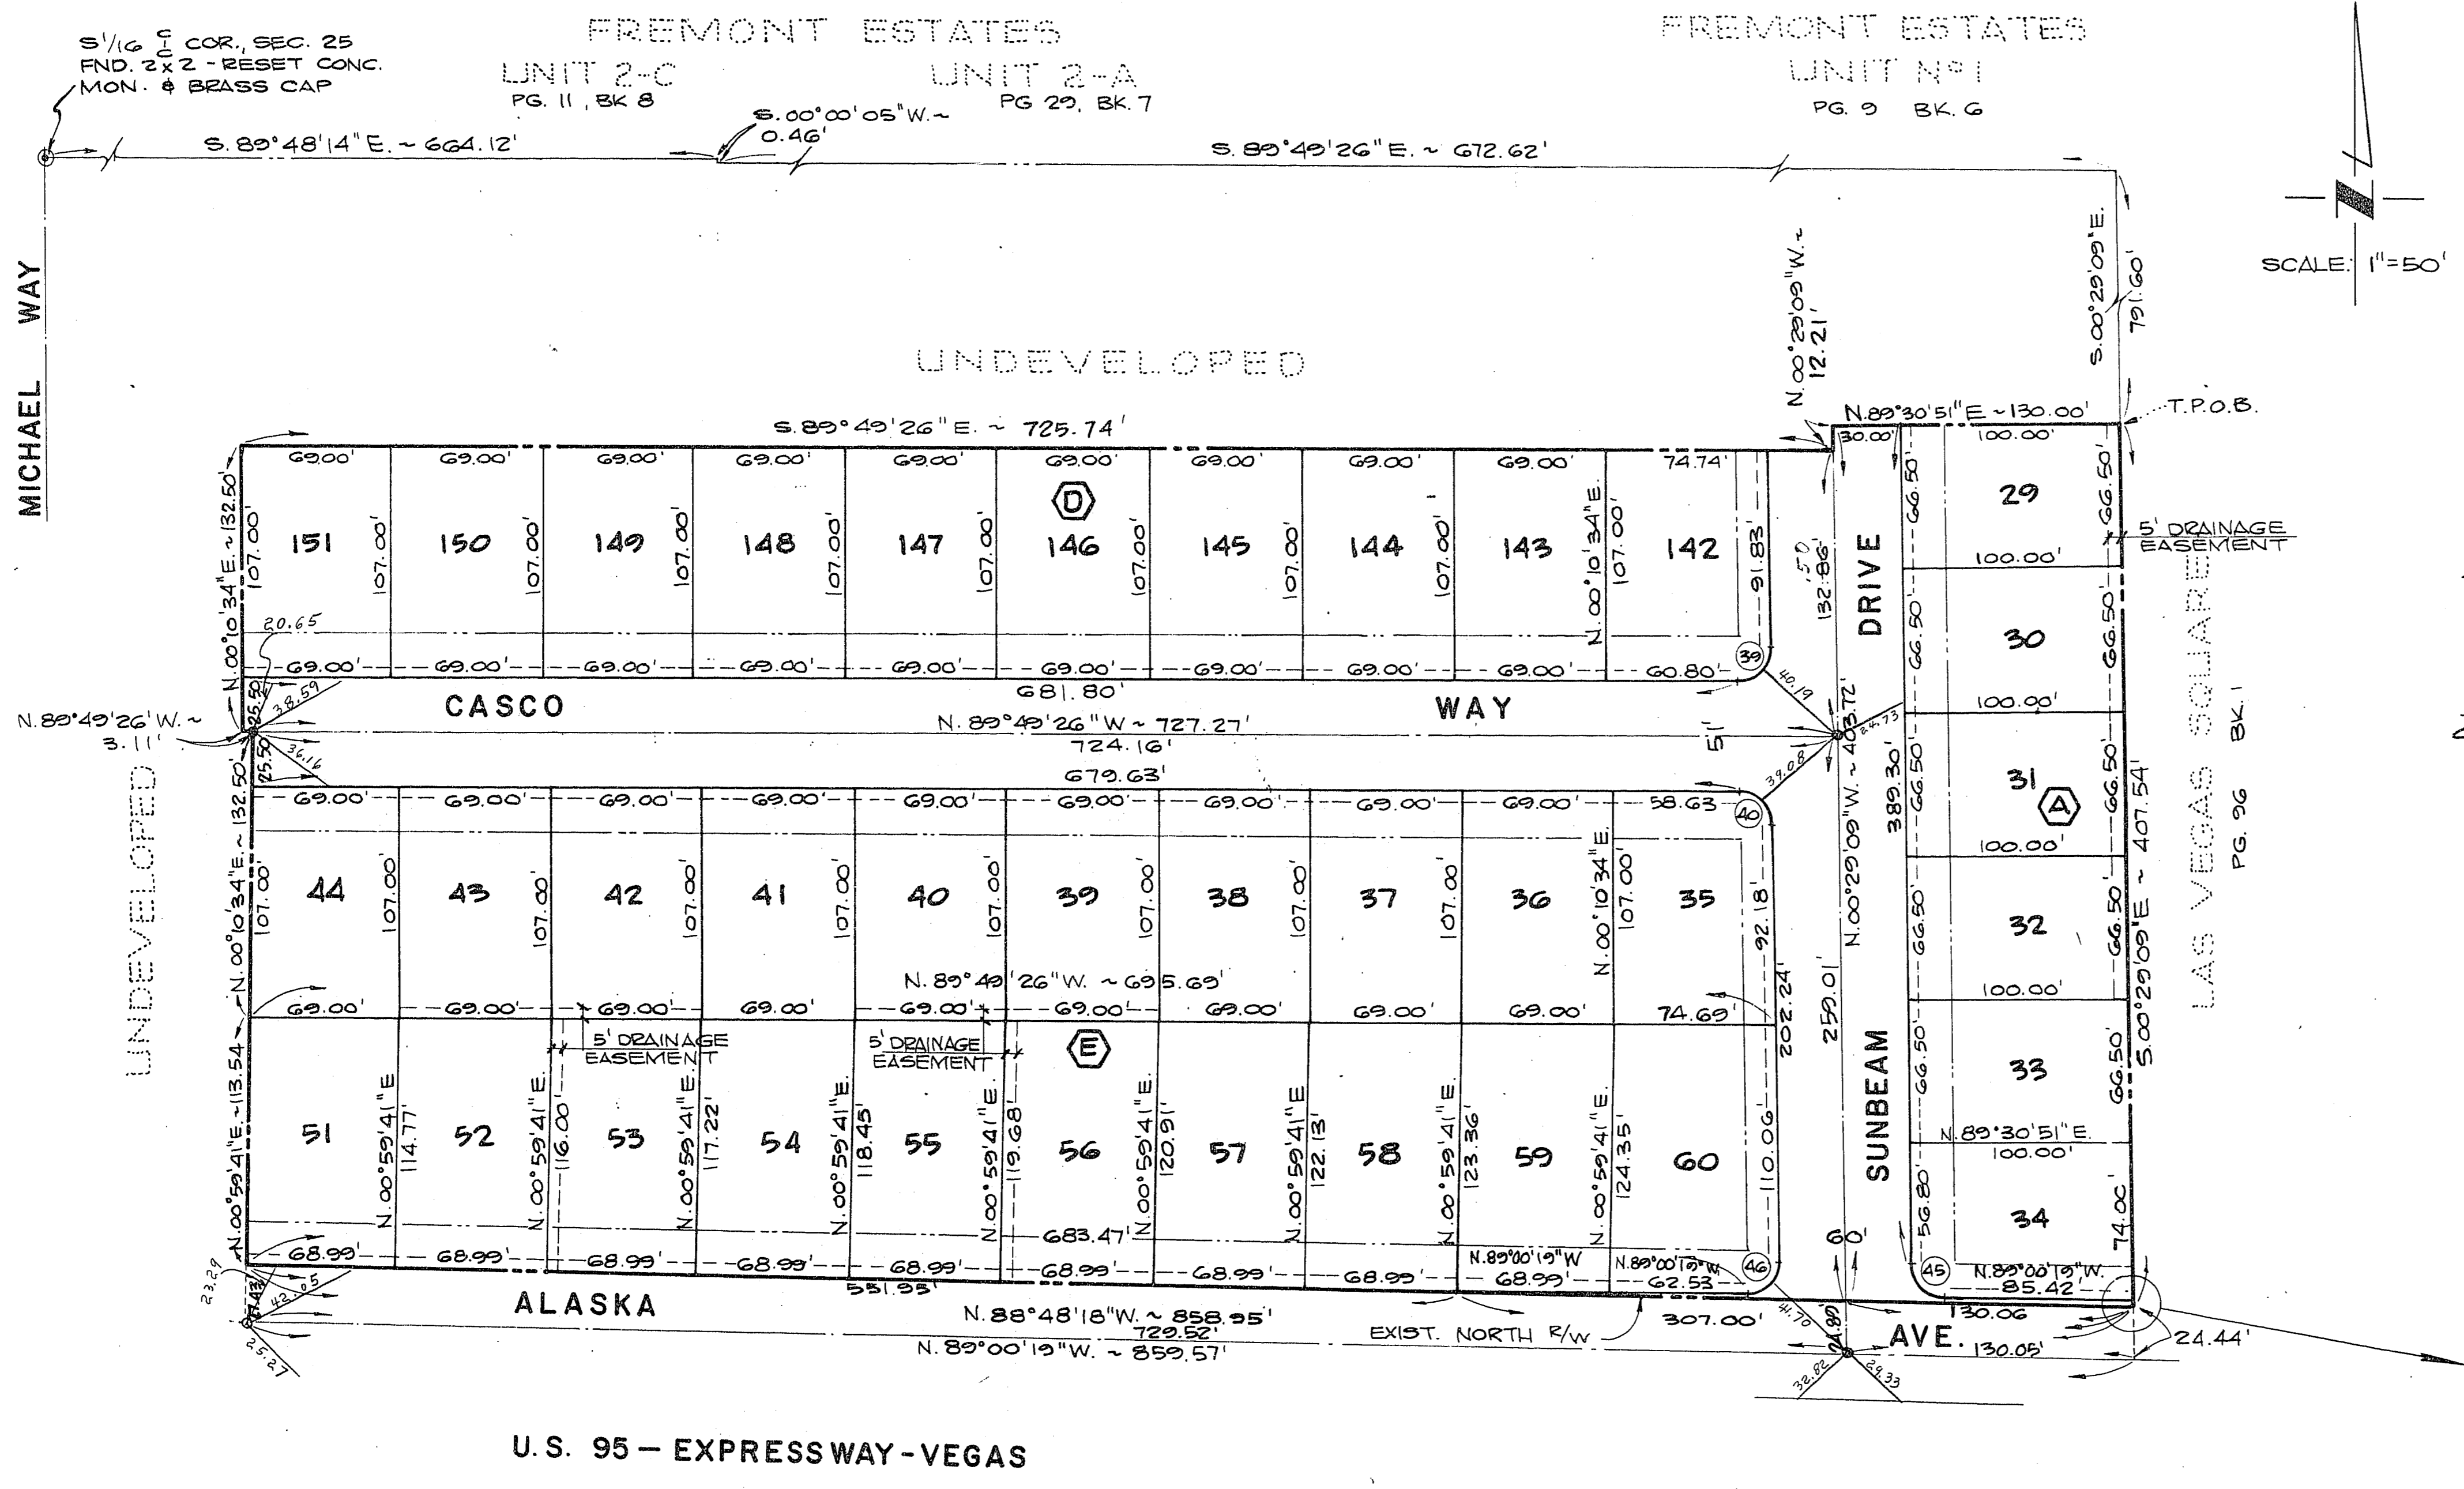

CURVE DATA

NO	Δ	R	L	T
39	90°39'43"	15.00	23.74	15.17
40	89°20'17"	15.00	23.39	14.83
45	88°31'10"	15.00	23.17	14.62
46	91°28'50"	15.00	23.95	15.39

SURVEYOR'S CERTIFICATE
THIS IS TO CERTIFY THAT THE MONUMENTS
HAVE BEEN SET AND TIES ESTABLISHED
AS SHOWN HEREON.

Kay L. Adams 3/27/80
KAY L. ADAMS R.L.S., NEV. CERT. NO. 2050

BASIS OF BEARING

N. 00°07'06" W. BEING THE BEARING OF THE WEST LINE OF THE SE 1/4 OF SECTION 25, T. 20 S., R. 60 E., M.D.M., CLARK COUNTY, NEVADA AS SHOWN BY A PLAT ON FILE IN THE CLARK COUNTY, NEVADA RECORDER'S OFFICE AS PAGE 11, BOOK 8 OF PLATS.

LEGEND

- ⓔ BLOCK NUMBER
- ⓐ CURVE NUMBER
- 39 LOT NUMBER
- UNIT BOUNDARY
- 5' UTILITY EASEMENT
- SETBACK:
FRONT YARD - 20' MIN.
SIDE YARD CORNER - 15' MIN.
- ⊙ MONUMENT FND. AS SHOWN
- SET STD. CONC. MONUMENT
- SET 3/8" REBAR & AL. CAP

56-108
058-2029-3