
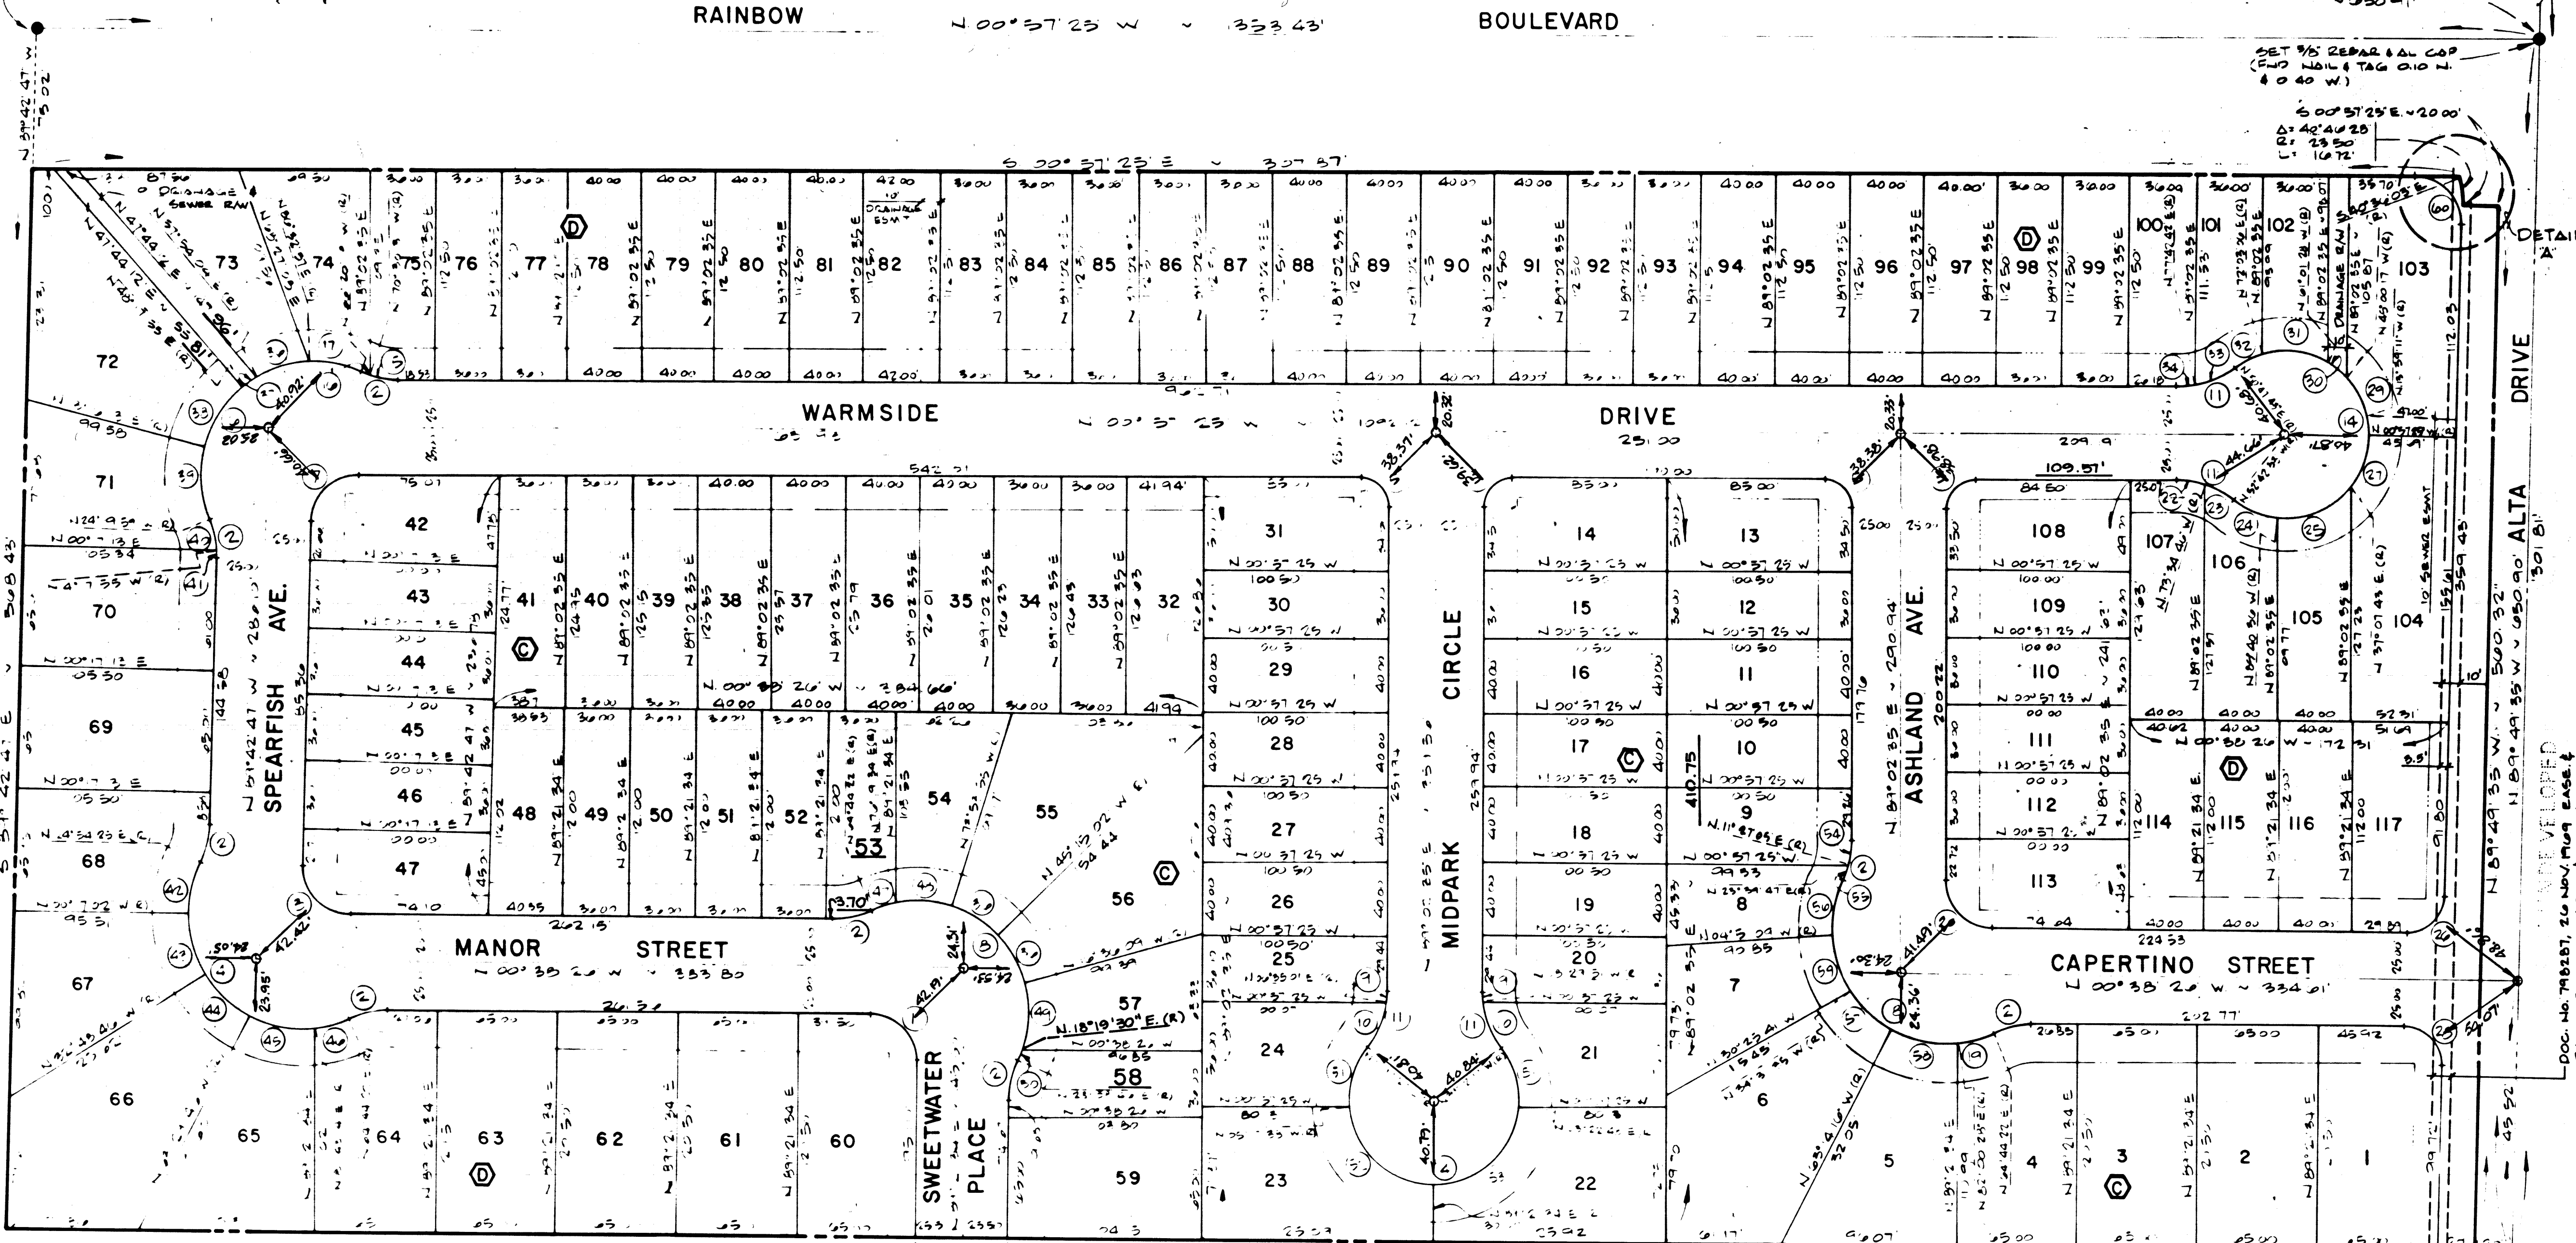


LEWIS HOMES - STONEGATE NO. 3

A PORTION OF THE SE 1/4 OF THE NE 1/4 OF SECTION 34, T. 20S., R. 60E., M.D.M.,
CITY OF LAS VEGAS, CLARK COUNTY, NEVADA

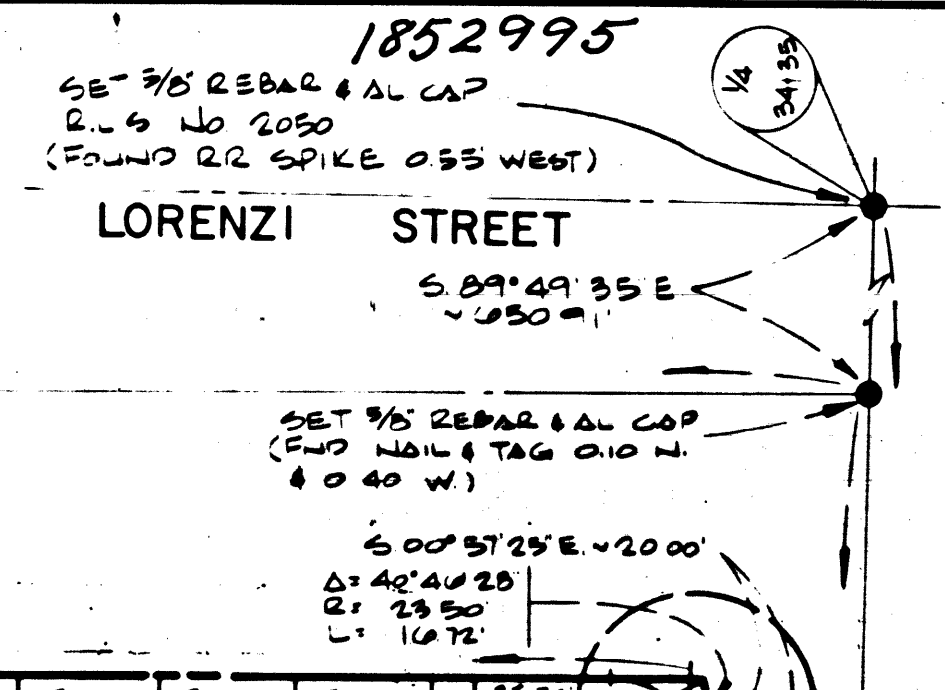

CURVE DATA


NO.	Δ	R	L	T
1	90° 00' 00"	25.50	40.00	25.50
2	24° 31' 12"	50.00	21.49	10.91
3	90° 55' 39"	25.50	40.41	25.92
4	140° 10' 03"	60.00	146.78	165.60
5	90° 00' 00"	15.50	24.35	15.50
6	137° 59' 42"	60.00	144.51	156.29
7	88° 45' 22"	25.50	39.50	24.95
8	139° 14' 24"	60.00	145.81	161.51
9	07° 32' 26"	50.00	6.58	3.30
10	30° 42' 26"	50.00	26.86	13.73
11	38° 14' 52"	50.00	33.38	17.34
14	256° 29' 44"	45.50	203.61	~
15	20° 26' 54"	50.00	17.84	9.02
16	04° 10' 18"	50.00	3.64	1.82
17	27° 06' 30"	60.00	28.39	14.47
18	138° 55' 25"	60.00	145.48	160.15
19	17° 16' 06"	60.00	8.78	4.11
20	89° 41' 11"	25.50	39.91	25.36
60	91° 07' 50"	25.00	39.76	25.50

CURVE DATA

NO.	Δ	R	L	T
22	17° 22' 39"	50.00	15.16	7.64
23	20° 52' 13"	50.00	18.21	9.21
24	32° 58' 05"	45.50	26.18	13.46
25	57° 11' 41"	45.50	45.42	24.80
26	89° 11' 09"	20.50	31.91	20.21
27	38° 05' 08"	45.50	30.25	15.71
28	90° 48' 51"	20.50	32.49	20.79
29	44° 02' 52"	45.50	34.98	18.41
30	16° 01' 11"	45.50	12.72	6.40
31	46° 55' 26"	45.50	37.26	19.75
32	21° 15' 23"	45.50	16.88	8.54
33	26° 34' 59"	50.00	23.49	11.97
34	11° 19' 53"	50.00	9.89	4.96
35	91° 07' 50"	25.00	39.76	25.50
36	28° 38' 53"	60.00	30.00	15.32
37	09° 36' 09"	60.00	10.06	5.04
38	35° 01' 42"	60.00	36.68	18.93
39	37° 36' 12"	60.00	39.38	20.43
59	79° 40' 26"	60.00	31.07	15.89



CURVE DATA

NO.	Δ	R	L	T
40	20° 02' 04"	50.00	17.48	8.83
41	04° 35' 08"	50.00	4.00	2.00
42	25° 11' 27"	60.00	26.38	13.41
43	32° 31' 44"	60.00	34.06	17.56
44	36° 41' 09"	60.00	32.15	16.46
45	34° 42' 00"	60.00	36.34	18.75
46	17° 03' 52"	60.00	17.81	9.00
47	11° 35' 27"	60.00	12.13	6.09
48	29° 46' 31"	60.00	31.18	15.95
49	34° 55' 39"	60.00	36.58	18.88
50	05° 39' 16"	60.00	5.92	2.96
51	42° 55' 05"	45.50	33.82	17.73
52	85° 20' 48"	45.50	67.78	41.95
53	85° 58' 46"	45.50	68.28	42.41
54	12° 24' 30"	50.00	10.83	5.44
55	12° 12' 42"	50.00	10.66	5.35
56	28° 30' 56"	60.00	29.86	15.25
57	28° 42' 41"	60.00	30.07	15.36
58	34° 45' 16"	60.00	36.39	18.78

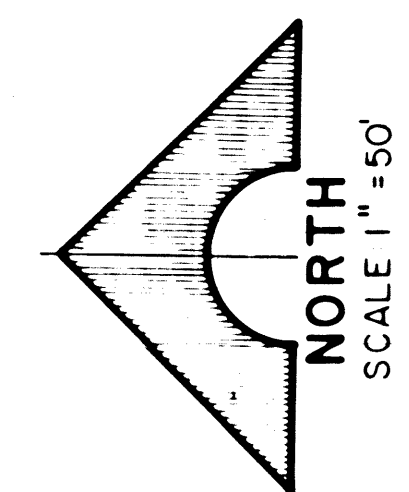

SURVEYOR'S CERTIFICATE
THIS IS TO CERTIFY THAT THE MONUMENTS HAVE BEEN SET AND TIES ESTABLISHED AS SHOWN HEREON.

Kay Adams
KAY ADAMS
REGISTERED LAND SURVEYOR
NEVADA CERTIFICATE NO. 2050

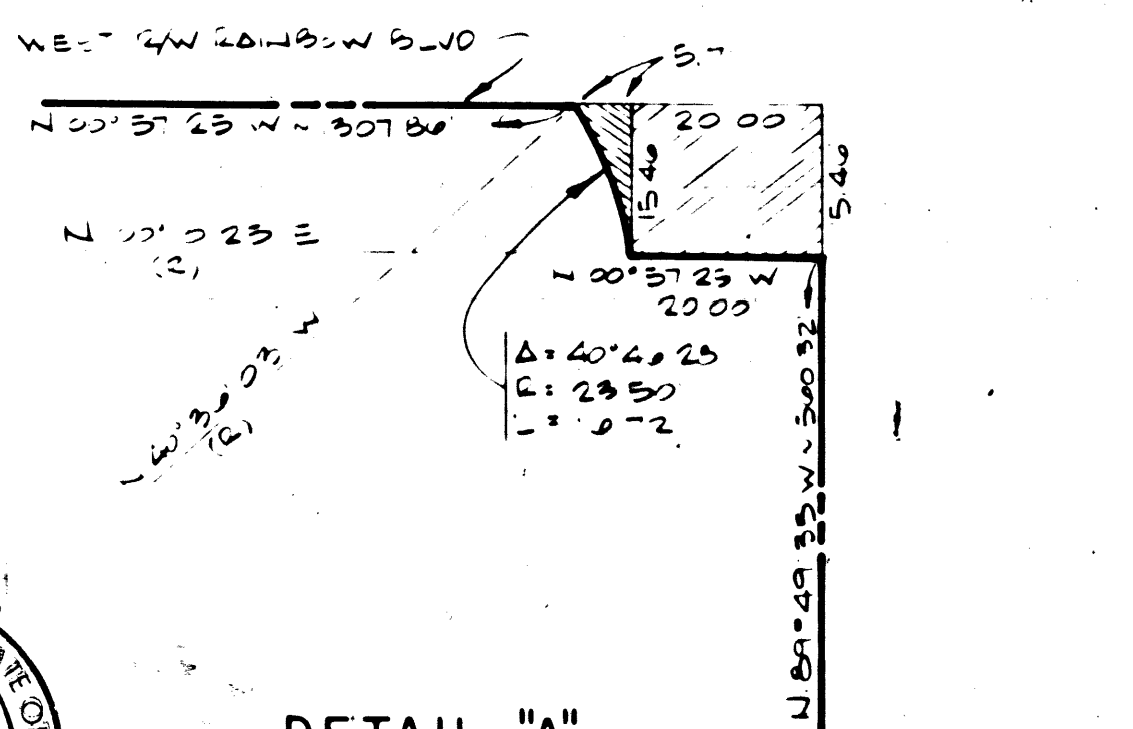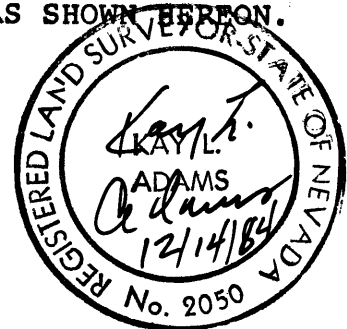

MONUMENT TIE MAP