
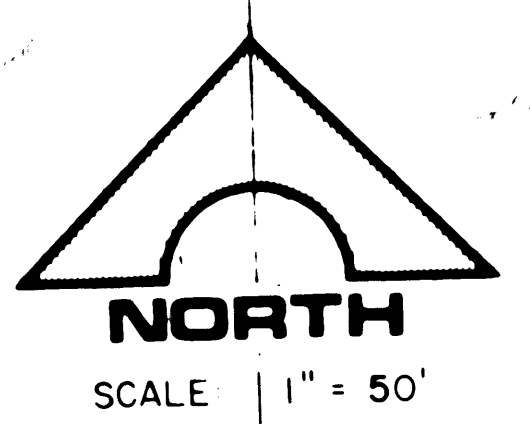


LEWIS HOMES - RAINBOW VISTA NO. - I

BEING A PORTION OF THE (NE 1/4) OF SECTION 26, T. 20 S. R. 60 E. M.D.M.
CITY OF LAS VEGAS, CLARK COUNTY, NEVADA

1776970

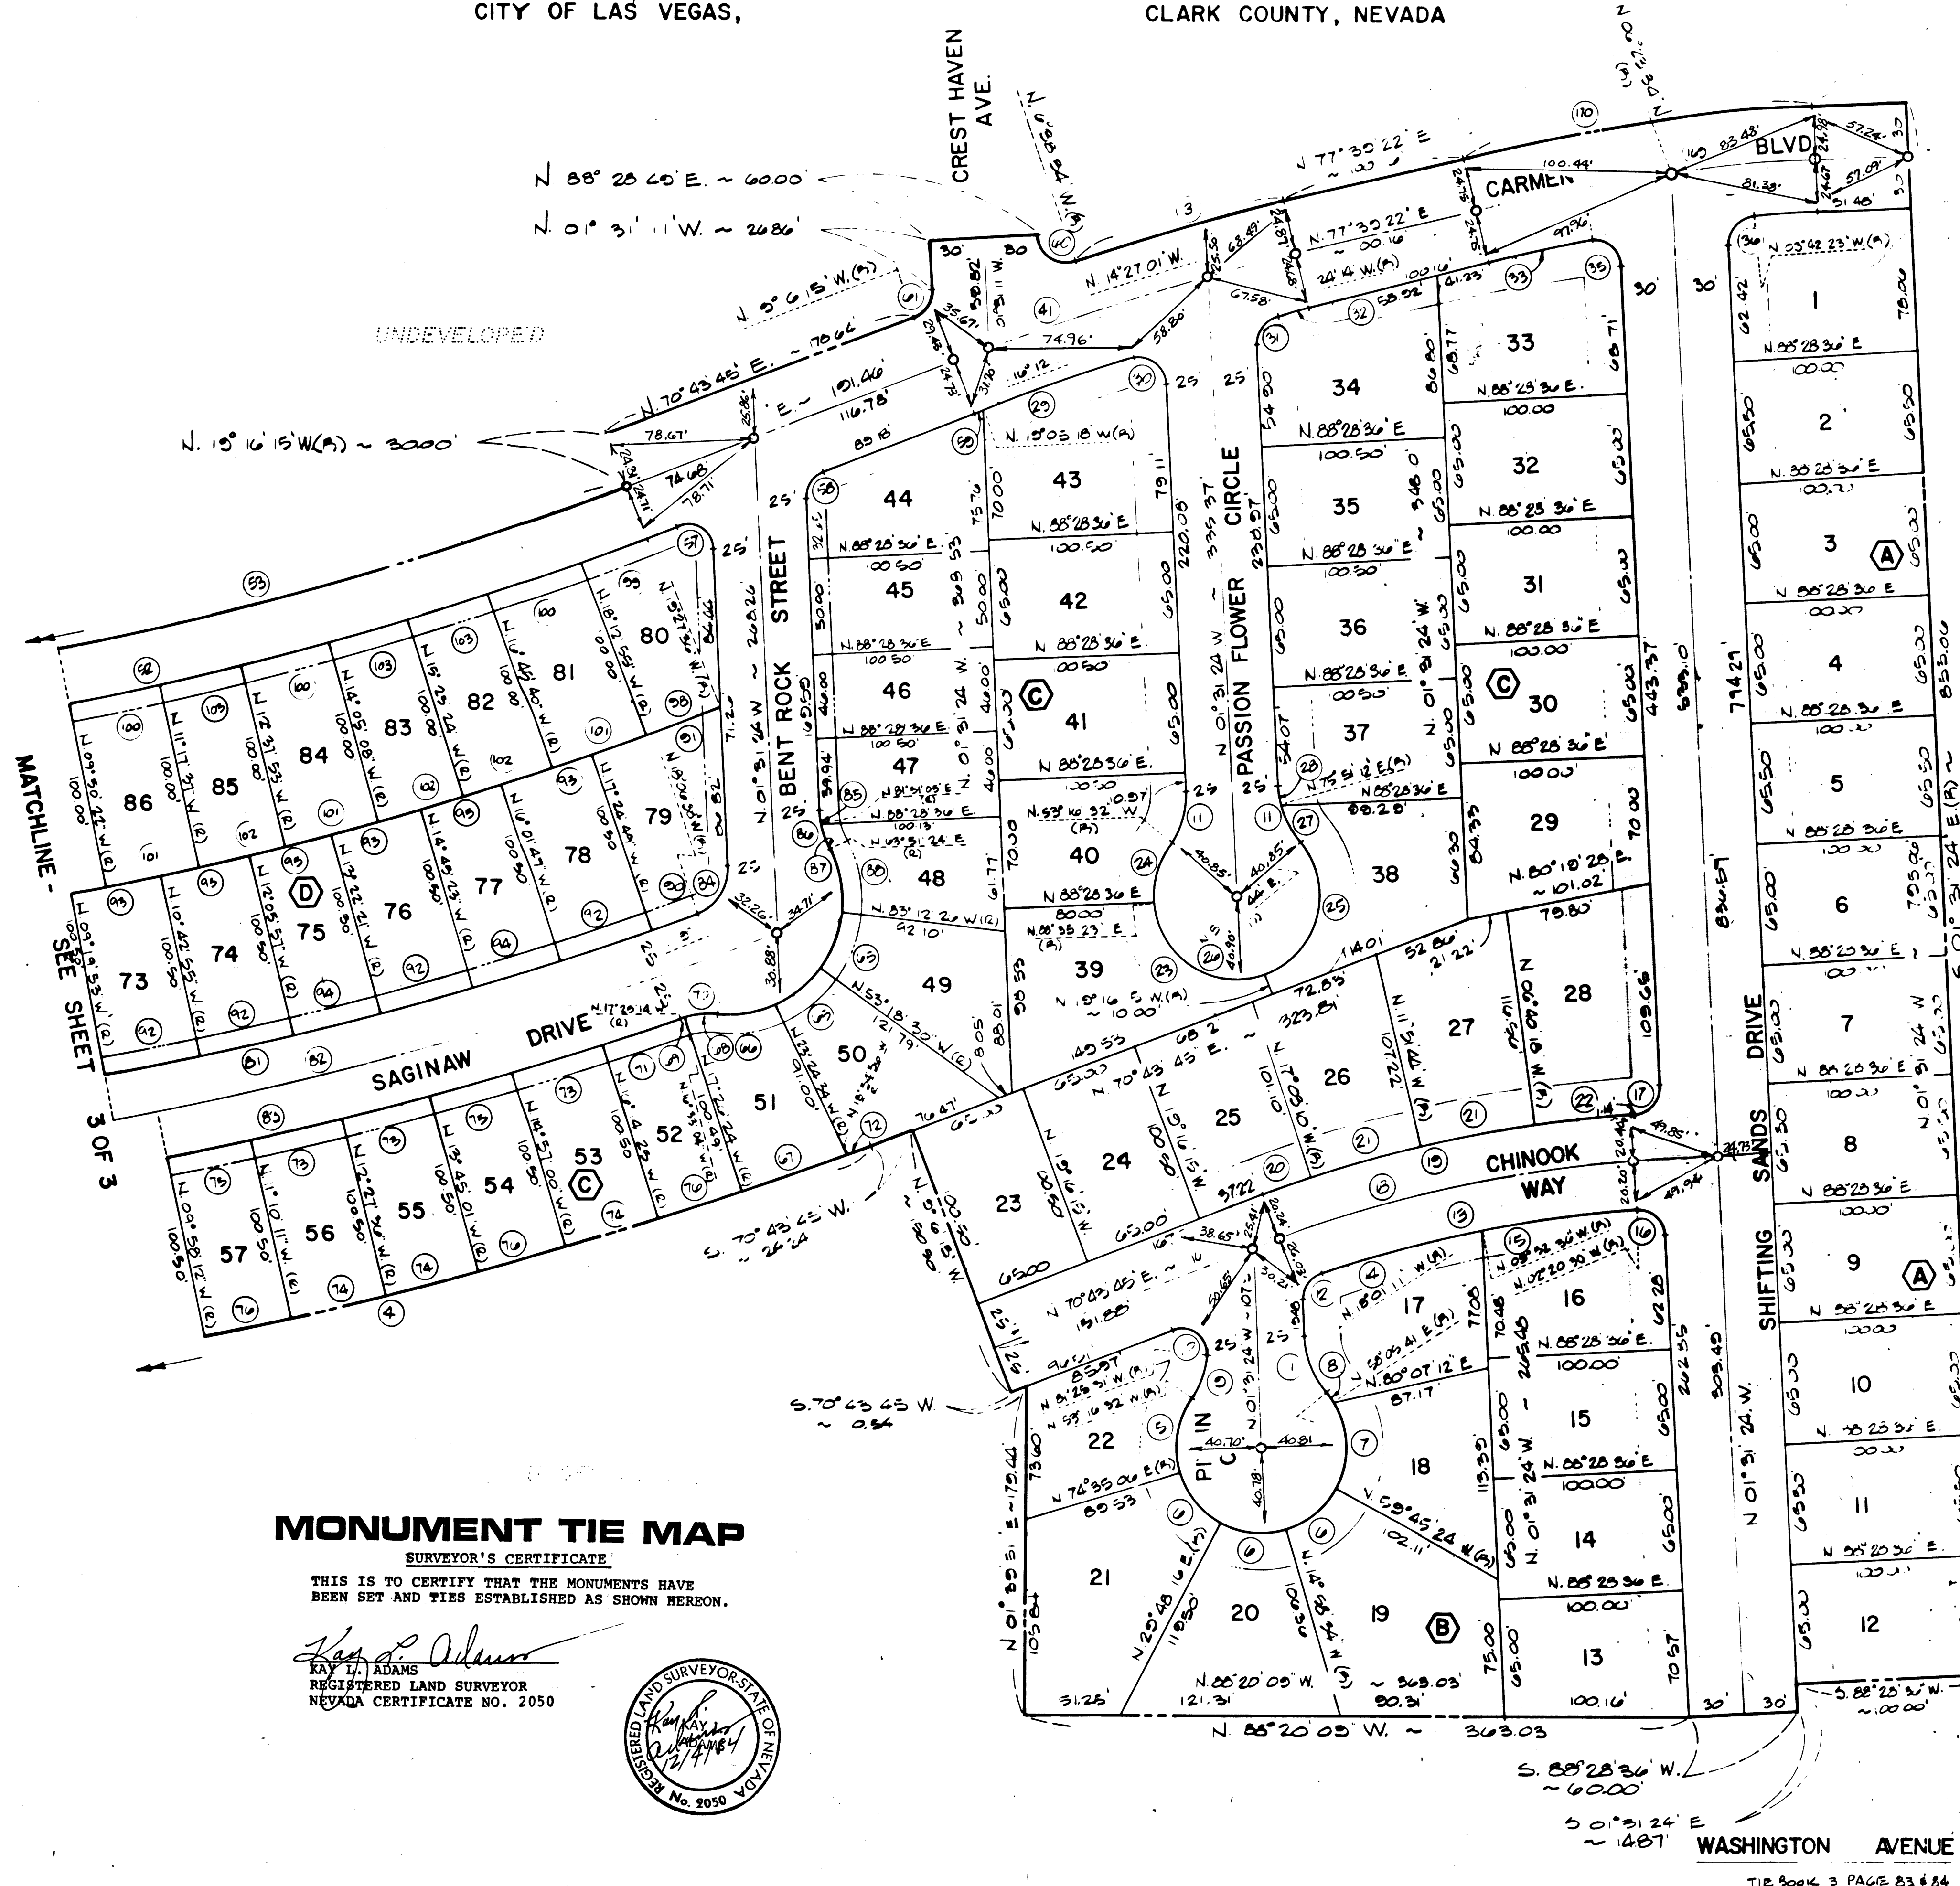


MONUMENT TIE MAP

SURVEYOR'S CERTIFICATE

THIS IS TO CERTIFY THAT THE MONUMENTS HAVE BEEN SET AND TIES ESTABLISHED AS SHOWN HEREON.

Kay L. Adams
KAY L. ADAMS
REGISTERED LAND SURVEYOR
NEVADA CERTIFICATE NO. 2050

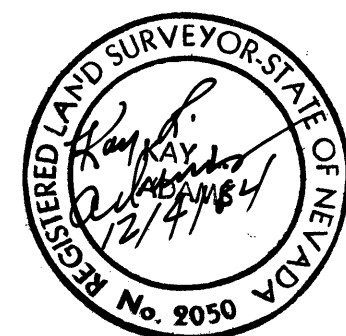

56-110

05B-2032-1

SHEET 2 OF 3

Book 30 Page 41