


LEWIS HOMES - RAINBOW VISTA NO.-2

BEING A PORTION OF THE (NE 1/4) OF SECTION 26, T. 20 S., R. 60 E., M.D.M.
CITY OF LAS VEGAS, CLARK COUNTY, NEVADA


SURVEYOR'S CERTIFICATE

THIS IS TO CERTIFY THAT THE MONUMENTS HAVE BEEN SET AND TIES ESTABLISHED AS SHOWN HEREON.

Frederick W. Orban
FREDERICK W. ORBAN
REGISTERED LAND SURVEYOR
NEVADA CERTIFICATE NO. 4541

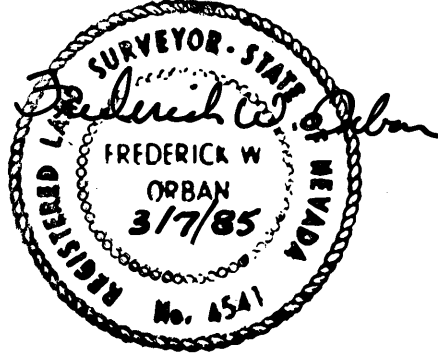


UNDEVELOPED

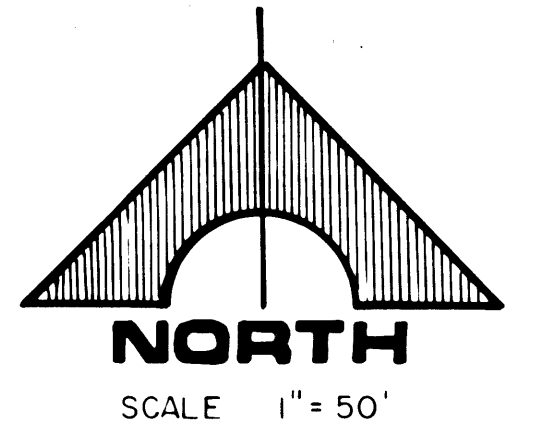

UNDEVELOPED

UNDEVELOPED

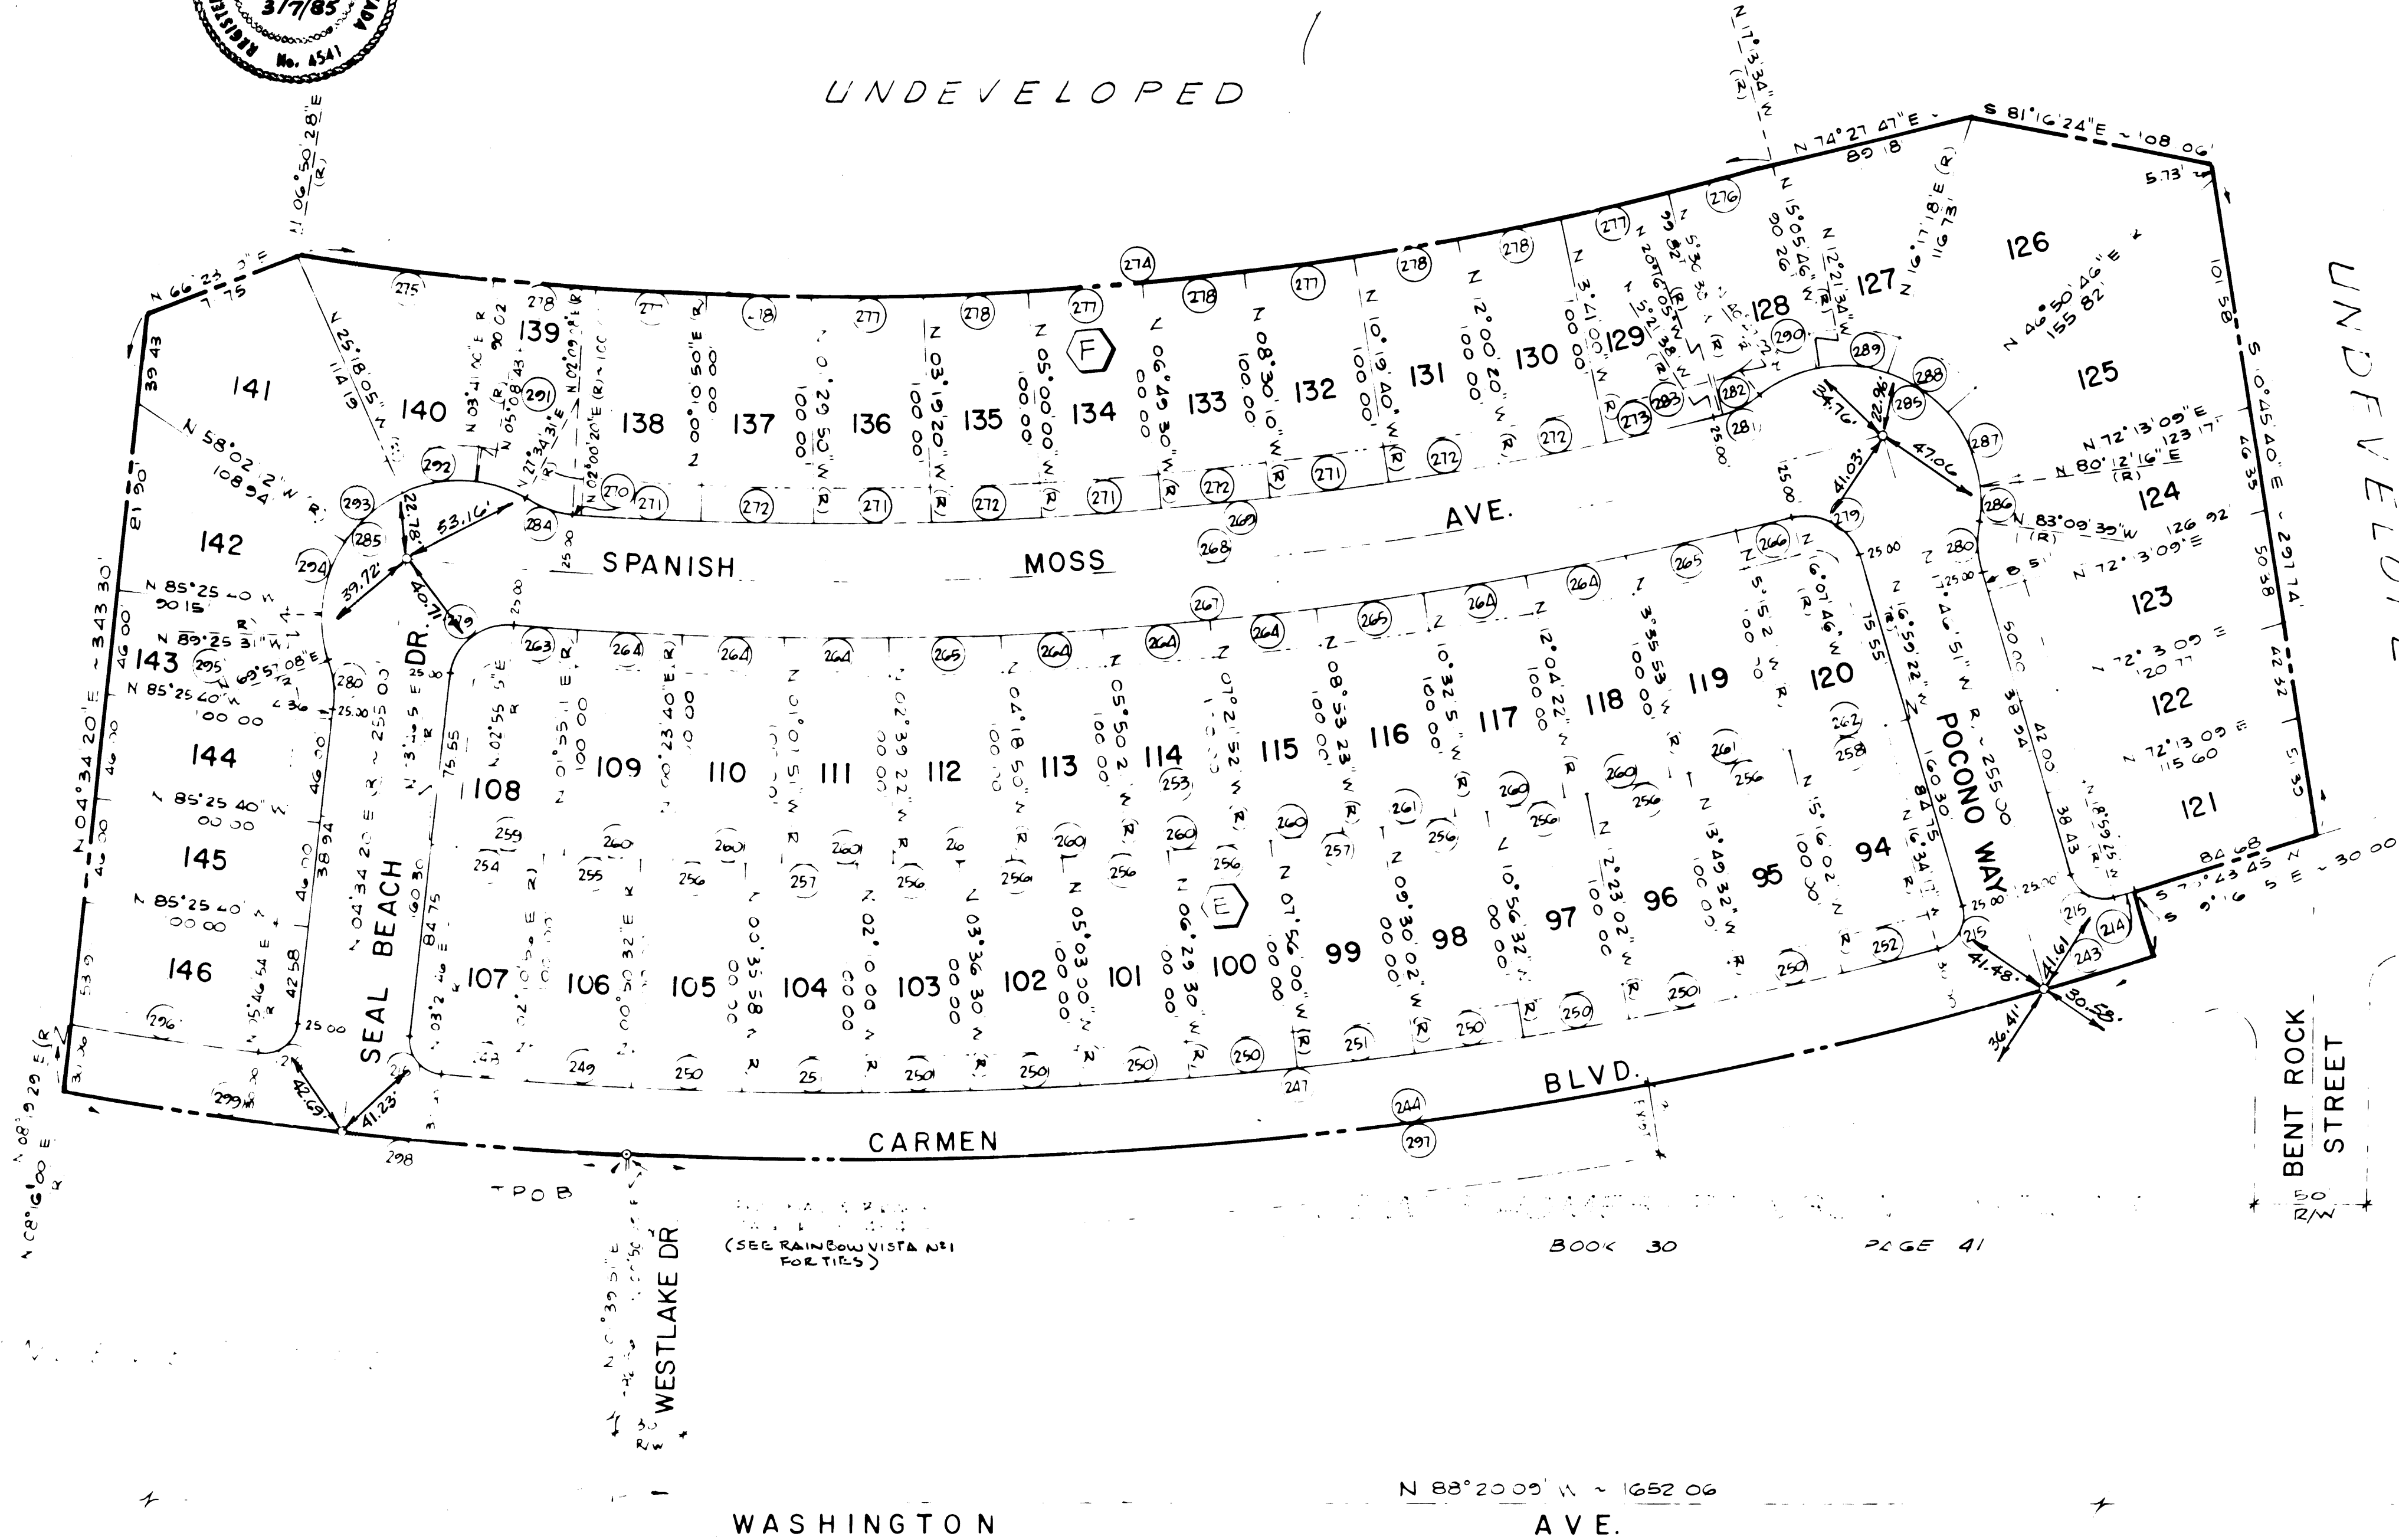

CURVE DATA

NO	Δ	R	L	T
214	00°16'50"	1910.00	9.35	4.68
215	91°12'34"	15.00	23.88	5.32
243	01°29'24"	1940.00	50.45	25.23
244	22°21'11"	1940.00	756.86	383.30
245	15°3'54"	940.00	525.89	264.57
246	00°11'03"	1940.00	6.24	3.2
247	9°56'03"	1910.00	664.52	335.65
248	01°0'50"	1910.00	39.36	19.68
249	01°20'24"	1910.00	44.67	22.34
250	0°26'30"	1910.00	48.06	24.03
251	01°34'02"	1910.00	52.25	26.12
252	01°18'15"	1910.00	43.48	21.74
253	20°46'13"	1810.00	656.14	331.71
254	01°35'55"	1810.00	50.50	25.25
255	01°20'24"	1810.00	42.33	21.17

NO	Δ	R	L	T
256	0°26'30"	80.00	45.54	22.77
257	01°34'02"	180.00	49.5	24.76
258	0°43'20"	80.00	54.4	27.2
259	0°5'40"	180.00	58.79	29.40
260	0°3'3"	80.00	48.18	24.09
261	0°39'28"	180.00	52.37	26.9
262	0°44'01"	80.00	54.77	27.39
263	0°00'04"	170.00	29.88	14.94
264	0°3'3"	70.00	45.52	22.76
265	0°39'28"	1710.00	49.48	24.74
266	00°52'25"	170.00	26.01	3.04
267	0°03'0"	1710.00	568.56	286.93
268	22°2'11"	1685.00	657.38	332.92
269	17°30'46"	1660.00	507.39	255.69
270	00°08'48"	1660.00	4.25	2.13

NO	Δ	R	L	T
271	01°49'30"	1660.00	52.88	26.44
272	0°40'40"	1660.00	48.61	24.31
273	0°40'38"	1660.00	48.59	24.30
274	24°04'02"	560.00	655.28	332.55
275	03°09'28"	1560.00	85.98	43.00
276	0°43'04"	1560.00	46.77	23.39
277	0°49'30"	1560.00	49.69	24.85
278	0°40'40"	1560.00	45.63	22.84
279	88°20'55"	25.00	38.55	24.29
280	24°37'12"	50.00	21.49	10.9
281	25°25'24"	50.00	22.19	11.28
282	20°30'57"	50.00	17.90	9.05
283	04°54'21"	50.00	4.28	2.14
284	25°25'23"	50.00	22.19	11.28
285	131°31'23"	60.00	144.12	154.78

NO	Δ	R	L	T
286	13°38'05"	60.00	7.42	8.77
287	33°21'30"	60.00	34.93	17.98
288	30°33'28"	60.00	32.00	6.39
289	28°38'52"	60.00	30.00	5.32
290	28°25'28"	60.00	29.77	15.20
291	22°25'48"	60.00	23.49	9.0
292	30°26'48"	60.00	31.88	6.33
293	32°44'01"	60.00	34.28	17.62
294	31°23'19"	60.00	32.87	16.86
295	20°37'21"	60.00	21.60	10.92
296	02°32'35"	1910.00	84.78	42.39
297	20°07'4"	1940.00	681.21	344.18
298	07°25'01"	1940.00	251.13	125.74
299	03°41'40"	1940.00	125.09	62.57

LEGEND

- 99 LOT NUMBER
- (F) BLOCK NUMBER
- (269) CURVE NUMBER
- SETBACKS
- 6 MIN FRONT YARD
- 0 MIN SIDEYARD CORNER
- LEGAL BOUNDARY
- FND MON. AS SHOWN
- SET NAIL & BRASS TAG R.L.S. 4541
- W/B C REF TIES SET IN TOP OF CURB

MONUMENT TIE MAP