

LEWIS HOMES-RAINBOW VISTA NO. 3

BEING A PORTION OF THE (NE 1/4) OF SECTION 26, T.20 S., R. 60 E., M.D.M.
CITY OF LAS VEGAS, CLARK COUNTY, NEVADA


2129869

CURVE DATA

NO.	Δ	R	L	T
11	38°14'52"	50.00	33.38	17.34
26	25°29'44"	45.50	203.69	∞
601	01°19'33"	1970.00	49.59	22.79
602	01°26'28"	1970.00	49.55	24.78
603	01°09'17"	1970.00	39.70	19.85
604	07°53'57"	1970.00	271.60	136.01
605	08°54'24"	1940.00	301.57	151.09
606	82°06'42"	15.00	21.90	13.07
607	00°39'41"	2070.00	23.89	11.95
608	01°19'33"	2070.00	41.90	23.95
609	01°26'28"	2070.00	52.06	26.03
610	01°53'57"	2070.00	66.61	34.31
611	01°22'39"	2070.00	49.77	24.88
612	01°16'02"	2070.00	45.78	22.89
613	01°28'52"	2070.00	53.51	26.76
614	09°18'18"	2070.00	336.17	168.46
615	01°22'39"	2170.00	52.17	26.09
616	01°16'02"	2170.00	41.99	24.00
617	00°35'20"	2170.00	22.30	11.15
618	98°02'10"	15.00	25.67	17.27
619	95°34'47"	15.00	25.02	16.53
620	16°36'07"	1940.00	562.13	283.05
621	07°41'43"	1940.00	260.56	130.47
622	01°07'32"	1970.00	38.70	19.35
623	01°23'04"	1970.00	47.60	23.80
624	01°22'58"	1970.00	47.54	23.77
625	01°10'02"	1970.00	40.13	20.07
626	05°03'36"	1970.00	173.98	87.05
627	01°31'42"	2070.00	55.22	27.61
628	01°19'02"	2070.00	47.59	23.80
629	01°18'57"	2070.00	47.54	23.77
630	01°31'21"	2070.00	55.01	27.50
631	05°41'02"	2070.00	205.35	102.76
632	02°46'35"	2070.00	100.31	50.16
633	02°54'27"	2070.00	105.04	52.53
634	81°57'50"	15.00	21.46	13.03
635	01°21'35"	2220.00	52.68	26.34
636	02°09'08"	2220.00	83.39	41.70
637	03°30'43"	2220.00	136.07	68.06
638	89°29'49"	15.00	23.43	14.87
639	04°47'35"	2195.00	183.65	91.85
640	101°32'53"	15.00	26.59	18.37
641	08°24'46"	2170.00	318.62	159.60
642	08°24'46"	2195.00	322.29	161.44
643	76°21'01"	15.00	19.99	11.79
644	02°29'54"	2220.00	96.80	48.41
645	00°18'03"	2220.00	11.66	5.83
646	02°47'57"	2220.00	108.46	54.24
647	03°37'08"	2195.00	138.64	69.34
648	02°37'37"	45.50	2.09	1.04
649	60°59'52"	45.50	48.44	26.80
650	64°37'23"	45.50	51.32	28.78
651	72°44'25"	45.50	57.76	33.51
652	55°30'27"	45.50	44.08	23.94
653	13°53'29"	50.00	12.72	6.09
654	24°21'23"	50.00	21.23	10.79
655	29°29'57"	50.00	25.74	13.16
656	08°44'55"	50.00	7.63	3.82
657	58°09'53"	45.50	46.19	25.31
658	70°04'59"	45.50	55.65	31.91
659	75°21'35"	45.50	59.85	35.14
660	52°53'7"	45.50	42.00	22.63
661	18°49'57"	50.00	16.43	8.29
662	19°24'55"	50.00	16.94	8.55

LEGEND


- 149 LOT NUMBER
- ⬡ BLOCK NUMBER
- Ⓢ CURVE NUMBER
- SETBACKS:
 - 18' MIN. FRONT YARD
 - 10' MIN. SIDE YARD
- LEGAL BOUNDARY
- ⊙ FDN. MON. AS SHOWN
- SET NAIL & BRASS TAG R.L.S. 2050
W/B.C. REF. TIES SET IN TOP OF CURB

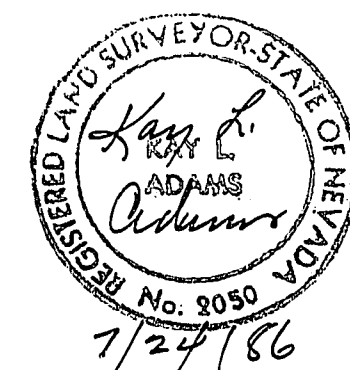

SURVEYOR'S CERTIFICATE

THIS IS TO CERTIFY THAT THE MONUMENTS HAVE BEEN SET AND TIES ESTABLISHED AS SHOWN HEREBON.

Kay L. Adams
REGISTERED LAND SURVEYOR
NEVADA CERTIFICATE NO. 2050

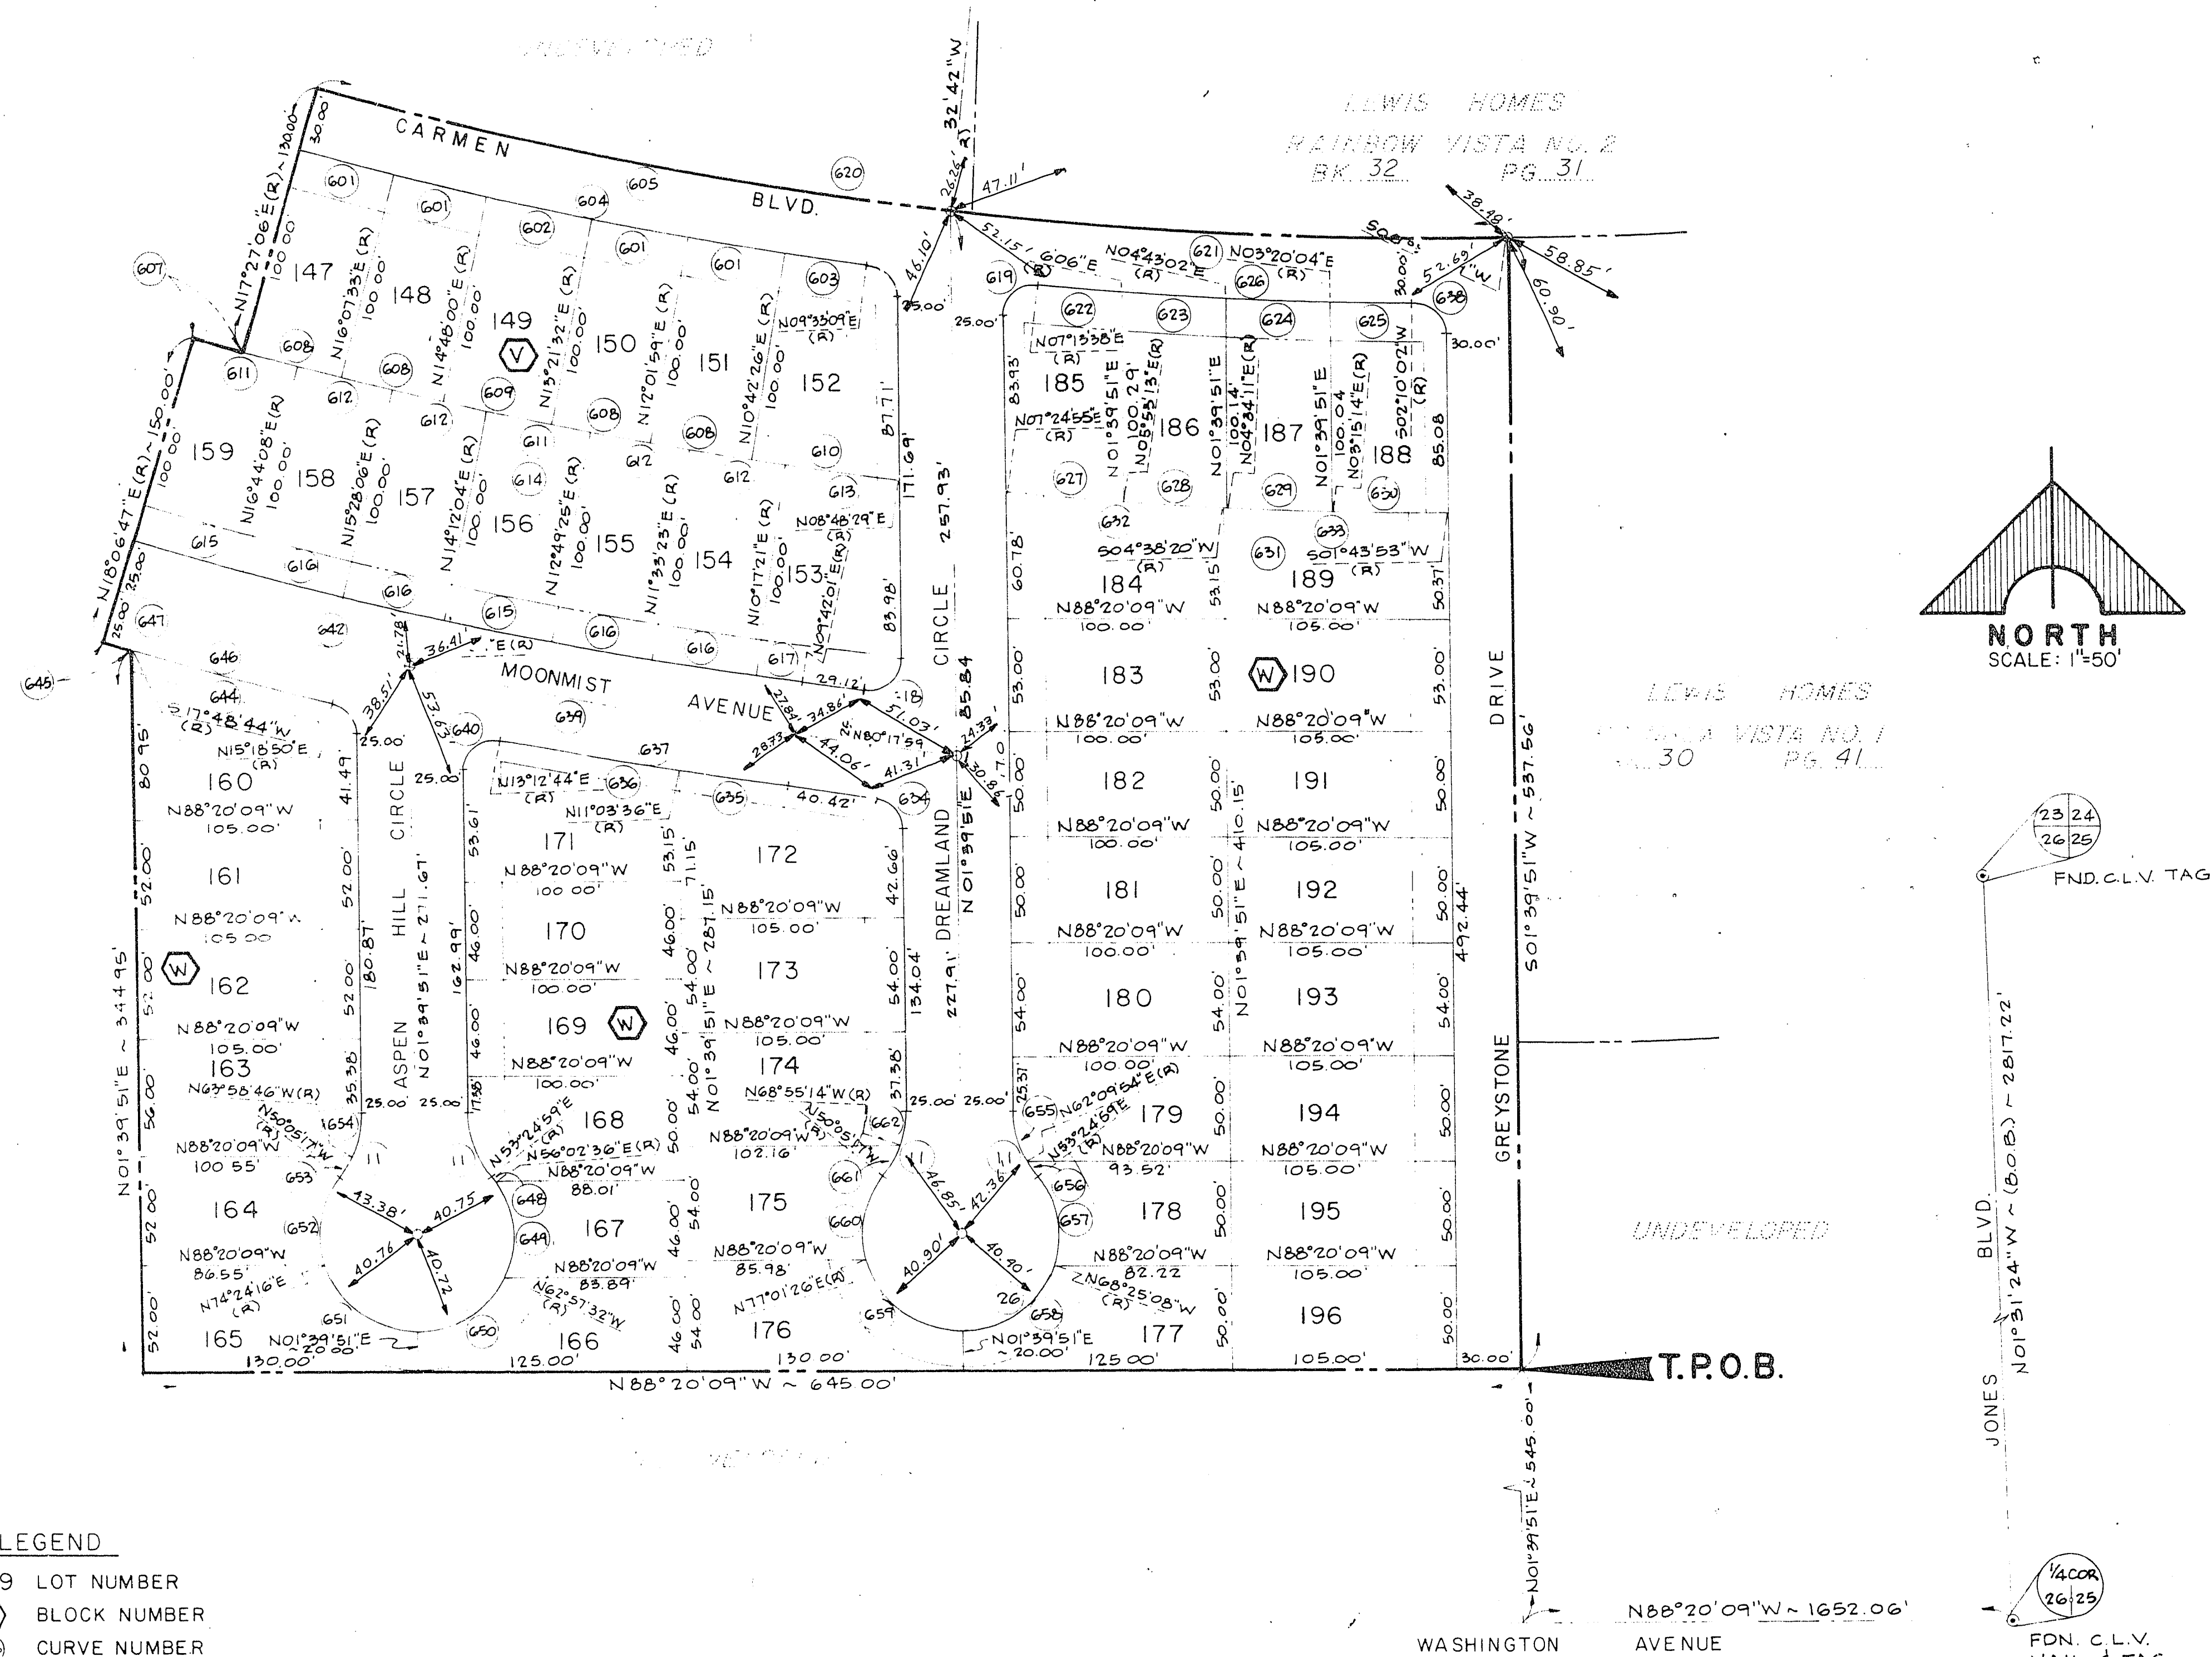

MONUMENT TIE MAP

SHT. 3 OF 3
BK. 33 PG. 219

56-104 058-2032-3