


BOOK 86 1114

LEWIS HOMES - RAINBOW VISTA NO. 4

30524

BEING A PORTION OF THE (NE 1/4) OF SECTION 26, T.20 S., R. 60 E., M.D.M.
CITY OF LAS VEGAS,

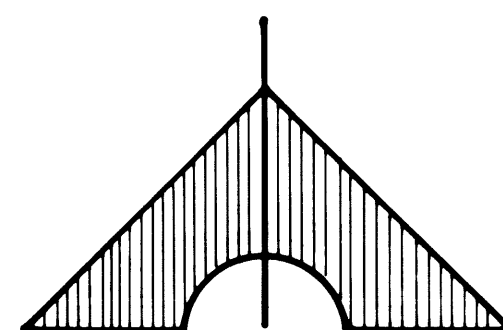

SCALE 1" = 50'

LEWIS HOMES
RAINBOW VISTA NO. 1

BK. 30

PG. 41



LEGEND

- 234 LOT NUMBER
- (X) BLOCK NUMBER
- (O) CURVE NUMBER

--- SETBACKS

R-I

RCL

20' MIN. FRONT YARD

16' MIN. FRONT YARD

15' MIN. SIDE YARD CORNER

10' MIN. SIDE YARD CORNER

--- LEGAL BOUNDARY

● FND. MON. AS SHOWN

○ SET 5/8" REBAR AND ALUM. CAP R.L.S. 2050
W/B C. REF. TIES SET IN TOP OF CURB.

CURVE DATA

NO.	Δ	R.	L.	T.
86	24°37'12"	50.00	21.48	13.91
106	93°11'15"	15.00	24.40	15.86
07	86°48'45"	15.00	22.73	14.19
108	88°16'19"	15.00	23.11	14.55
109	139°14'24"	60.00	145.81	161.51
110	139°00'00"	25.00	39.27	25.00
111	01°55'39"	2471.50	83.14	41.58
112	02°04'13"	2471.50	89.30	44.66
118	30°07'14"	60.00	31.54	16.15
119	41°21'27"	60.00	43.31	22.65
120	48°08'02"	60.00	50.41	26.80
129	19°37'41"	60.00	20.55	10.38
131	05°02'03"	2446.50	214.96	107.55
132	05°57'18"	2446.50	254.28	127.25
137	02°02'22"	2471.50	87.97	43.99
141	03°59'06"	2471.50	171.90	85.98
144	01°56'44"	2471.50	83.92	41.97
146	82°25'05"	15.00	21.55	13.14
147	101°34'01"	15.00	26.59	18.38
148	95°43'33"	15.00	25.06	16.58
152	91°43'41"	15.00	24.01	15.46
158	19°30'49"	2321.00	790.42	399.11
178	02°04'54"	2446.50	88.89	44.45
183	19°12'25"	2421.50	811.75	409.72


CURVE DATA

NO.	Δ	R.	L.	T.
186	19°12'25"	2446.50	820.13	413.95
200	01°01'53"	2421.50	43.59	21.80
201	00°58'56"	2421.50	41.51	20.76
202	01°13'41"	2421.50	51.90	25.95
203	01°01'53"	2321.00	41.78	20.89
204	00°58'56"	2321.00	39.79	19.89
205	01°13'41"	2321.00	49.75	24.87
206	01°20'34"	2321.00	54.39	27.20
214	01°02'10"	2421.50	43.79	21.90
215	76°32'41"	15.00	20.04	11.83
216	02°07'09"	2471.50	91.41	45.71
217	01°59'42"	2471.50	86.06	43.03
218	01°25'16"	2471.50	61.30	30.65
219	06°08'10"	2446.50	262.01	131.13
220	107°34'10"	15.00	28.16	20.48
221	70°29'10"	15.00	18.45	10.60
222	01°34'13"	2321.00	63.61	31.81
223	00°59'06"	2321.00	39.90	19.96
224	01°34'13"	2421.50	66.36	33.18
225	00°59'06"	2421.50	41.63	20.82
226	04°06'51"	2471.50	177.47	88.77
130	03°59'52"	2471.50	172.45	86.26

SURVEYOR'S CERTIFICATE

THIS IS TO CERTIFY THAT THE MONUMENTS HAVE
BEEN SET AND TIES ESTABLISHED AS SHOWN HEREON.

KAY L. ADAMS
REGISTERED LAND SURVEYOR
NEVADA CERTIFICATE

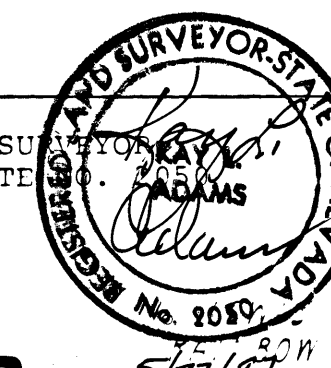

MONUMENT TIE MAP

058-2032-4 SHEET 3 OF 3
5-6-107 BK. 35 PG. 92