Book 860903

01138

LEWIS HOMES - RAINBOW VISTA NO. 5

BEING A PORTION OF THE (NE 1/4) OF SECTION 26, T. 20 S., R. 60 E., M.D.M.
CITY OF LAS VEGAS, CLARK COUNTY, NEVADA

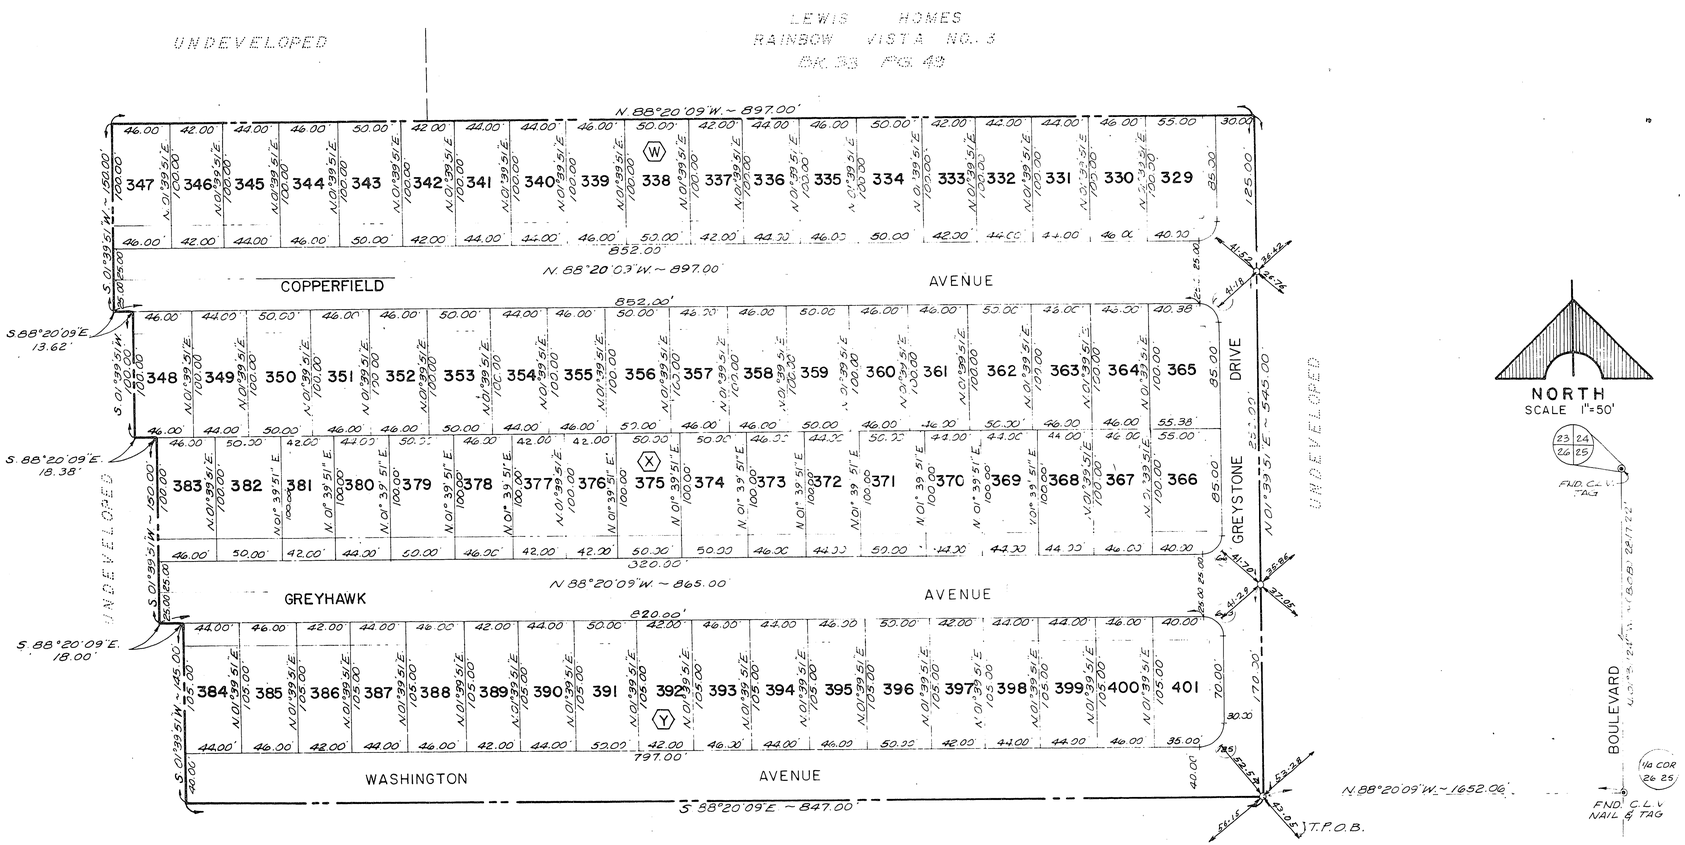

NOTE:
NO ACCESS TO WASHINGTON AVE. FROM THE REAR OF THE ABUTTING LOTS.

LEGEND

331 LOT NUMBER
(X) BLOCK NUMBER
(10) CURVE NUMBER
—·—·— SETBACKS
16' MIN. FRONT YARD
10' MIN. SIDE YARD CORNER
——— LEGAL BOUNDARY
◉ FND. MON. AS SHOWN
○ SET 5/8" REBAR AND ALUM. CAP R.L.S. 2050 W/ B.C. REF. TIES SET IN TOP OF CURB.

CURVE DATA

NO.	Δ	R	L	T
125	90°00'00"	20.00'	31.42'	20.00'
663	90°00'00"	15.00'	23.56	15.00'

SURVEYOR'S CERTIFICATE

THIS IS TO CERTIFY THAT THE MONUMENTS HAVE BEEN SET AND TIES ESTABLISHED AS SHOWN HEREON.

KAY L. ADAMS
REGISTERED LAND SURVEYOR
NEVADA CERTIFICATE NO. 2050

REGISTERED LAND SURVEYOR STATE OF NEVADA No. 2050 KAY L. ADAMS

12/28/87

MONUMENT TIE MAP

058-2032-5

SHEET 3 OF 3
BK.
PG.

5-6-106

Book 35 Pg 55