


Book 136 Page 99

00723

LEWIS HOMES - RAINBOW VISTA NO.-8

BEING A PORTION OF THE (N1/2) OF SECTION 26, T.20S. R.60E. M.D.M.
CITY OF LAS VEGAS, CLARK COUNTY, NEVADA

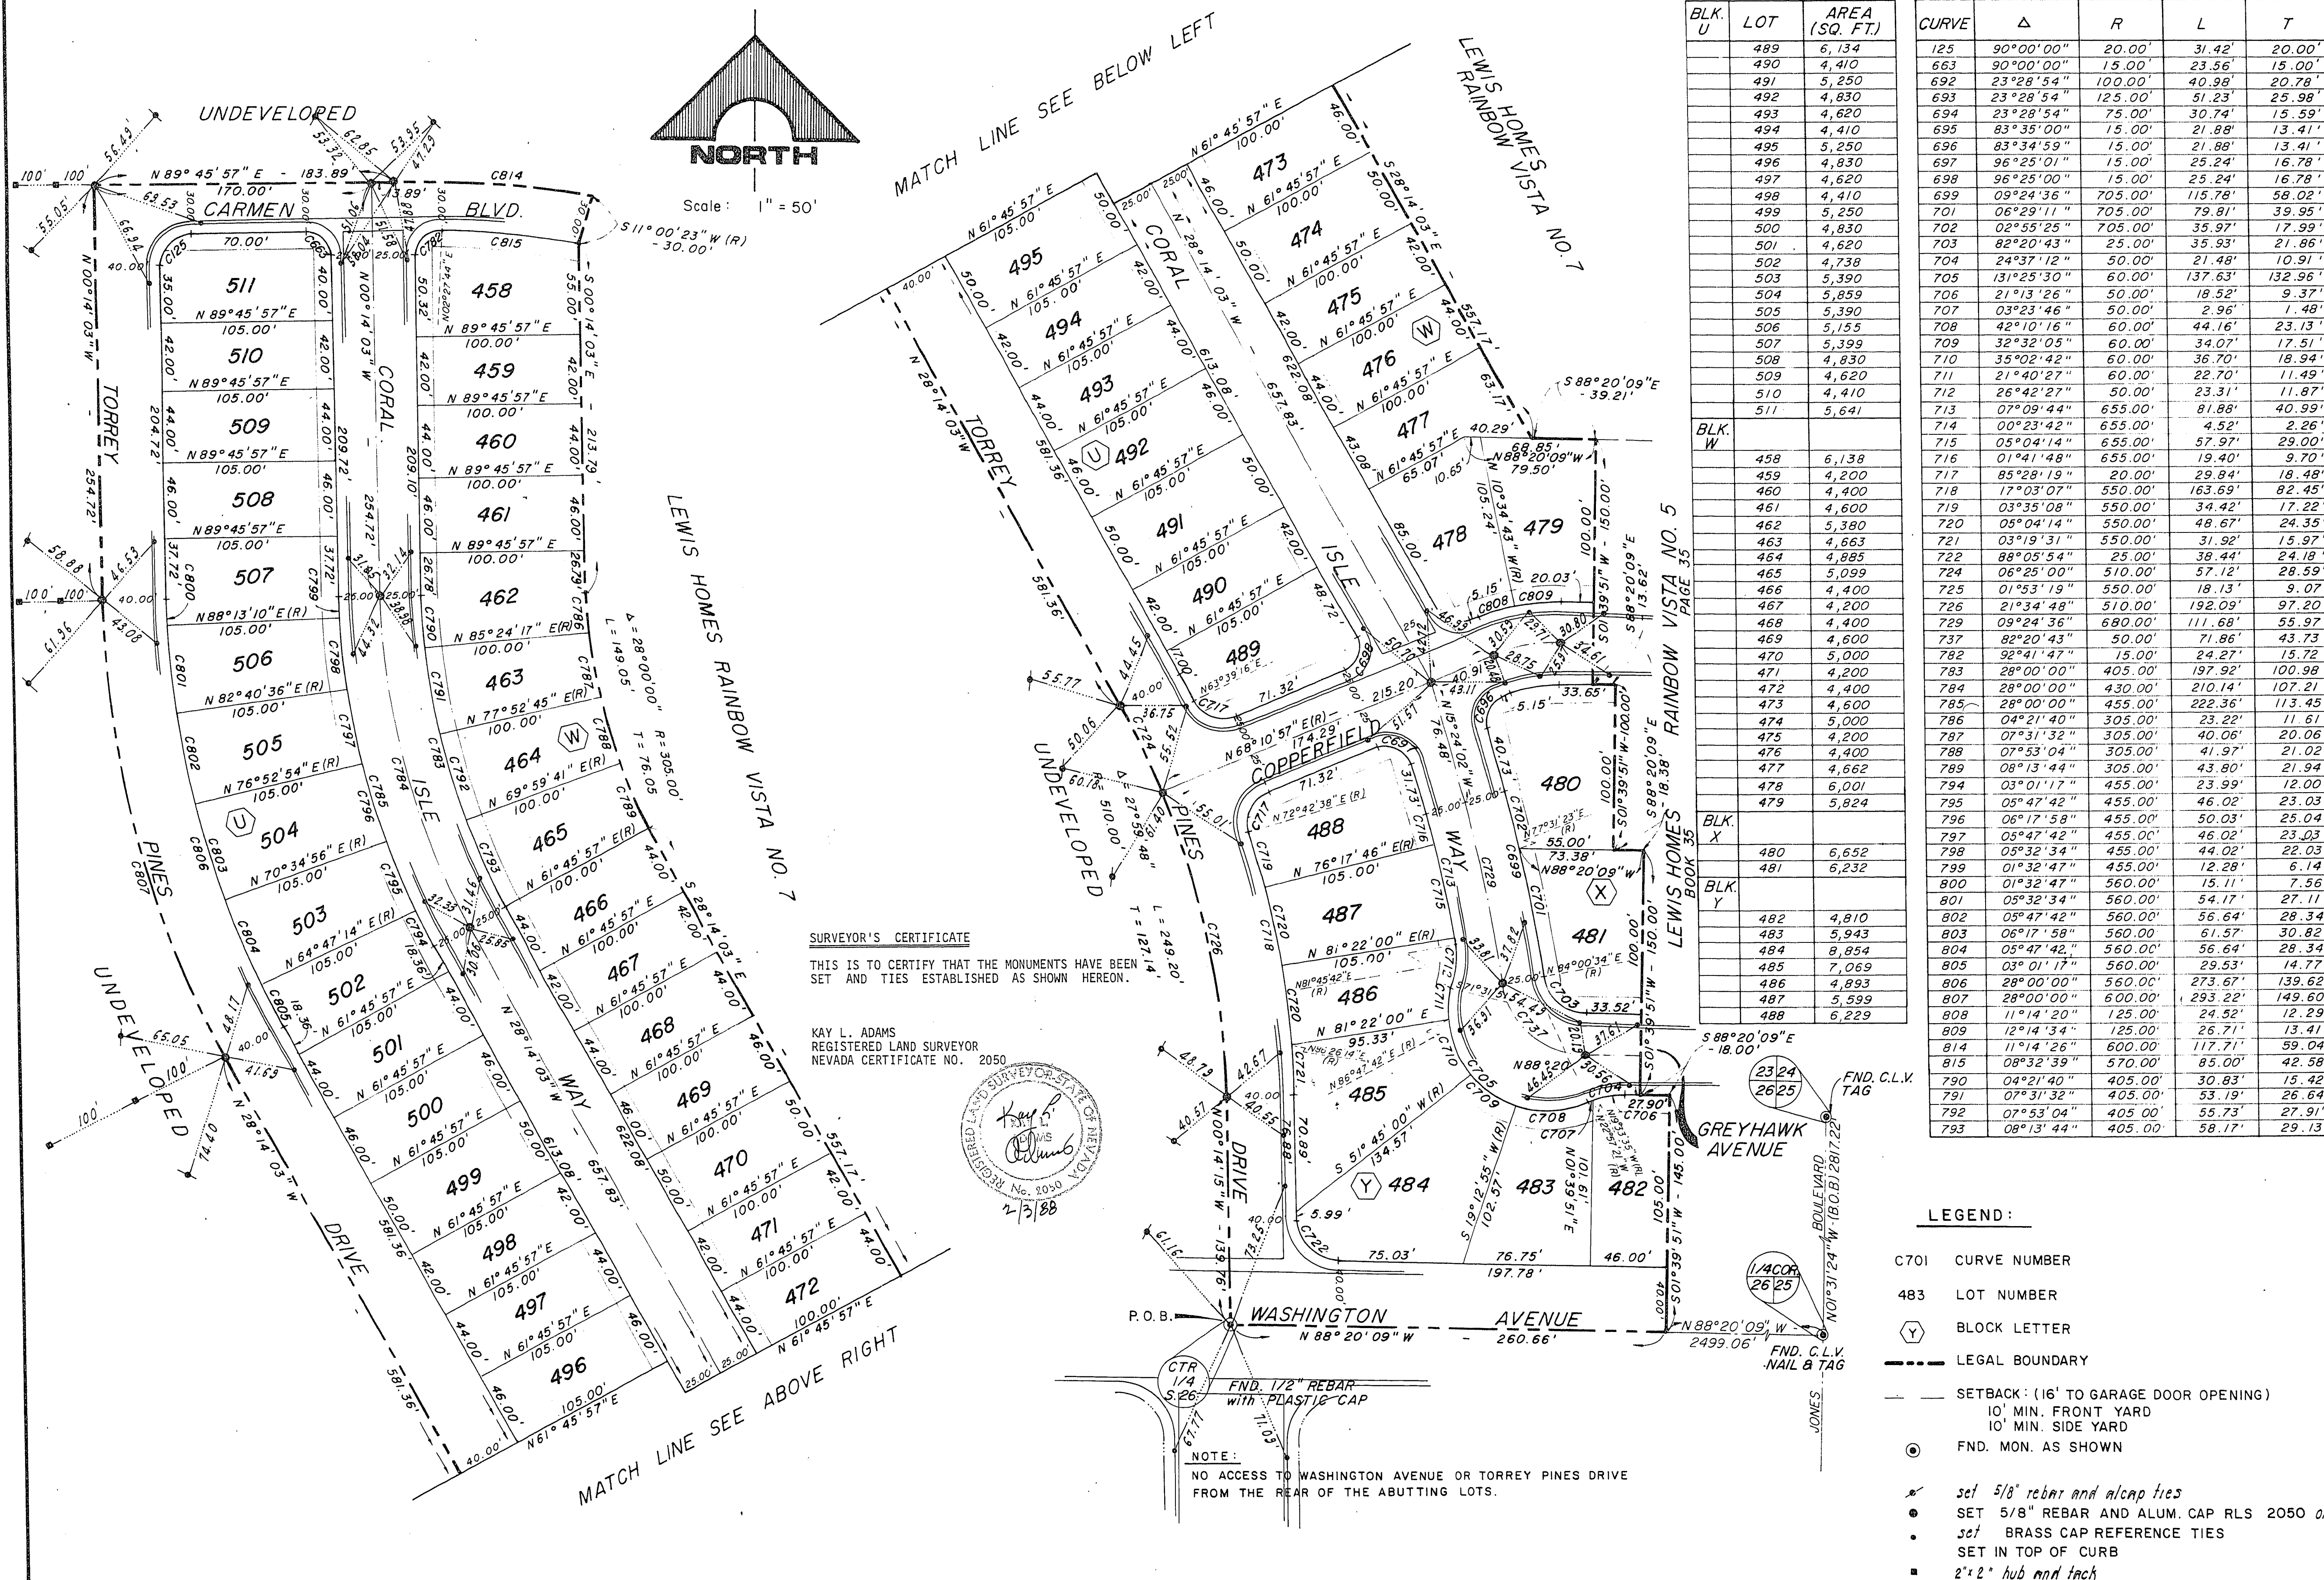

BLK. U	LOT	AREA (SQ. FT.)
489	5,134	
490	4,410	
491	5,250	
492	4,830	
493	4,620	
494	4,410	
495	5,250	
496	4,830	
497	4,620	
498	4,410	
499	5,250	
500	4,830	
501	4,620	
502	4,738	
503	5,390	
504	5,859	
505	5,390	
506	5,155	
507	5,399	
508	4,830	
509	4,620	
510	4,410	
511	5,641	

CURVE	Δ	R	L	T
125	90°00'00"	20.00'	31.42'	20.00'
663	90°00'00"	15.00'	23.56'	15.00'
692	23°28'54"	100.00'	40.98'	20.78'
693	23°28'54"	125.00'	51.23'	25.98'
694	23°28'54"	75.00'	30.74'	15.59'
695	83°35'00"	15.00'	21.88'	13.41'
696	83°34'59"	15.00'	21.88'	13.41'
697	96°25'01"	15.00'	25.24'	16.78'
698	96°25'00"	15.00'	25.24'	16.78'
699	09°24'36"	705.00'	115.78'	58.02'
701	06°29'11"	705.00'	79.81'	39.95'
702	02°55'25"	705.00'	35.97'	17.99'
703	82°20'43"	25.00'	35.93'	21.86'
704	24°37'12"	50.00'	21.48'	10.91'
705	131°25'30"	60.00'	137.63'	132.96'
706	21°13'26"	50.00'	18.52'	9.37'
707	03°23'46"	50.00'	2.96'	1.48'
708	42°10'16"	60.00'	44.16'	23.13'
709	32°32'05"	60.00'	34.07'	17.51'
710	35°02'42"	60.00'	36.70'	18.94'
711	21°40'27"	60.00'	22.70'	11.49'
712	26°42'27"	50.00'	23.31'	11.87'
713	07°09'44"	655.00'	81.88'	40.99'
714	00°23'42"	655.00'	4.52'	2.26'
715	05°04'14"	655.00'	57.97'	29.00'
716	01°41'48"	655.00'	19.40'	9.70'
717	85°28'19"	20.00'	29.84'	18.48'
718	17°03'07"	550.00'	163.69'	82.45'
719	03°53'08"	550.00'	34.42'	17.22'
720	05°04'14"	550.00'	48.67'	24.35'
721	03°19'31"	550.00'	31.92'	15.97'
722	88°05'54"	25.00'	38.44'	24.18'
724	06°25'00"	510.00'	57.12'	28.59'
725	01°53'19"	550.00'	18.13'	9.07'
726	21°34'48"	510.00'	192.09'	97.20'
729	09°24'36"	680.00'	111.68'	55.97'
737	82°20'43"	50.00'	71.86'	43.73'
782	92°41'47"	15.00'	24.27'	15.72'
783	28°00'00"	405.00'	197.92'	100.98'
784	28°00'00"	430.00'	210.14'	107.21'
785	28°00'00"	455.00'	222.36'	113.45'
786	04°21'40"	305.00'	23.22'	11.61'
787	07°31'32"	305.00'	40.06'	20.06'
788	07°53'04"	305.00'	41.97'	21.02'
789	08°13'44"	305.00'	43.80'	21.94'
794	03°01'17"	455.00'	23.99'	12.00'
795	05°47'42"	455.00'	46.02'	23.03'
796	06°17'58"	455.00'	50.03'	25.04'
797	05°47'42"	455.00'	46.02'	23.03'
798	05°32'34"	455.00'	44.02'	22.03'
799	01°32'47"	455.00'	12.28'	6.14'
800	01°32'47"	560.00'	15.11'	7.56'
801	03°32'34"	560.00'	54.17'	27.11'
802	05°47'42"	560.00'	56.64'	28.34'
803	06°17'58"	560.00'	61.57'	30.82'
804	05°47'42"	560.00'	56.64'	28.34'
805	03°01'17"	560.00'	29.53'	14.77'
806	28°00'00"	560.00'	273.67'	139.62'
807	28°00'00"	600.00'	293.22'	149.60'
808	11°14'20"	125.00'	24.52'	12.29'
809	12°14'34"	125.00'	26.71'	13.41'
814	11°14'26"	600.00'	117.71'	59.04'
815	08°32'39"	570.00'	85.00'	42.58'
790	04°21'40"	405.00'	30.83'	15.42'
791	07°31'32"	405.00'	53.19'	26.64'
792	07°53'04"	405.00'	55.73'	27.91'
793	08°13'44"	405.00'	58.17'	29.13'

MONUMENT TIE MAP

SHEET 3 OF 3

Book 136 Page 99
058-2032-8

56-103