

LOS LAGOS

A PORTION OF THE SOUTHEAST QUARTER (SE.1/4) OF THE SOUTHEAST QUARTER (SE.1/4) OF SECTION 8, T. 21 S., R. 60 E., M.D.M.

MONUMENT TIE MAP

LINE DATA TABLE

LABEL	BEARING	DISTANCE
T1	N 89° 22' 10" W	100.02
T2	N 89° 22' 10" W	100.02
T3	N 89° 22' 10" W	100.02
T4	N 89° 22' 10" W	100.02
T5	N 45° 48' 51" E	15.44
T6	N 52° 02' 28" W	20.28
T7	N 50° 48' 39" E	17.62
T8	N 52° 02' 28" W	20.28
T9	N 50° 48' 39" E	17.62
T10	N 52° 02' 28" W	20.28
T11	N 50° 48' 39" E	17.62
T12	N 45° 48' 51" E	15.44
T13	N 89° 22' 10" W	100.02
T14	N 89° 22' 10" E	45.00
T15	S 50° 48' 39" W	17.62
T16	N 52° 02' 28" W	20.28
T17	N 50° 48' 39" E	17.62
T18	N 89° 22' 10" E	45.00
T19	N 52° 02' 28" W	20.28
T20	S 89° 22' 10" E	45.00
T21	S 89° 22' 10" E	45.00
T22	N 89° 22' 10" W	26.00
T23	S 89° 36' 36" E	45.00
T24	N 89° 22' 10" W	2.30
T25	N 89° 22' 10" W	0.11
T26	S 89° 22' 10" E	11.78
T27	N 89° 22' 10" W	13.02
T28	S 89° 22' 10" E	11.78
T29	N 89° 22' 10" W	13.02
T30	S 89° 22' 10" E	11.78
T31	N 89° 22' 10" W	13.02
T32	S 89° 22' 10" E	11.78
T33	N 89° 22' 10" W	15.02
T34	S 89° 22' 10" E	11.78
T35	N 89° 36' 36" W	12.84
T36	N 89° 36' 36" E	26.00
T37	S 89° 22' 10" E	0.11
T38	N 89° 22' 10" W	0.11
T39	S 89° 22' 10" E	31.55
T40	N 89° 22' 10" W	32.40

CURVE DATA TABLE


LABEL	RADIUS	CENTRAL ANGLE	ARC LENGTH	TAN. LENGTH
C1	25.50	89° 07' 34"	39.87	25.11
C2	20.50	46° 00' 01"	18.46	8.70
C3	45.00	40° 22' 03"	31.70	16.54
C4	45.00	47° 48' 59"	37.55	19.95
C5	45.00	37° 07' 42"	29.10	15.11
C6	45.00	37° 07' 42"	29.10	15.11
C7	45.00	37° 19' 42"	29.32	15.20
C8	45.00	53° 58' 24"	42.39	22.92
C9	20.50	46° 00' 01"	18.46	8.70
C10	15.50	90° 52' 26"	24.58	15.74
C11	15.50	89° 07' 34"	24.11	15.27
C12	20.50	46° 00' 01"	18.46	8.70
C13	45.00	00° 50' 35"	0.66	0.33
C14	45.00	55° 31' 04"	43.60	23.68
C15	45.00	39° 48' 11"	31.27	16.30
C16	45.00	39° 48' 11"	31.27	16.30
C17	45.00	37° 19' 42"	29.32	15.20
C18	45.00	37° 19' 42"	29.32	15.20
C19	45.00	53° 58' 24"	42.39	22.92
C20	45.00	07° 22' 12"	7.79	2.80
C21	20.50	46° 00' 01"	18.46	8.70
C22	15.50	90° 52' 26"	24.58	15.74
C23	15.50	89° 07' 34"	24.11	15.27
C24	20.50	46° 00' 01"	18.46	8.70
C25	45.00	00° 50' 35"	0.66	0.33
C26	45.00	55° 31' 04"	43.60	23.68
C27	45.00	39° 48' 11"	31.27	16.30
C28	45.00	39° 48' 11"	31.27	16.30
C29	45.00	37° 19' 42"	29.32	15.20
C30	45.00	37° 19' 42"	29.32	15.20
C31	45.00	53° 58' 24"	42.39	22.92
C32	45.00	07° 22' 12"	7.79	2.80
C33	20.50	46° 00' 01"	18.46	8.70
C34	15.50	90° 52' 26"	24.58	15.74
C35	15.50	89° 07' 34"	24.11	15.27
C36	20.50	46° 00' 01"	18.46	8.70
C37	45.00	00° 50' 35"	0.66	0.33
C38	45.00	55° 31' 04"	43.60	23.68
C39	45.00	39° 48' 11"	31.27	16.30
C40	45.00	39° 48' 11"	31.27	16.30

(CON'T.)


LABEL	RADIUS	CENTRAL ANGLE	ARC LENGTH	TAN. LENGTH
C41	45.00	37° 19' 42"	29.32	15.20
C42	45.00	37° 19' 42"	29.32	15.20
C43	45.00	53° 58' 24"	42.39	22.92
C44	45.00	07° 22' 12"	7.79	2.80
C45	20.50	46° 00' 01"	18.46	8.70
C46	15.50	90° 52' 26"	24.58	15.74
C47	15.50	89° 07' 34"	24.11	15.27
C48	20.50	46° 00' 01"	18.46	8.70
C49	45.00	00° 50' 35"	0.66	0.33
C50	45.00	55° 31' 04"	43.60	23.68
C51	45.00	39° 48' 11"	31.27	16.30
C52	45.00	39° 48' 11"	31.27	16.30
C53	45.00	37° 19' 42"	29.32	15.20
C54	45.00	37° 19' 42"	29.32	15.20
C55	45.00	53° 58' 24"	42.39	22.92
C56	45.00	07° 22' 12"	7.79	2.80
C57	20.50	46° 00' 01"	18.46	8.70
C58	15.50	90° 52' 26"	24.58	15.74
C59	15.50	89° 07' 34"	24.11	15.27
C60	20.50	46° 00' 01"	18.46	8.70
C61	45.00	00° 50' 35"	0.66	0.33
C62	45.00	55° 31' 04"	43.60	23.68
C63	45.00	39° 48' 11"	31.27	16.30
C64	45.00	39° 48' 11"	31.27	16.30
C65	45.00	37° 19' 42"	29.32	15.20
C66	45.00	37° 19' 42"	29.32	15.20
C67	45.00	53° 58' 24"	42.39	22.92
C68	45.00	07° 22' 12"	7.79	2.80
C69	20.50	46° 00' 01"	18.46	8.70
C70	15.50	90° 52' 26"	24.58	15.74
C71	15.50	89° 07' 34"	24.11	15.27
C72	20.50	46° 00' 01"	18.46	8.70
C73	45.00	00° 50' 35"	0.66	0.33
C74	45.00	55° 31' 04"	43.60	23.68
C75	45.00	39° 48' 11"	31.27	16.30
C76	45.00	39° 48' 11"	31.27	16.30
C77	45.00	37° 19' 42"	29.32	15.20
C78	45.00	37° 19' 42"	29.32	15.20
C79	45.00	53° 58' 24"	42.39	22.92
C80	45.00	07° 22' 12"	7.79	2.80
C81	20.50	46° 00' 01"	18.46	8.70
C82	15.50	90° 52' 26"	24.58	15.74
C83	15.50	89° 07' 34"	24.11	15.27
C84	20.50	46° 00' 01"	18.46	8.70
C85	45.00	00° 50' 35"	0.66	0.33
C86	45.00	55° 31' 04"	43.60	23.68
C87	45.00	39° 48' 11"	31.27	16.30
C88	45.00	39° 48' 11"	31.27	16.30
C89	45.00	37° 19' 42"	29.32	15.20
C90	45.00	37° 19' 42"	29.32	15.20
C91	45.00	53° 58' 24"	42.39	22.92
C92	45.00	07° 22' 12"	7.79	2.80
C93	20.50	46° 00' 01"	18.46	8.70
C94	15.50	90° 52' 26"	24.58	15.74
C95	15.50	89° 07' 34"	24.11	15.27
C96	20.50	46° 00' 01"	18.46	8.70
C97	45.00	00° 50' 35"	0.66	0.33
C98	45.00	55° 31' 04"	43.60	23.68
C99	45.00	39° 48' 11"	31.27	16.30
C100	45.00	39° 48' 11"	31.27	16.30

LEGEND

- SET 5/8" BRASS CAP IN T.C. STAMPED R.M.(DIST. NOTED)
- ▲ FOUND AS INDICATED
- SET 5/8" REBAR W/BRASS CAP TIES, R.L.S. 6305
- C79 CURVE NUMBER (SEE TABLE)
- T10 LINE TABLE (SEE TABLE)
- 5 LOT NUMBER
- ② BLOCK NUMBER
- BUILDING SETBACK LINE (16' FRONT, 10' SIDE)
- SET AS INDICATED

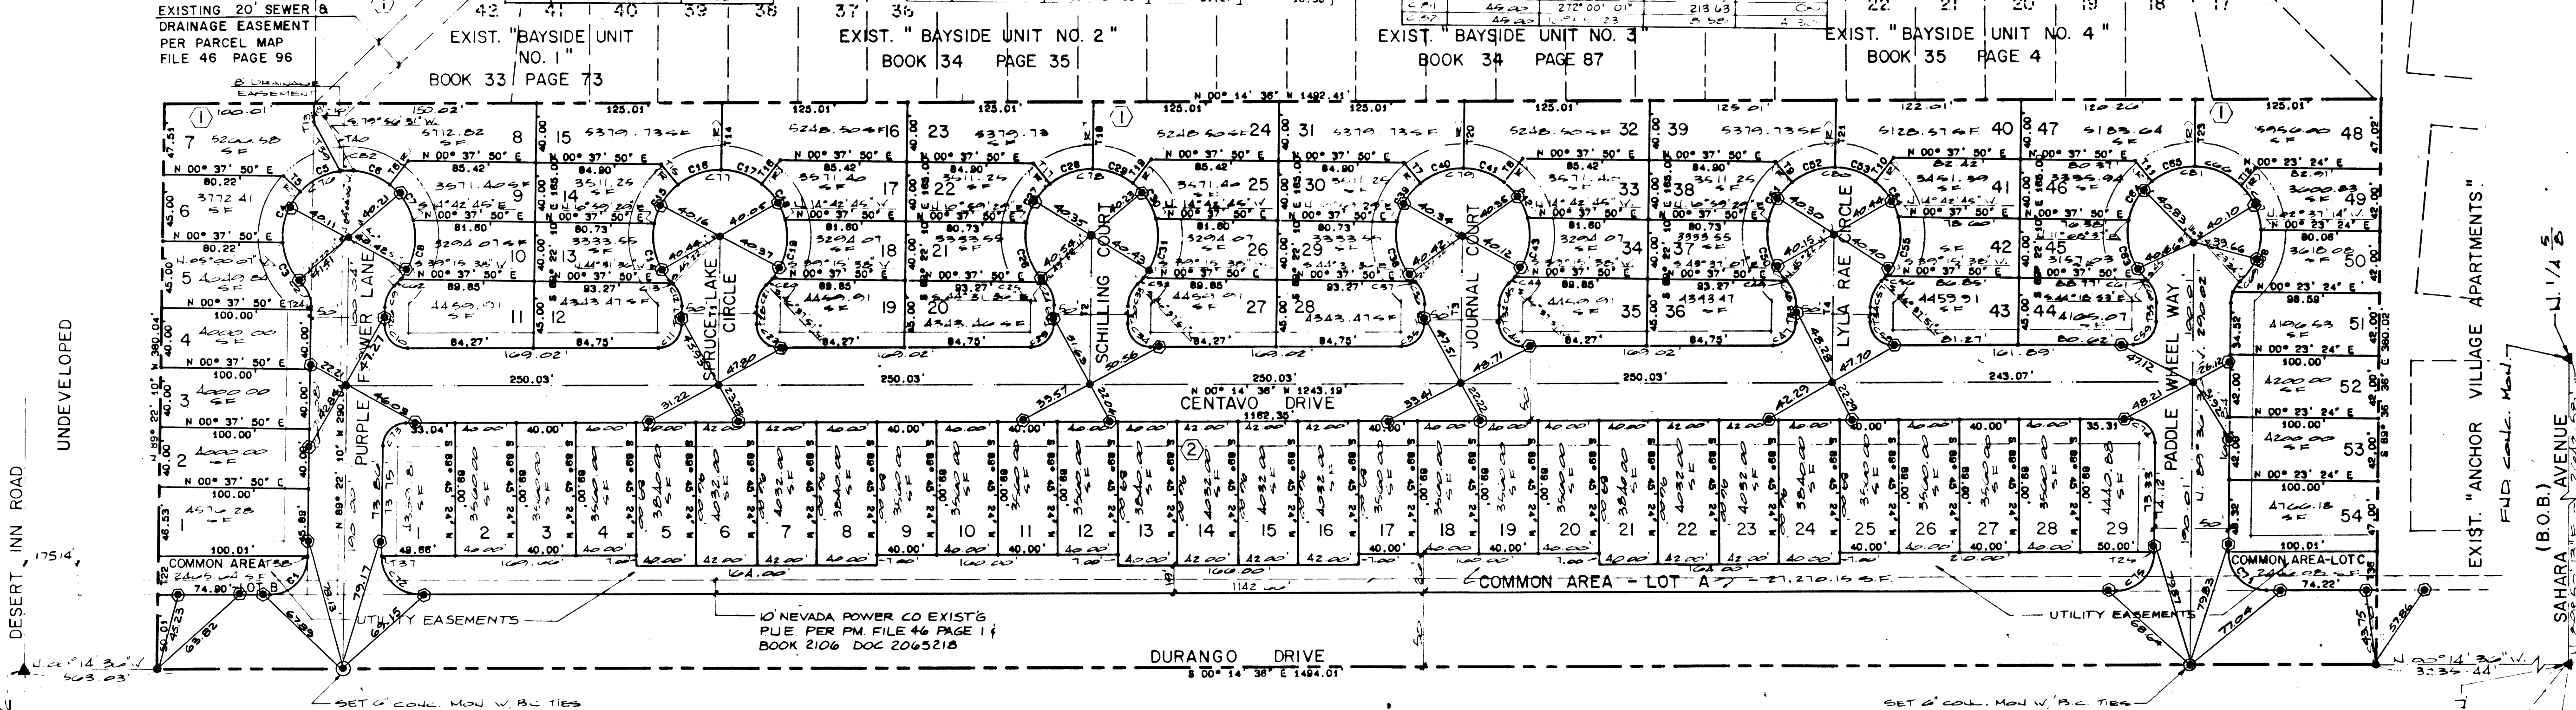

I, DENE E. KRAMETBAUER, A DULY REGISTERED LAND SURVEYOR IN THE STATE OF NEVADA, DO HEREBY CERTIFY THAT THE MONUMENTS HAVE BEEN SET AND THE TIES ESTABLISHED AS SHOWN HEREON.

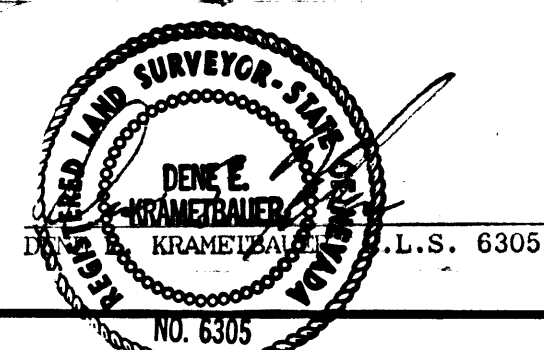

11/6/07