


A PORTION OF THE S 1/2 OF THE NW 1/4 OF SECTION 2, T.20S., R.60E., M.D.M.,
CITY OF LAS VEGAS, CLARK COUNTY, NEVADA

BASIS OF BEARING

1
 2
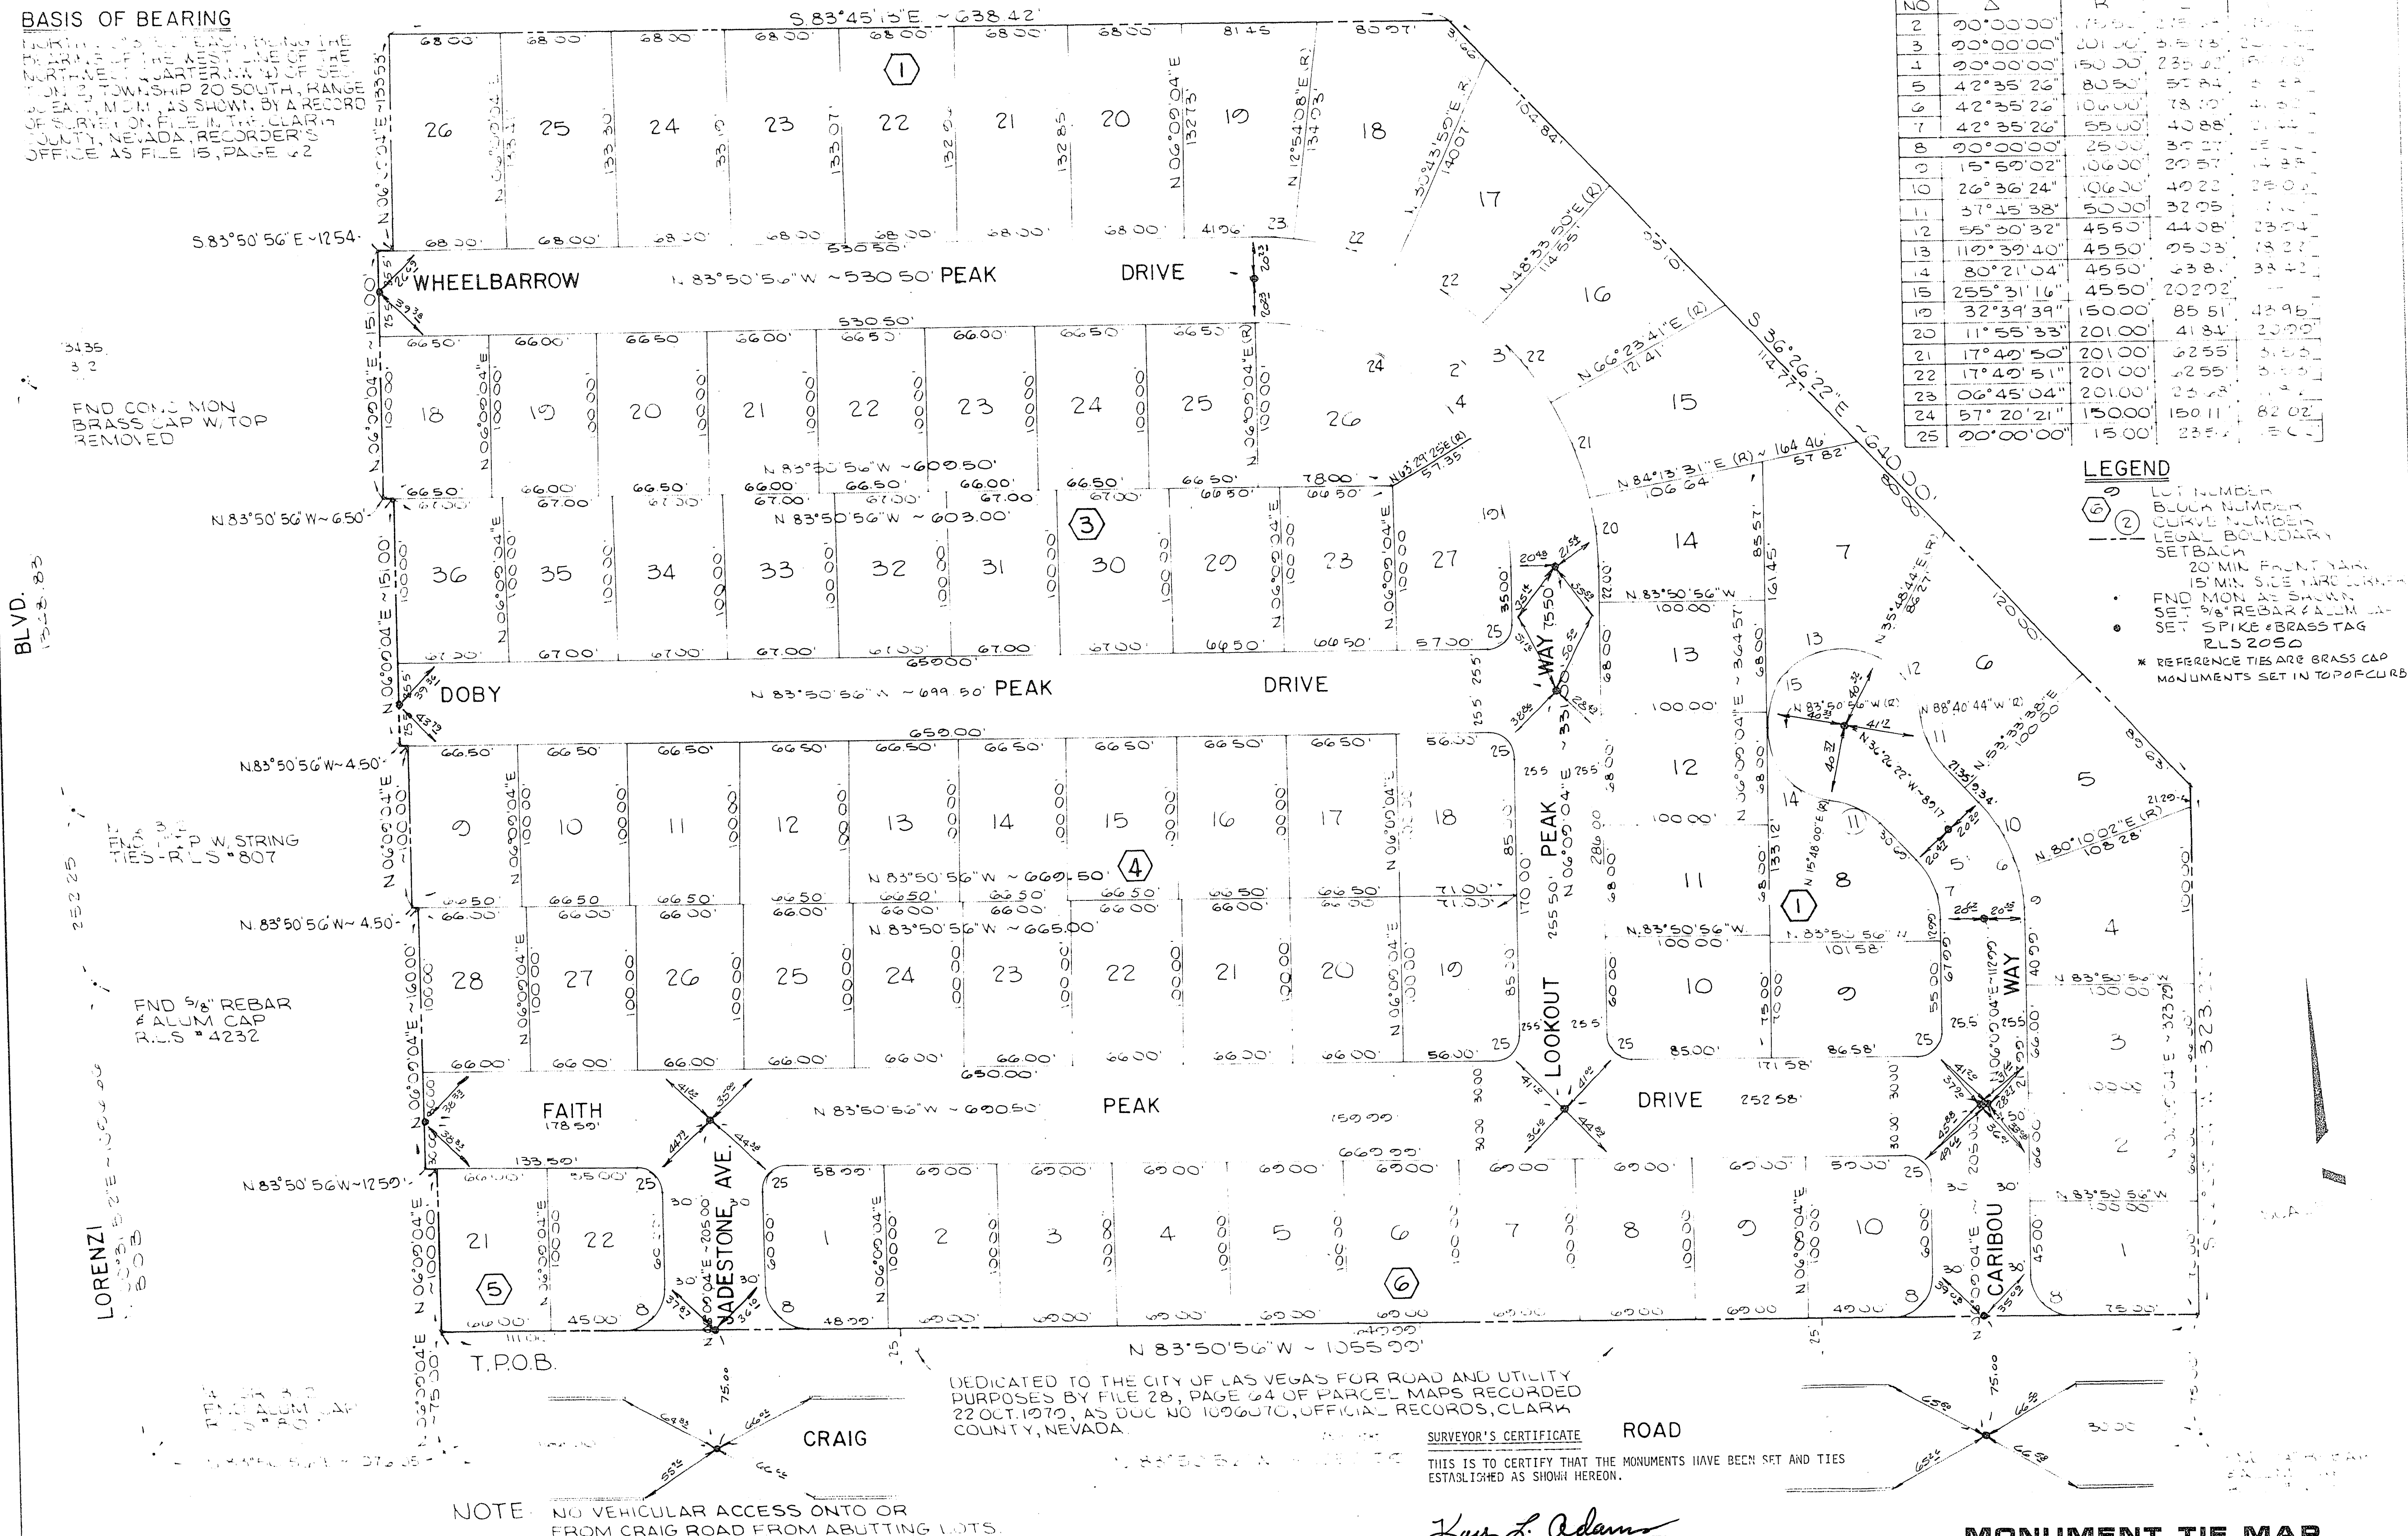

CURVE DATA			
NO	Δ	R	L
2	90°00'00"	150.00	215.47
3	90°00'00"	201.00	316.13
4	90°00'00"	150.00	235.62
5	42°35'26"	80.50	51.84
6	42°35'26"	104.00	78.10
7	42°35'26"	55.00	40.88
8	90°00'00"	25.00	30.27
9	15°59'02"	106.00	20.57
10	26°36'24"	106.00	40.23
11	37°45'38"	50.00	32.05
12	56°30'32"	45.50	44.08
13	119°29'40"	45.50	95.23
14	80°29'04"	45.50	63.81
15	255°31'16"	45.50	202.02
16	32°39'39"	150.00	85.51
20	11°55'53"	201.00	41.84
21	17°49'50"	201.00	62.55
22	17°49'50"	201.00	122.55
23	06°45'04"	201.00	23.48
24	57°20'21"	150.00	150.11
25	90°00'00"	150.00	235.62

LEGEND

LOT NUMBER
BLOCK NUMBER
CURVE NUMBER
LEGAL BOUNDARY
SETBACK
20' MIN. FRONT YARD
15' MIN. SIDE YARD
• SET SPIKE & BRASS TAG
RLS 2050
* REFERENCE TIES ARE BRASS CAP
MONUMENTS SET IN TOP OF CURB

SURVEYOR'S CERTIFICATE

THIS IS TO CERTIFY THAT THE MONUMENTS HAVE BEEN SET AND TIES
ESTABLISHED AS SHOWN HEREON.

Kay L. Adams
KAY L. ADAMS
REGISTERED LAND SURVEYOR
NEVADA CERTIFICATE NO. 2050

OAD

7/27/81

MONUMENT TIE MAP

THE BOOK 2

5-68⁸⁷BOOK 25 PAGE 90
058-2036-1