


I, GENE D. KRAMETBAUER, A PROFESSIONAL LAND SURVEYOR IN THE STATE OF NEVADA, DO HEREBY CERTIFY THAT THE MONUMENTS HAVE BEEN SET. THIS SURVEY WAS COMPLETED ON 9/16/93

GENE D. KRAMETBAUER, P.L.S.
NEVADA CERTIFICATION NO.: 6201

LOS PRADOS PHASE 1 - UNIT 2

A PORTION OF THE WEST HALF (W1/2) OF SECTION 36,
T.19S., R.60E., M.D.M.,
CITY OF LAS VEGAS, CLARK COUNTY, NEVADA.

MONUMENT TIE MAP

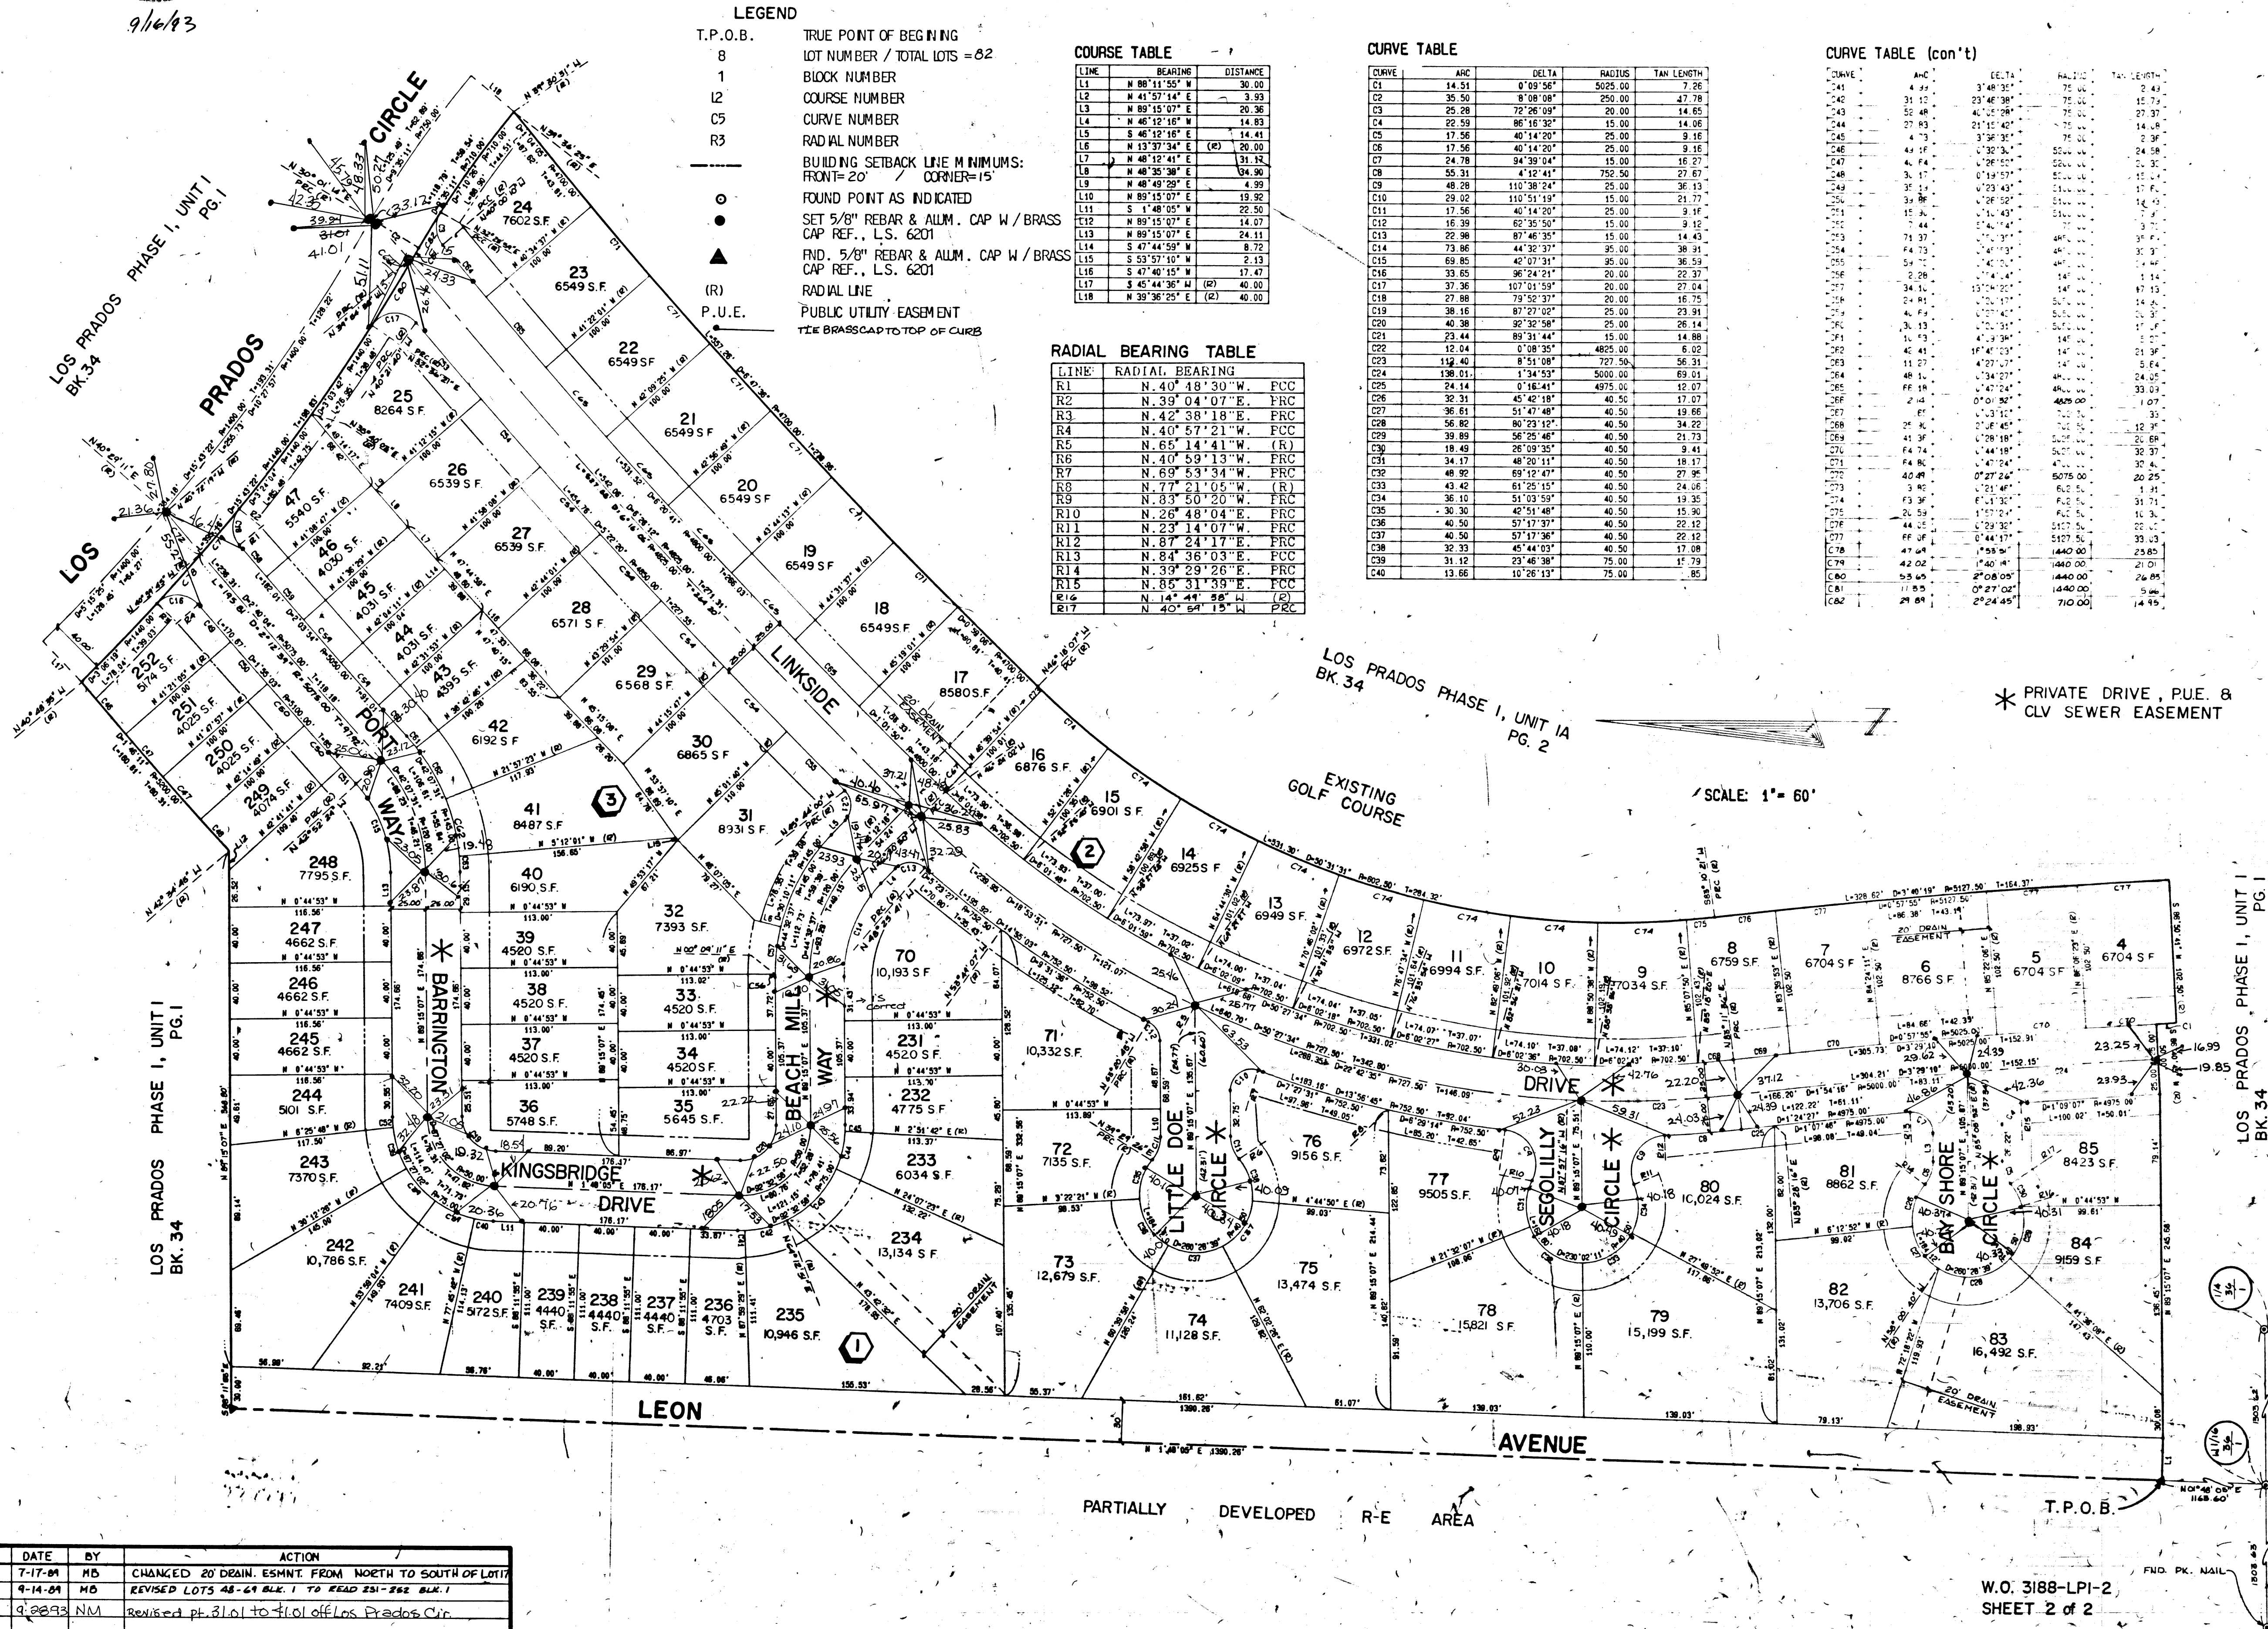

LOS PRADOS PHASE 1 - 2
CERTIFICATE OF AMENDMENT:
AMENDMENT SHOULD BE MADE TO OWNER'S CERTIFICATE:
WEST HILLS, INC., A NEVADA CORPORATION SHOULD BE CHANGED TO READ AS ANDREA
REAL ESTATE MANAGEMENT COMPANY, A DELAWARE CORPORATION

BOOK: 46
PAGE: 56
DATE: 6/28/90
CLARK COUNTY, NEVADA
JOAN L. SWIFT, RECORDER
VTR NEVADA
BOOK: 323-230
PAGE: 14117
BOOK: 323-230
PAGE: 81125
FEE: 6.00
CITY PLAT: 6.00
COMPUTED CORRECTIONS WILL BE CHARGED TO THE CLIENT.

5-6-72 BK. 45, PG. 11 58-2037-1-2