


8-6-27

# JONATHAN'S GLEN III

## (A RESIDENTIAL SUBDIVISION)


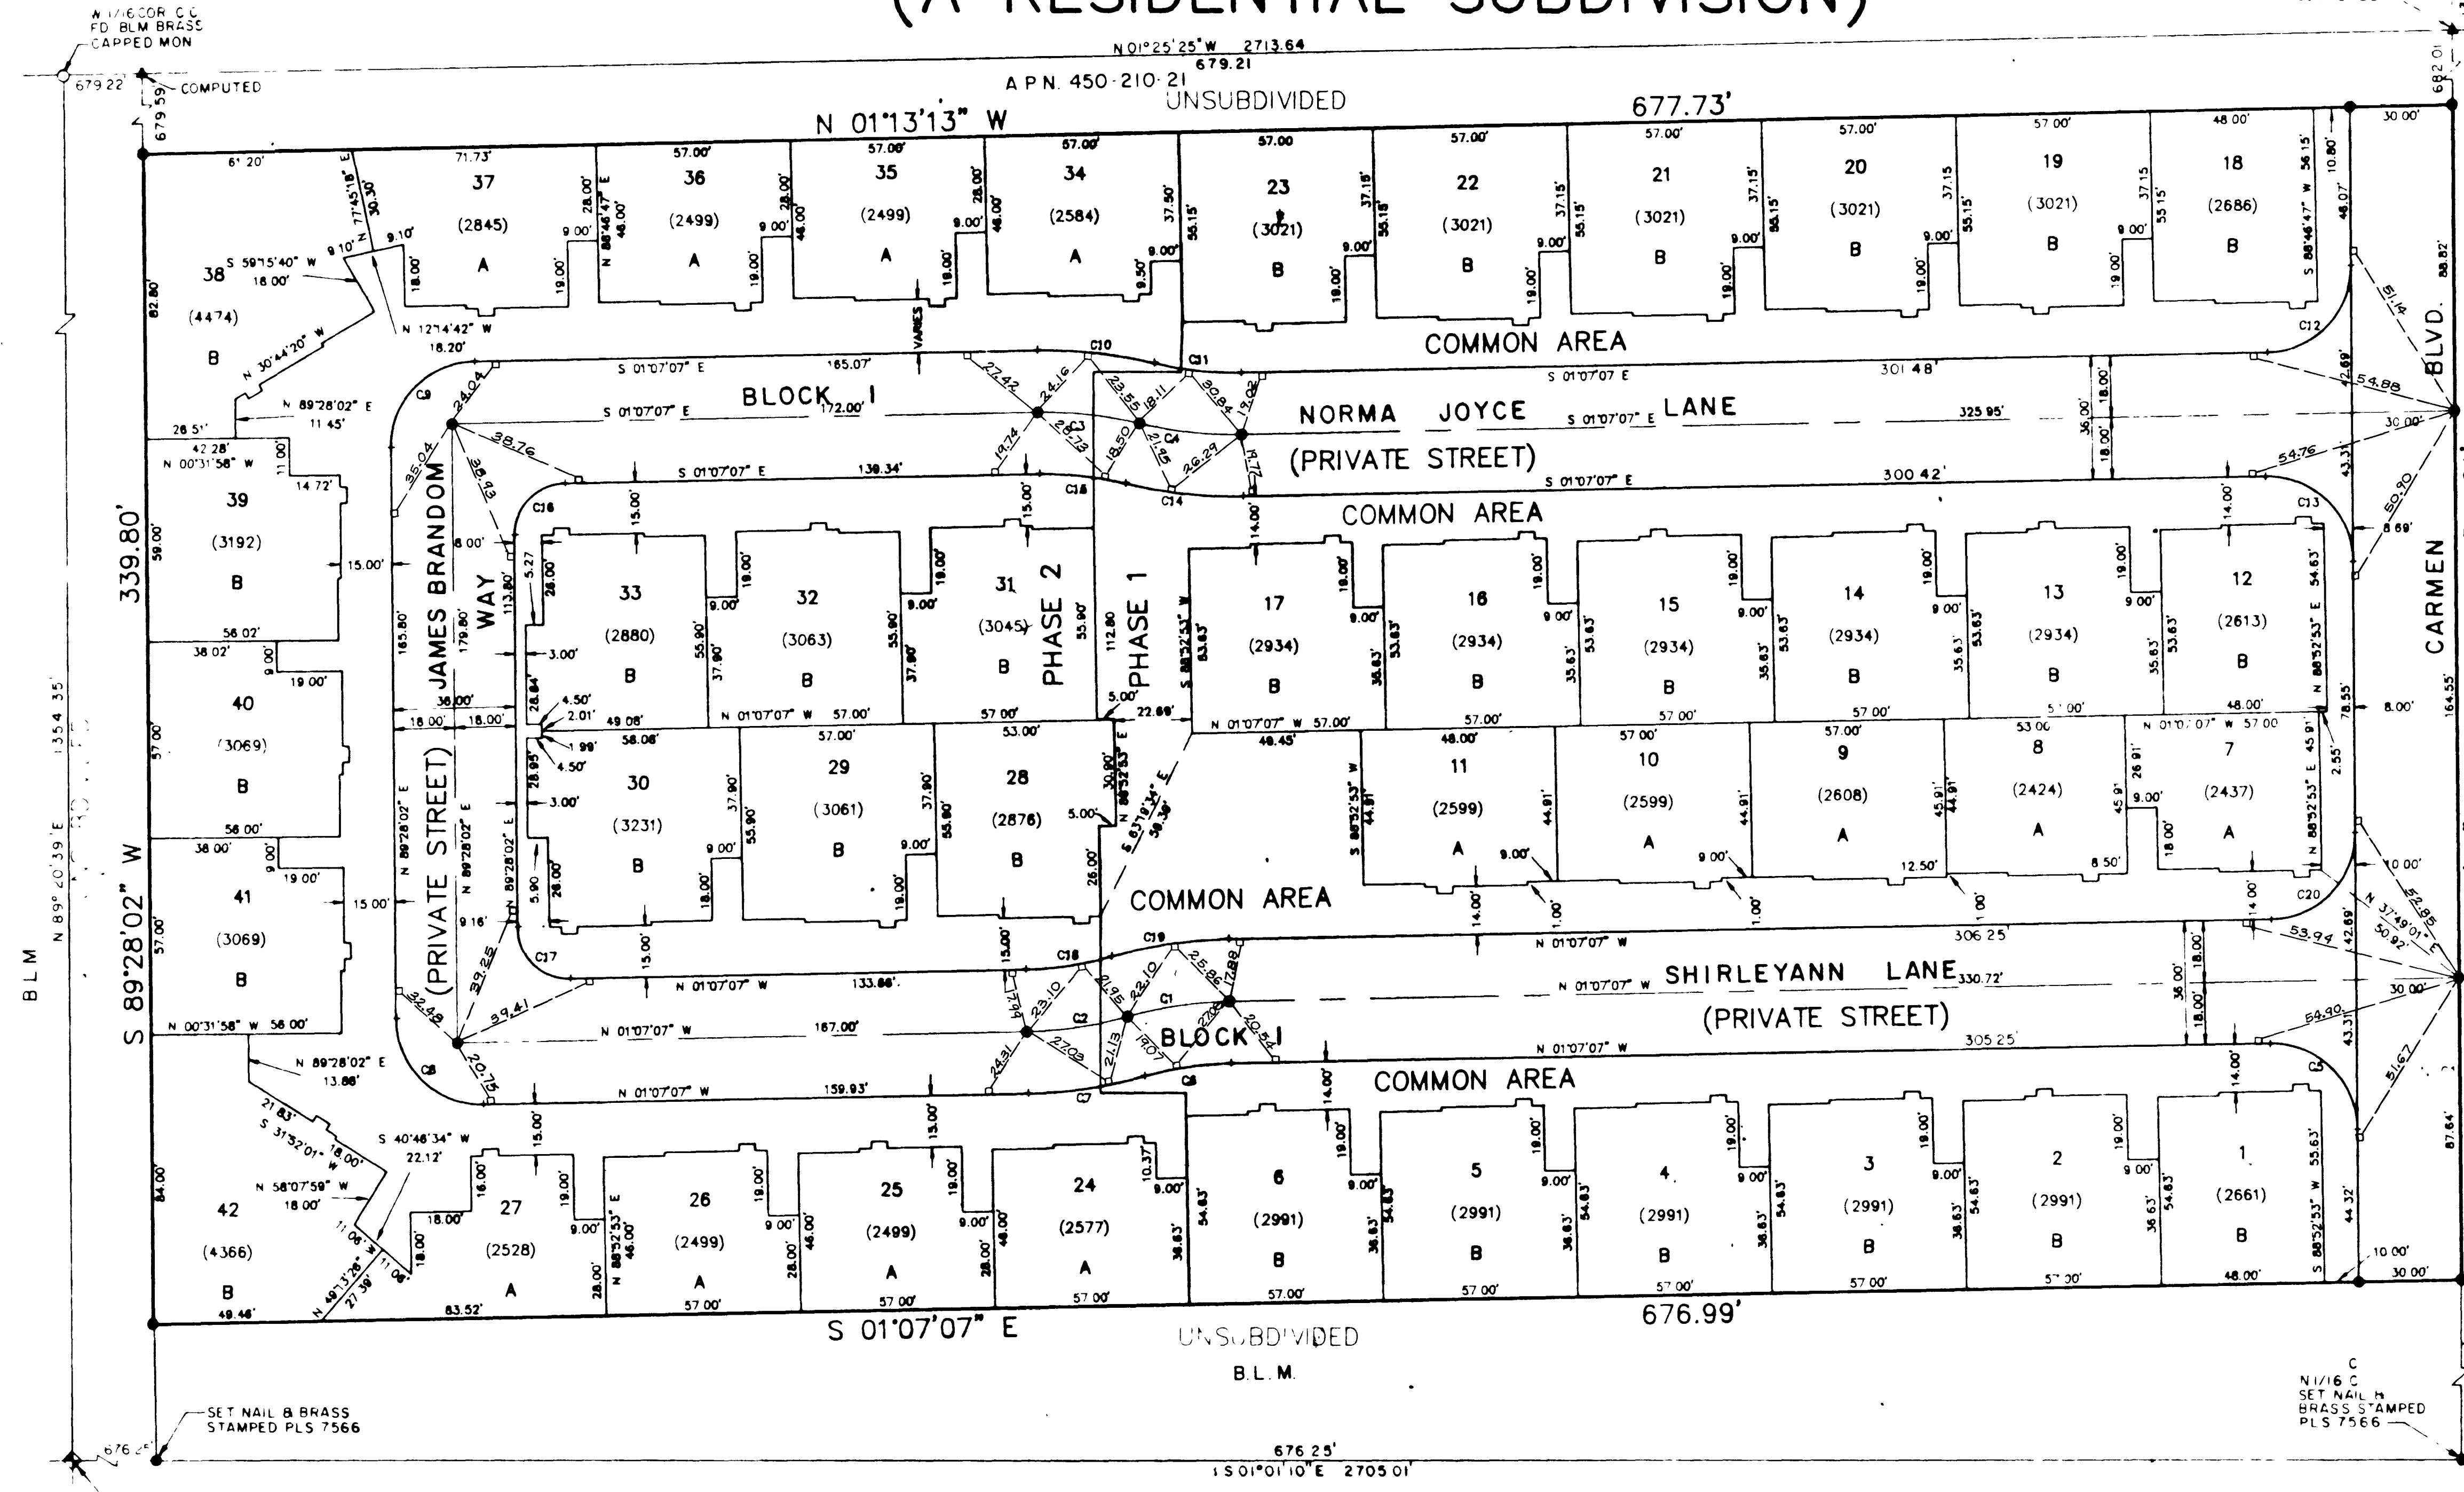


- LEGEND**
- MONUMENT
  - MONUMENT FOUND - AS DESCRIBED
  - 20 LOT NUMBER
  - (2000) AREA IN SQUARE FEET
  - A LOT TYPE DESIGNATION
  - ▲ COMPUTED POINT
  - TIE MONUMENT
- TOTAL AREA = 5.293 ACRES  
TOTAL NUMBER OF LOTS = 42

**COUNTY RECORDERS NOTE**  
ANY SUBSEQUENT CHANGES TO THIS MAP SHOULD BE EXAMINED AND MAY BE DETERMINED BY REFERENCE TO THE COUNTY RECORDERS CUMULATIVE MAP INDEX. (PER NRS 278.5695)

**BASIS OF BEARINGS**  
S 01°07'07" W BEING THE CENTER SECTION OF SECTION 28, TOWNSHIP 20 SOUTH, RANGE 80 EAST, M 2 W AS SHOWN ON FILE 42 PAGE 15 RECORD OF SURVEY, ON FILE IN THE CLARK COUNTY, NEVADA COURT HOUSE

CURVE	RADIUS	LENGTH	CHORD	BEARING	DELTA	TANGENT
C1	18.00	30.00	30.01	S 08°25'23" E	4.3812	15.13
C2	18.00	30.00	30.01	S 78°25'23" W	4.3812	15.13
C3	18.00	30.00	30.01	S 08°25'23" W	4.3800	15.12
C4	18.00	30.00	30.01	S 78°25'23" E	4.3800	15.12
C5	25.00	39.58	35.57	S 44°40'07" W	90°42'27"	20.08
C6	25.00	39.58	35.57	S 08°25'23" E	4.3812	12.76
C7	25.00	39.58	35.57	S 78°25'23" W	4.3812	12.76
C8	25.00	39.58	35.57	S 08°25'23" E	4.3812	12.76
C9	25.00	39.58	35.57	S 78°25'23" W	4.3812	12.76
C20	25.00	39.58	35.57	S 08°25'23" E	4.3812	12.76

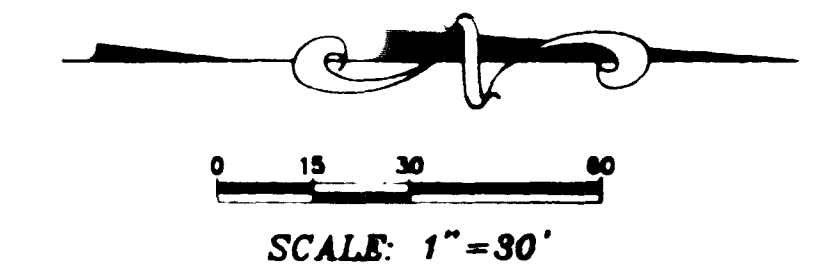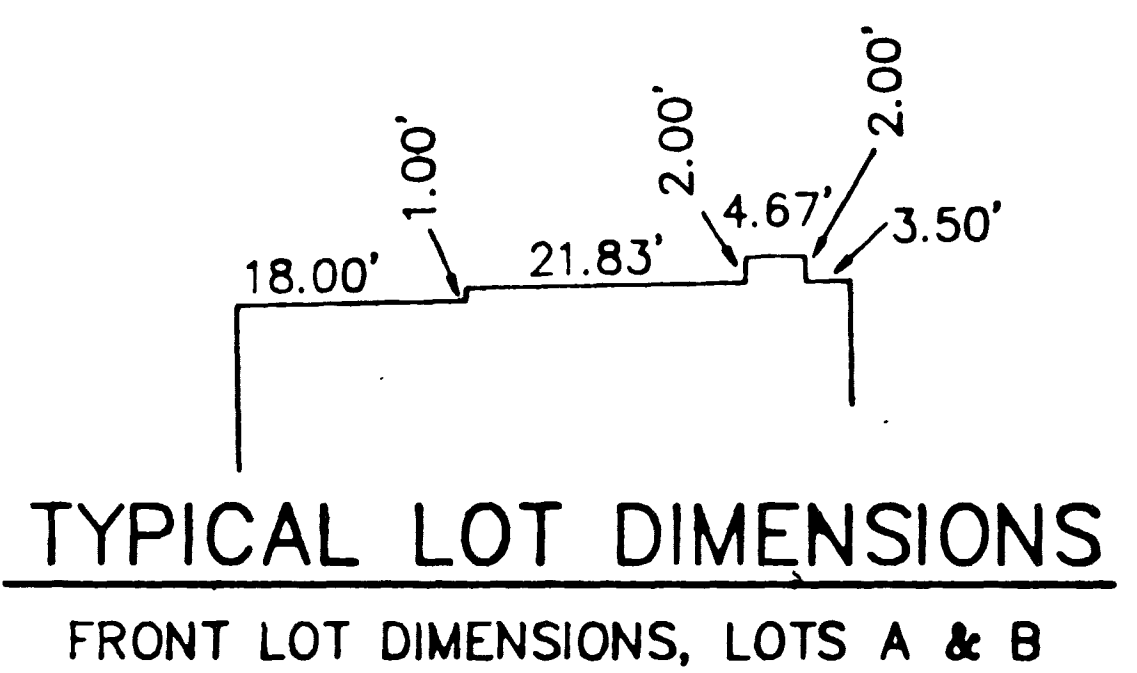

**CERTIFICATION**  
I, JACK H. NINNEMAN A PROFESSIONAL LAND SURVEYOR REGISTERED IN THE STATE OF NEVADA, DO HEREBY CERTIFY THAT THE MONUMENTS HAVE BEEN SET AND THE TIE DISTANCES ESTABLISHED AS SHOWN HEREON. THIS WAS COMPLETED ON 8-7-91

JACK H. NINNEMAN  
DATE: 9/17/91




OFFICIAL MONUMENT TIE MAP  
**JONATHAN'S GLEN III**  
(A RESIDENTIAL SUBDIVISION)  
SITUATED IN THE NORTHWEST 1/4 OF SECTION 28, TOWNSHIP 20 SOUTH, RANGE 80 EAST, M 2 W, LAS VEGAS, CLARK COUNTY, NEVADA.  
SHEET 2 OF 2

ROBINSON DALTON CONSULTING, INC.  
THE HANCO OFFICE CENTER  
3650 BATTERY DRIVE, SUITE 8  
LAS VEGAS, NEVADA 89169  
TELEPHONE 702-584-8788

058-4040-3

# JONATHAN'S GLEN III (A RESIDENTIAL SUBDIVISION)

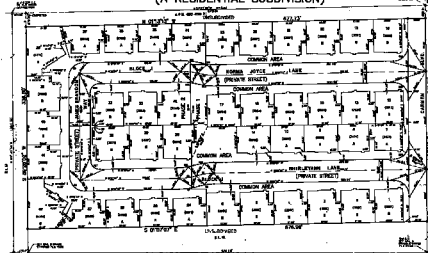

- LEGEND**





**TYPICAL LOT DIMENSIONS**  
 FRONT LOT DIMENSIONS, LOTS A & B





