


LOS PRADOS - PHASE 2, UNIT 3

A SUBDIVISION OF LOT 3 OF PARCEL MAP: FILE 51, PAGE 73
BEING A PORTION OF THE NORTHEAST QUARTER (NE 1/4) OF SECTION 36,
TOWNSHIP 19 SOUTH, RANGE 60 EAST, M.D.M., CITY OF LAS VEGAS, CLARK COUNTY, NEVADA.

MONUMENTATION TIE MAP

SCALE 1" = 50'

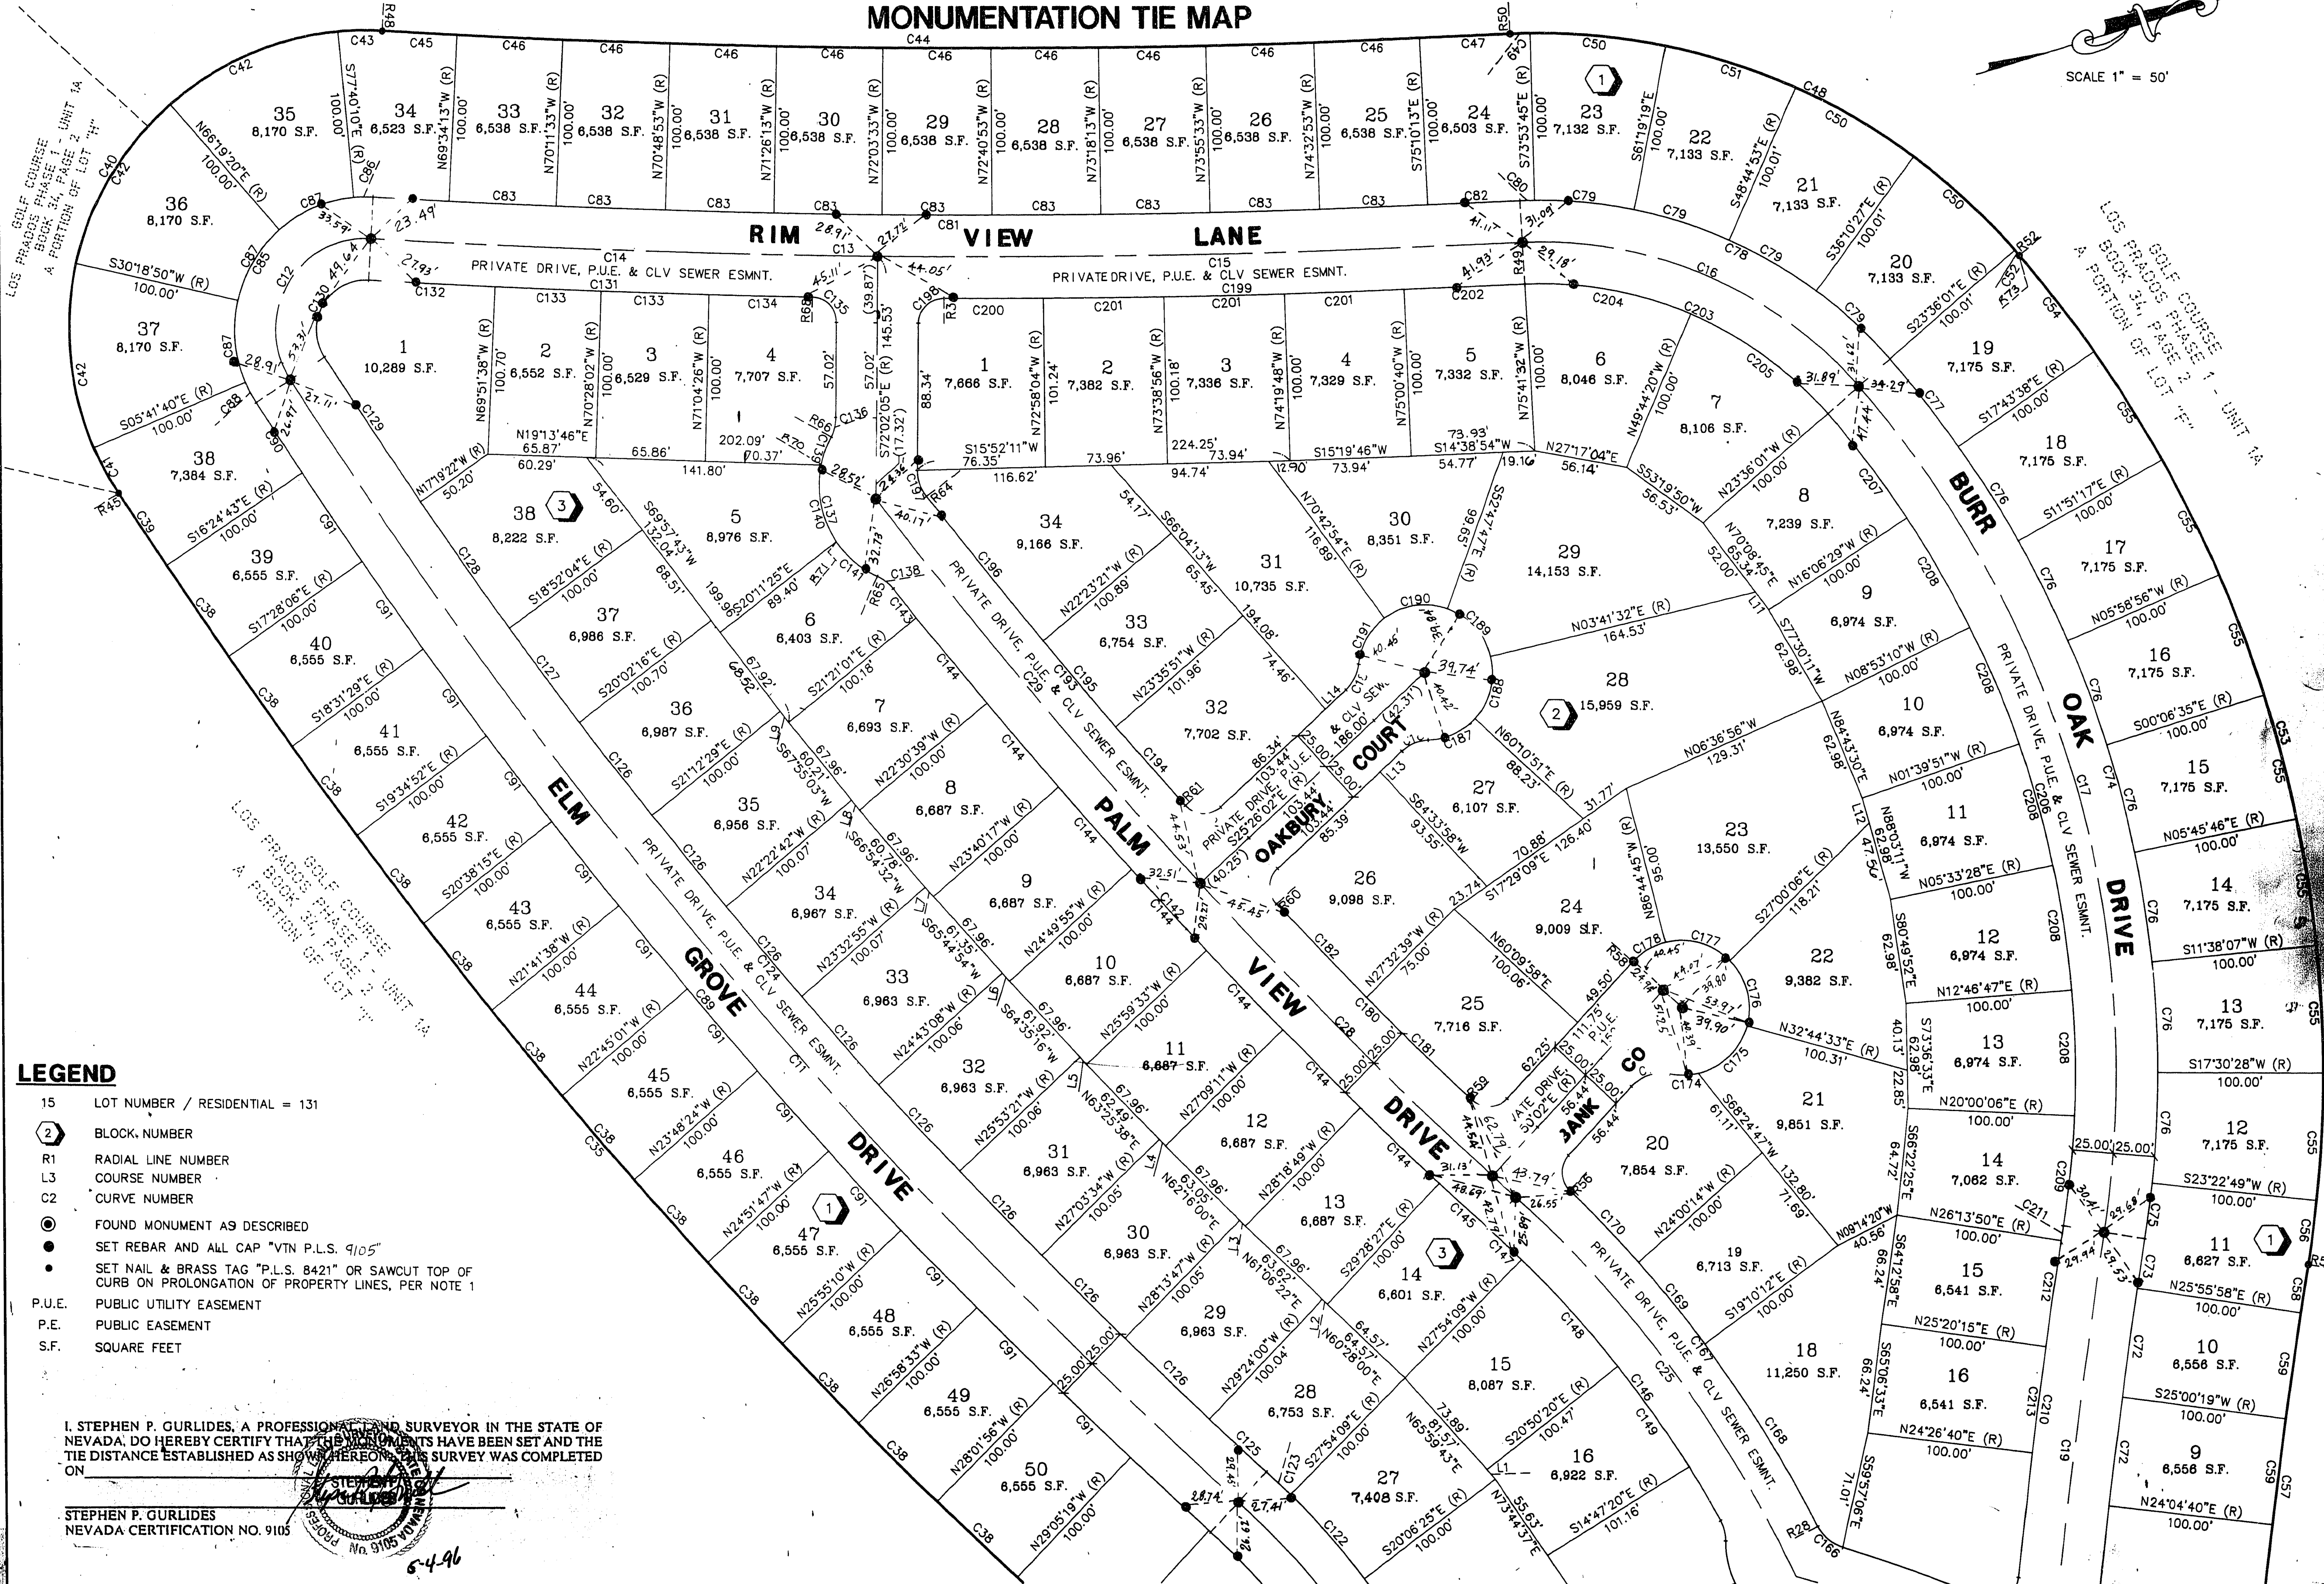

LEGEND

- 15 LOT NUMBER / RESIDENTIAL = 131
- 2 BLOCK, NUMBER
- R1 RADIAL LINE NUMBER
- L3 COURSE NUMBER
- C2 CURVE NUMBER
- FOUND MONUMENT AS DESCRIBED
- SET REBAR AND ALL CAP "VTN P.L.S. 9/05"
- SET NAIL & BRASS TAG "P.L.S. 8421" OR SAWCUT TOP OF CURB ON PROLONGATION OF PROPERTY LINES, PER NOTE 1
- P.U.E. PUBLIC UTILITY EASEMENT
- P.E. PUBLIC EASEMENT
- S.F. SQUARE FEET

I, STEPHEN P. GURLIDES, A PROFESSIONAL LAND SURVEYOR IN THE STATE OF NEVADA, DO HEREBY CERTIFY THAT THE MONUMENTS HAVE BEEN SET AND THE TIE DISTANCE ESTABLISHED AS SHOWN HEREON. THIS SURVEY WAS COMPLETED ON

STEPHEN P. GURLIDES
NEVADA CERTIFICATION NO. 9105

NOTE:

- 1) PURSUANT TO N.R.S. 278.371, ALL REAR LOT CORNERS SHALL BE SET WITH A NAIL AND BRASS TAG P.L.S. 8421 ON BLOCK WALL AND ALL FRONT OR SIDE LOT CORNERS ADJOINING RIGHT-OF-WAY SHALL BE MARKED BY THE SAWCUTTING OF THE BACK OF CURBS ON THE PROLONGATION OF THE PROPERTY LINES.

MATCH LINE SEE SHEET 3 OF 4

W.O. 3188-D7
SHEET 2 OF 4

DFD

10-6-2009 Book 64 Page 76 058-4116-2-3