


940304

01218

LOS PRADOS PHASE 2 - UNIT 5

BEING A PORTION OF THE NORTHEAST QUARTER (NE1/4) OF SECTION 36,
T.19 S., R.60 E., M.D.M., CITY OF LAS VEGAS, CLARK COUNTY, NEVADA.

MONUMENTATION TIE MAP

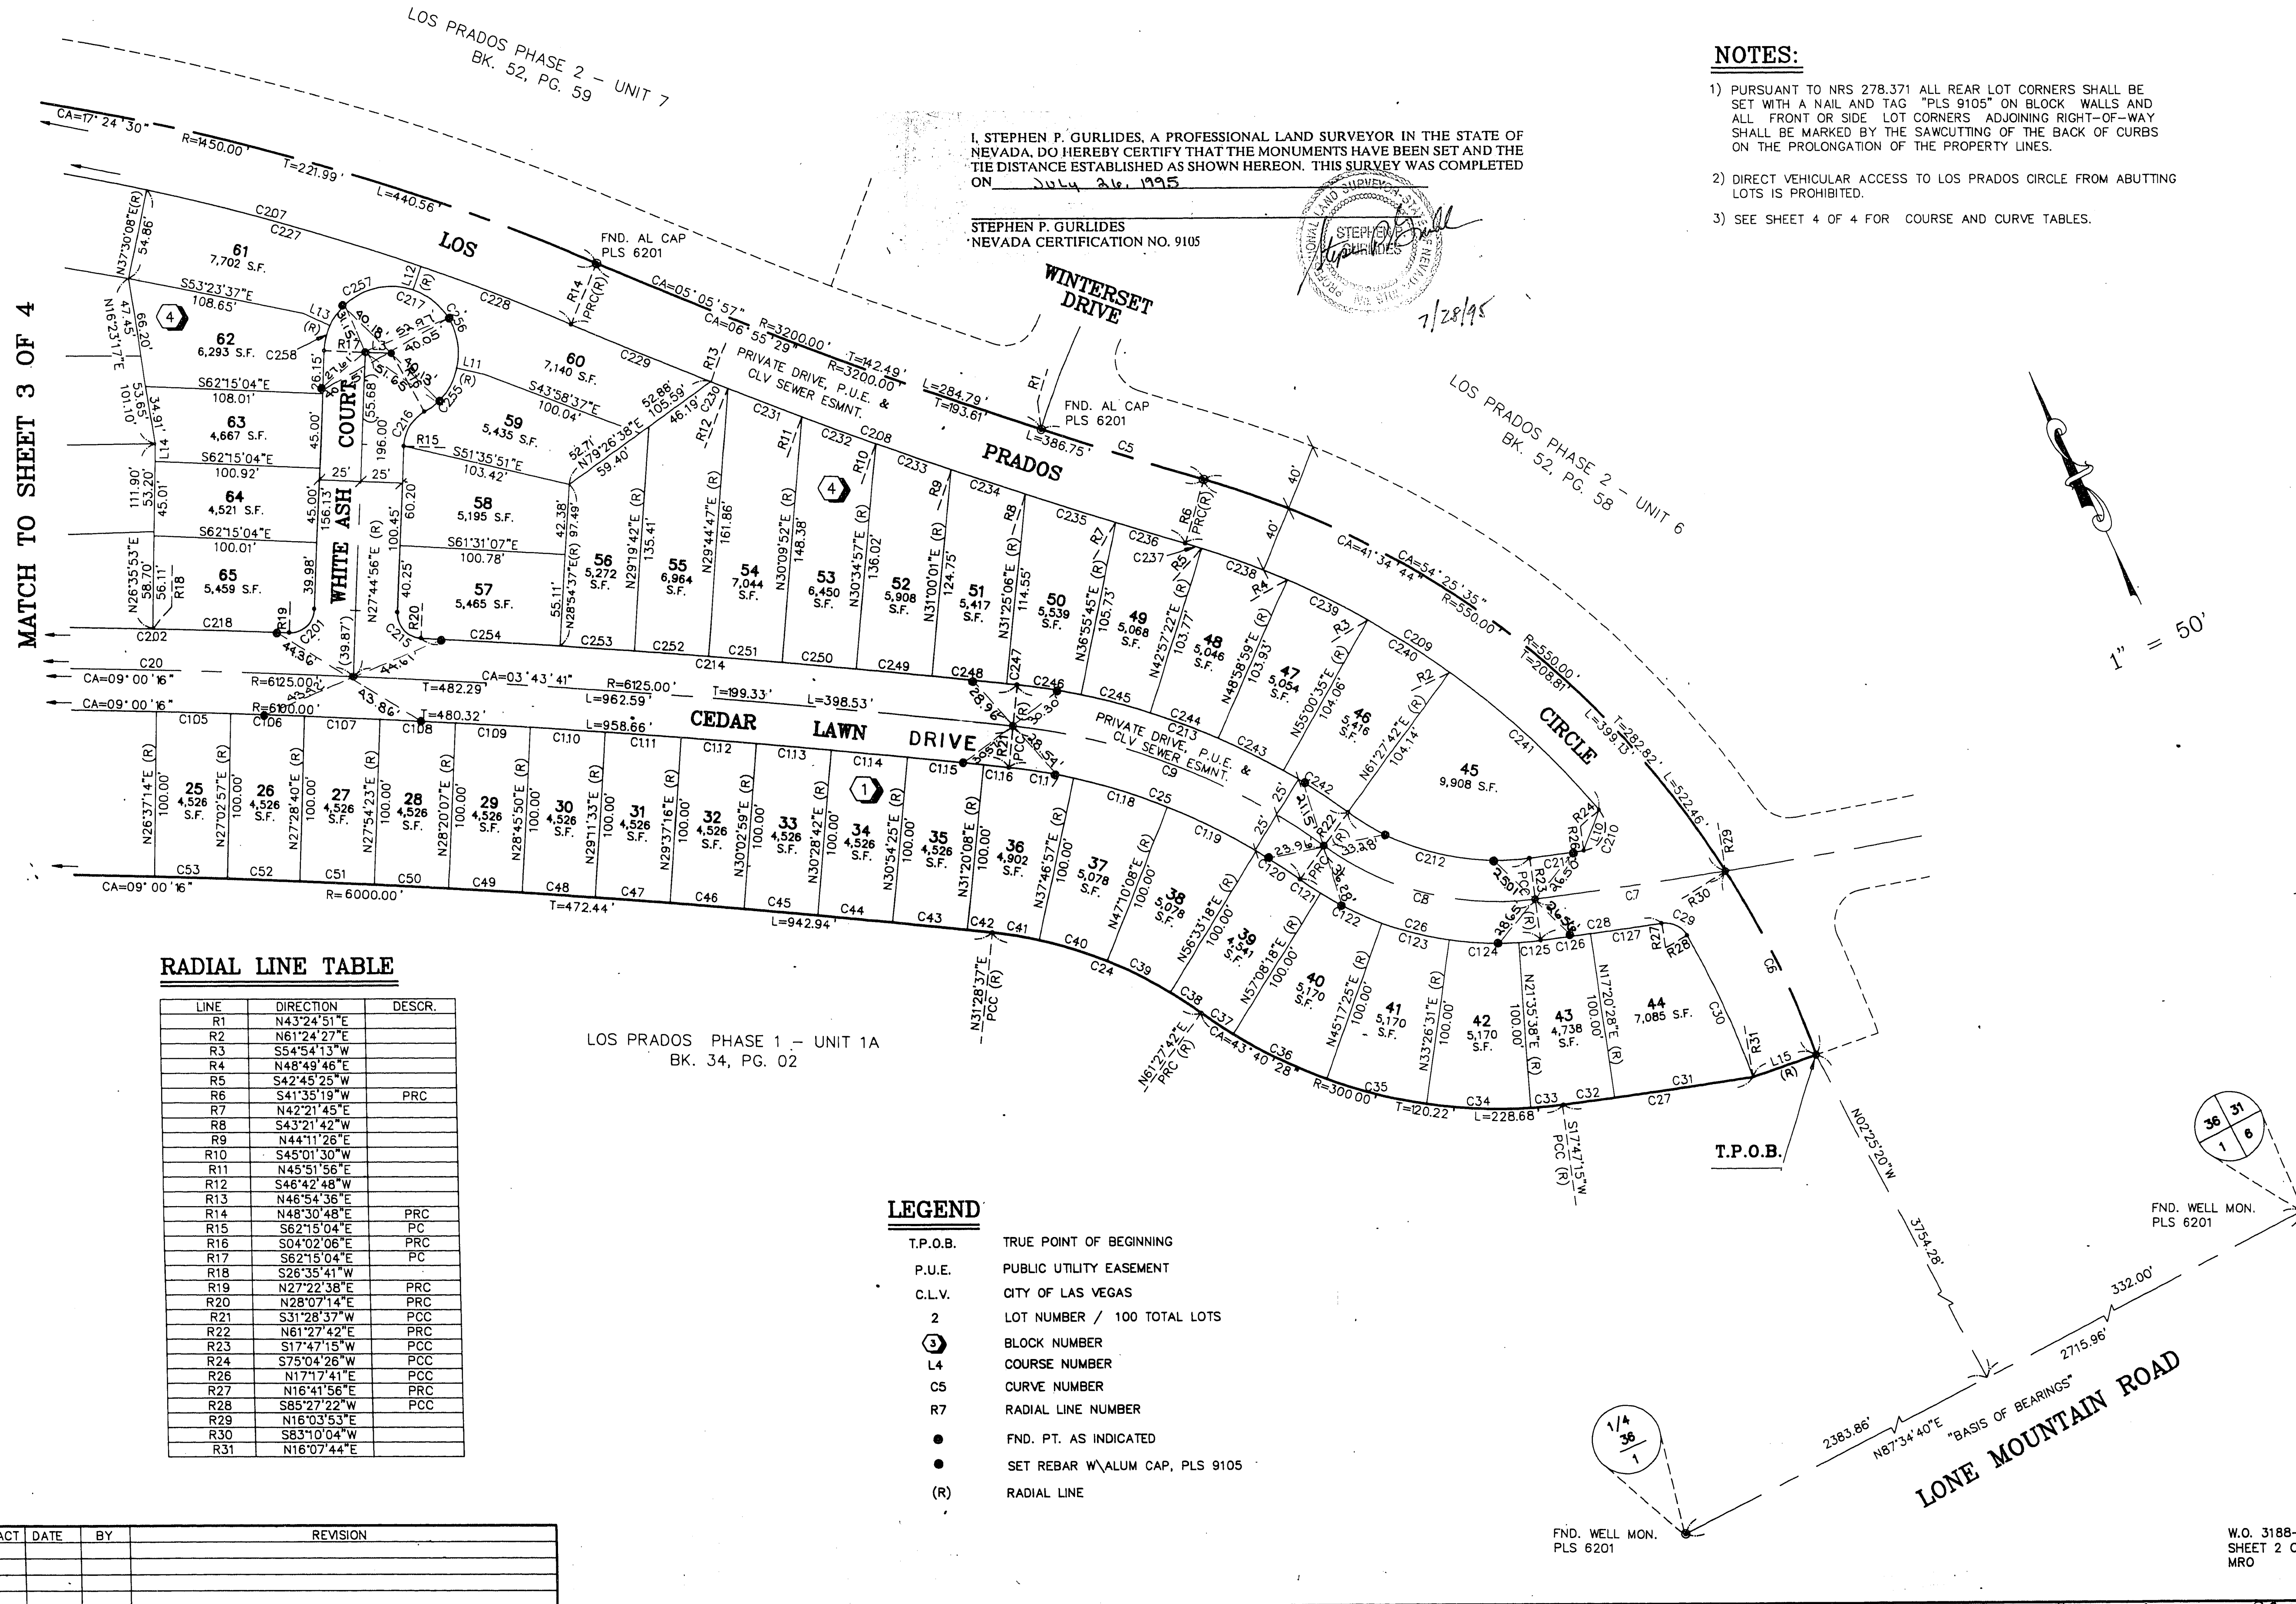


NOTES:

- 1) PURSUANT TO NRS 278.371 ALL REAR LOT CORNERS SHALL BE SET WITH A NAIL AND TAG "PLS 9105" ON BLOCK WALLS AND ALL FRONT OR SIDE LOT CORNERS ADJOINING RIGHT-OF-WAY SHALL BE MARKED BY THE SAWCUTTING OF THE BACK OF CURBS ON THE PROLONGATION OF THE PROPERTY LINES.
- 2) DIRECT VEHICULAR ACCESS TO LOS PRADOS CIRCLE FROM ABUTTING LOTS IS PROHIBITED.
- 3) SEE SHEET 4 OF 4 FOR COURSE AND CURVE TABLES.

I, STEPHEN P. GURLIDES, A PROFESSIONAL LAND SURVEYOR IN THE STATE OF NEVADA, DO HEREBY CERTIFY THAT THE MONUMENTS HAVE BEEN SET AND THE TIE DISTANCE ESTABLISHED AS SHOWN HEREON. THIS SURVEY WAS COMPLETED ON July 26, 1995

STEPHEN P. GURLIDES
NEVADA CERTIFICATION NO. 9105

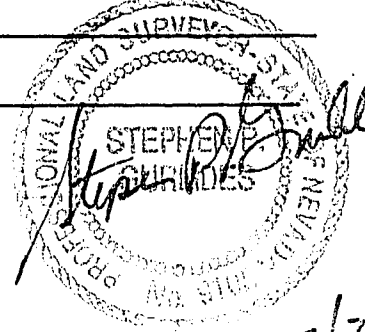

RADIAL LINE TABLE

LINE	DIRECTION	DESCR.
R1	N43°24'51"E	
R2	N61°24'27"E	
R3	S54°54'13"W	
R4	N48°49'46"E	
R5	S42°45'25"W	
R6	S41°35'19"W	PRC
R7	N42°21'45"E	
R8	S43°21'42"W	
R9	N44°11'26"E	
R10	S45°01'30"W	
R11	N45°51'56"E	
R12	S46°42'48"W	
R13	N48°54'36"E	
R14	N48°30'48"E	PRC
R15	S62°15'04"E	PC
R16	S04°02'06"E	PRC
R17	S62°15'04"E	PC
R18	S26°35'41"W	
R19	N27°22'38"E	PRC
R20	N28°07'14"E	PRC
R21	S31°28'37"W	PCC
R22	N61°27'42"E	PRC
R23	S17°47'15"W	PCC
R29	N16°03'53"E	
R30	S83°10'04"W	
R31	N16°07'44"E	

LEGEND

- T.P.O.B. TRUE POINT OF BEGINNING
- P.U.E. PUBLIC UTILITY EASEMENT
- C.L.V. CITY OF LAS VEGAS
- 2 LOT NUMBER / 100 TOTAL LOTS
- 3 BLOCK NUMBER
- L4 COURSE NUMBER
- C5 CURVE NUMBER
- R7 RADIAL LINE NUMBER
- FND. PT. AS INDICATED
- SET REBAR W/ALUM CAP, PLS 9105
- (R) RADIAL LINE

ACT	DATE	BY	REVISION

10-6-206 BOOK 60 PAGE 80
058-416-2-5