

920414

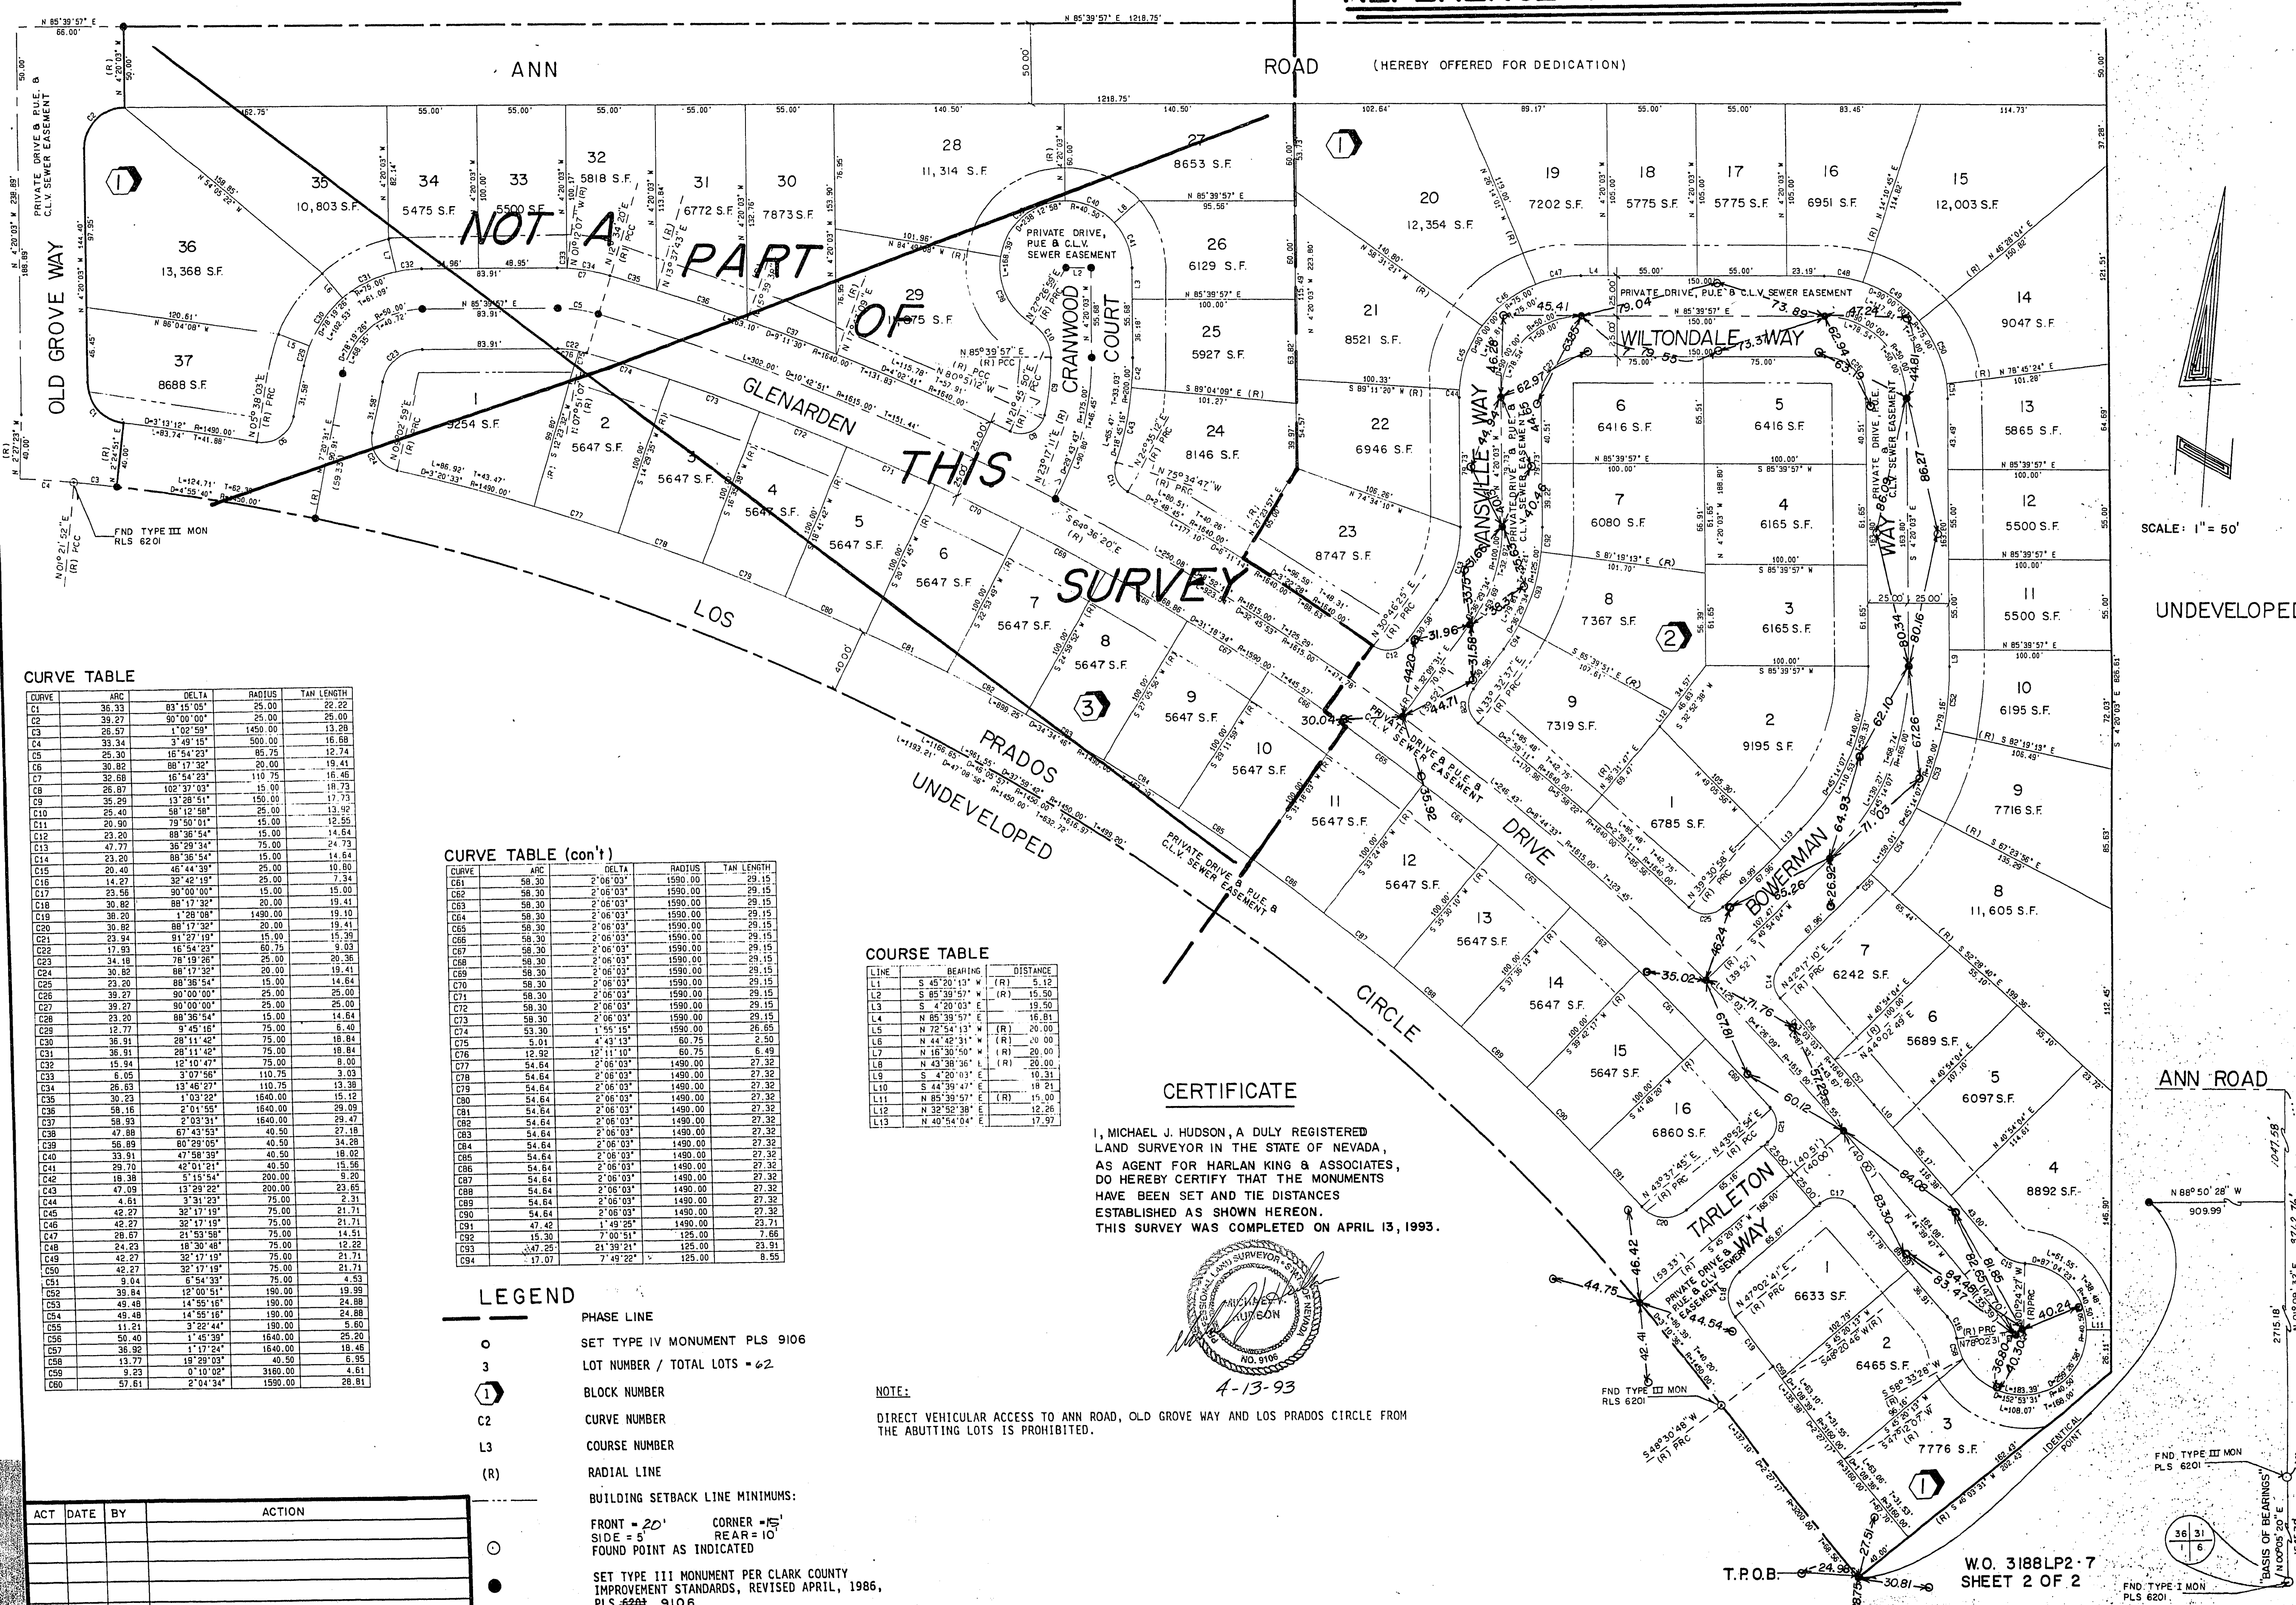
00807

LOS PRADOS PHASE 2 - UNIT 7

A POR. OF THE NE1/4 OF SEC. 36, T. 19 S., R. 60 E., M.D.M.,
CITY OF LAS VEGAS, CLARK COUNTY, NEVADA.

UNDEVELOPED

REFERENCE MONUMENT TIE MAP

BOOK 52 PAGE 59
058-4116-2-7