

LOS PRADOS - PHASE 2 UNIT 8


MONUMENTATION TIE MAP

BEING ALL THE AREA AS SHOWN ON REVERSIONARY PARCEL MAP: FILE 81, PAGE 31, LOCATED IN THE NORTHWEST QUARTER (NW 1/4) OF SECTION 36, TOWNSHIP 19 SOUTH, RANGE 80 EAST, M.D.M., CITY OF LAS VEGAS, CLARK COUNTY, NEVADA

I, STEPHEN P. GURLIDES, A PROFESSIONAL LAND SURVEYOR IN THE STATE OF NEVADA, DO HEREBY CERTIFY THAT THE MONUMENTS HAVE BEEN SET AND THE TIE DISTANCES ESTABLISHED AS SHOWN HEREON. THIS SURVEY WAS COMPLETED ON:

STEPHEN P. GURLIDES
NEVADA CERTIFICATION
No. 9105


2-9-98

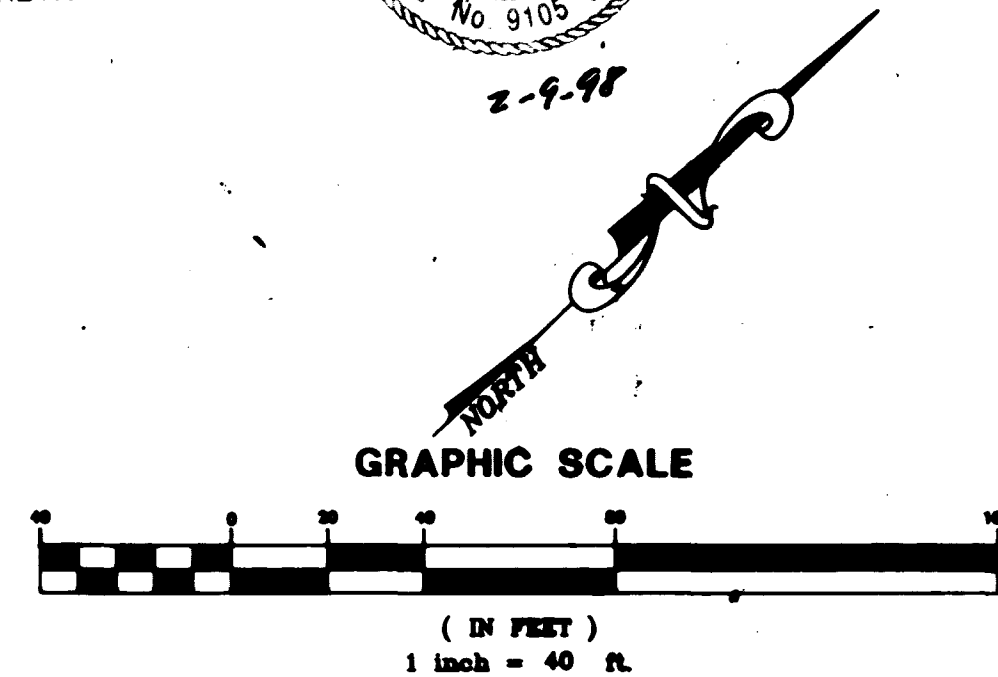


LEGEND

- 15 LOT NUMBER / RESIDENTIAL = 80
- 2 BLOCK NUMBER
- R1 RADIAL LINE NUMBER
- L3 COURSE NUMBER
- C2 CURVE NUMBER
- FOUND MONUMENT AS DESCRIBED
- SET 5/8" REBAR & AL. CAP "VTN PLS 9105"
- ▲ SET NAIL & BRASS TAG "VTN PLS 9105" OR SAWCUT TOP OF CURB ON THE PROLONGATION OF PROPERTY LINES PER NOTE 1 THIS SHEET.
- P.U.E. PUBLIC UTILITY EASEMENT
- S.F. SQUARE FEET
- CENTERLINE
- LOT LINE
- BOUNDARY LINE
- RIGHT-OF-WAY LINE

DETAIL NO. 1 NOT TO SCALE

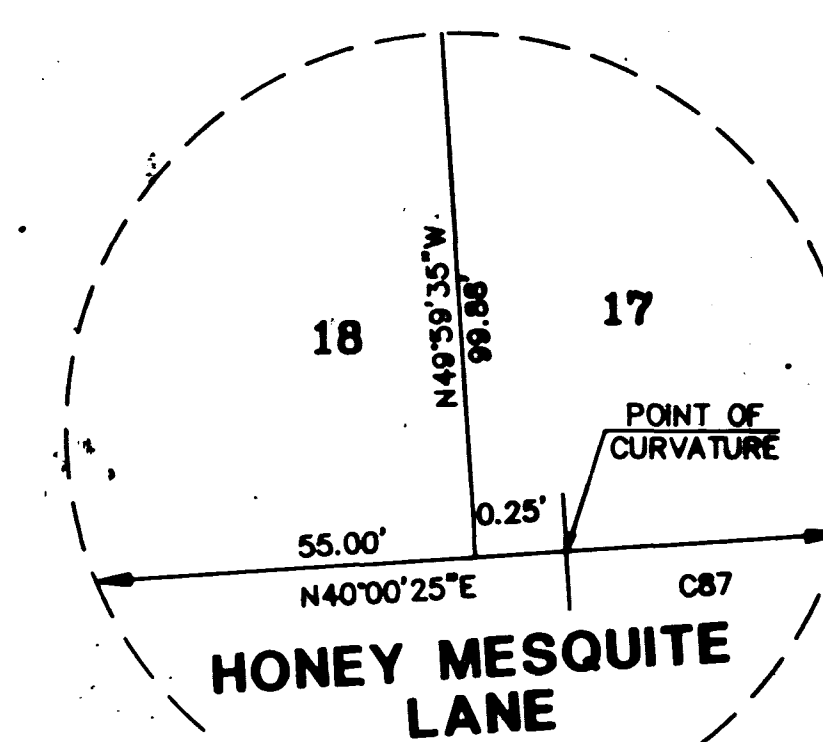

DETAIL NO. 2 NOT TO SCALE

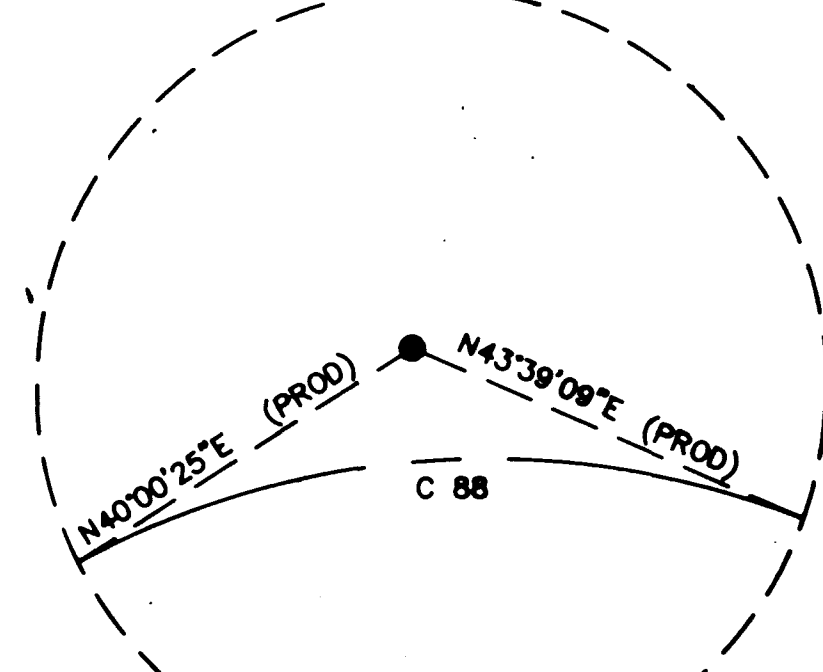

SEE SHEET 3 FOR CONTINUATION OF THIS AREA

NOTES

1. DIRECT VEHICULAR ACCESS TO LOS PRADOS CIRCLE FROM ADJUTING LOTS IS PROHIBITED.
2. ALL REAR LOT CORNERS SHALL BE SET WITH A NAIL AND BRASS TAG P.L.S. 9105 ON BLOCK WALL AND ALL FRONT OF SIDE LOT CORNERS ADJOINING RIGHT-OF-WAY SHALL BE MARKED BY THE SAWCUTTING OF THE BACK OF CURBS ON THE PROLONGATION OF THE PROPERTY LINES.

W.O. 3188-D16-A1
SHEET 2 OF 4
VCL/T.H.

