

LOS PRADOS - PHASE 2 UNIT 8

BEING ALL THE AREA AS SHOWN ON REVERSIONARY PARCEL MAP: FILE 81, PAGE 31, LOCATED IN THE NORTHWEST QUARTER (NW 1/4) OF SECTION 36, TOWNSHIP 19 SOUTH, RANGE 60 EAST, M.D.M., CITY OF LAS VEGAS, CLARK COUNTY, NEVADA

MONUMENTATION TIE MAP

I, STEPHEN P. GURILDES, A PROFESSIONAL LAND SURVEYOR IN THE STATE OF NEVADA, DO HEREBY CERTIFY THAT THE MONUMENTS HAVE BEEN SET AND THE TIE DISTANCES ESTABLISHED AS SHOWN HEREON. THIS SURVEY WAS COMPLETED ON 9/26/95.
 STEPHEN P. GURILDES
 NEVADA CERTIFICATION NO. 9105



SEE SHEET 2 FOR CONTINUATION OF THIS AREA



LEGEND

- 15 LOT NUMBER / RESIDENTIAL = 80
- 2 BLOCK NUMBER
- R1 RADIAL LINE NUMBER
- L3 COURSE NUMBER
- C2 CURVE NUMBER
- FOUND MONUMENT AS DESCRIBED
- SET 5/8" REBAR & AL CAP "VTN PLS 9105"
- ▲ SET NAIL & BRASS TAG "VTN PLS 9105" OR SAWCUT TOP OF CURB ON THE PROLONGATION OF PROPERTY LINES PER NOTE 1 THIS SHEET.
- P.U.E. PUBLIC UTILITY EASEMENT
- S.F. SQUARE FEET
- CENTERLINE
- LOT LINE
- BOUNDARY LINE
- RIGHT-OF-WAY LINE

DETAIL NO. 3
NOT TO SCALE

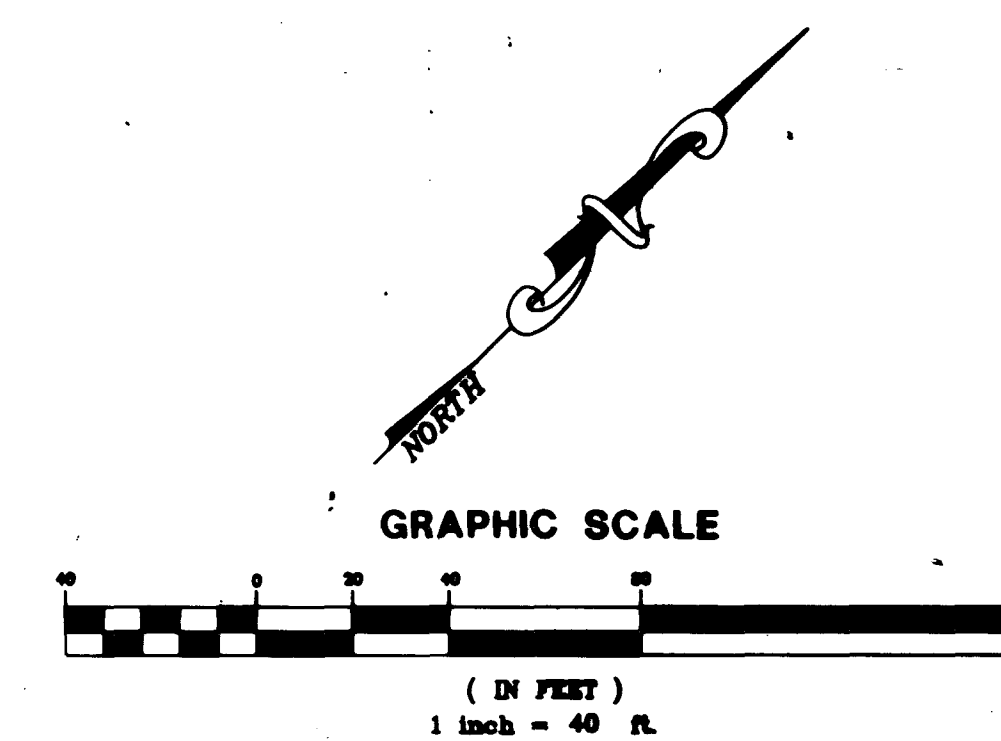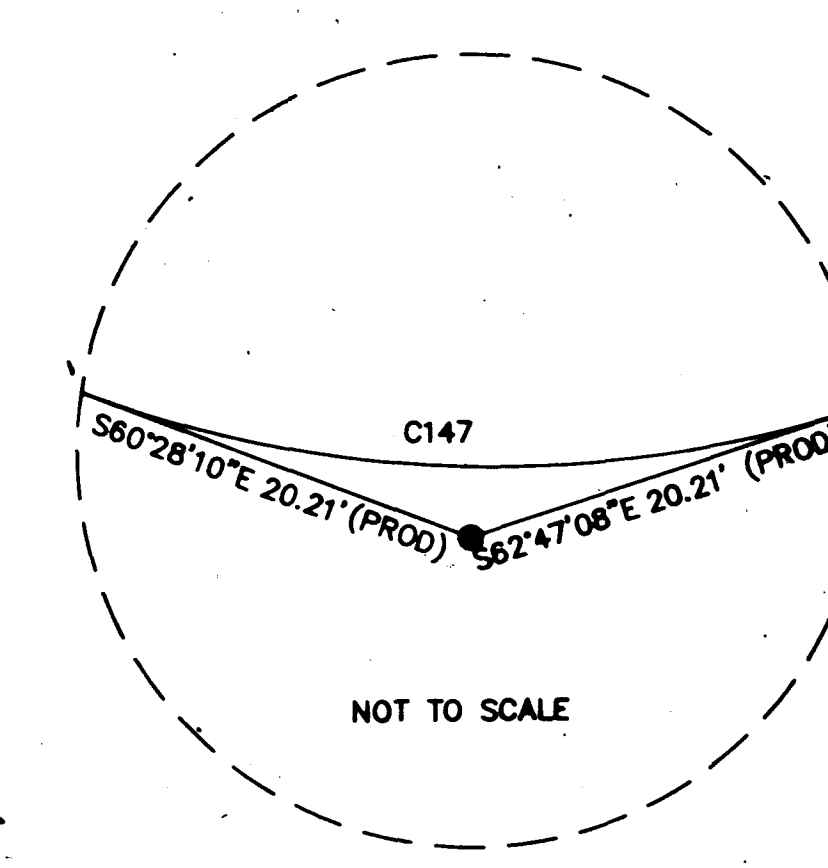

NOTES

1. DIRECT VEHICULAR ACCESS TO LOS PRADOS CIRCLE FROM ABUTTING LOTS IS PROHIBITED.
2. ALL REAR LOT CORNER SHALL BE SET WITH A NAIL AND BRASS TAG P.L.S. 9105 ON BLOCK WALL AND ALL FRONT OF SIDE LOT CORNERS ADJOINING RIGHT-OF-WAY SHALL BE MARKED BY THE SAWCUTTING OF THE BACK OF CURBS ON THE PROLONGATION OF THE PROPERTY LINES.

ACT	DATE	BY	REVISION
1	9/26/95	TZ	REV. LOTS 5,6,8,10,11,12,14,15

EXISTING LOS PRADOS GOLF COURSE
BOOK 34, PAGE 2

W.O. 3188-D16-A1
SHEET 3 OF 4
VCL/T.H.

2623

Book 73 Page 51 058-4116-28

