


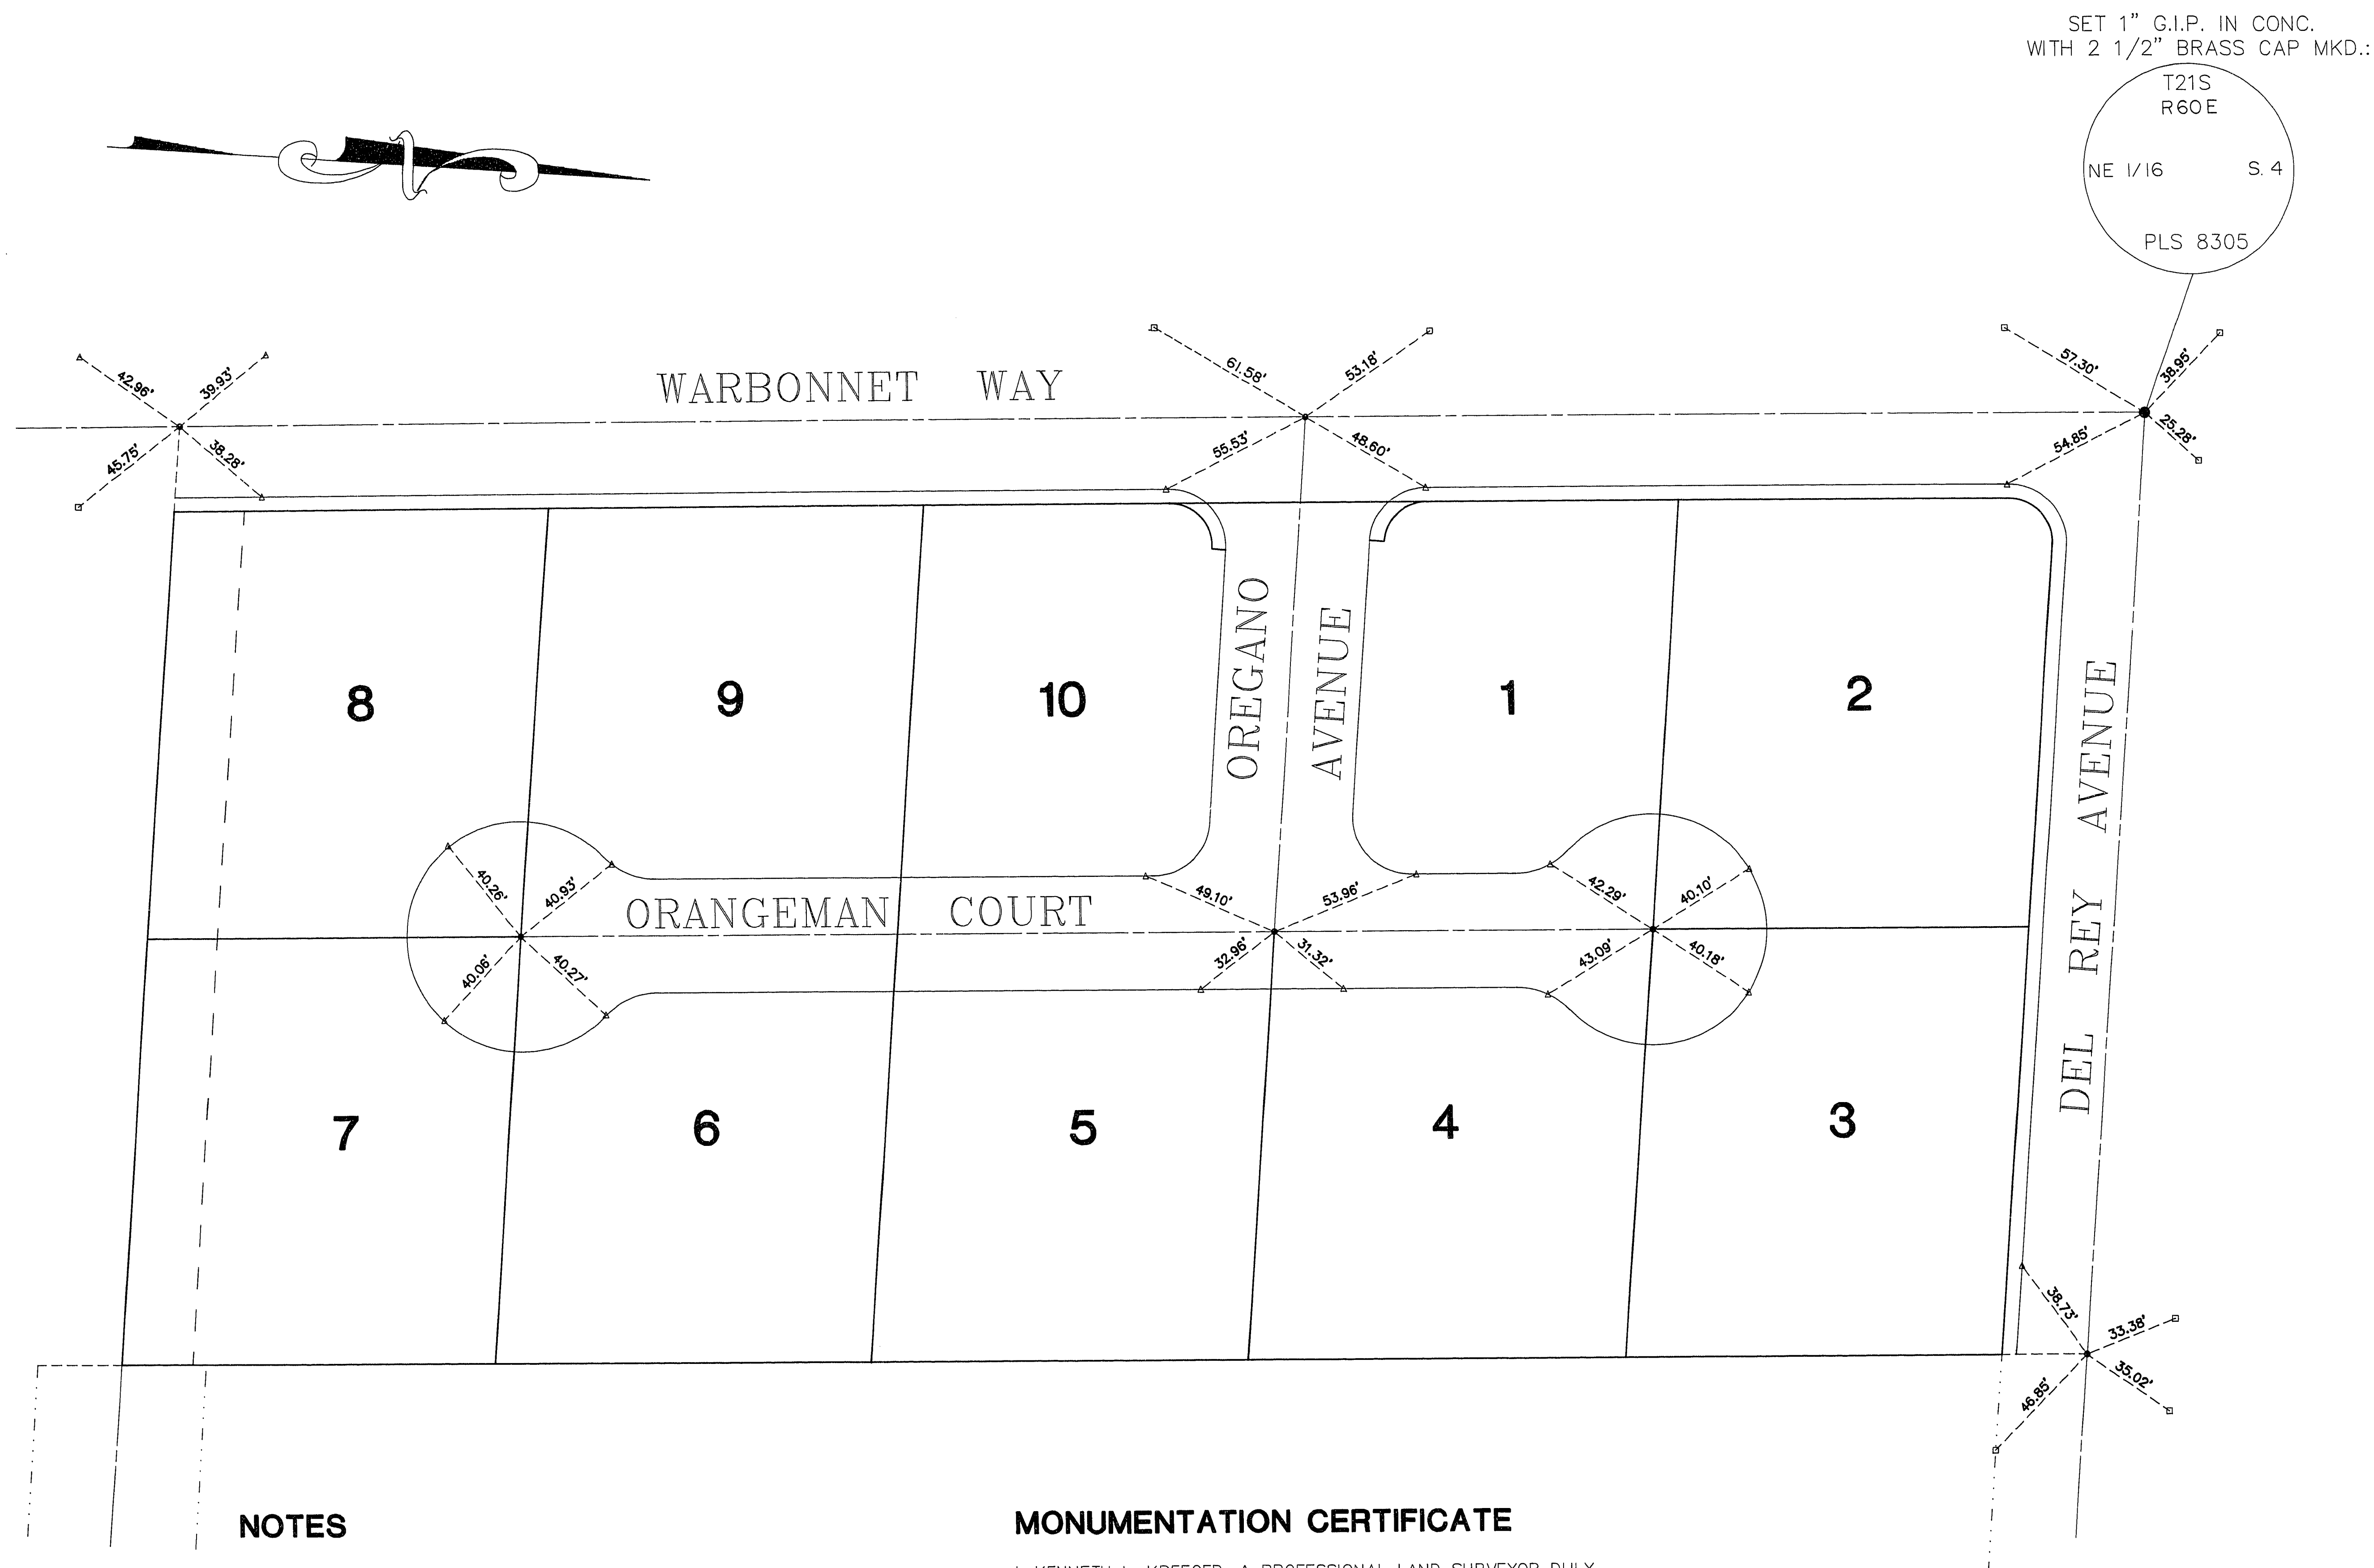

NOTES

JUSTINE COURT FINAL MAP RECORDED IN BOOK 48 AT PAGE 25 OF PLATS, OFFICIAL RECORDS OF CLARK COUNTY, NEVADA.

LEGEND

- SET 5/8" ALUM. CAP P.L.S. 8305 UNLESS OTHERWISE NOTED
- ▲ SET 1 3/8" BRASS CAP REFERENCE MONUMENT SET IN TOP OF CURB PLS 8305
- ◻ SET 5/8" REBAR AND ALUM. CAP REF. MON. PLS 8305

MONUMENTATION CERTIFICATE

I, KENNETH L. KREEGER, A PROFESSIONAL LAND SURVEYOR DULY REGISTERED IN THE STATE OF NEVADA, DO HEREBY CERTIFY THAT THE MONUMENTS HAVE BEEN SET AND THE TIE DISTANCES ESTABLISHED ARE AS SHOWN HEREON.

THIS SURVEY WAS COMPLETED ON OR PRIOR TO OCTOBER 22, 1991

Kenneth L. Kreeger
KENNETH L. KREEGER, P.L.S. 8305

Kenneth L. Kreeger

10-22-91

SET 1" G.I.P. IN CONC.
WITH 2 1/2" BRASS CAP MKD.:

T21S
R60E
NE 1/16 S. 4
PLS 8305

REVISION DESCRIPTION	
NO.	DATE
BY	
DATE	
SOUTHWEST ENGINEERING LAND PLANNING-MAPPING-DEVELOPMENT 3465 WEST VEGAS DRIVE LAS VEGAS, NEVADA 89102 PHONE (702) 648-9700	
TITLE MONUMENTATION LOCATION MAP	
PROJECT JUSTINE COURT	
WORK ORDER NO. 900228	
DESIGN BY R. BLACK	
DATE SEPTEMBER 4, 1990	
SCALE 1" = 30'	
SHEET OF 5 SHEETS	

10-643

058-4143