


MONUMENT TIE MAP

CITY OF LAS VEGAS, CLARK COUNTY, NEVADA.

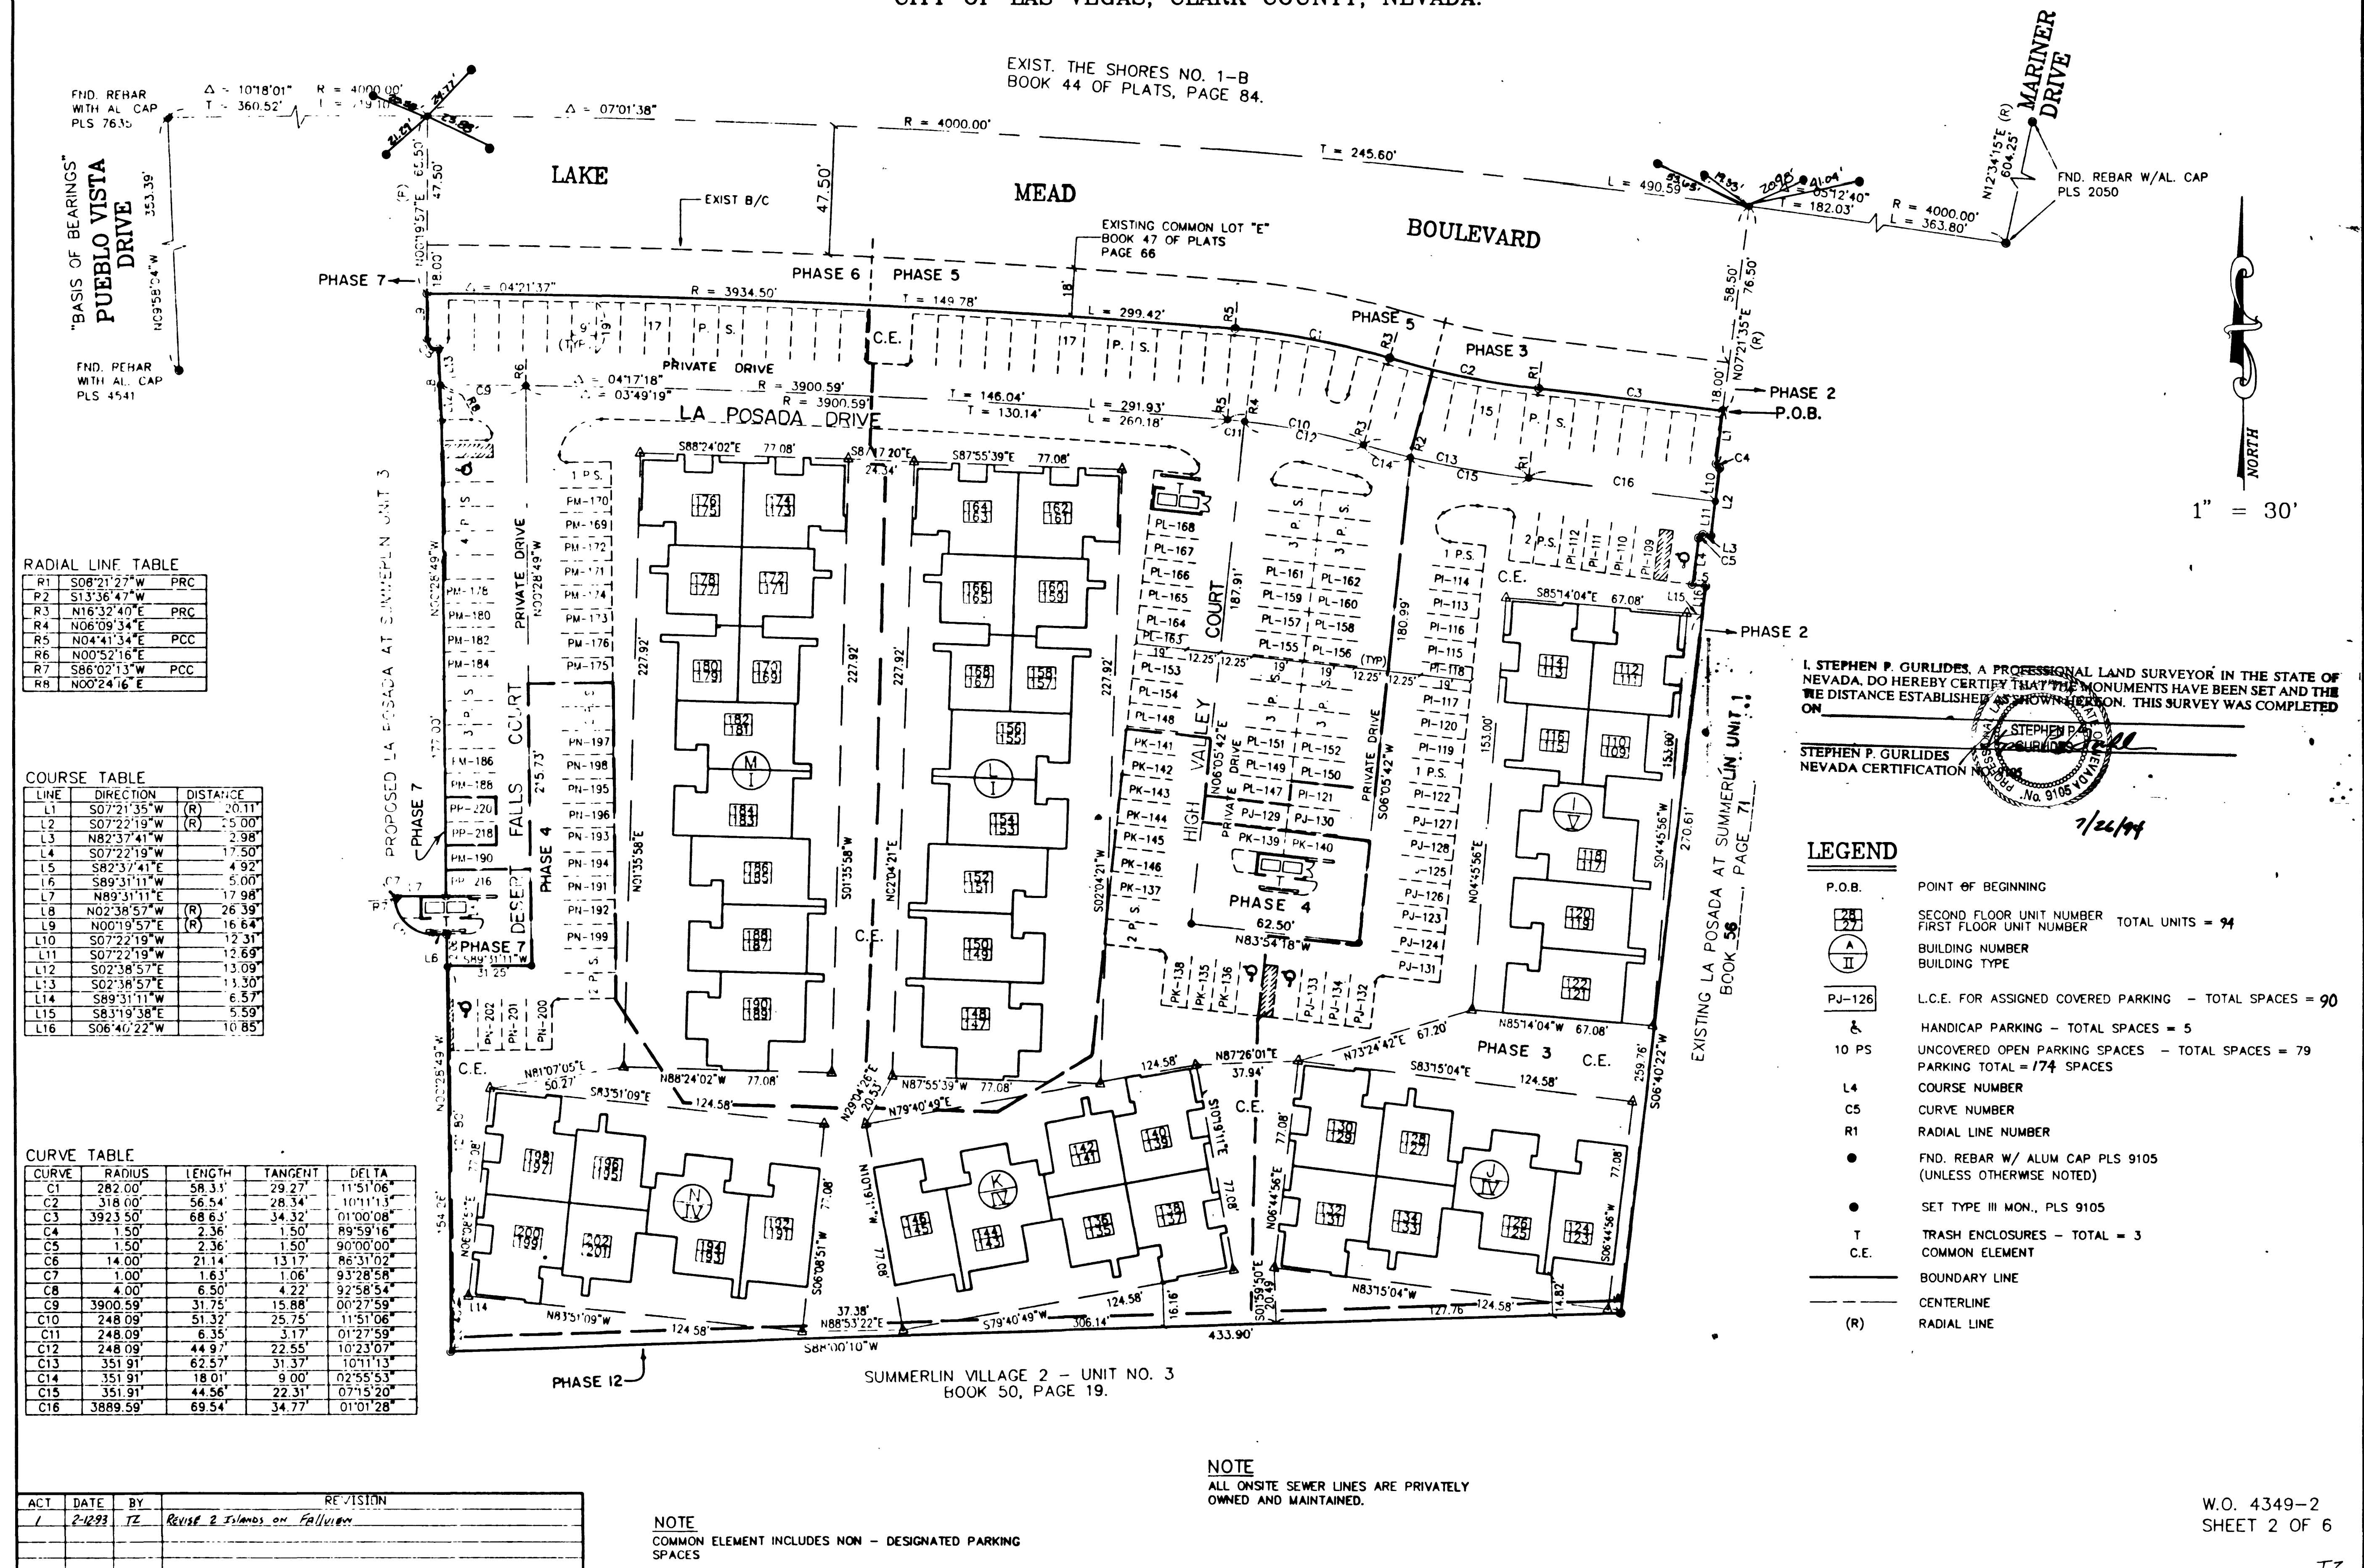

3043

11-6-141 Book 57 PAGE 1
058-4251-2

Z.

