

940382

01217

LEGENDS WEST CONDOMINIUMS UNIT 1

BEING A PORTION OF PARCEL 2 AS SHOWN BY A MAP IN THE OFFICE OF THE CLARK COUNTY, NEVADA RECORDER, IN FILE 68, PAGE 60 OF PARCEL MAPS. SITUATED IN THE WEST HALF (W 1/2) OF THE SOUTHWEST QUARTER (SW 1/4) OF SECTION 22, TOWNSHIP 20 SOUTH, RANGE 60 EAST, M.D.M., CITY OF LAS VEGAS, CLARK COUNTY, NEVADA.

LEGEND

NOTES:

COMMON ELEMENT "E" WITHIN THE BOUNDARY OF LEGENDS WEST CONDOMINIUMS UNIT 1 IS A PRIVATE STREET, P.U.E. AND C.L.V. PUBLIC SEWER EASEMENT. SEE SHEET 4-5 FOR CURB & PHASE DIMENSIONS, & COMMON ELEMENT AREAS.

SEE SHEETS 6-9 FOR BUILDING DETAILS & SECTIONS.

PURSUANT TO NRS 278.311, ALL PEARL LOT CORNERS SHALL BE SET WITH A NAIL & L.S. TAG ON THE BLOCK WALL AND ALL FRONT OR SIDE CORNERS ADJOINING PUBLIC RIGHTS-OF-WAY SHALL BE MARKED BY THE SAWCUTTING OF THE BACK OF SIDEWALK.

- ▲ FND. MONUMENT AS INDICATED
- SET NAIL & L.S. TAG IN BLOCK WALL PLS 6902 PER THIS MAP.
- SET 5/8" PEBAR W/ALUM. CAP PLS 6902 PER THIS MAP.
- FND. TYPE III MONUMENT PLS 9108 NO REFERENCE, CHECKED & ACCEPTED
- ① FND. TYPE III MONUMENT PLS 7635 PER BOOK 50, PAGE 19 OF PLATS.
- ▲ BUILDING TIE CORNER
- SET TYPE III MONUMENT PLS 6902
- C5 CURVE DATA
- L5 LINE DATA
- P.U.E. PUBLIC UTILITY EASEMENT
- R/W RIGHT-OF-WAY
- SB SETBACK
- PS PRIVATE STREET
- C.E. COMMON ELEMENT
- LCE LIMITED COMMON ELEMENT
- P2325 LIMITED COMMON ELEMENT (49 CARPORTS) PARKING FOR UNIT OF SAME # (2325)
- G2311 LIMITED COMMON ELEMENT (52 GARAGES) SEE SHEETS 6-9 FOR UNIT ASSIGNMENTS GARAGE FOR UNIT OF SAME # (2311)
- 23 BUILDING NUMBER (11 TOTAL) BUILDING TYPE
- 2323 UNIT DESIGNATOR (101 UNITS TOTAL) SEE DETAIL "A" FOR UNIT NUMBER
- TRASH ENCLOSURE (3 TOTAL)
- HANDICAP PARKING (6 TOTAL)
- BACK OF CURB
- PHASE LINE
- BOUNDARY LINE
- CENTERLINE
- BUILDING OUTLINE
- BUILDING PROJECTION LINE
- LIMITED COMMON ELEMENT EASEMENT
- SET 1-3/8" BRASS CAP IN T.C. STAMPED R.M. PLS 6902 (DISTANCE NOTED)

SCALE: 1"=30'




B.L.O.G. No. 1024
FLOOR No. 1
DETAIL "A"

LINE TABLE


No.	BEARING	DISTANCE
1	N88°06'51"E	8.64
2	N08°22'03"W	24.28
3	N02°00'45"W	8.15
4	N87°59'15"E	25.00
5	N87°59'15"E	12.50
6	N87°59'15"E	6.50
7	N87°59'15"E	6.00
8	N01°53'09"W	15.86
9	S88°06'51"W	12.50
10	N20°38'16"W	12.50
11	N20°38'16"W	5.00
12	N20°38'16"W	6.00
13	N05°39'04"E	25.50
14	N69°21'44"E	14.66
15	N87°59'15"E	15.35
16	N01°53'09"W	25.50
17	N87°59'15"E	22.46
18	N01°51'10"E	17.48
19	S41°16'44"E	34.32
20	N33°02'30"E	7.71
21	S88°06'51"W	22.63
22	S88°06'51"W	22.12
23	N2°44'01"E	5.67
24	N2°44'01"E	18.50
25	N2°44'01"E	20.82
26	N46°45'29"E	8.70
27	S88°06'51"W	22.50
28	S68°59'47"W	23.81

CURVE TABLE

No.	RADIUS	DELTA	LENGTH	TANGENT
1	15.00	92°02'07"	24.09	15.54
2	12.50	19°05'28"	37.49	18.92
3	87.50	19°05'28"	29.16	14.71
4	100.00	19°05'28"	33.32	16.82
5	2.50	90°00'00"	3.93	2.50
6	25.00	87°50'17"	30.66	19.26
7	20.00	90°00'00"	31.42	20.00
8	374.50	30°00'28"	196.14	100.37
9	374.50	07°40'17"	50.14	25.11
10	374.50	22°20'11"	146.00	73.94
11	425.80	30°00'00"	222.79	114.07
12	25.00	90°00'00"	39.27	25.00
13	400.00	30°00'00"	209.44	107.18
14	400.00	22°20'11"	155.94	78.97
15	400.00	07°40'17"	53.50	26.79
16	400.00	29°59'57"	209.43	107.18
17	85.64	06°45'16"	10.10	5.05
18	85.64	19°32'03"	29.20	14.74
19	85.64	26°17'19"	39.30	20.00
20	479.00	03°52'04"	32.34	16.17
21	479.00	14°37'10"	22.22	61.44
22	479.00	25°59'12"	50.05	25.05
23	479.00	05°31'34"	46.20	23.12
24	479.00	32°00'00"	250.80	128.35
25	321.00	06°56'36"	38.90	19.47
26	371.50	14°40'55"	27.28	4.28
27	153.50	27°44'53"	46.41	23.29
28	87.50	68°22'53"	97.27	55.17
29	87.50	16°45'47"	194.54	205.65

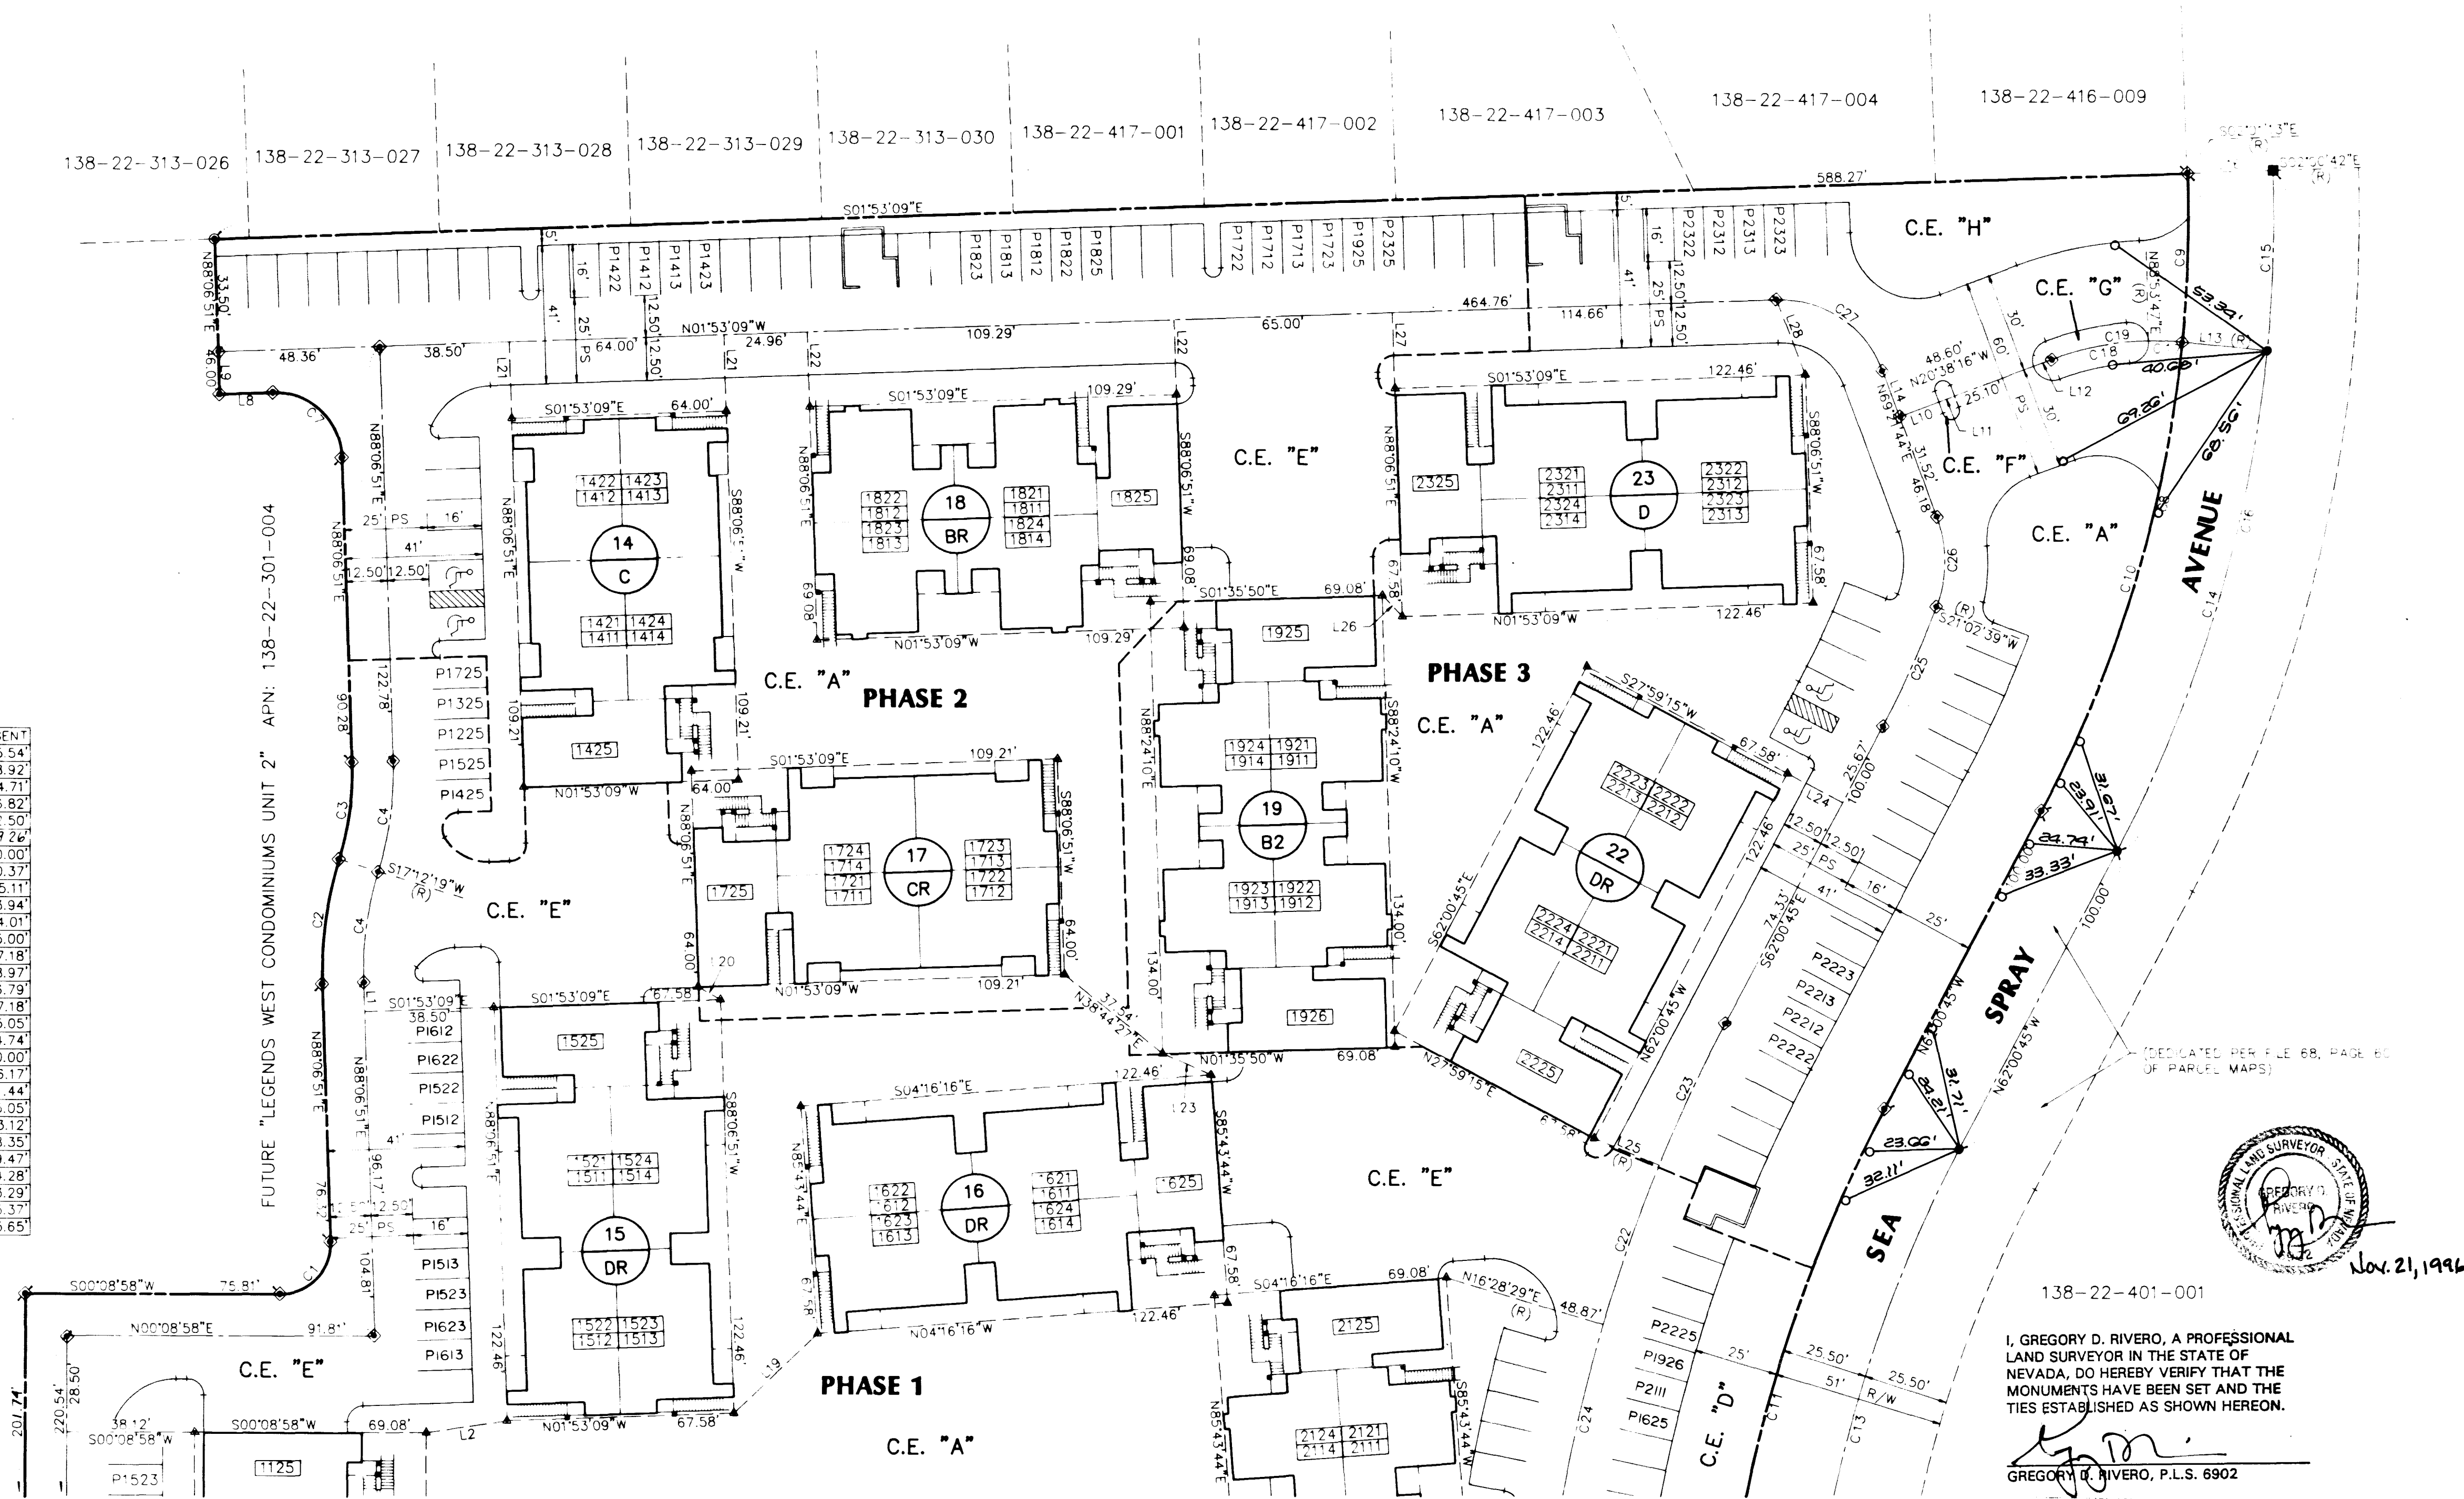

SEE SHEET 2 OF 9 FOR CONTINUATION

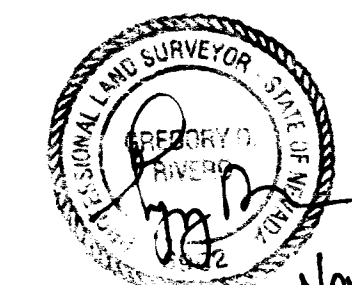

I, GREGORY D. RIVERO, A PROFESSIONAL LAND SURVEYOR IN THE STATE OF NEVADA, DO HEREBY VERIFY THAT THE MONUMENTS HAVE BEEN SET AND THE TIES ESTABLISHED AS SHOWN HEREON.

GREGORY D. RIVERO, P.L.S. 6902

SHEET 3 OF 9

W.O.#	721-9691	# UNITS	101	DATE	06/14/93	BY	RNB
DATE	8-11-93	REVISION	DESCRIPTION	BY			
			Revised Building Map, 1st Floor	RNB			

2086

BOOK 60 PAGE 76
058-4295-1

LEGENDS WEST CONDOMINIUMS UNIT 1

BEING A PORTION OF PARCEL 2 AS SHOWN BY A MAP IN THE OFFICE OF THE CLARK COUNTY, NEVADA RECORDERS, IN FILE NO. PAGE 60 OF PARCEL MAPS.
SITUATED IN THE WEST HALF (W 1/2) OF THE SOUTHWEST QUARTER (SW 1/4) OF SECTION 22, TOWNSHIP 20 SOUTH, RANGE 60 EAST, M.D.M., CITY OF LAS VEGAS, CLARK COUNTY, NEVADA.

113-1507











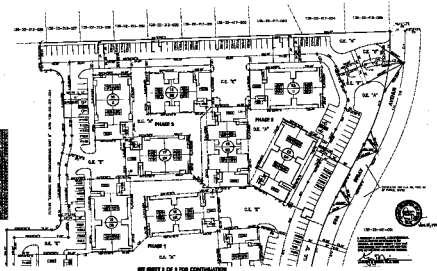



BOOK 60 PAGE 72