


940510

00876

AMENDED MAP OF A PORTION OF LONE MOUNTAIN VILLAGE - UNIT 1

BEING LOTS 20, 21, 24 AND 25 OF BLOCK 1 AND LOTS 22 AND 23 OF BLOCK 2 OF PLAT: BOOK 59, PAGE 100
LOCATED IN A PORTION OF GOVERNMENT LOT 2 OF THE NORTHEAST QUARTER (NE 1/4) OF
SECTION 3, TOWNSHIP 20 SOUTH, RANGE 60 EAST, M.D.M., CITY OF LAS VEGAS, CLARK COUNTY, NEVADA.

MONUMENT TIE MAP

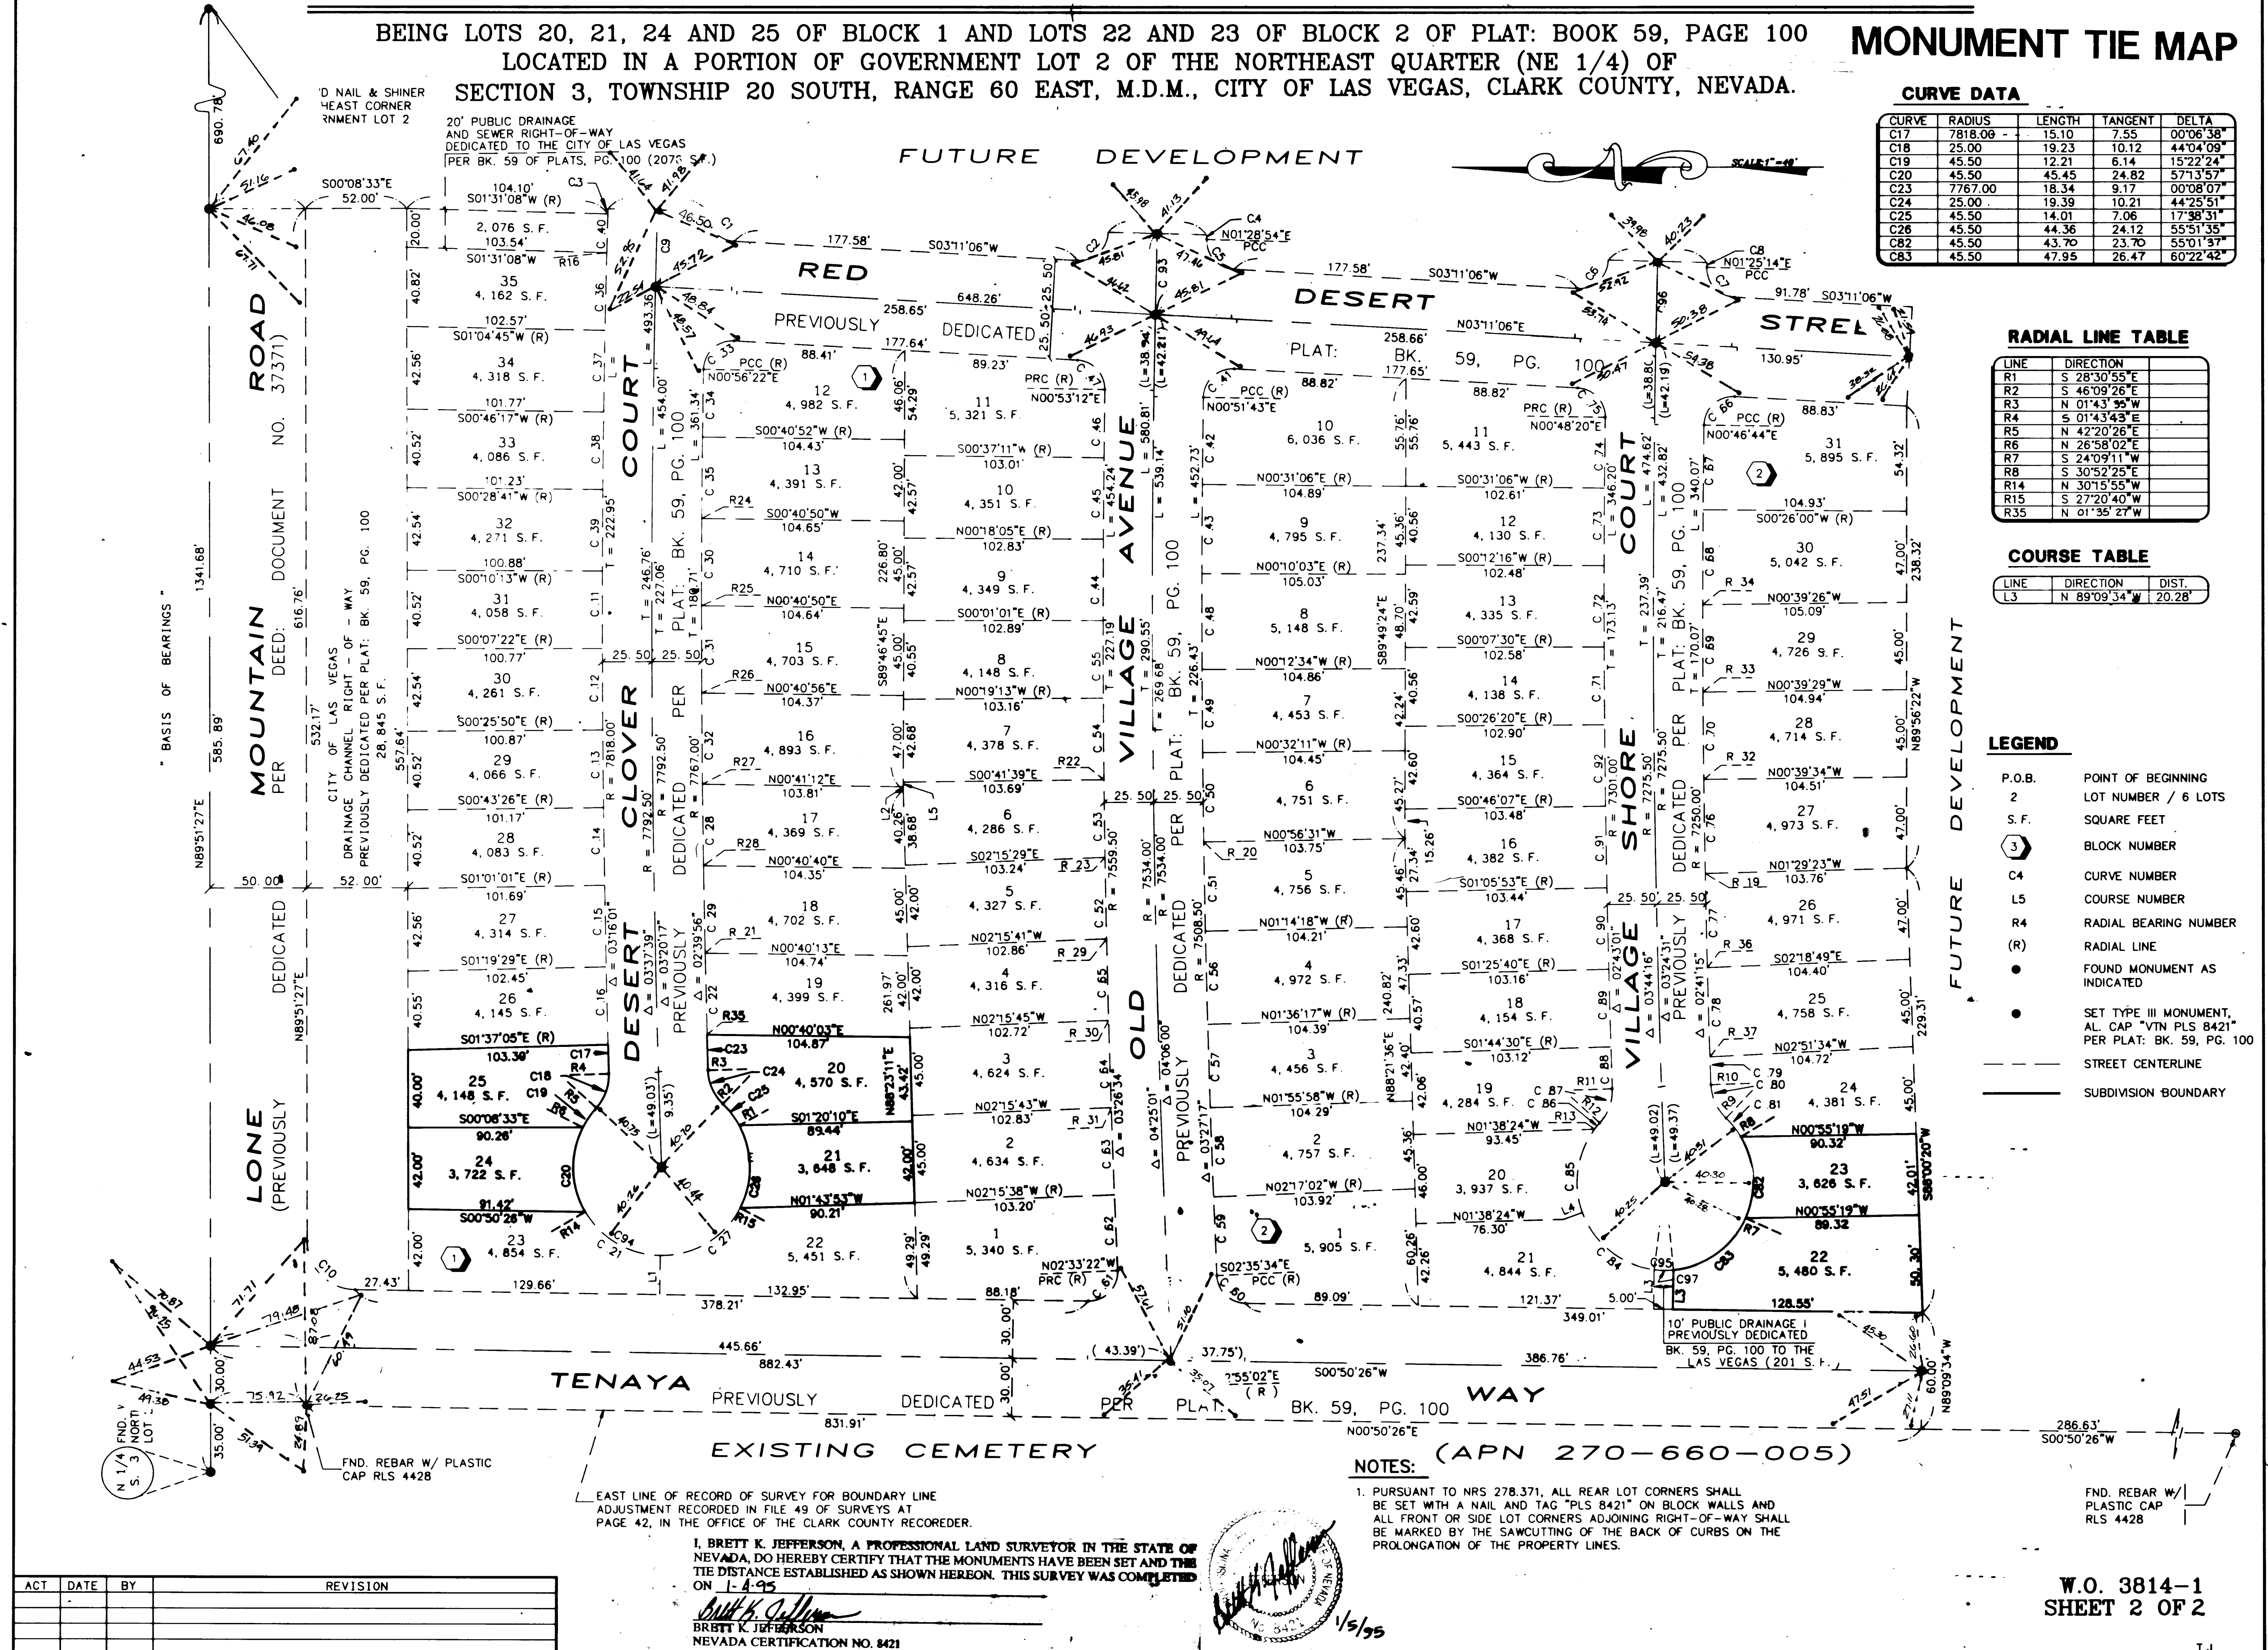

ACT	DATE	BY	REVISION

I, BRETT K. JEFFERSON, A PROFESSIONAL LAND SURVEYOR IN THE STATE OF NEVADA, DO HEREBY CERTIFY THAT THE MONUMENTS HAVE BEEN SET AND THE TIE DISTANCE ESTABLISHED AS SHOWN HEREON. THIS SURVEY WAS COMPLETED ON 1-4-95.

BRETT K. JEFFERSON
NEVADA CERTIFICATION NO. 8421

Book 61 Page 84


940510

00876

AMENDED MAP OF A PORTION OF LONE MOUNTAIN VILLAGE - UNIT 1


MONUMENT TE MAP

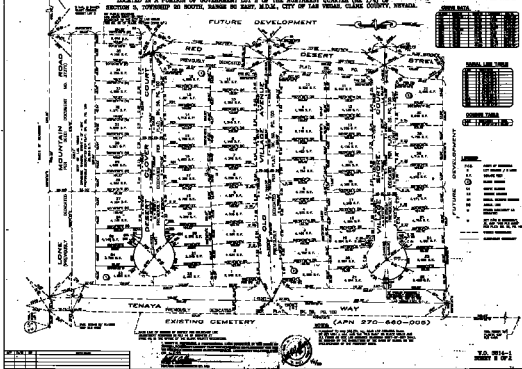

Book 61 Page 64