



MONUMENTATION MAP OF JAKE'S RANCH UNIT 3

SITUATE IN THE CITY OF LAS VEGAS, CLARK COUNTY, NEVADA BEING A PORTION THE NORTHWEST ONE-QUARTER OF THE NORTHWEST ONE-QUARTER OF SECTION 23, TOWNSHIP 20 SOUTH, RANGE 60 EAST, M.D.M.

RECORDED IN BOOK 72, PAGE 94



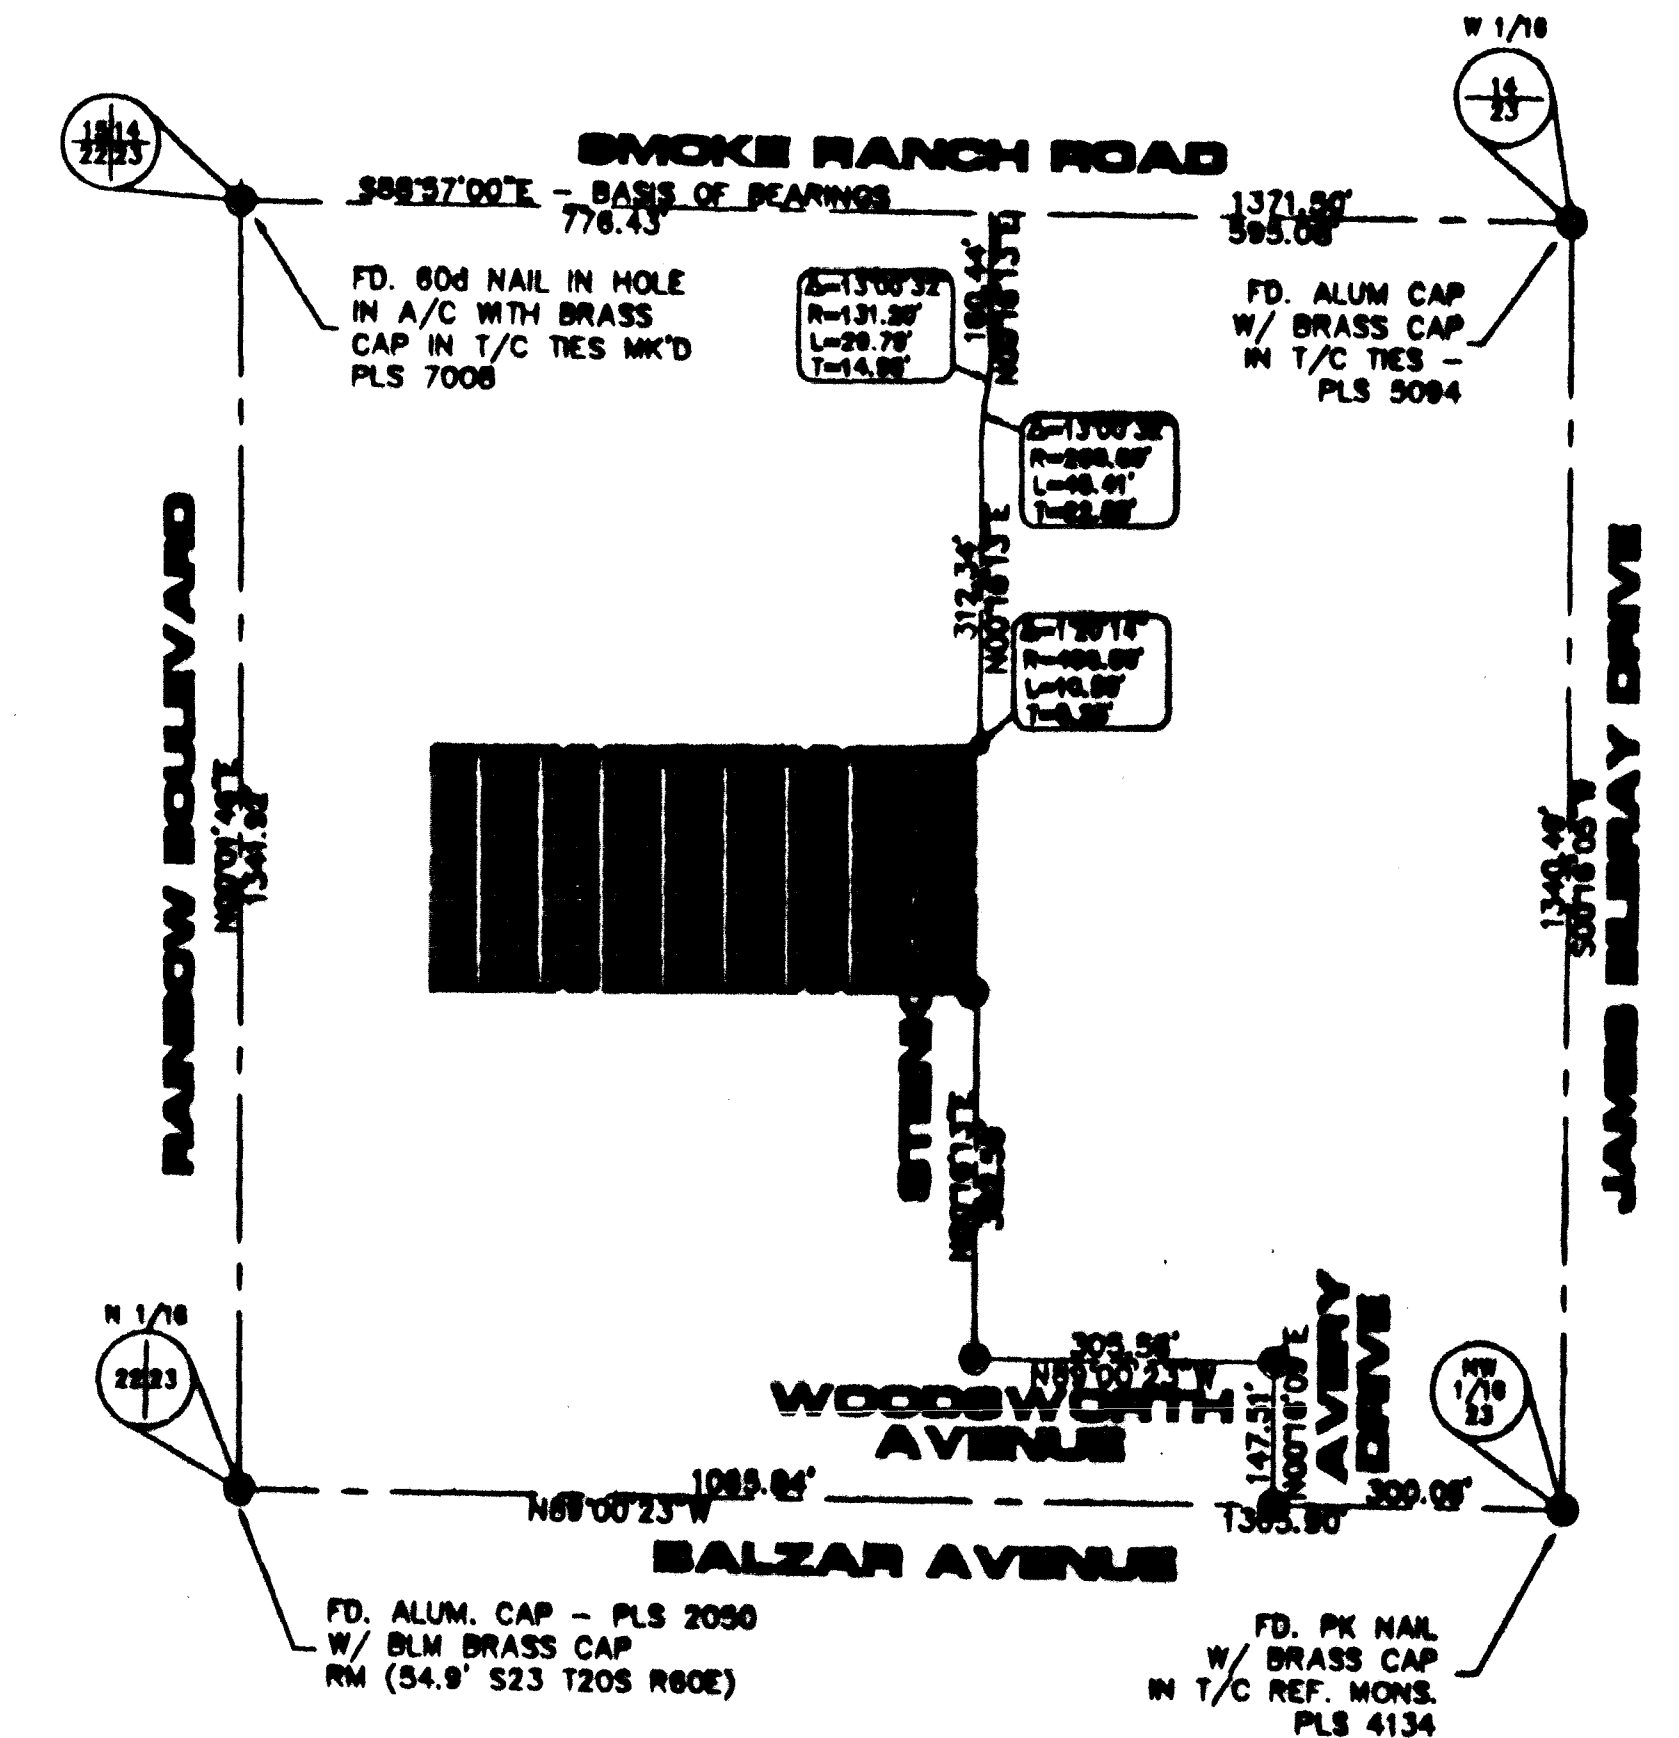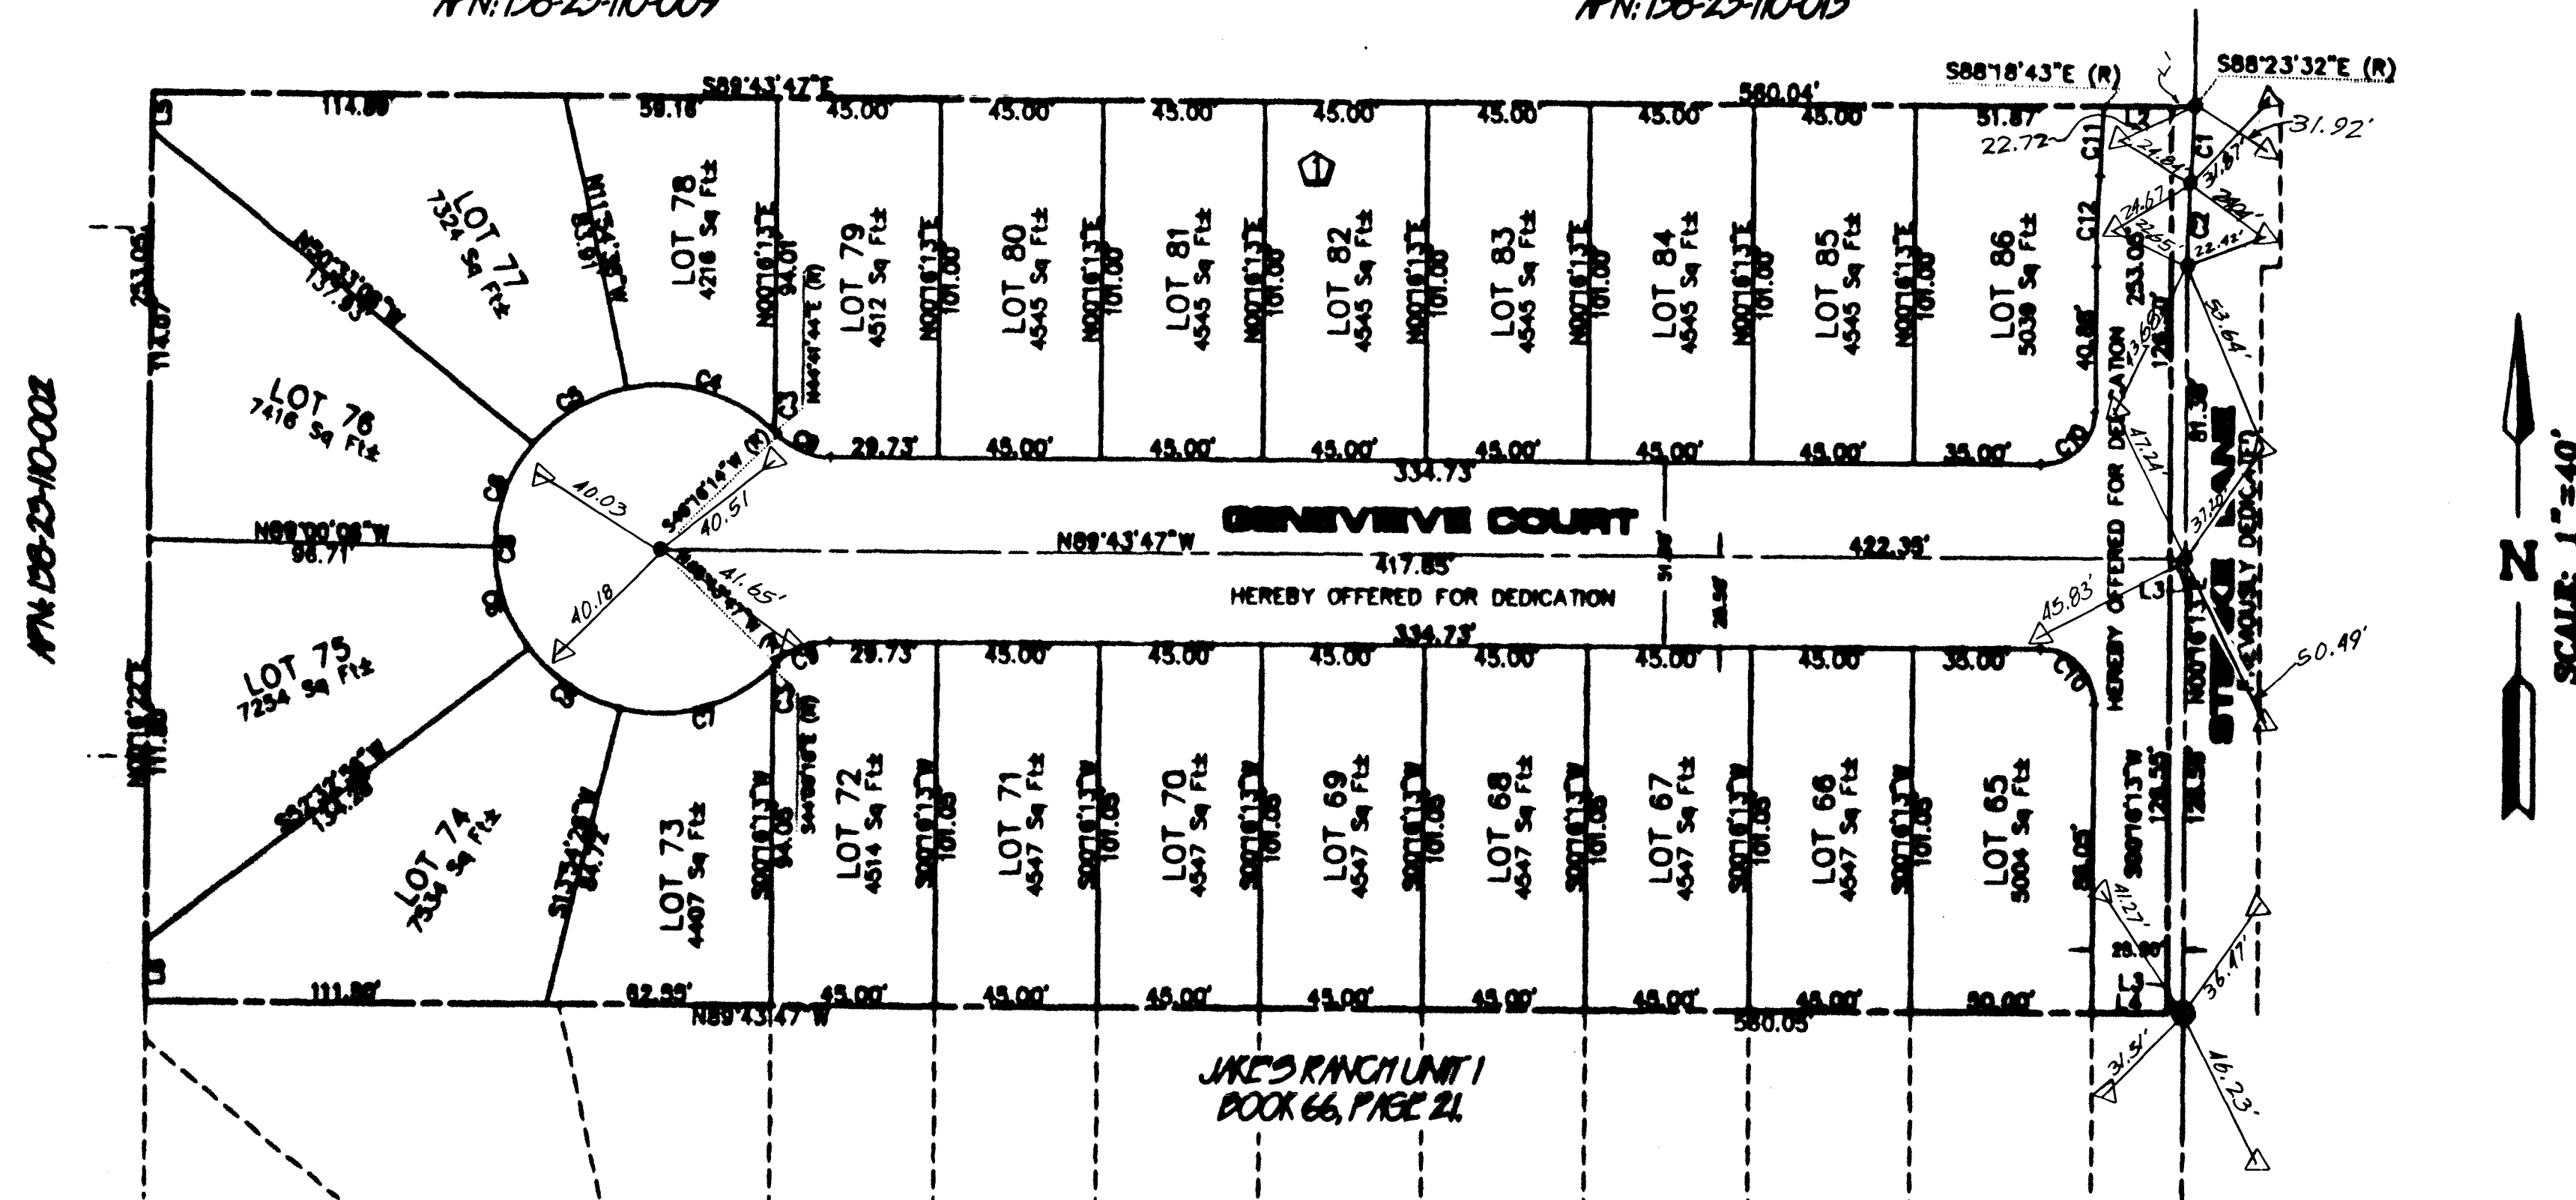

CURVE DATA TABLE


No.	RADIUS	DELTA	LENGTH	TANGENT
C1	450.00	02°48'53"	21.84	10.82
C2	324.44	04°07'07"	23.32	11.87
C3	45.50	01°34'30"	1.25	0.63
C4	45.50	58°38'23"	44.85	24.50
C5	45.50	38°38'30"	30.88	15.85
C6	45.50	38°28'58"	30.53	15.87
C7	45.50	58°03'44"	48.11	25.25
C8	45.50	272°00'01"	216.00	---
C9	20.00	48°00'01"	18.04	8.48
C10	15.00	90°00'00"	23.56	15.00
C11	424.50	02°42'03"	20.01	10.01
C12	348.84	04°07'07"	25.18	12.58

LINE DATA TABLE

No.	BEARING	DISTANCE
L1	S88°43'47"E	6.38
L2	S88°43'47"E	19.13
L3	S88°43'47"E	4.50
L4	S88°43'47"E	21.00
L5	N00°18'22"E	10.82
L6	N00°18'22"E	18.85

SURVEYOR'S CERTIFICATE:

I, ROBERT C. JOHNSON, A PROFESSIONAL LAND SURVEYOR REGISTERED IN THE STATE OF NEVADA, DO HEREBY CERTIFY THAT THE MONUMENTS HAVE BEEN SET AND THE TIE DISTANCES ESTABLISHED AS SHOWN HEREON. THIS SURVEY WAS COMPLETED ON MARCH 10, 1992.

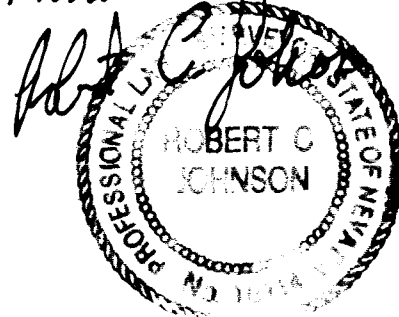

3/17/92

LEGEND:



	1 1/2" ALUMINUM DISK IN TOP OF CURB; PLS 10114
	5/8" REBAR W/ ALUM. CAP W/ TIES PLS 10114
	FOUND MONUMENT AS INDICATED
	OVERALL PARCEL BOUNDARY LINE
	INTERIOR PROPERTY OR RIGHT-OF-WAY LINE
	STREET CENTERLINE
	EASEMENT LINE
	BLOCK DESIGNATOR
	CURVE TABLE REFERENCE NUMBER
	LINE TABLE REFERENCE NUMBER
	LOT DESIGNATOR

MONUMENTATION MAP OF

JAKE'S RANCH UNIT 3

SITUATE IN THE CITY OF LAS VEGAS, CLARK COUNTY, NEVADA BEING A PORTION OF THE NORTHWEST ONE-QUARTER OF SECTION 23, TOWNSHIP 20 SOUTH, RANGE 60 EAST, M.D.M.

RECORDED IN BOOK 72, PAGE 94

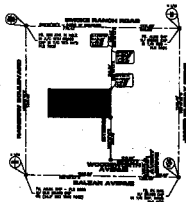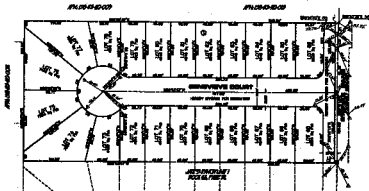

CLIVE DATA TABLE


LINE DATA TABLES

[illegible]

SURVEYOR'S CERTIFICATE:




LEGEND:

