


MONUMENT TIE MAP OF

LAPAZ

A PLANNED COMMUNITY AND COMMON INTEREST COMMUNITY

BEING A SUBDIVISION OF ALL OF LOT 11 OF "SUMMERLIN VILLAGE 7-THE TRAILS-UNIT NO. 1" AS SHOWN BY MAP THEREOF ON FILE IN BOOK 59, PAGE 11 OF PLATS IN THE CLARK COUNTY RECORDER'S OFFICE, CLARK COUNTY, NEVADA, LYING WITHIN SECTION 19, TOWNSHIP 20 SOUTH, RANGE 60 EAST, M.D.M., CITY OF LAS VEGAS, CLARK COUNTY, NEVADA

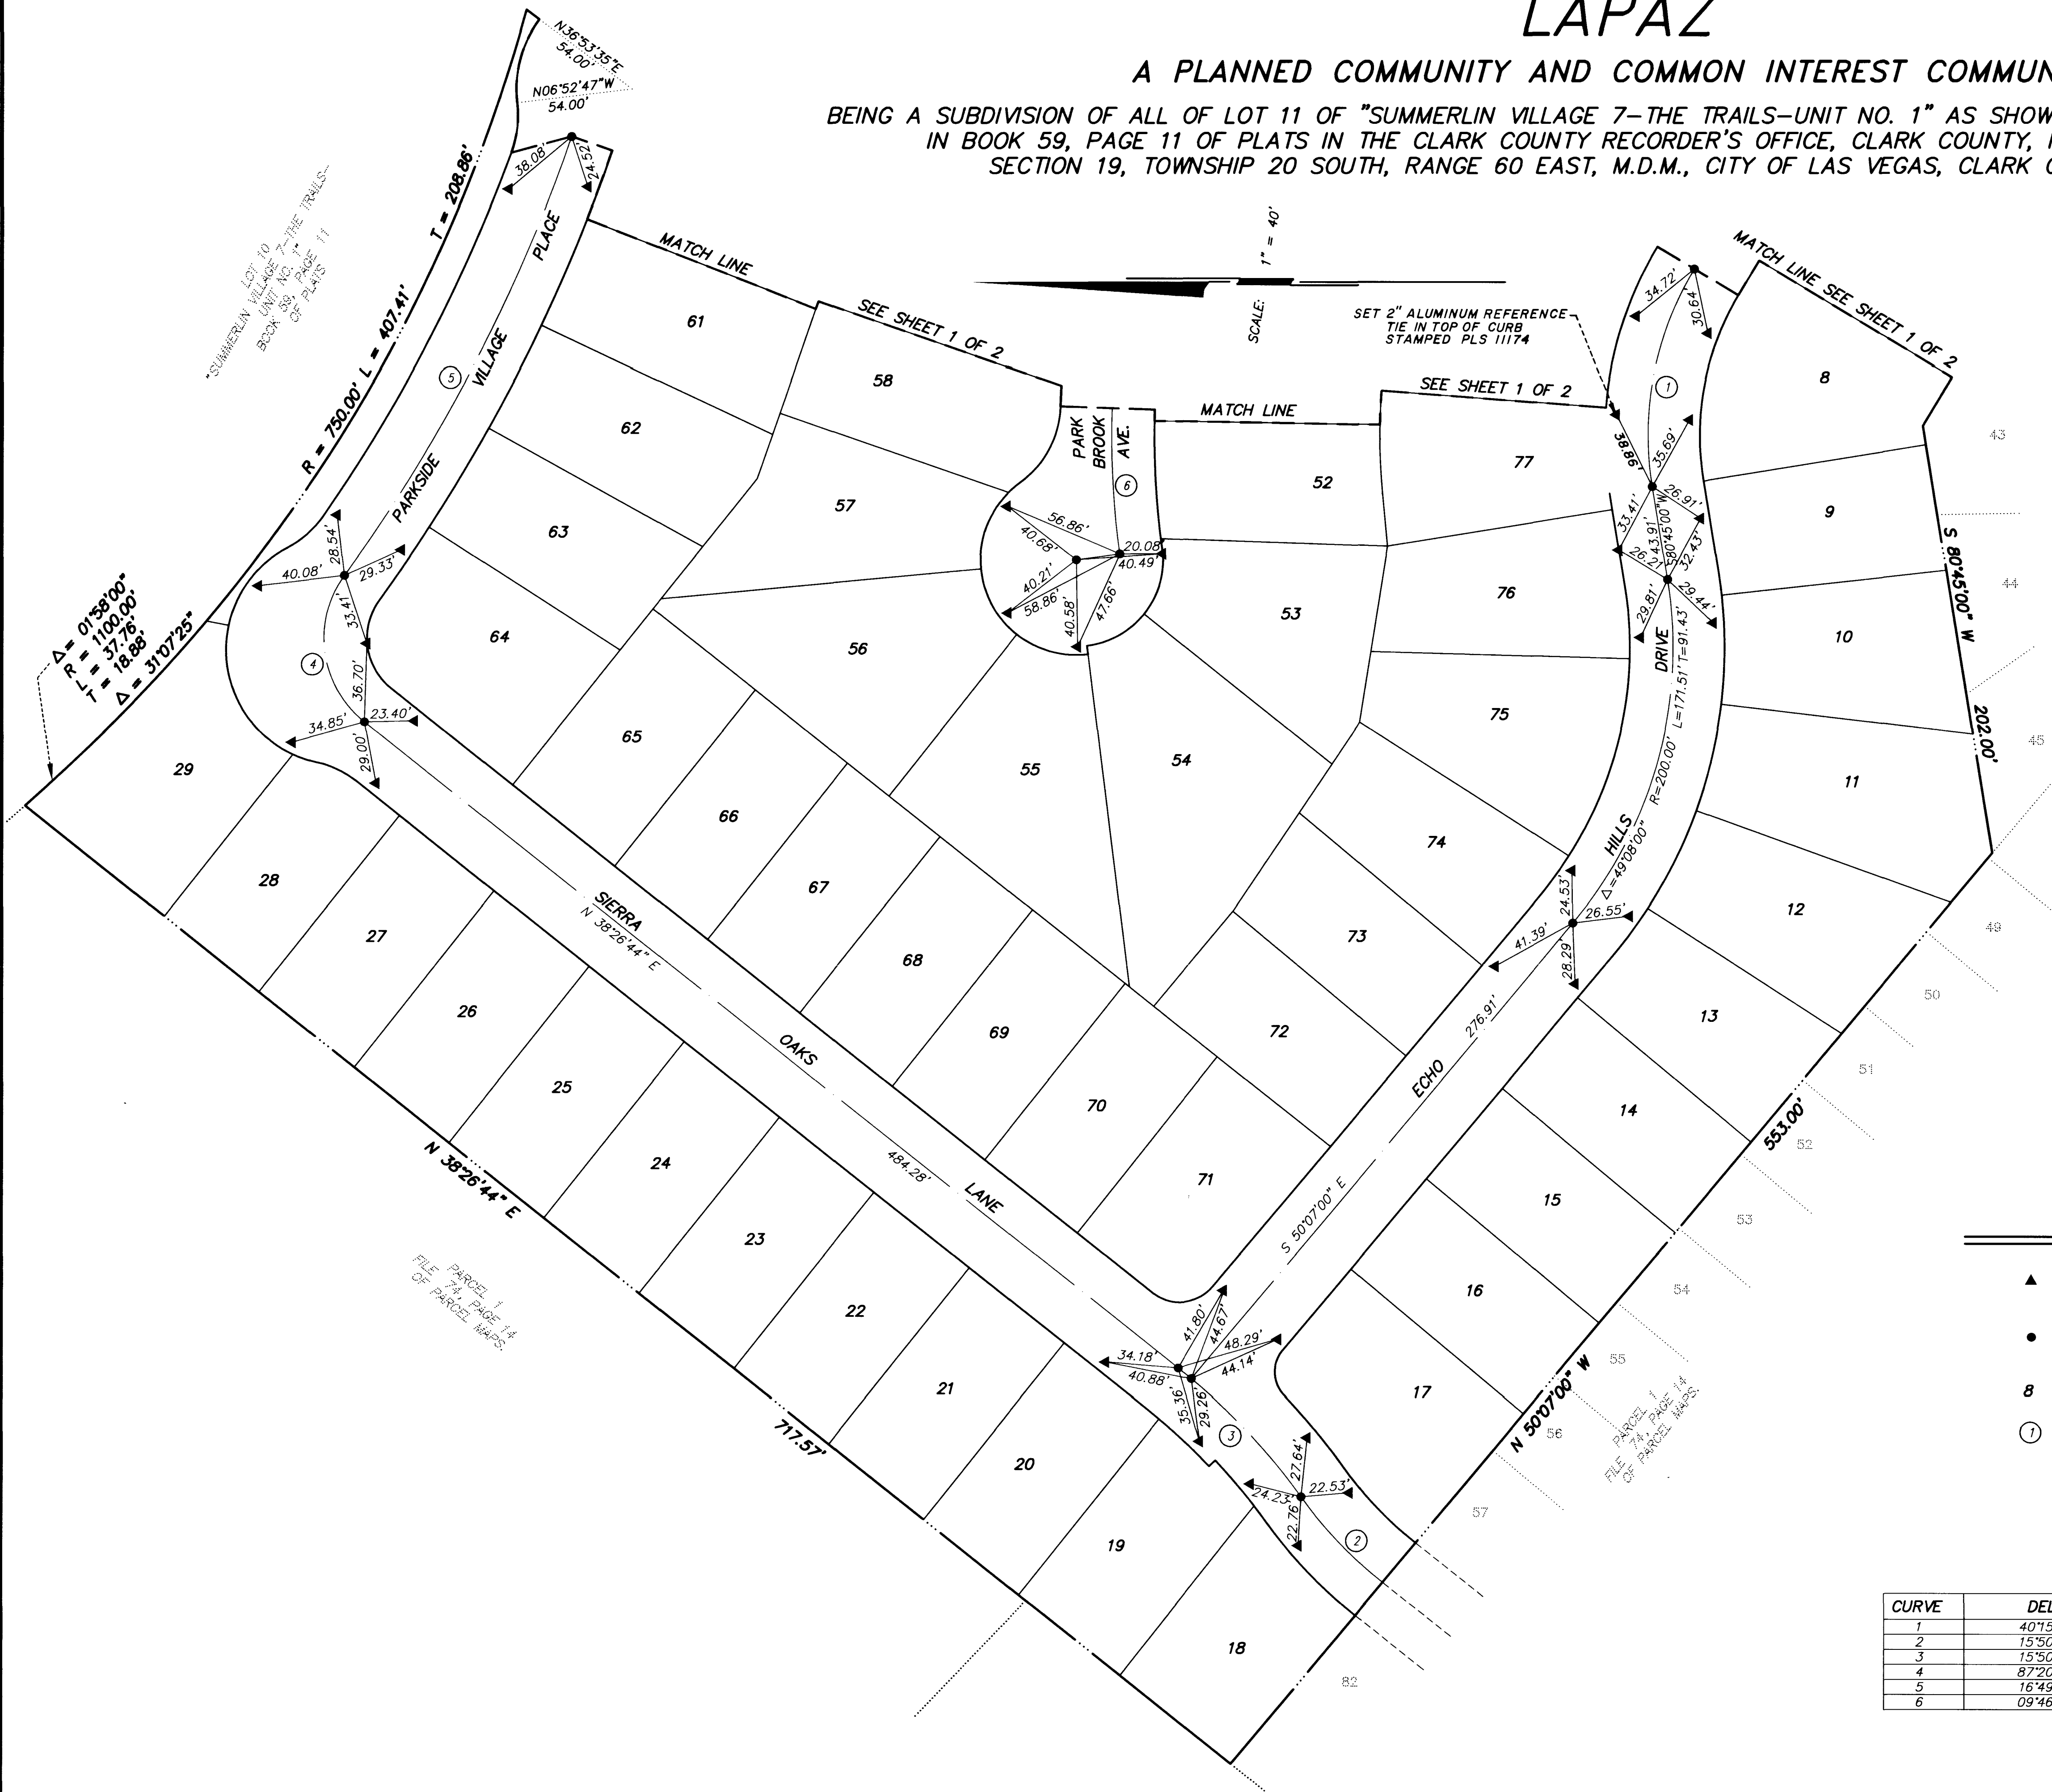


LEGEND

- ▲ SET 2" ALUMINUM REFERENCE TIE IN TOP OF CURB, STAMPED "PLS 9390" (UNLESS OTHERWISE NOTED)
- SET 5/8" REBAR AND ALCAP STAMPED "PLS 7755"
- 8 LOT NUMBER
- ① CURVE NUMBER

CURVE	DELTA	RADIUS	LENGTH	TANGENT
1	40°15'00"	150.00'	105.37'	54.97'
2	15°50'45"	200.00'	55.31'	27.83'
3	15°50'45"	300.00'	82.97'	41.75'
4	87°20'52"	50.00'	76.23'	47.74'
5	16°49'57"	787.50'	231.36'	116.52'
6	09°46'35"	400.00'	68.25'	34.21'

LAPAZ


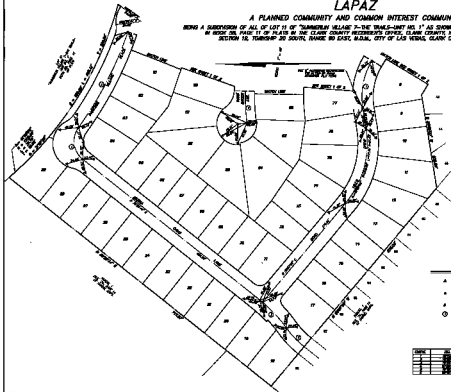

LEGEND


SHEET 2 OF 2

Book _____ Page _____

OSY-4853