
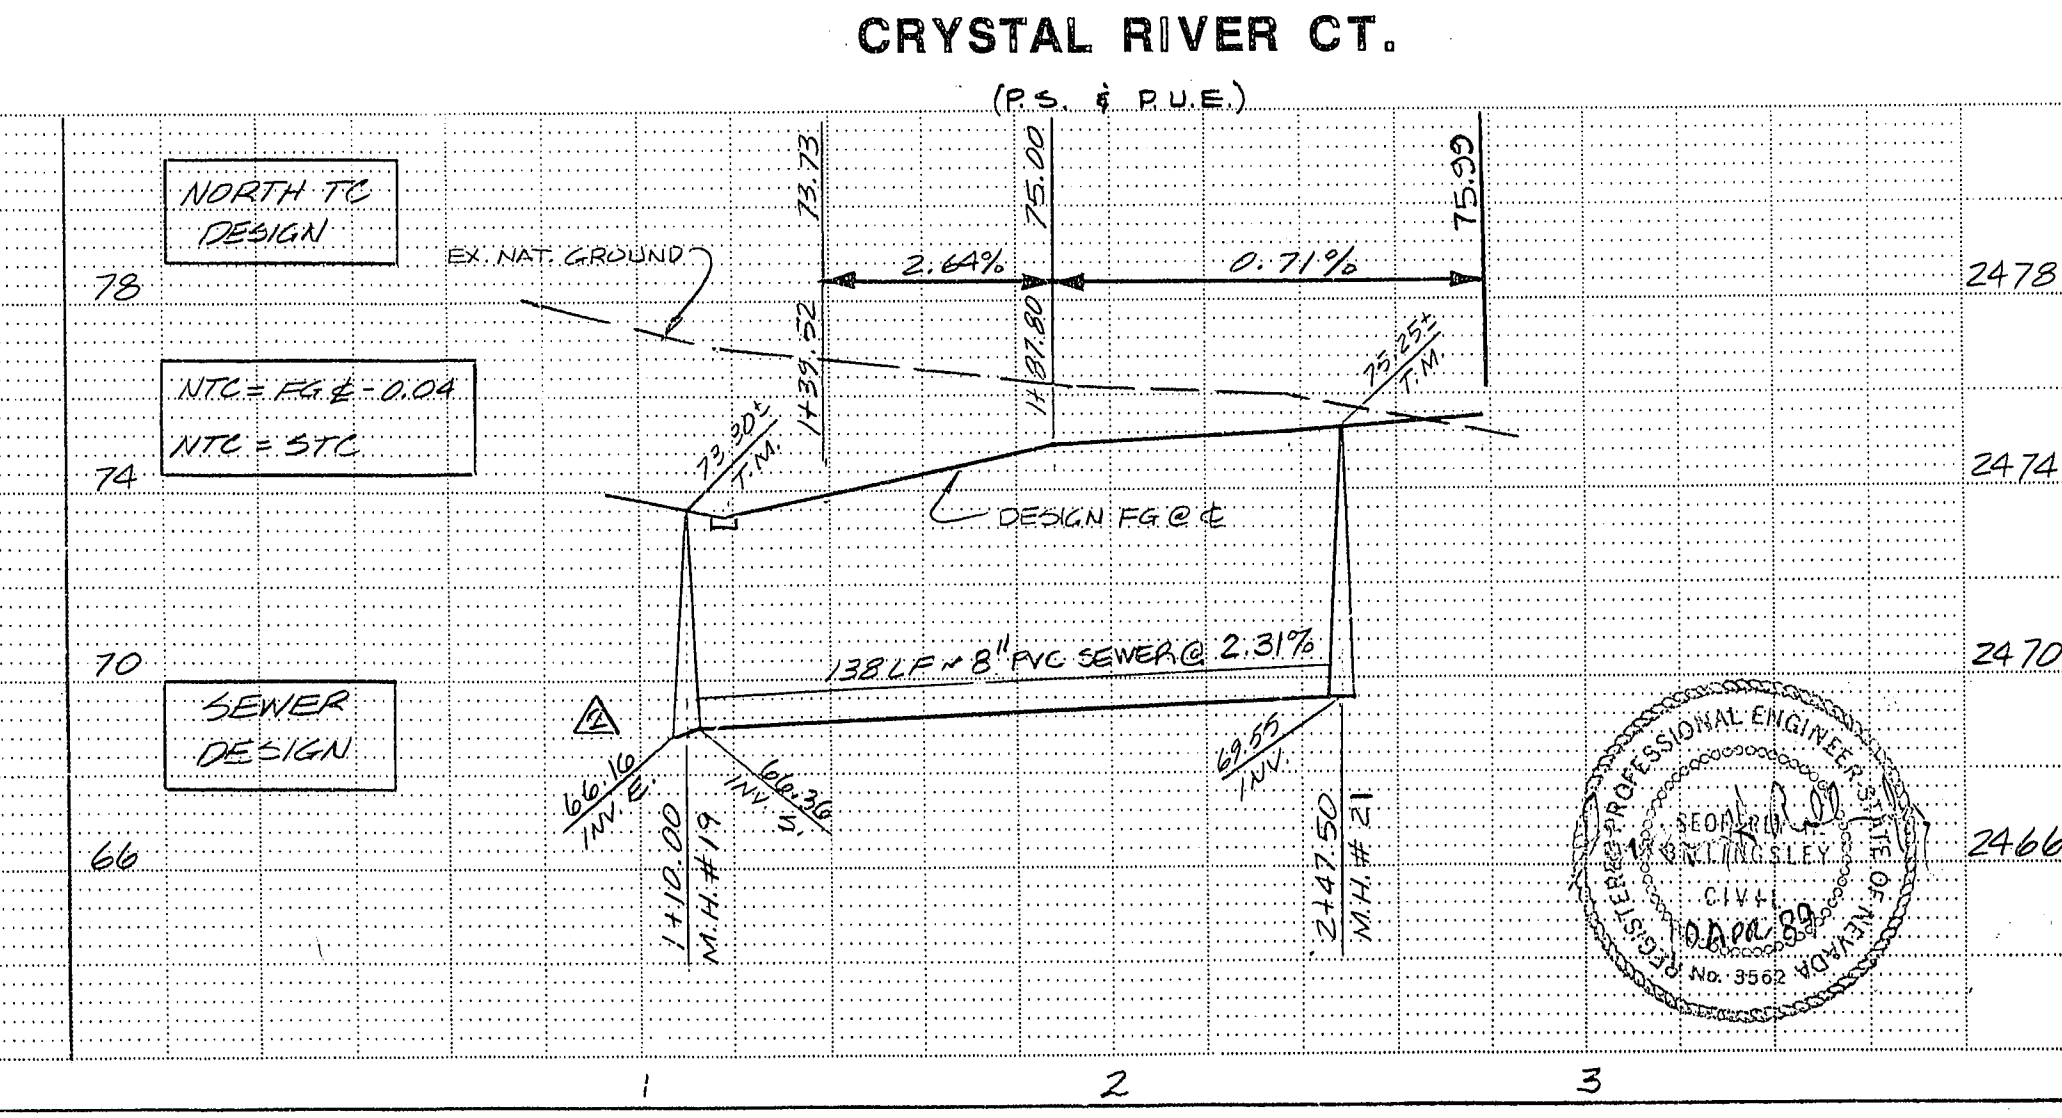
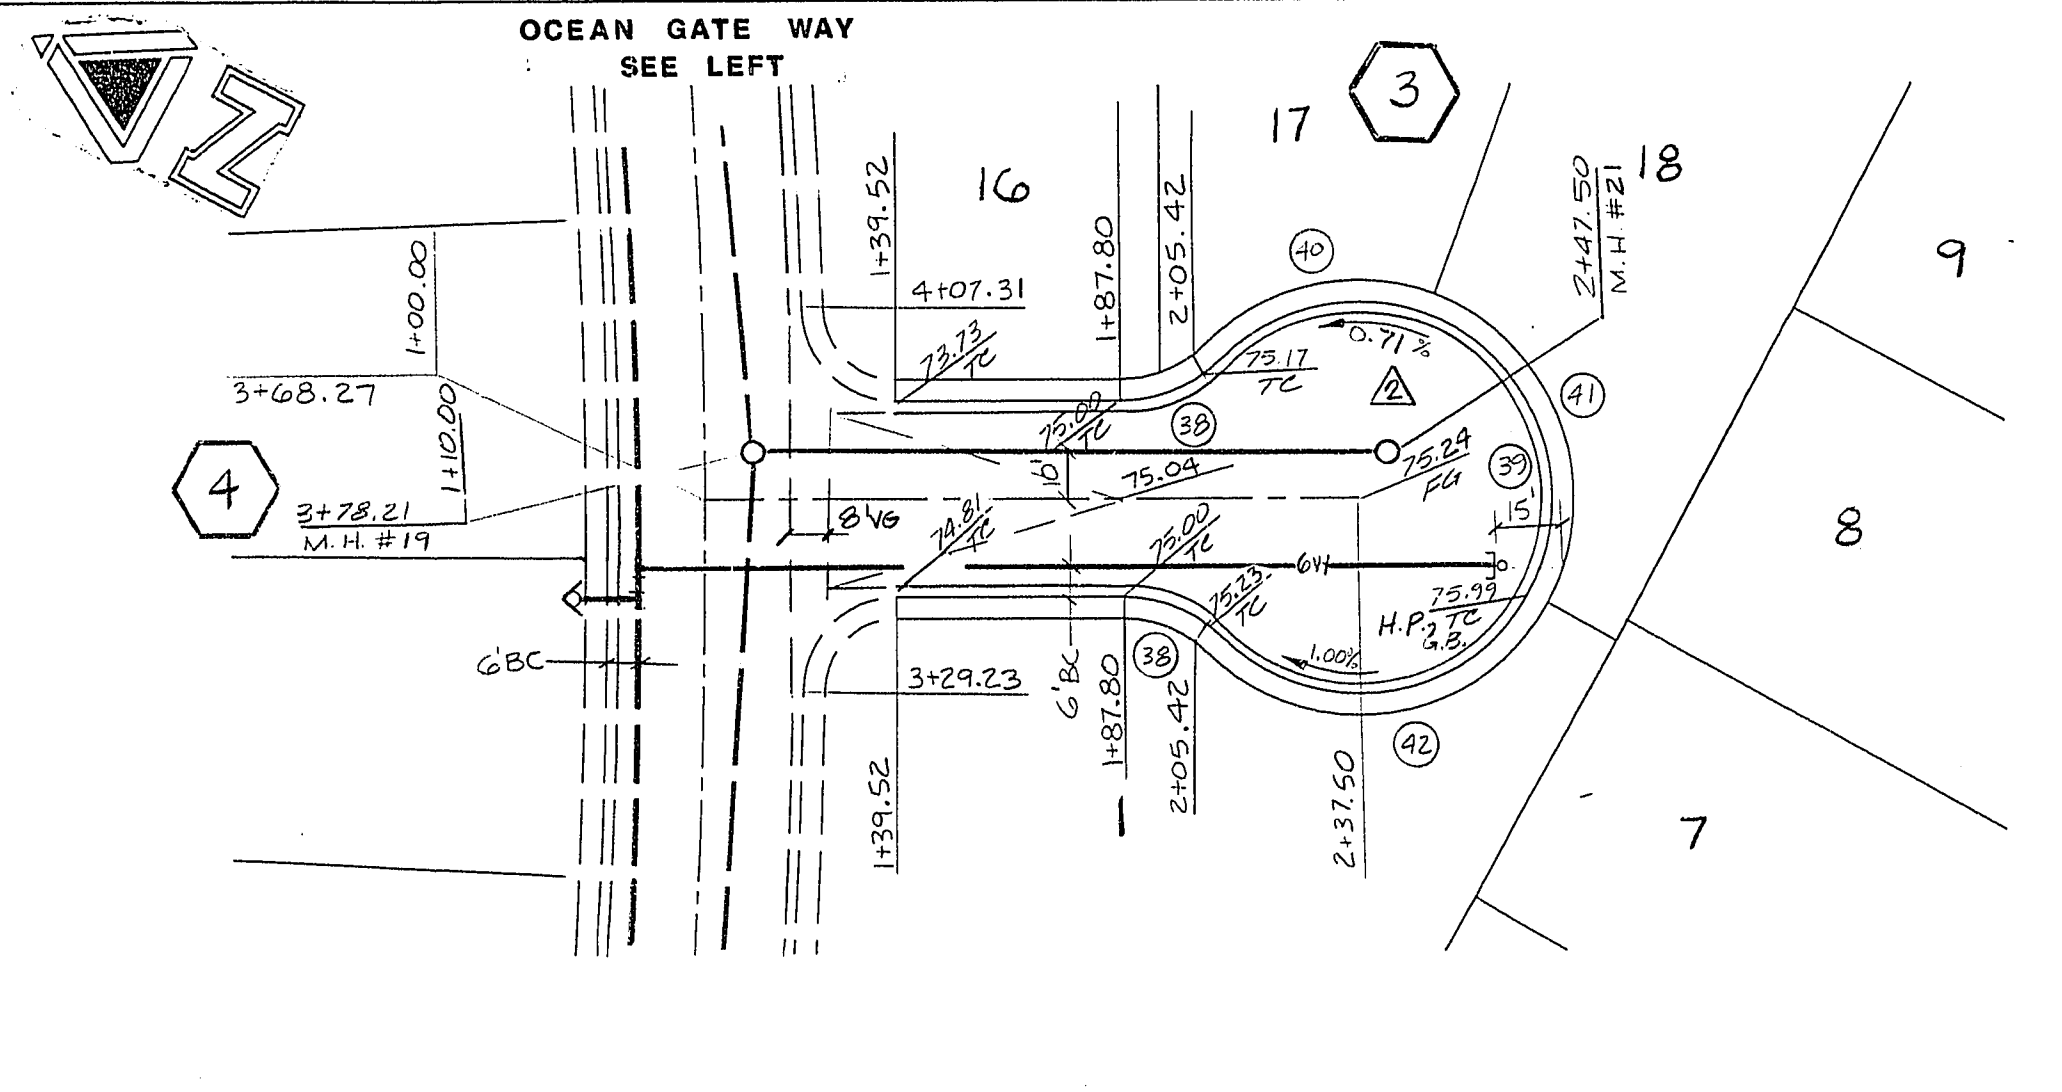
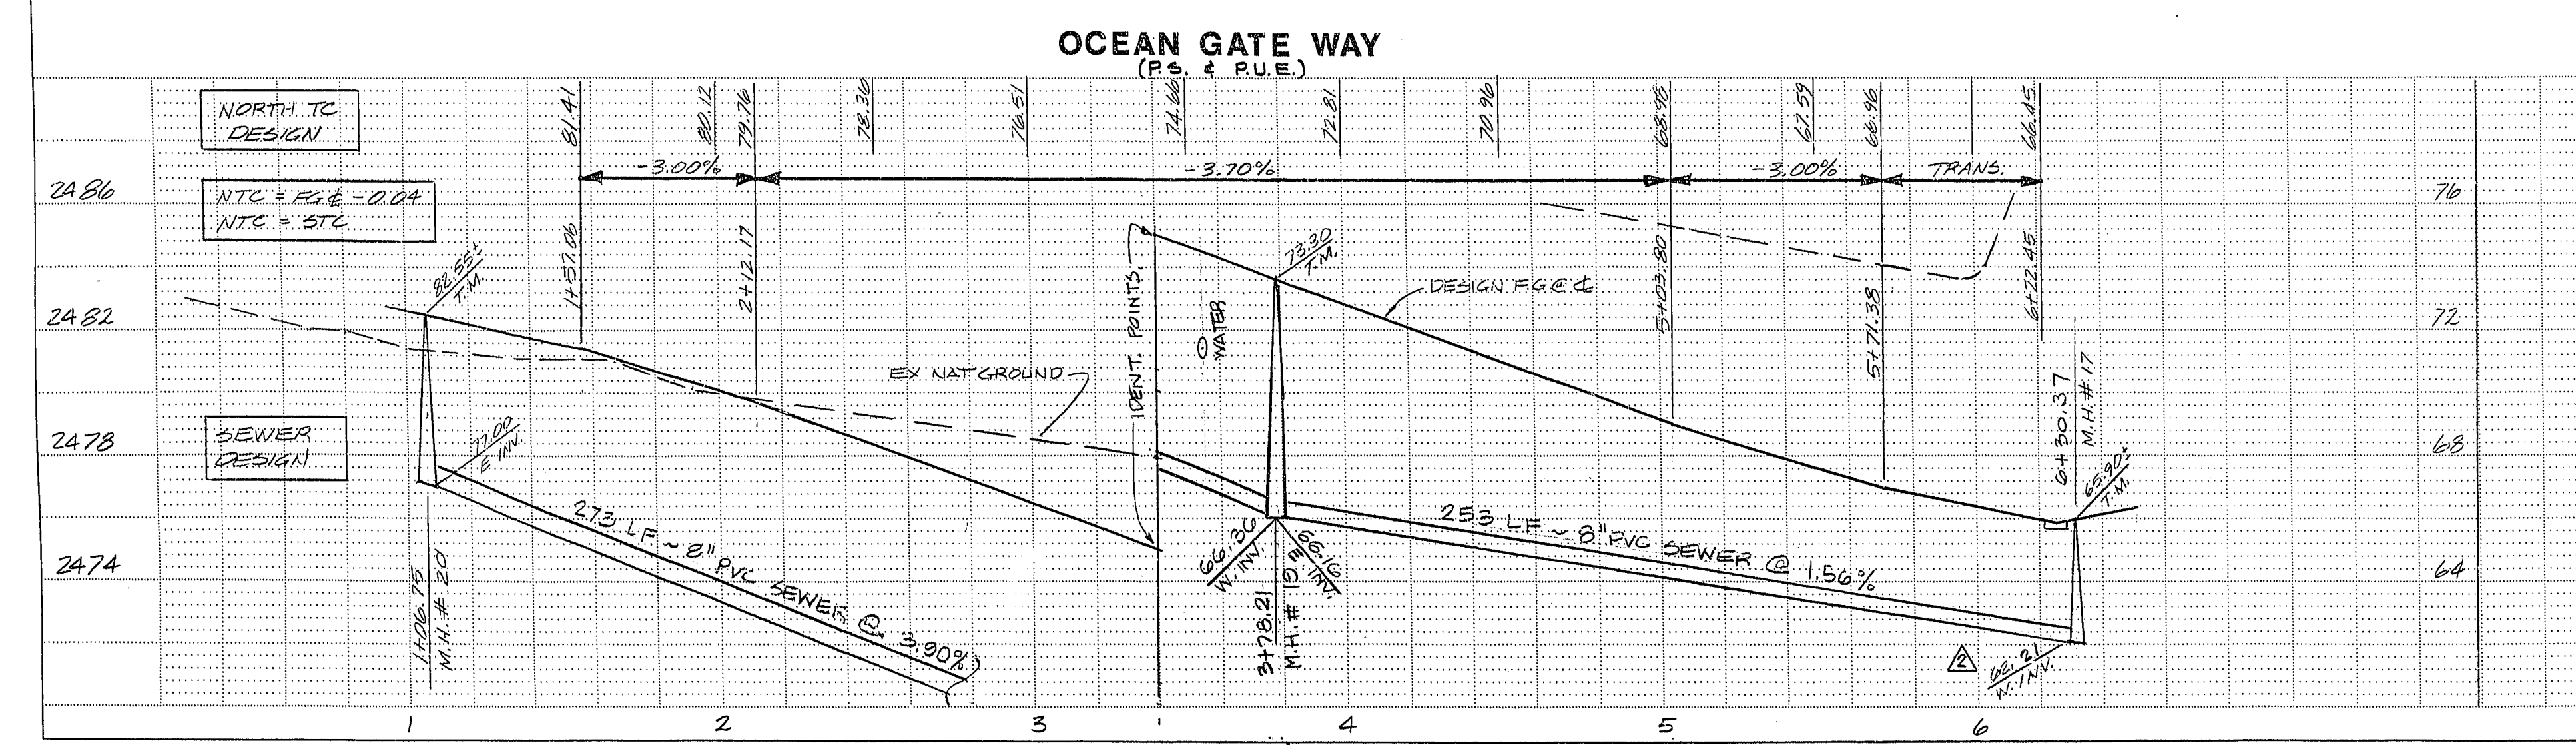
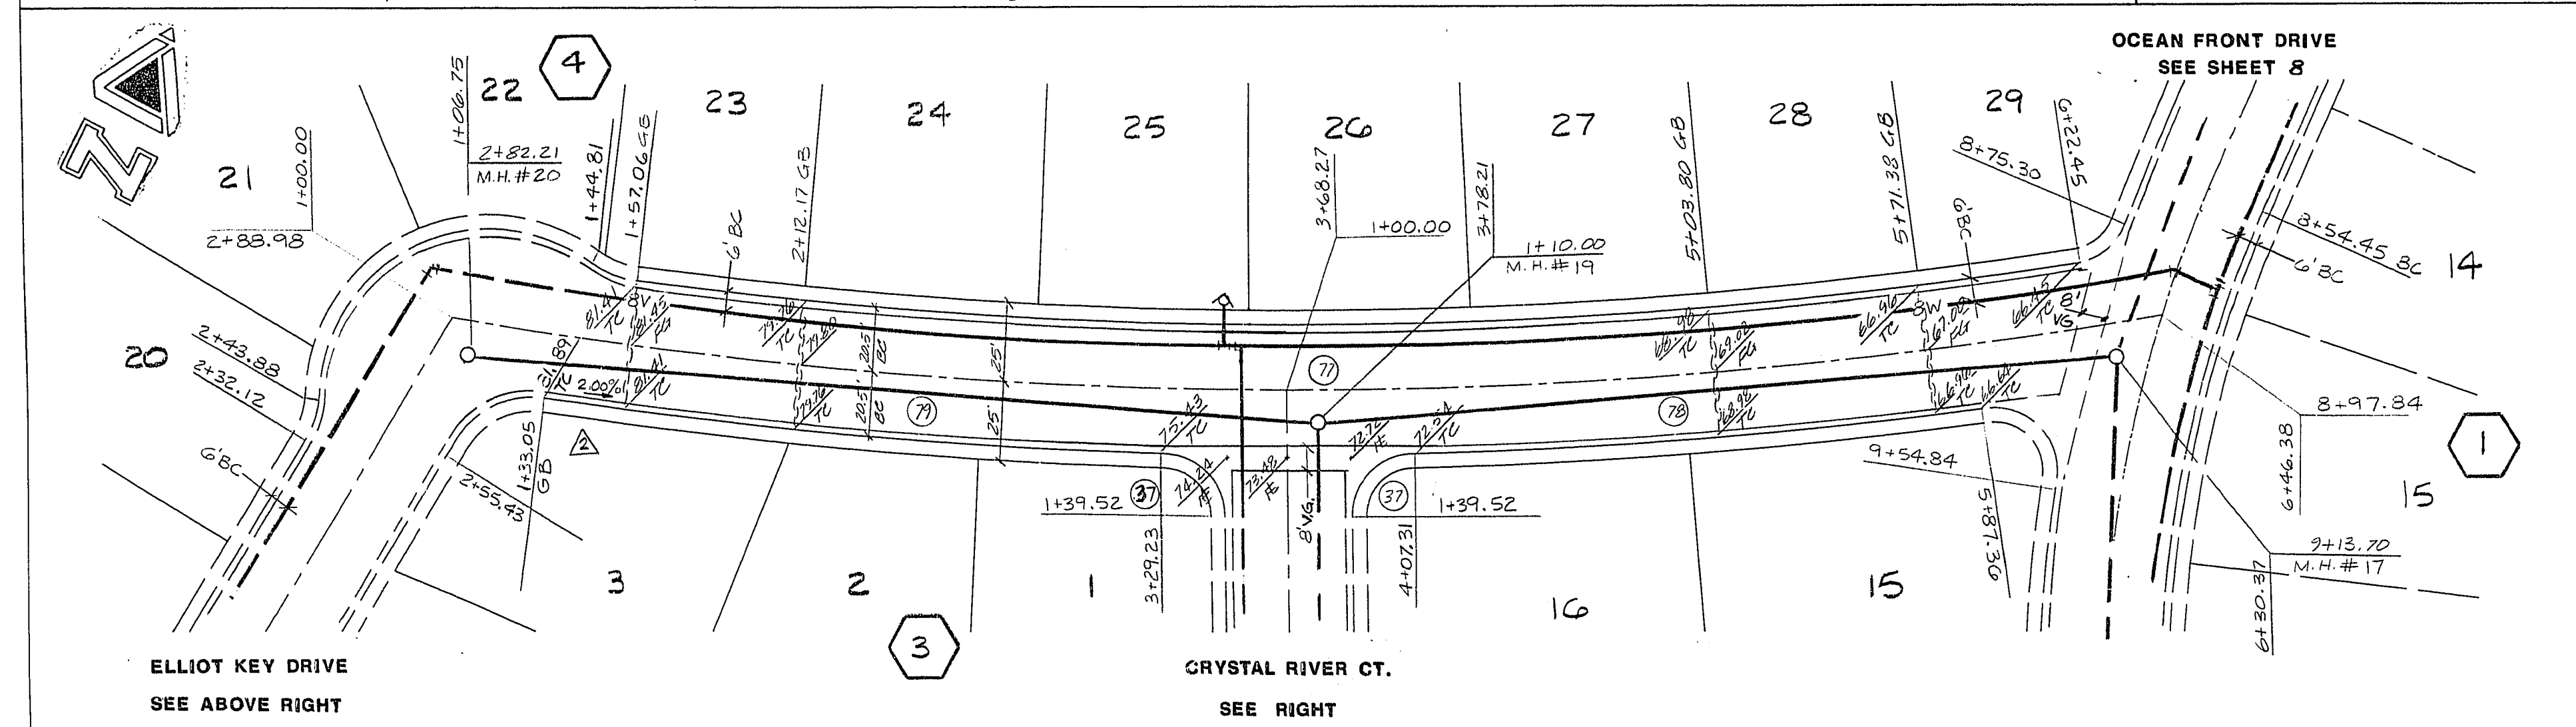
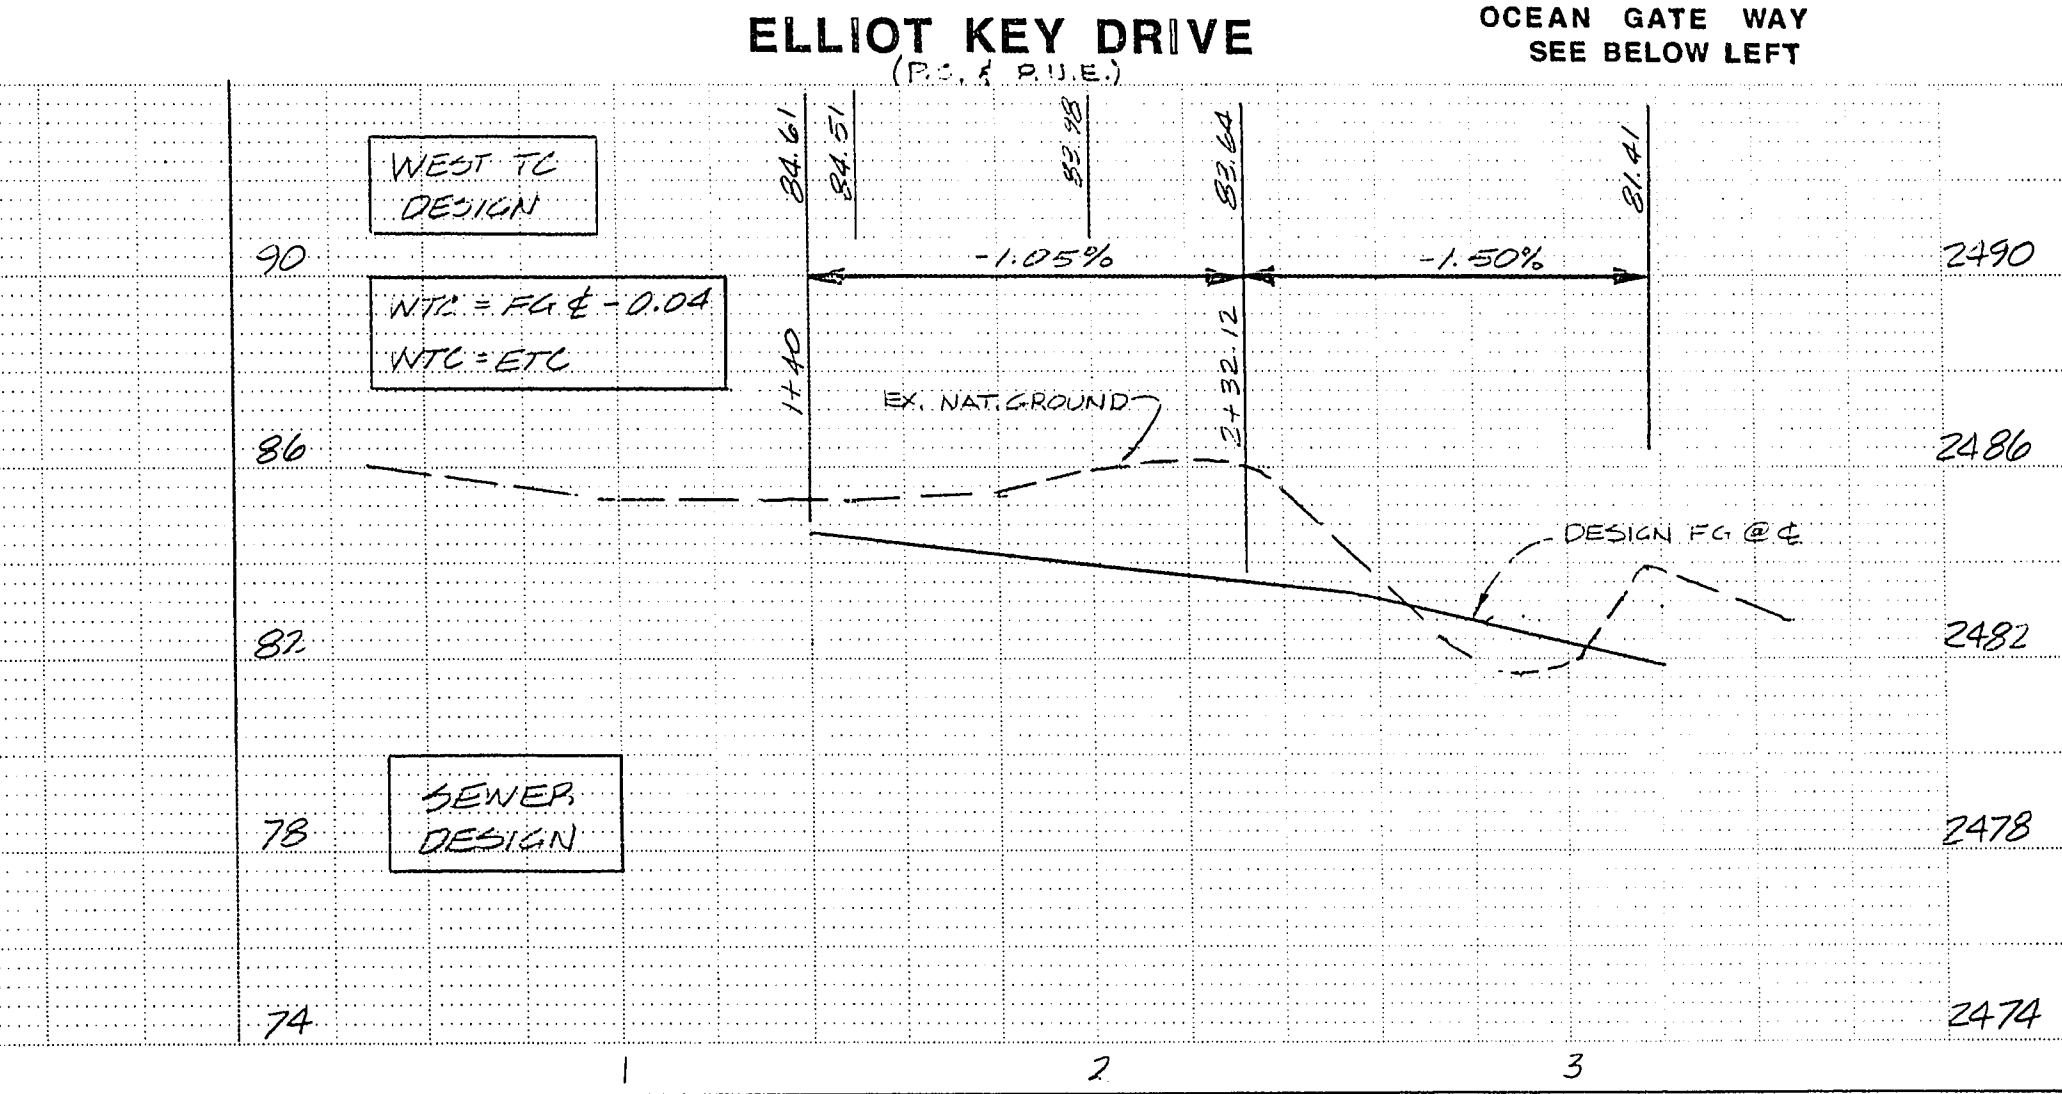
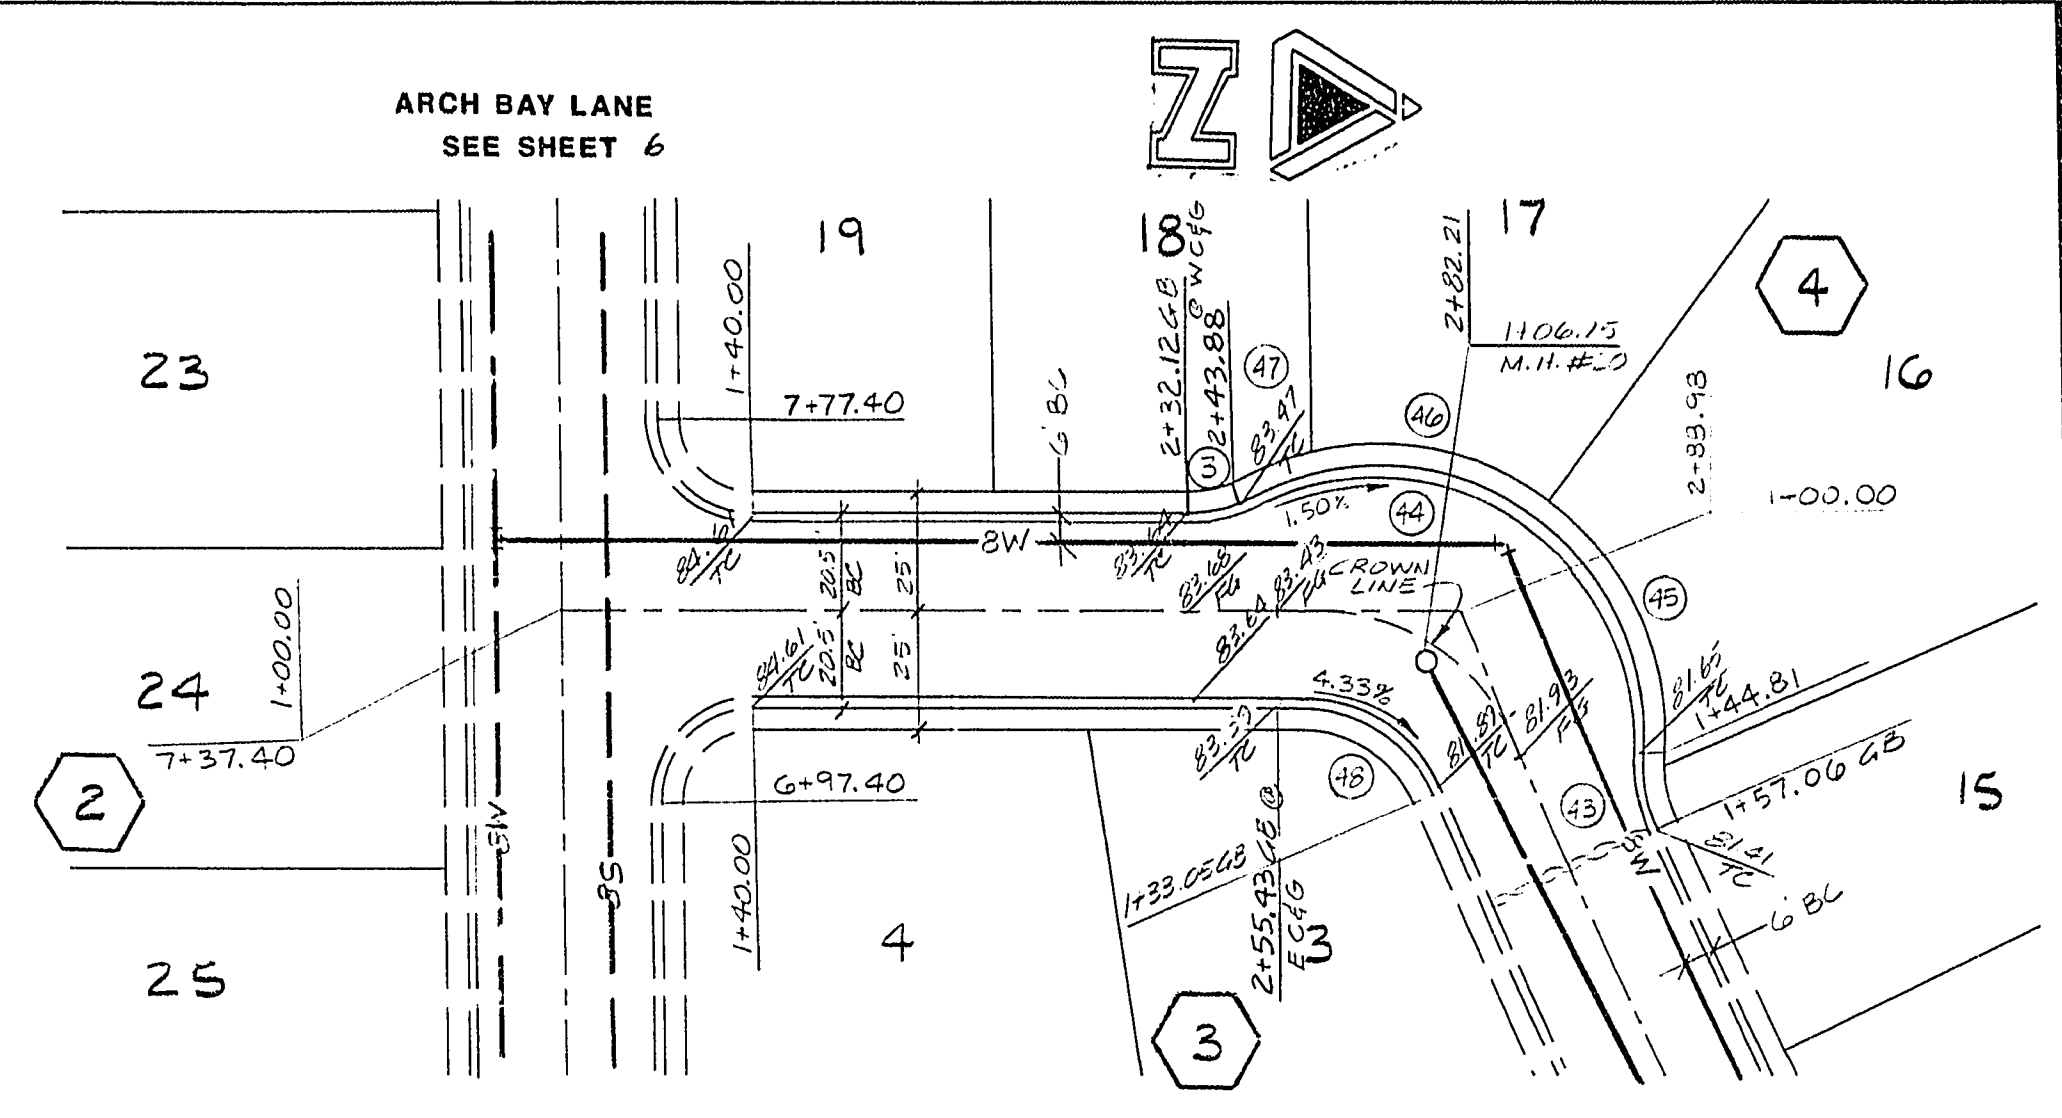
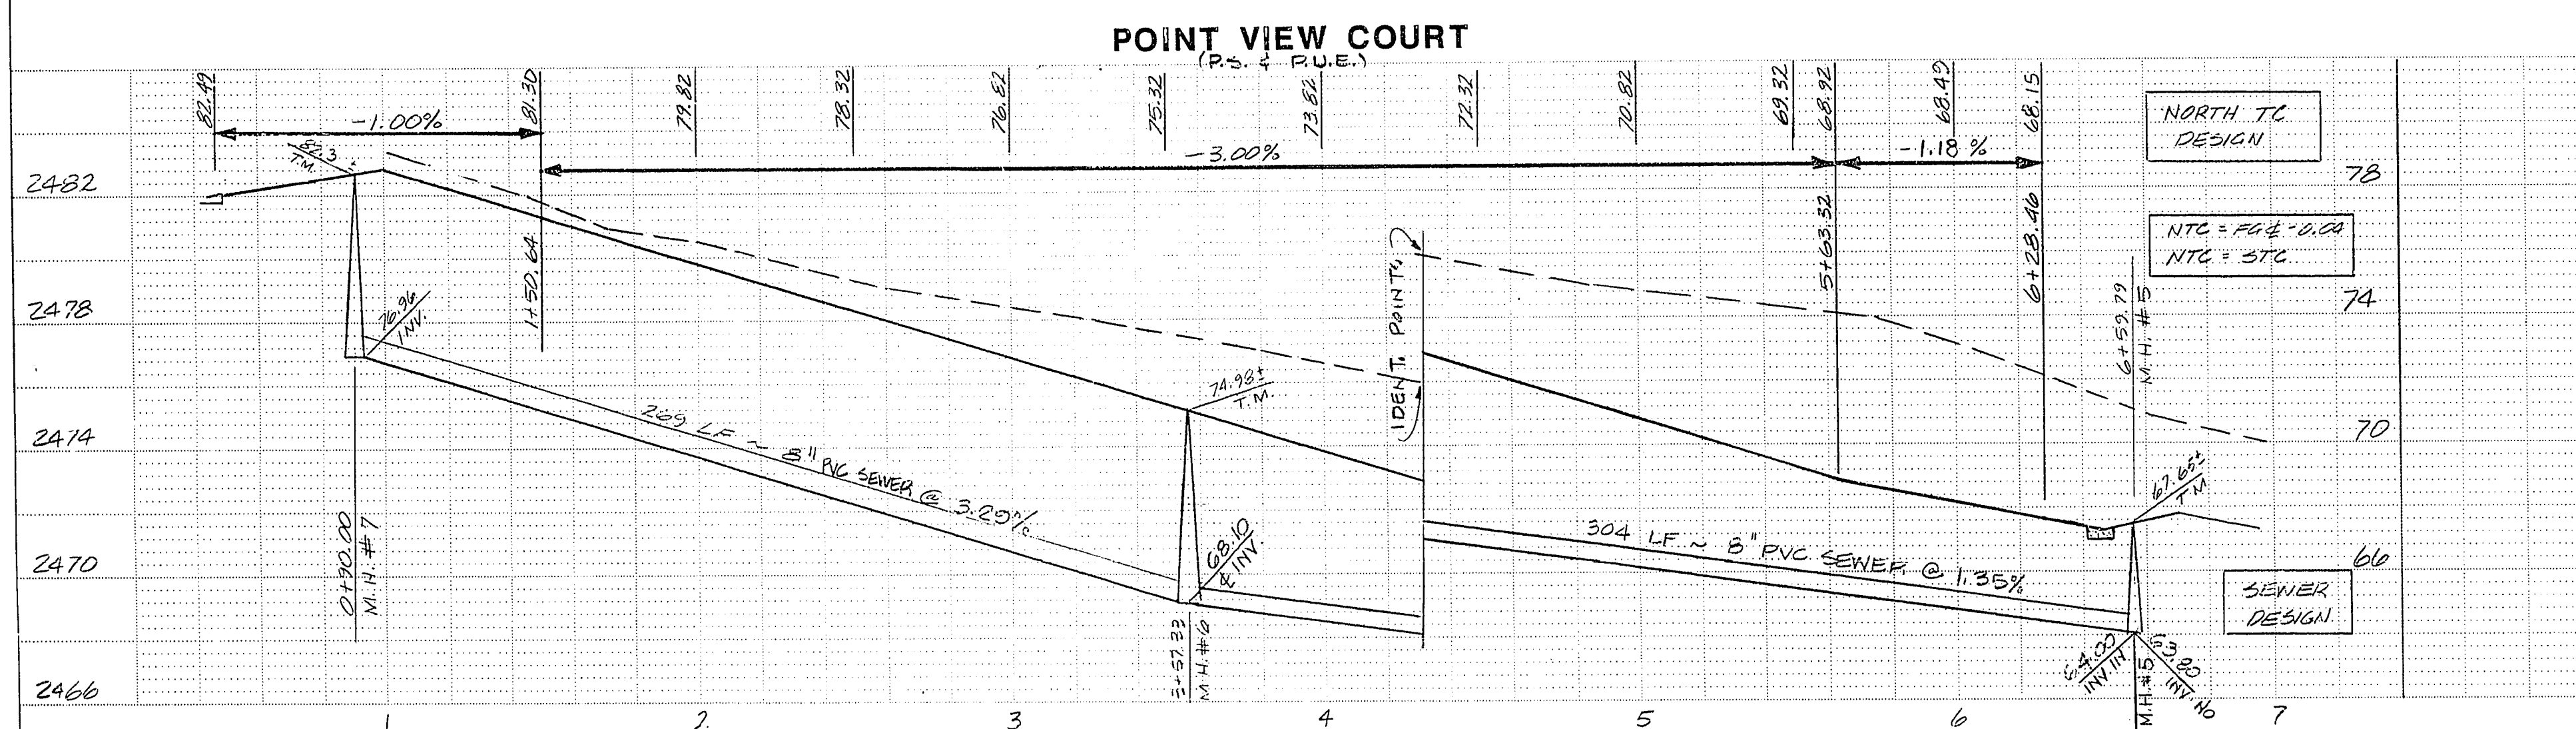


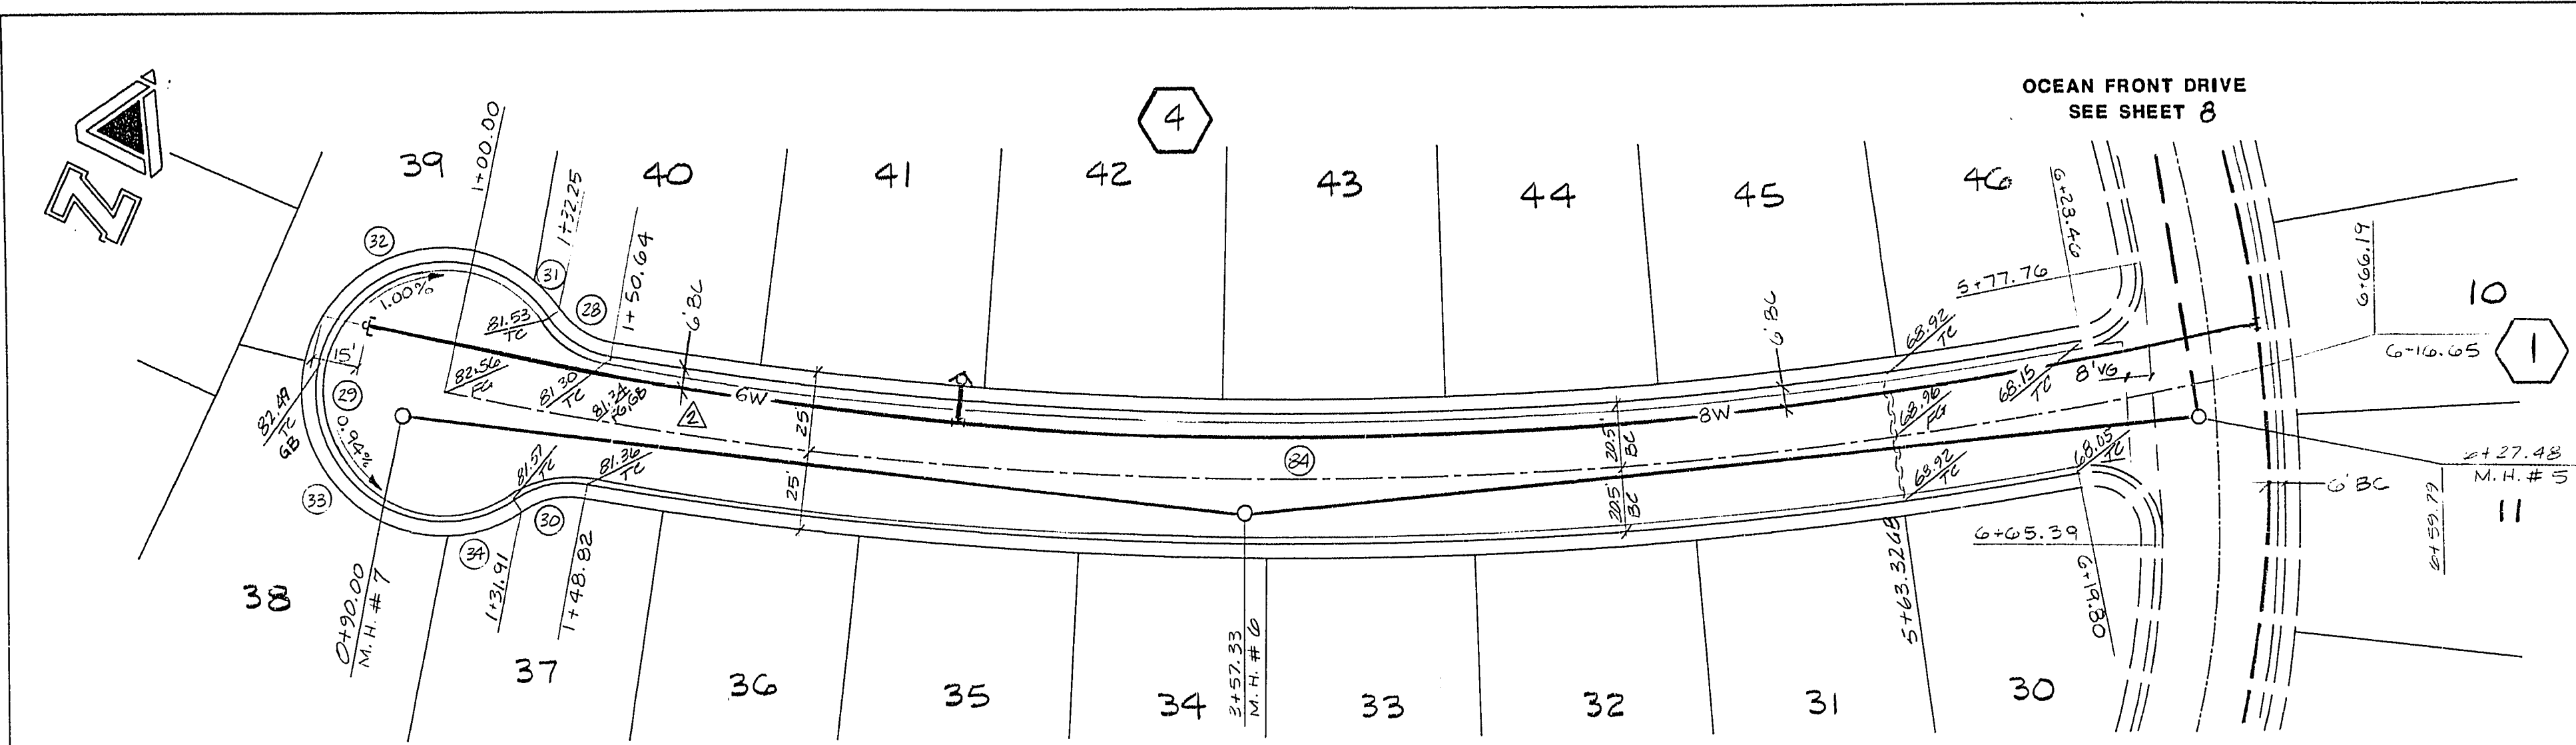

SCALE (H) 1" = 40'

SCALE (V) 1" = 4'

DES. G.H.B.

DR. A.R.S.

SECTION 6/21: 20 S. R.G.O.E.

DATE 11 MAY 89

BY JP

DESCRIPTION REV TC, T.M.H., SEWER GRADES

REV NO 2

LA JOLLA CLASSICS

LAS VEGAS

NEVADA

ST. IMPROVEMENT PLAN

OCEAN GATE WAY, CRYSTAL RIVER CT.

POINT VIEW COURT, ELLIOT KEY DRIVE.

JOB NO. 74070149

SHEET 7 OF 15

1074-4038