
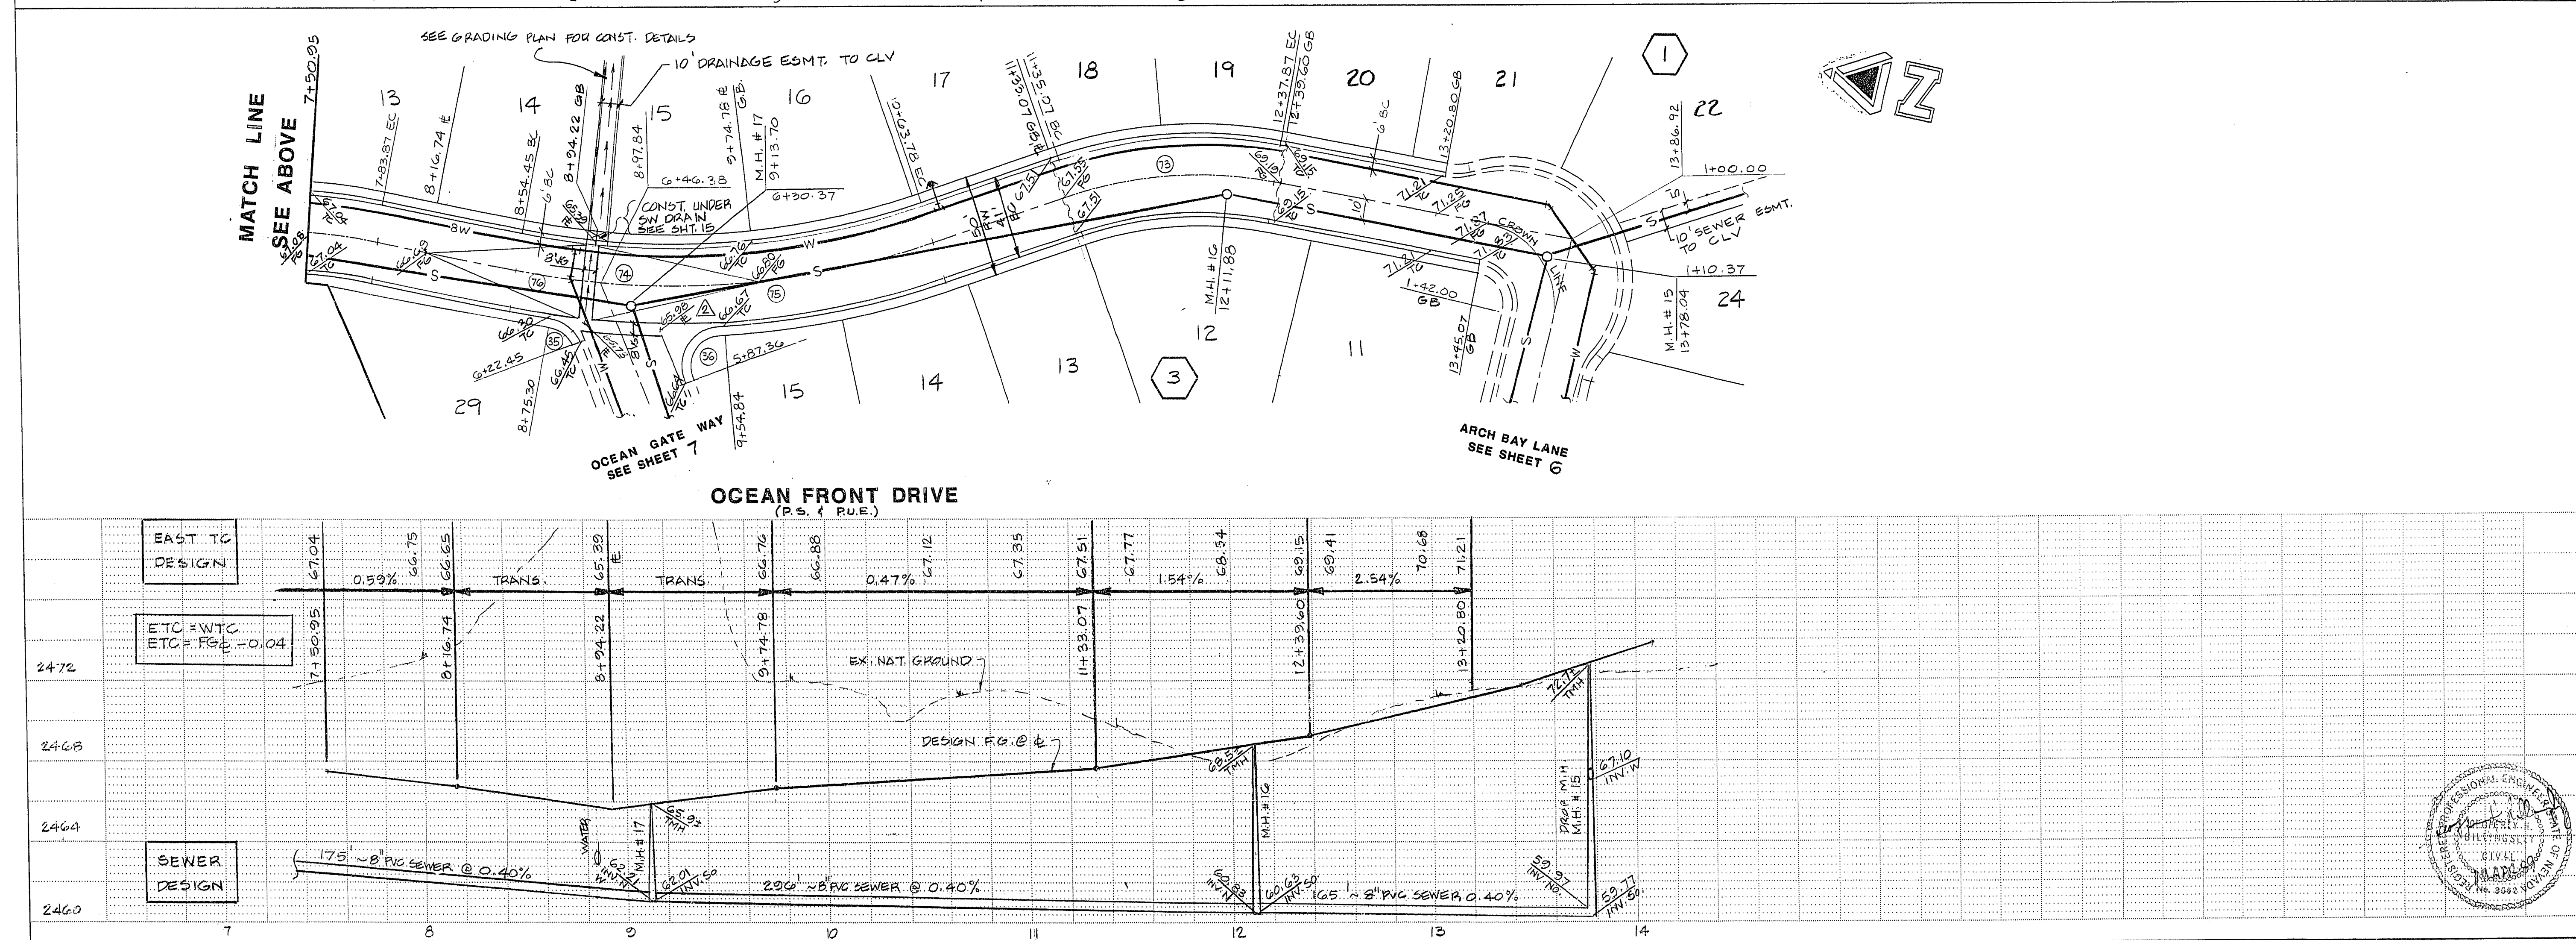


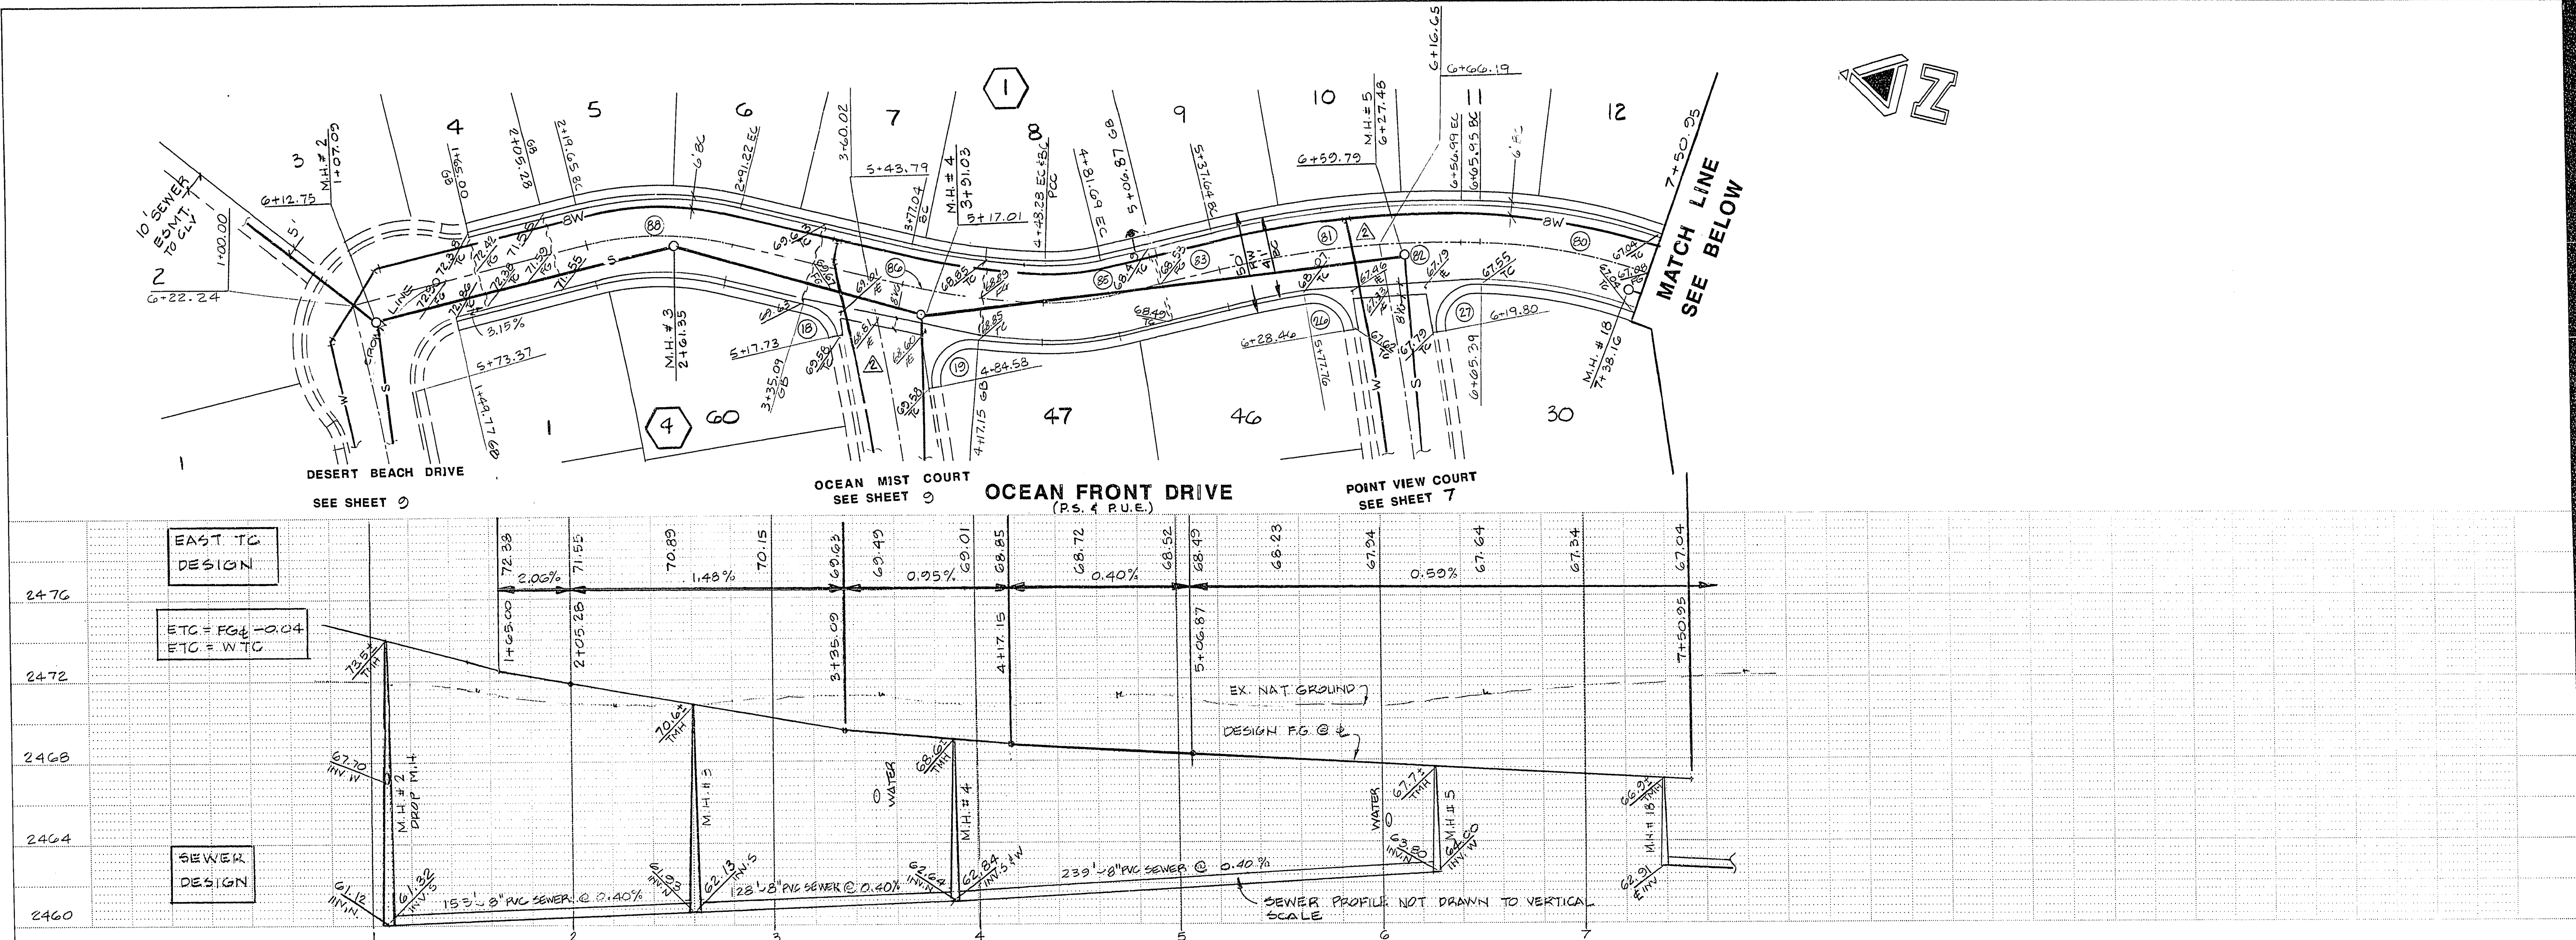

LA JOLLA CLASSICS
LAS VEGAS, NEVADA

ST. IMPROVEMENT PLAN
OCEAN FRONT DRIVE

ALCA
ENGINEERING & SURVEYING, INC.

820 SOUTH VALLEY VIEW BOULEVARD
LAS VEGAS, NV 89107 (702) 878-3358

JOB TITLE: **LA JOLLA CLASSICS**

JOB NO.: **74070149**

SHEET **8** OF **15**

SCALE (H): **1"=40'** SCALE (V): **1"=4'**

DES: **G.H.B.**

DR: **J.P.**

SECTION: **61210 S. R. 600 E.**

REV. NO. **1** REV. DATE **11 MAY 89**





