



LINE	BEARING	DISTANCE
L1	N 61°37'25" W	40.00
L2	S 52°18'12" E	40.00
L3	N 61°28'52" E	13.44
L4	S 89°54'40" E	7.50

CURVE	ARC	DELTA	RADIUS	TAN LENGTH
C1	23.38	89°18'06"	15.00	14.82
C2	14.33	3°53'18"	220.00	7.47
C3	22.00	84°02'11"	15.00	13.51
C4	23.56	90°00'00"	15.00	15.00
C5	13.96	5°19'51"	150.00	6.98
C6	22.18	84°42'17"	15.00	13.67
C7	18.47	6°02'53"	175.00	9.24
C8	4.28	9°48'45"	25.00	2.15
C9	8.70	19°56'14"	25.00	4.39
C10	12.12	27°47'14"	25.00	6.18
C11	8.78	0°07'31"	4010.00	4.39
C12	22.00	84°02'11"	15.00	13.51
C13	12.25	28°04'21"	25.00	6.25
C14	12.25	28°04'21"	25.00	6.25
C15	12.49	28°36'52"	25.00	6.38
C16	12.79	18°05'41"	40.50	6.45

B/C CURVE DATA				
NO.	Δ	L	R	T
1	20° 35' 38"	203.11	570.00	103.56
2	12° 23' 14"	125.34	580.00	62.94
3	91° 36' 53"	42.59	25.00	28.56
4	9° 38' 22"	26.92	160.00	13.49
5	1° 04' 44"	10.42	3740.00	35.21
6	84° 42' 17"	36.96	25.00	22.79
7	23° 16' 03"	61.01	165.00	33.91
8	9° 19' 46"	113.98	700.00	51.12
9	25° 45' 00"	18.11	35.00	9.30
10	130° 54' 59"	114.25	500.00	109.50
11	21° 41' 14"	16.97	35.00	8.66
12	2° 55' 41"	204.52	4000.00	102.28
13	35° 10' 53"	52.14	85.00	26.95
14	139° 16' 13"	60.98	25.00	68.24
15	173° 16' 35"	193.17	405.00	—
16	43° 30' 55"	18.99	25.00	9.98
17	28° 04' 21"	17.15	35.00	8.75
18	117° 32' 14"	102.51	50.00	82.46
19	28° 04' 21"	17.15	35.00	8.75
20	84° 02' 11"	36.61	25.00	22.52
21	55° 30' 20"	348.75	360.00	189.93
22	9° 15' 01"	93.66	580.00	46.93
23	91° 51' 20"	40.12	25.00	25.81
24	10° 56' 03"	36.26	190.00	18.18
25	8° 26' 14"	546.32	3710.00	273.65
26	91° 02' 55"	524.40	3300.00	336.10
27	84° 02' 11"	36.61	25.00	22.52
28	18° 25' 52"	115.81	360.00	58.41
29	6° 08' 01"	400.38	3740.00	200.38
30	97° 29' 40"	42.54	25.00	28.50
31	19° 50' 31"	46.76	135.00	23.61
32	11° 01' 25"	142.72	730.00	71.09
33	74° 52' 52"	45.74	35.00	26.80
34	3° 13' 20"	223.26	3970.00	111.66
35	35° 10' 53"	70.61	115.00	36.46
36	90° 00' 00"	39.21	25.00	25.00
37	61° 23' 32"	37.50	35.00	20.78

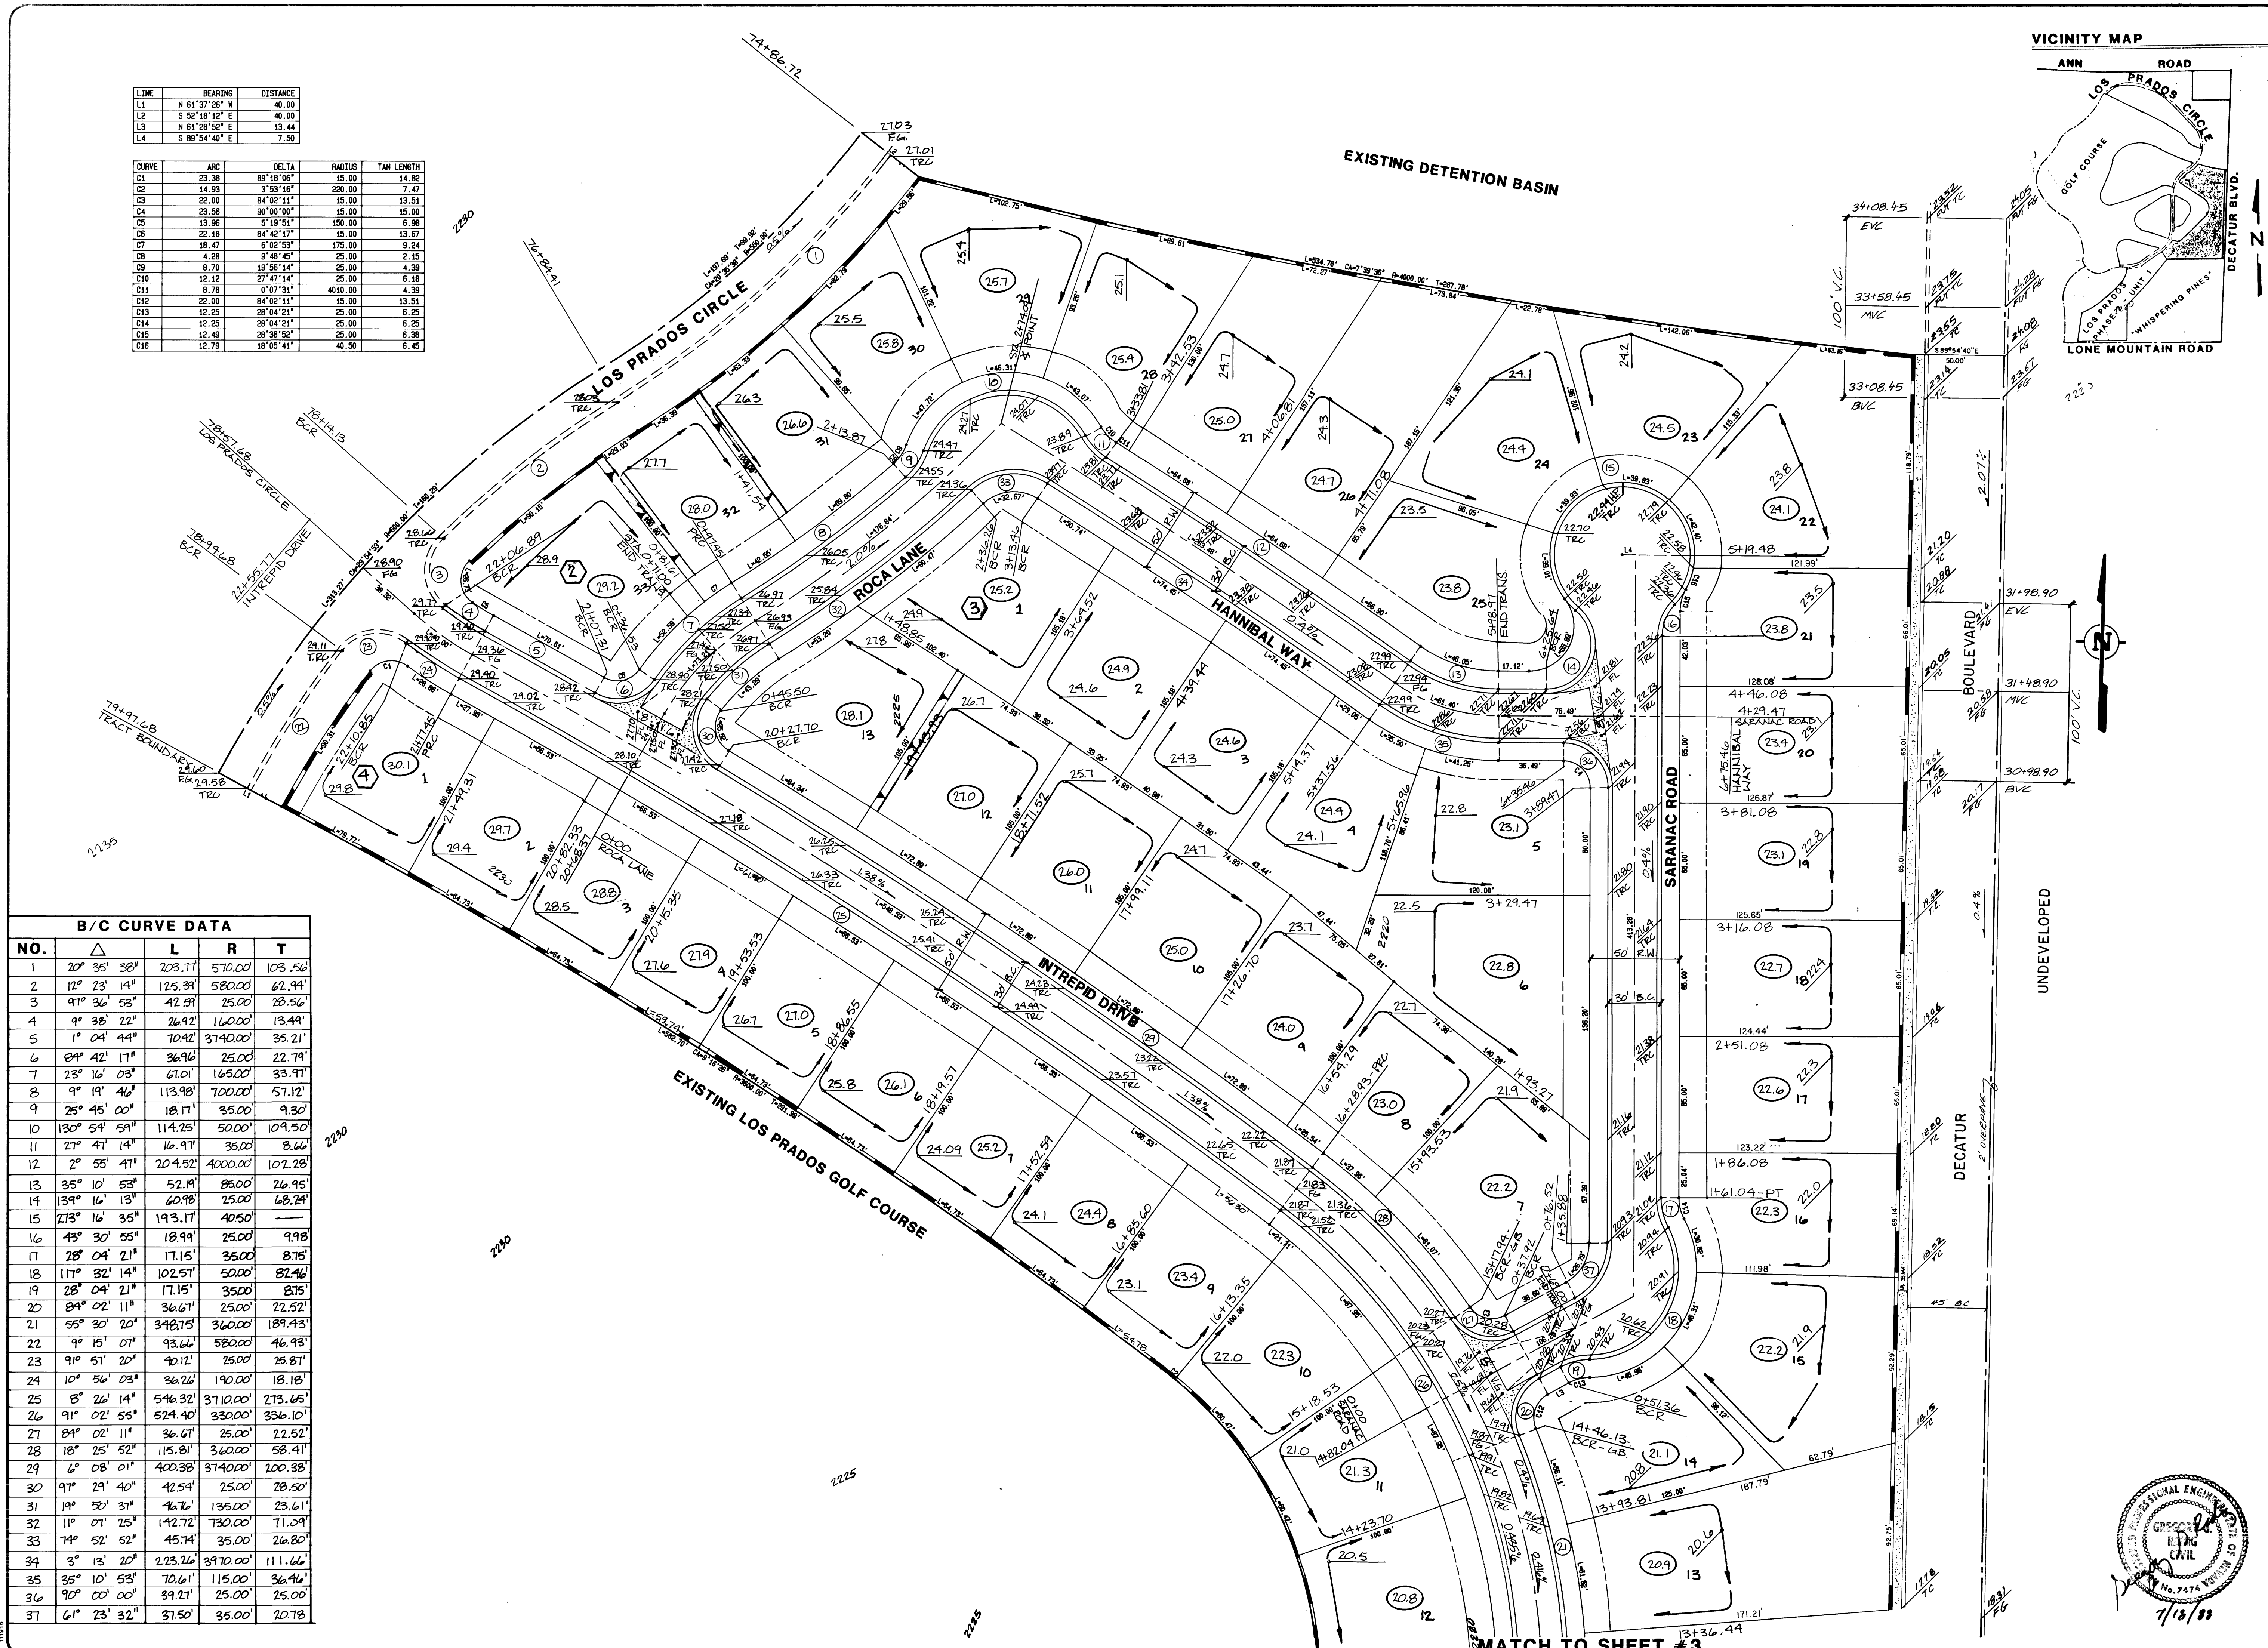

VICINITY MAP

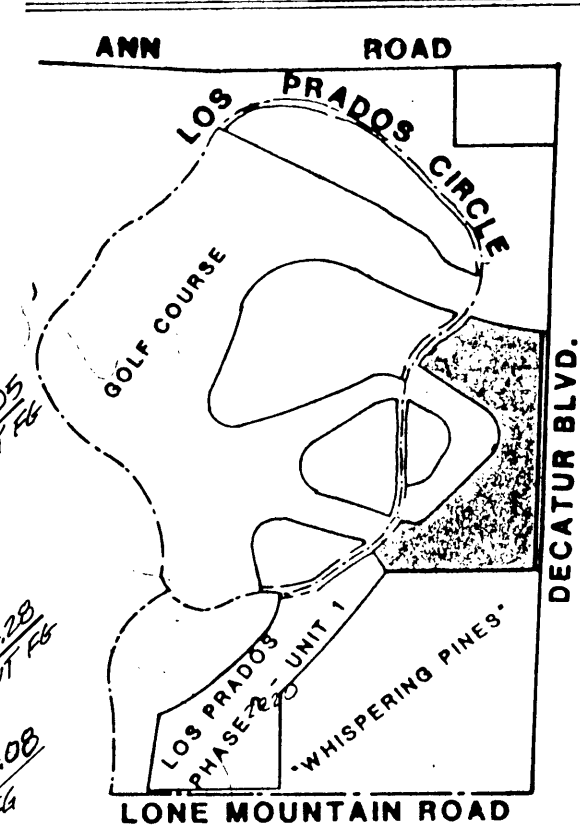

VISTA HILLS, INC.
LAS VEGAS, NEVADA

ROUGH GRADING PLAN

LOS PRADOS - PHASE 2 - UNIT 2

NO. 3188-LP2-2
BY G.R./F.L.C.
DATE JULY, 1988
SCALE 1" = 40'

SHEET
2
OF 13 SHEETS

CONSULTING ENGINEERS - PLANNERS
2300 PASEO DEL PRADO BUILDING A, SUITE 100
LAS VEGAS, NEVADA 89102 PHONE (702) 873-7550

vtm nevada

