

**BCR CURVE DATA**


NO.	Δ	R	L	T
1	90° 04' 36"	25.00'	39.30'	25.03'
2	89° 55' 22"	25.00'	39.24'	24.97'

NO.1A  
NO.1B




TENAYA WAY

FUTURE TENAYA WEST

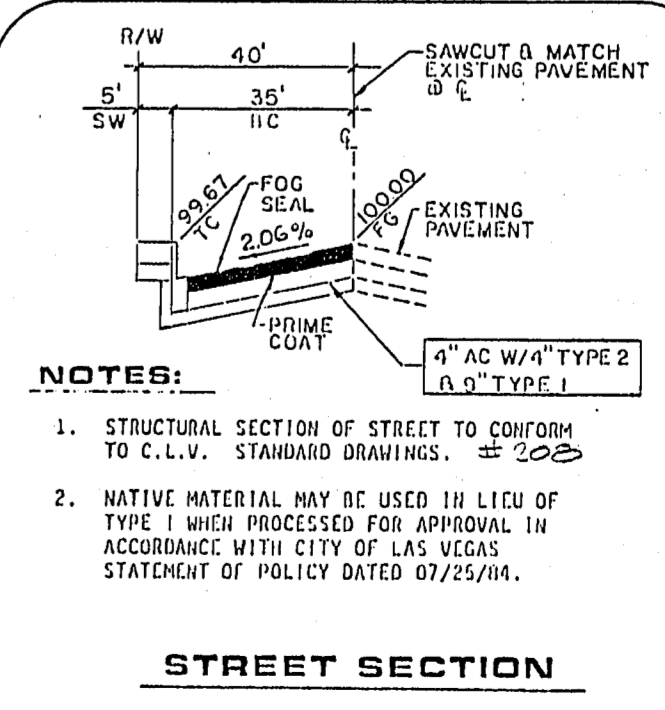

- NOTES:**
- STRUCTURAL SECTION OF STREET TO CONFORM TO C.L.V. STANDARD DRAWINGS, 2008
  - NATIVE MATERIAL MAY BE USED IN LIEU OF TYPE I WHICH PROCESSED FOR APPROVAL IN ACCORDANCE WITH CITY OF LAS VEGAS STATEMENT OF POLICY DATED 07/25/04.

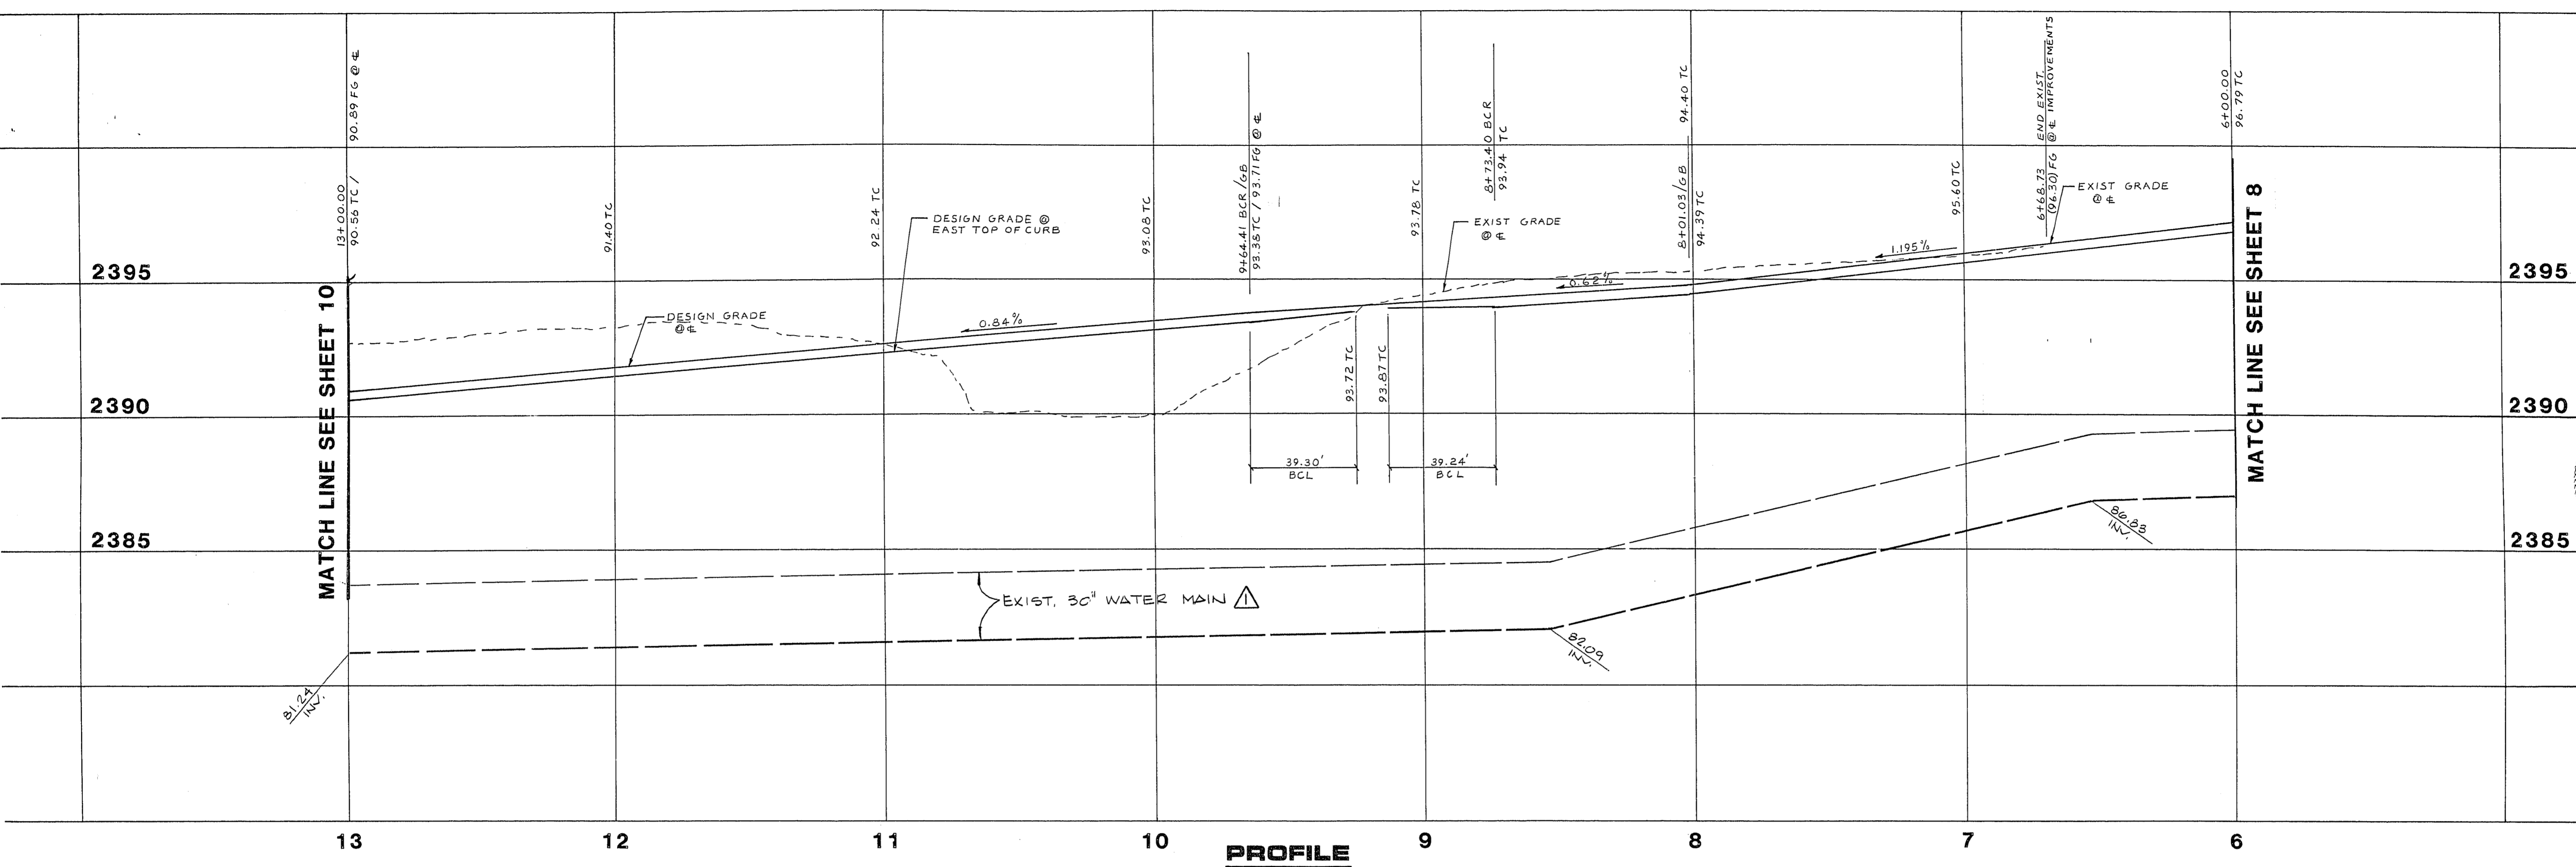


**PROFILE**  
SCALE: HORIZ. 1" = 30'  
VERT. 1" = 3'

MATCH LINE SEE SHEET 8

MATCH LINE SEE SHEET 10

REV	DATE	DESCRIPTION
1	6-11-10	ADD EXIST. 30" W/L TO PROFILE
2	8-26-10	CHANGE ST. NAMES, K/V

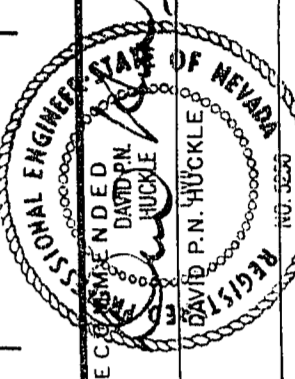

1555 SOUTH RAINBOW BLVD., LAS VEGAS, NEVADA 89102

**G.C. WALLACE, INC.**  
Engineering/Architecture

LEWIS HOMES OF NEVADA  
LEWIS HOMES - TENAYA EAST  
TENAYA WAY  
STA. 6+00.00 TO STA. 13+00.00

SHEET  
**9**  
OF 28 SHEETS