


SCALE: 1" = 30'

REV	DATE	DESCRIPTION
1	8-21-10	PROJ. CHANGE: STREET
2		REVISION: DATE
3		REVISION: DATE
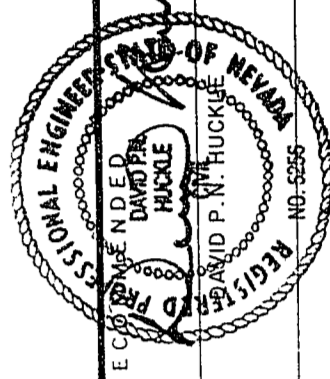

155 SOUTH HANBROW BLVD. LAS VEGAS, NEVADA 89102

G.C. WALLACE, INC.  
Engineering/Architecture

LEWIS HOMES OF NEVADA  
LEWIS HOMES - TENAYA EAST  
GRADING PLAN

SHEET  
26  
OF 28 SHEETS

121

Grdy 107V-4/28