
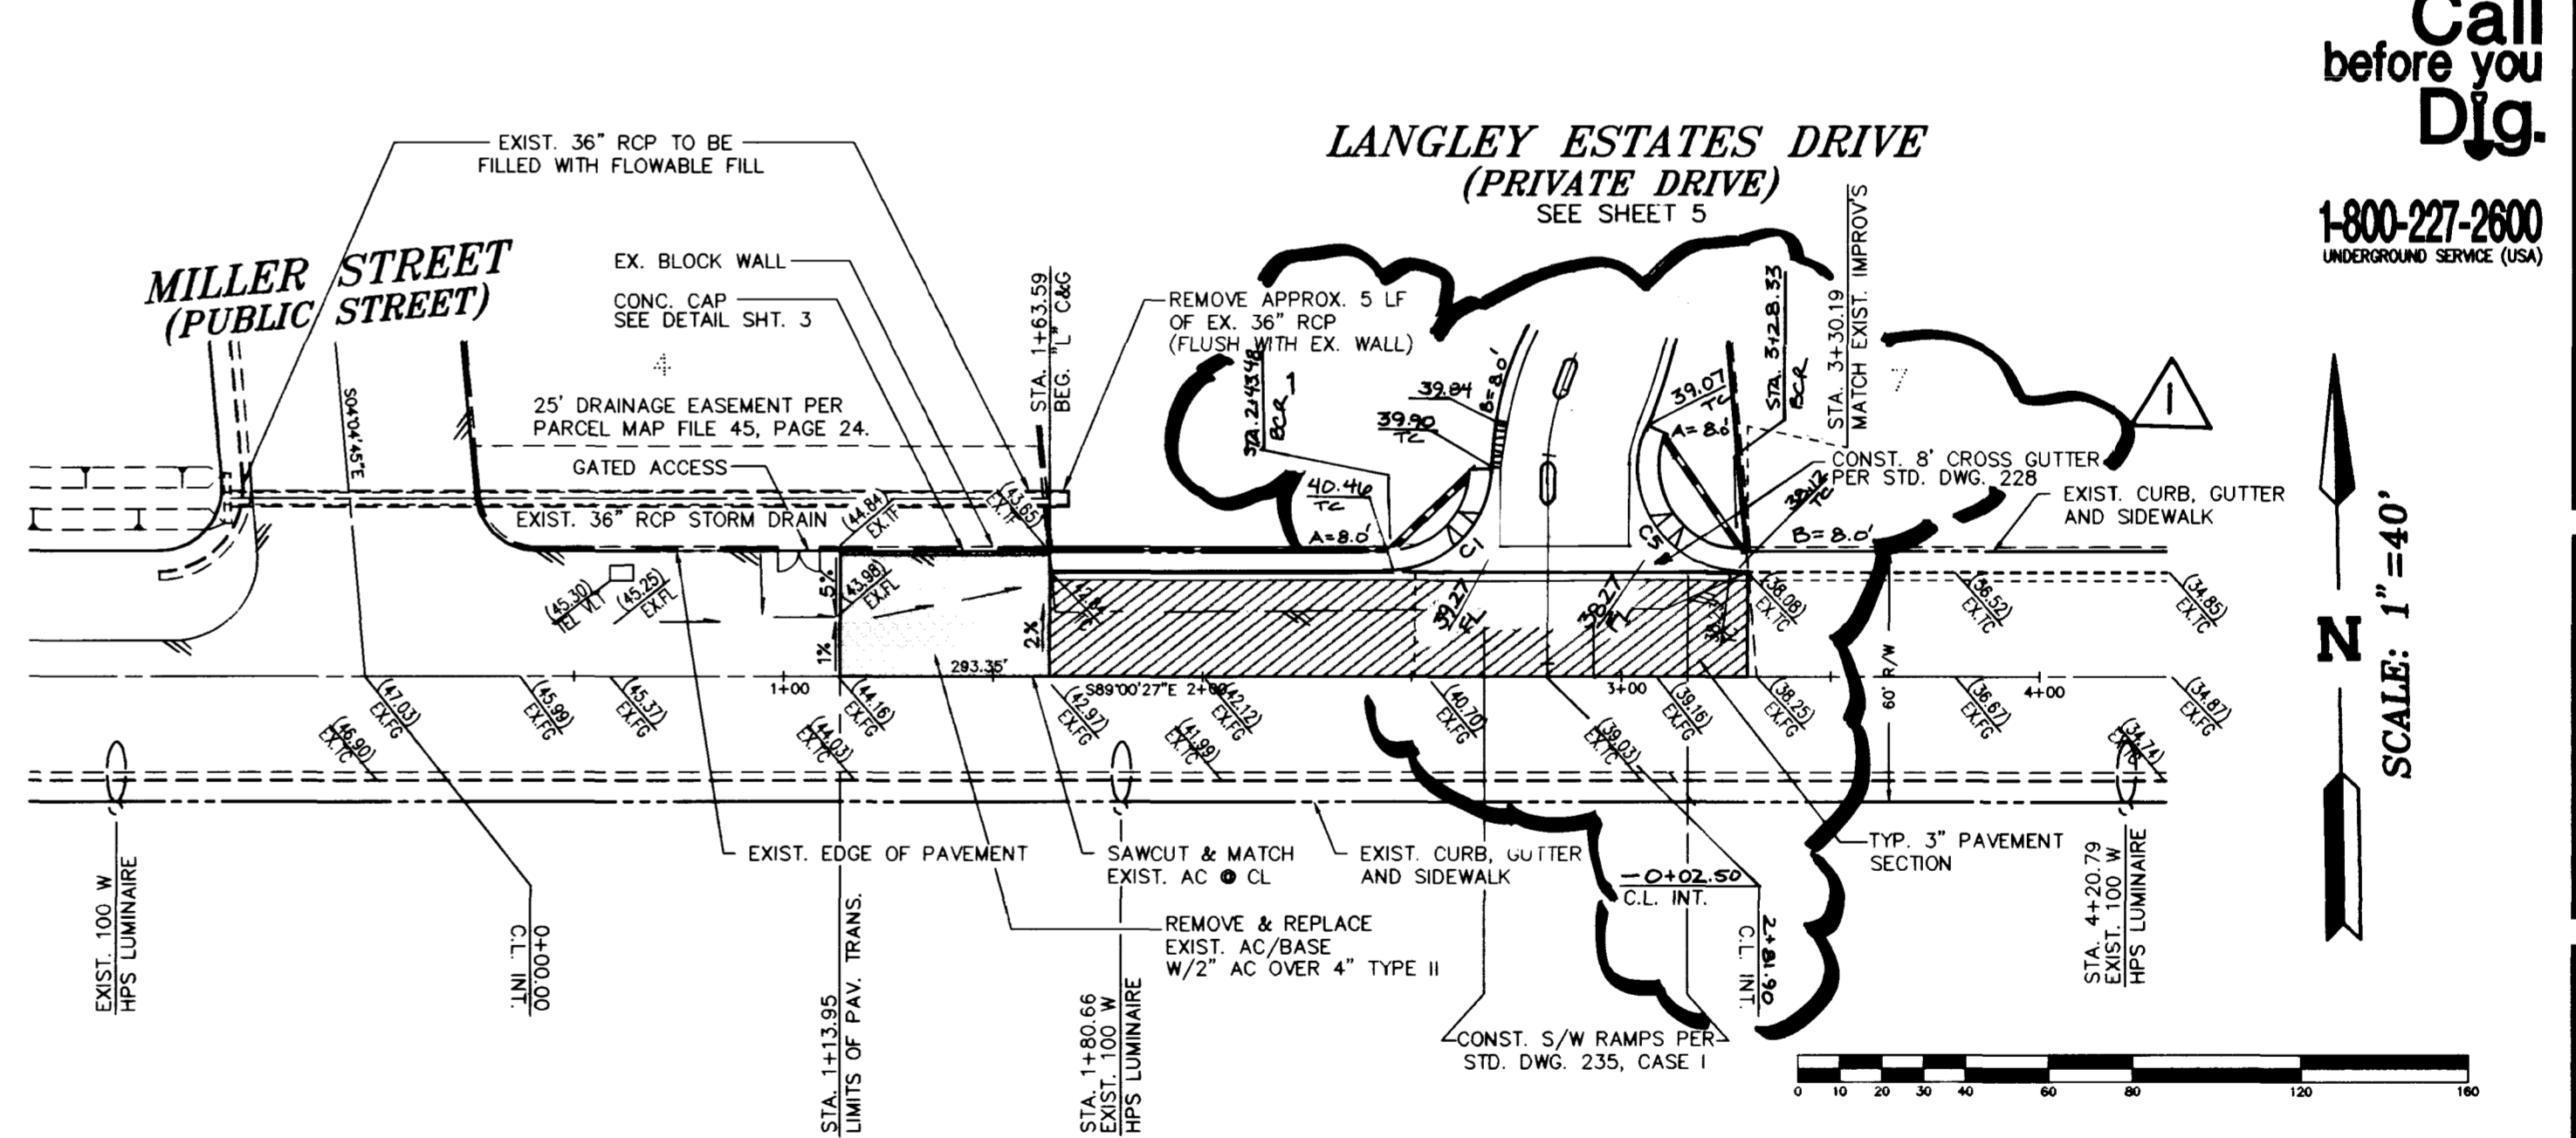


APPROVAL	DATE	BY	REVISION
	2-28-98	SEC	REVISED ENTRY FOR GATED ENTRANCE

0+00 1 2 3 4 0+00 1 2 3 4

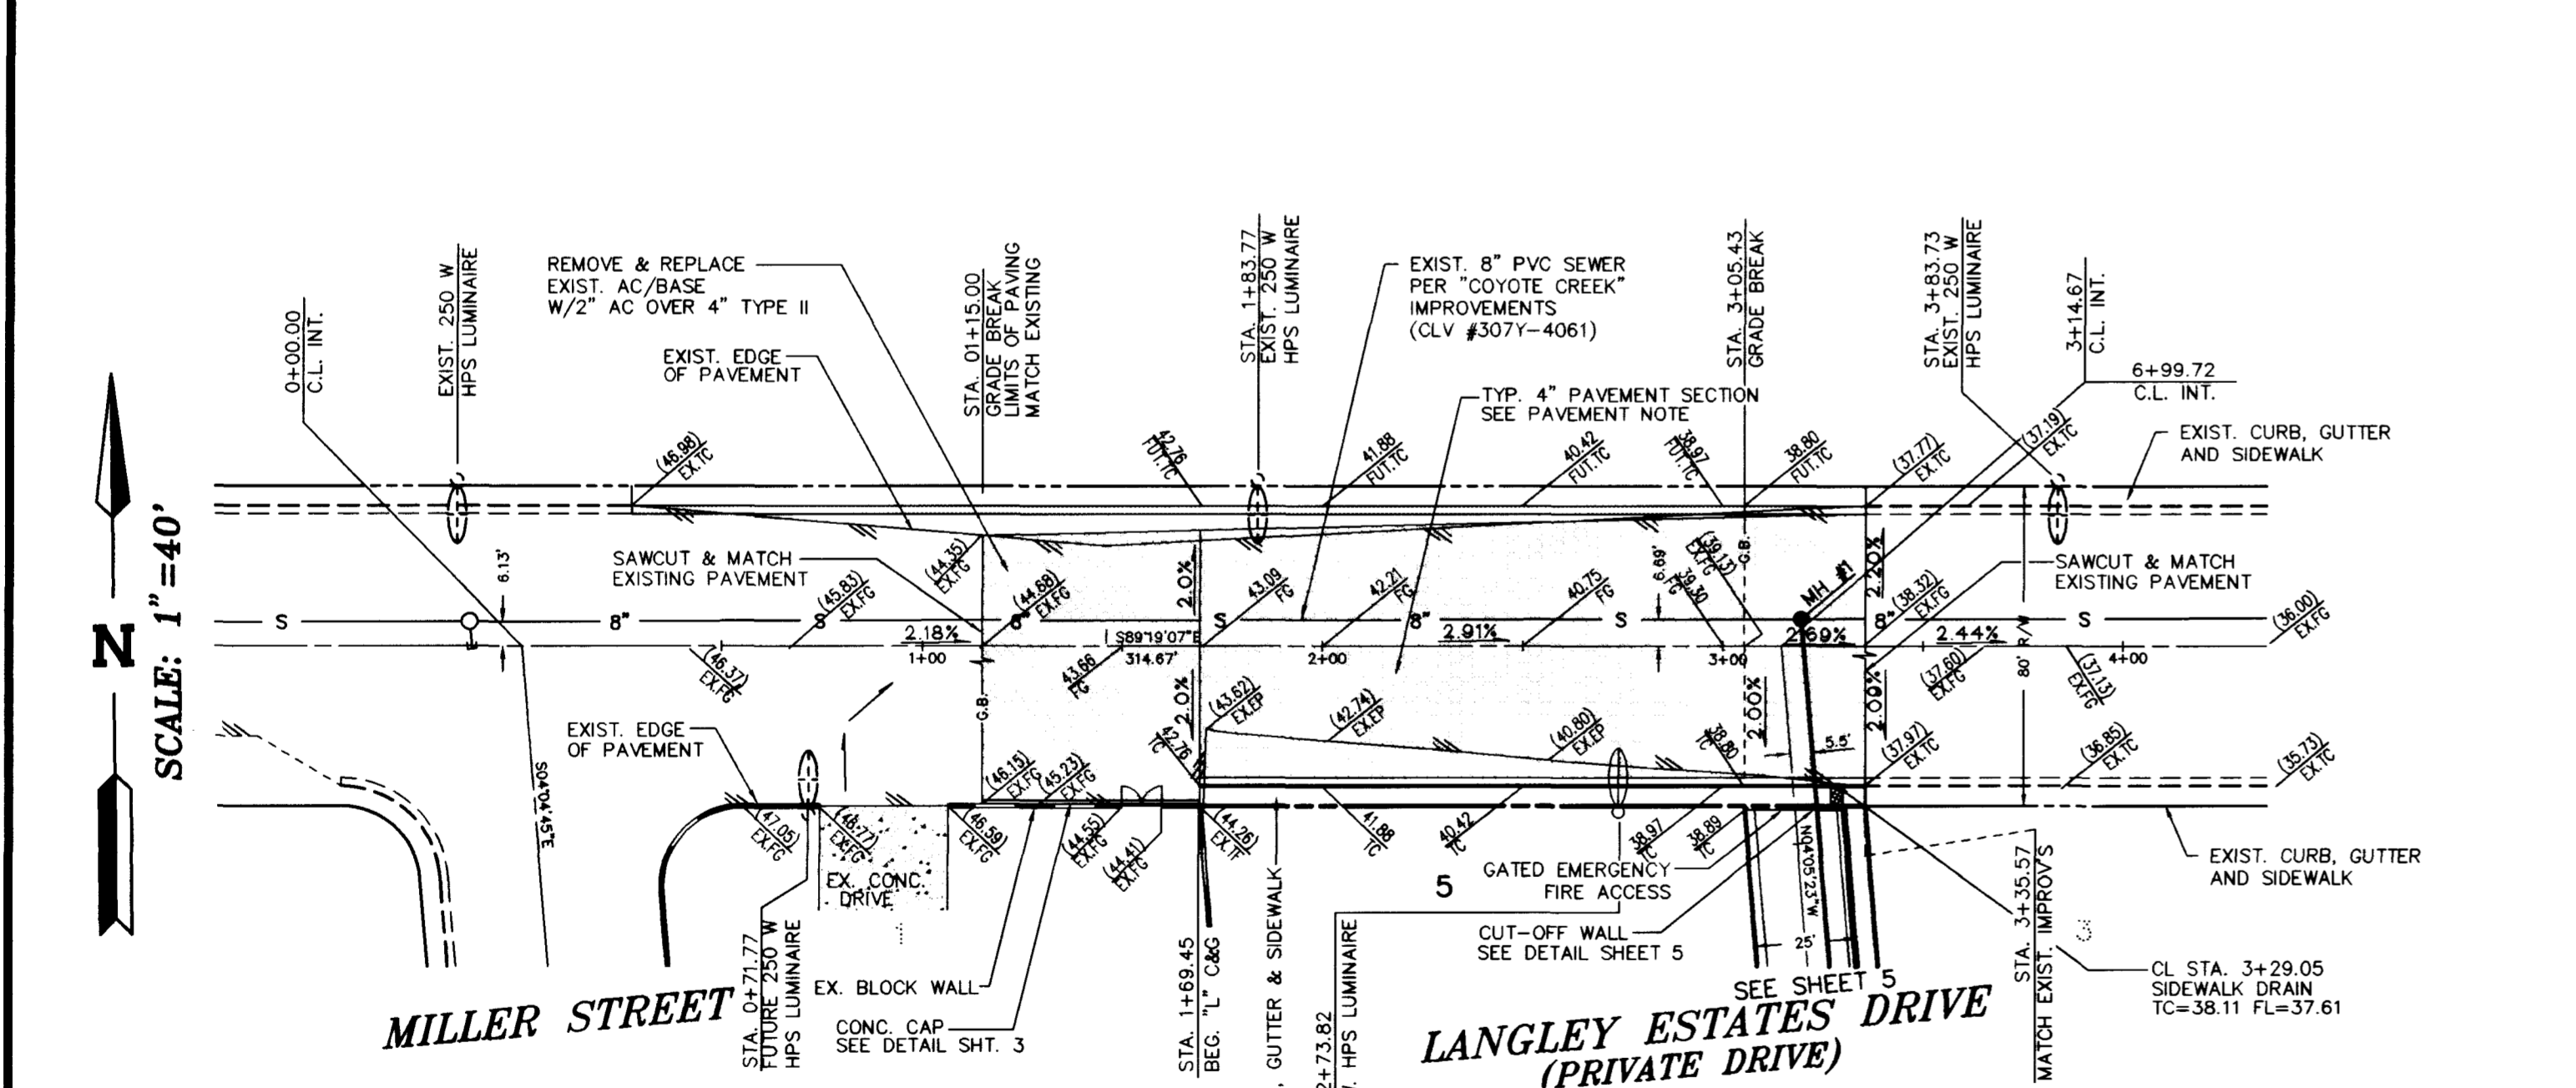


BACK OF CURB CURVE DATA

CURVE #	RADIUS	DELTA	LENGTH	TANGENT
C1	25.00'	87°57'46"	38.38'	24.13'
C5	25.00'	112°23'27"	49.04'	37.34'

UTILITY NOTE

UTILITY LOCATIONS SHOWN HEREON ARE APPROXIMATE ONLY. IT SHALL BE THE CONTRACTOR'S RESPONSIBILITY TO DETERMINE THE EXACT VERTICAL AND HORIZONTAL LOCATION OF ALL EXISTING UNDERGROUND UTILITIES PRIOR TO COMMENCING CONSTRUCTION. NO REPRESENTATION IS MADE THAT ALL EXISTING UTILITIES ARE SHOWN HEREON. THE ENGINEER ASSUMES NO RESPONSIBILITY FOR UTILITIES NOT SHOWN OR UTILITIES NOT SHOWN IN THEIR PROPER LOCATION.


CALL BEFORE YOU DIG: 1-800-227-2600

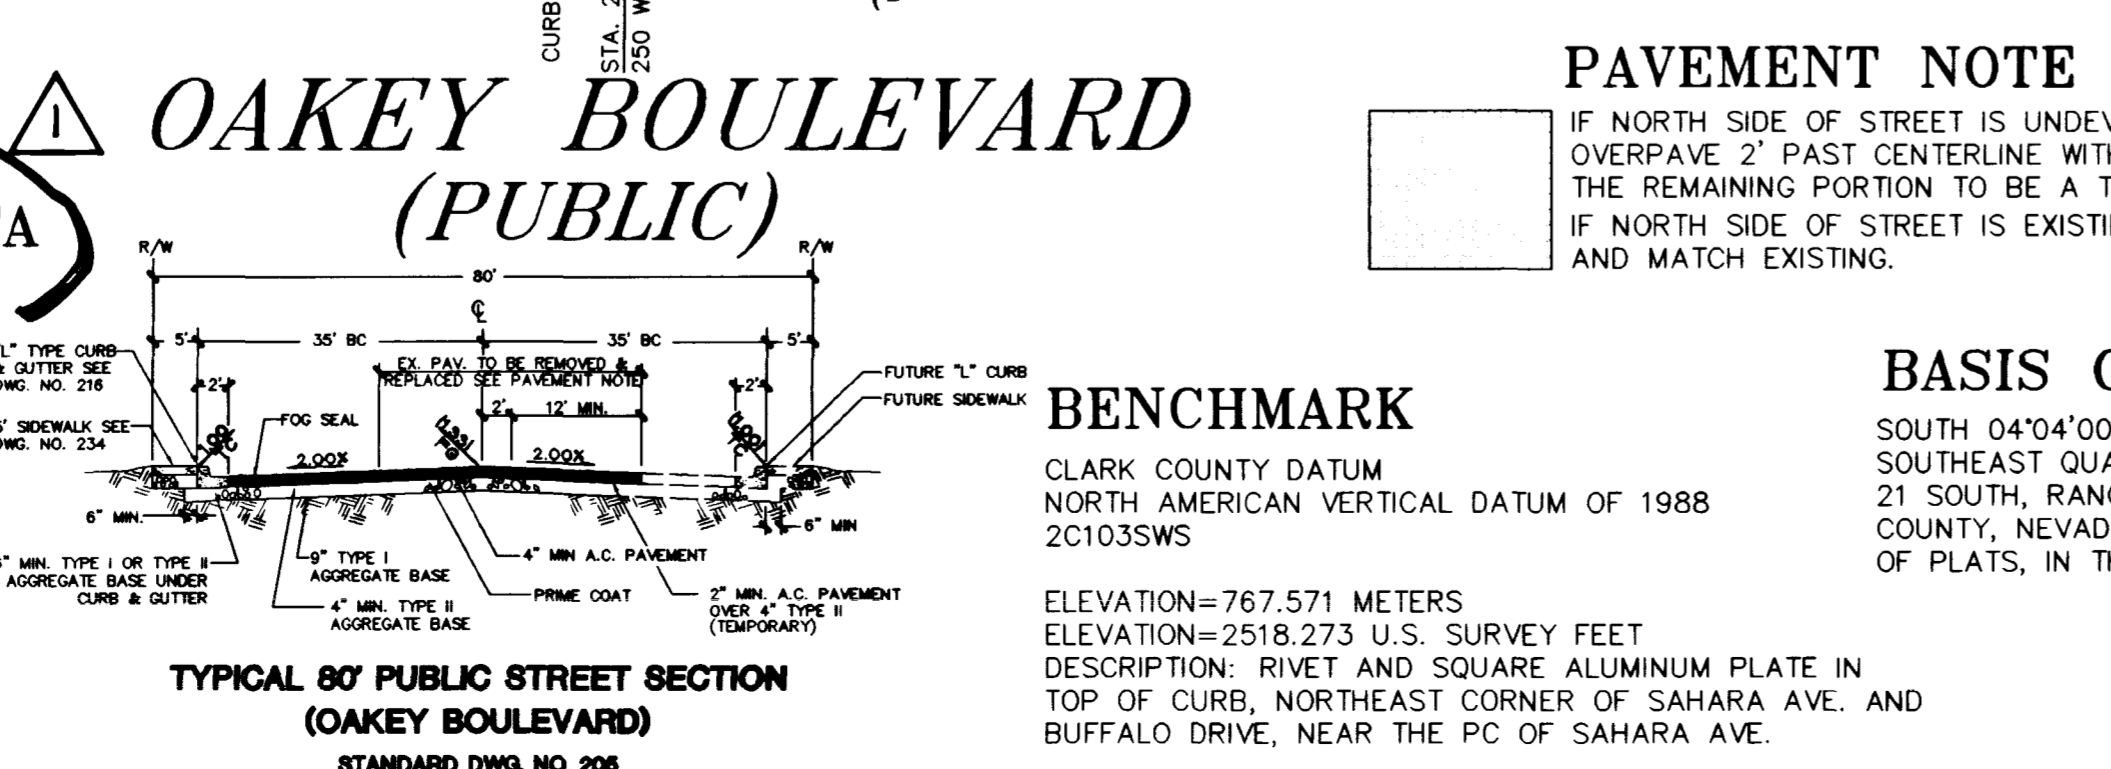

STREET & SEWER PLAN & PROFILE
OAKLEY BOULEVARD; EL PARQUE AVENUE

LANGLEY ESTATES

TITLE PROJECT

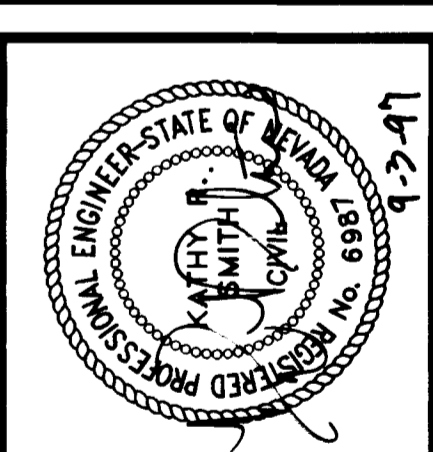

ESI ENGINEERS AND SURVEYORS, INC.
PLANNERS • CONSULTING ENGINEERS • SURVEYORS
7548 WEST SAHARA AVENUE • LAS VEGAS, NEVADA 89117 • (702) 248-6415

W.O. #: 984-C285
BY: DSR
DATE: AUG 1996
SCALE: 1"=40'

SHEET 4 OF 7

Call before you Dig.
1-800-227-2600
UNDERGROUND SERVICE (USA)

SCALE: 1"=40'

21-60-04