


SECTIONAL ELEVATION 1000  
SEE SHEET 100-101

REVISION ALL JOINTS FROM STA  
175+00 TO STA 174+00 AND FROM  
STA 174+00 TO STA 173+00

THE ALIGNMENT CHANGED BETWEEN  
STA 174+00 AND STA 173+00  
CONTRACTOR SHALL FOLLOW JOINTS  
TO OBTAIN PROPER ALIGNMENT.

PROPOSED INTERSECTIONS (PLAN SIGNALS)  
TO BE MAINTAINED THROUGH ALL  
PHASES OF CONSTRUCTION

Call  
Before You  
Dig  
1-800-485-5888

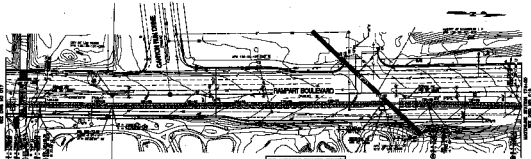

SECTIONAL ELEVATION 1000  
SEE SHEET 100-101