



H:\LAND\LAND\1346\34650\5013\5013.DWG PLOTTED BY: CFA

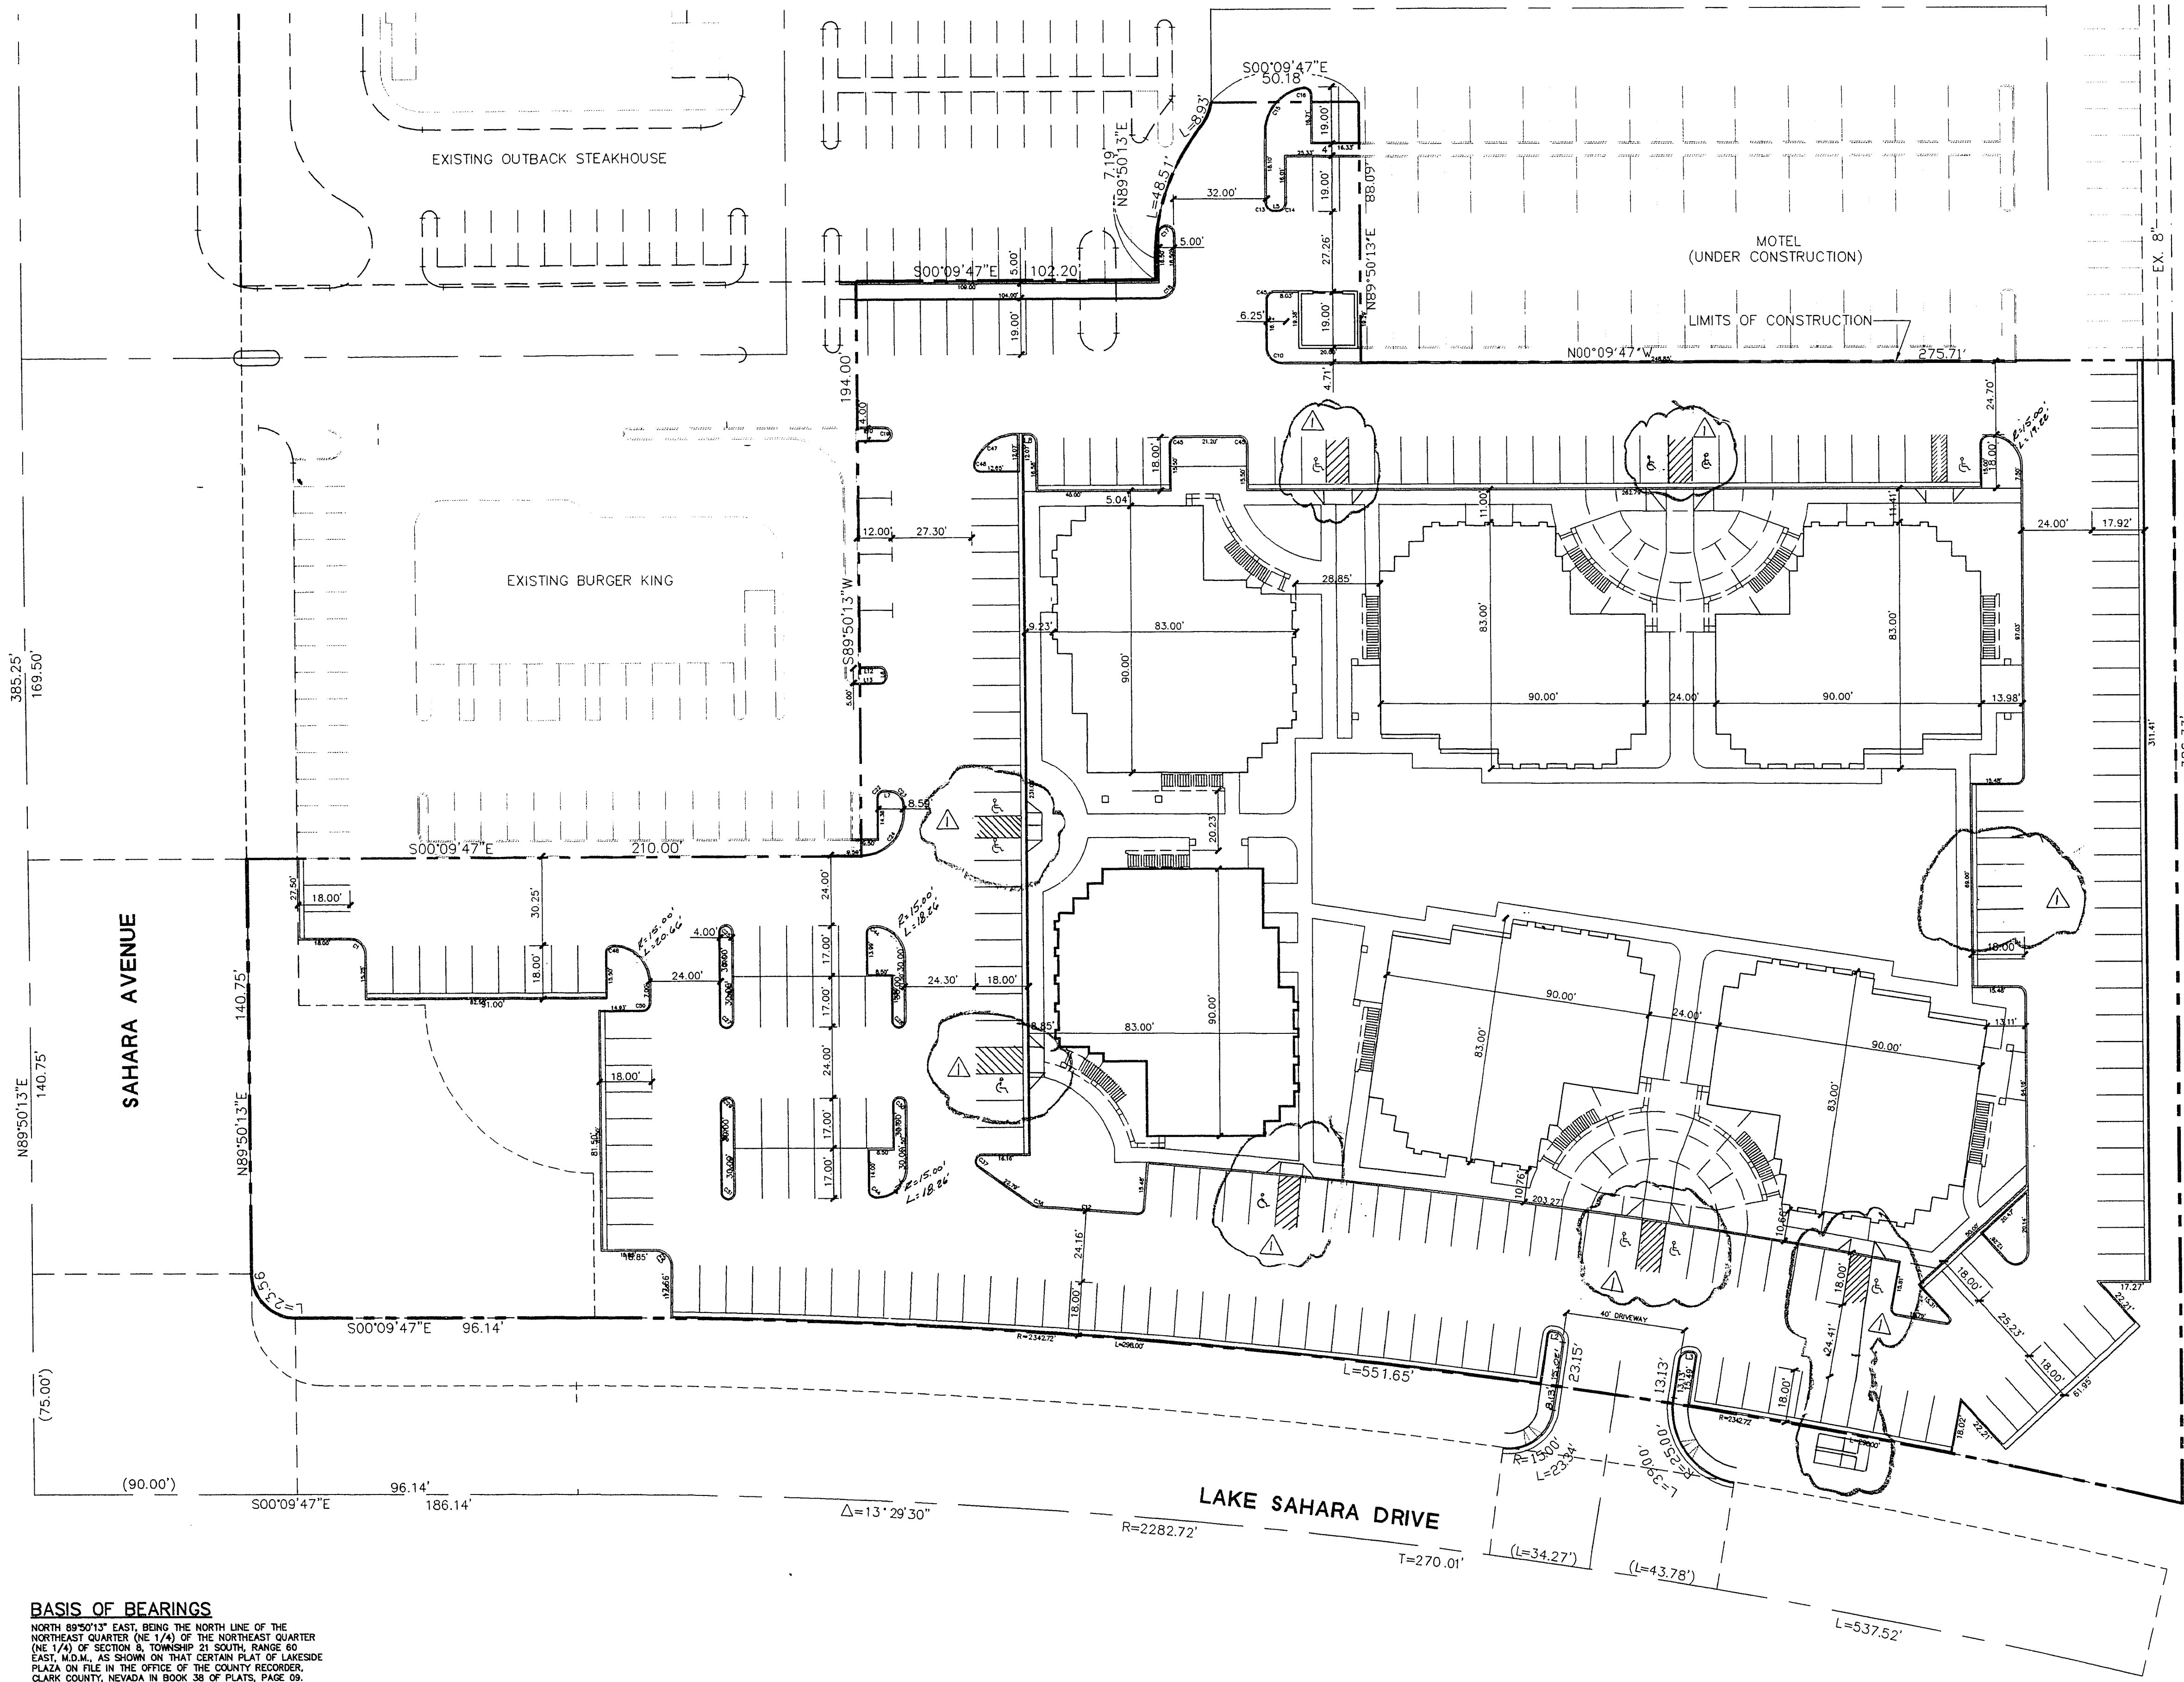


**BASIS OF BEARINGS**  
NORTH 89°50'13" EAST, BEING THE NORTH LINE OF THE  
NORTHEAST QUARTER (NE 1/4) OF THE NORTHEAST QUARTER  
(NE 1/4) OF SECTION 8, TOWNSHIP 21 SOUTH, RANGE 60  
EAST, M.D.M., AS SHOWN ON THAT CERTAIN PLAT OF LAKESIDE  
PLAZA ON FILE IN THE OFFICE OF THE COUNTY RECORDER,  

**BENCHMARK**  
CITY OF LAS VEGAS BENCHMARK STAMPED "1LV10 5556"  
RIVET AND PLATE IN TOP OF CURB ON SAHARA AVENUE,  
180' WEST OF LAKE SAHARA DRIVE, NORTH CURB LINE.  
ELEVATION = 2691.30 (NAVD 88)

2 working  
days  
Call  
before you  
Dig  
1-800-227-2600

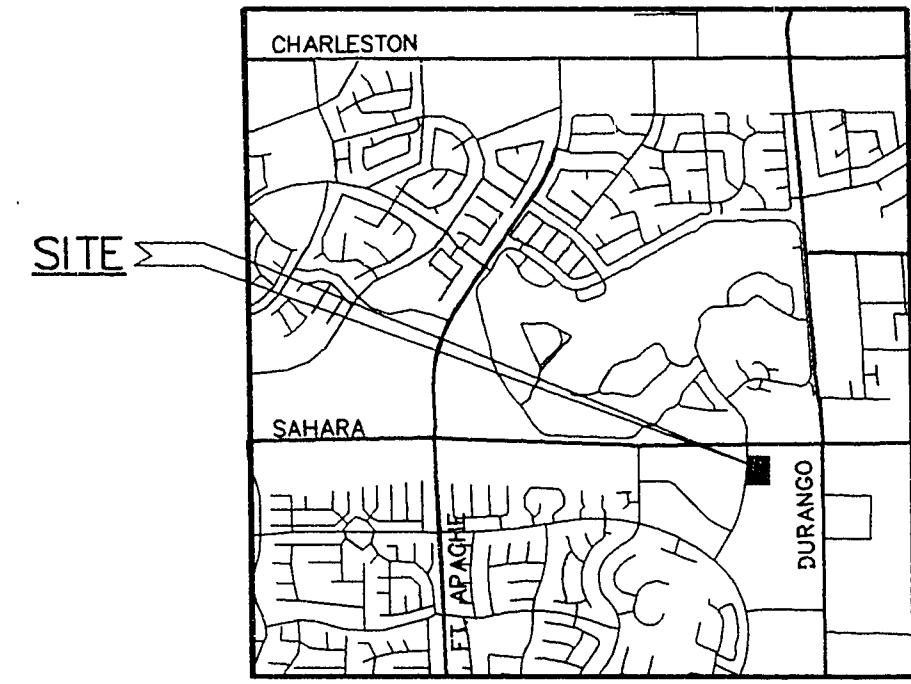

LOCATION MAP

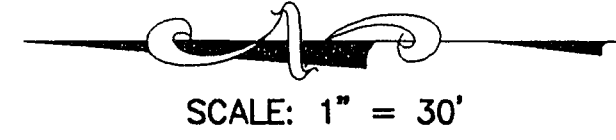

GRAPHIC SCALE

LINE DATA

| LINE | DIRECTION   | DISTANCE |
|------|-------------|----------|
| L1   | S00°09'47"E | 1.00'    |
| L2   | S07°57'41"W | 0.98'    |
| L3   | S09°06'24"W | 1.03'    |
| L4   | S00°09'47"E | 1.21'    |
| L5   | S00°09'47"E | 1.12'    |
| L6   | S89°50'13"W | 1.01'    |
| L7   | S00°00'00"E | 2.10'    |
| L8   | N89°50'27"E | 1.54'    |
| L9   | S03°32'15"W | 7.20'    |
| L10  | S00°09'47"E | 2.67'    |
| L11  | S00°00'00"E | 9.51'    |
| L12  | S00°00'00"E | 7.24'    |
| L13  | S00°00'00"E | 9.50'    |

CURVE DATA

| CURVE | RADIUS    | LENGTH | TANGENT    | DELTA      |
|-------|-----------|--------|------------|------------|
| C1    | 5.00'     | 7.85'  | 5.00'      | 90°00'00"  |
| C2    | 2.50'     | 3.93'  | 2.50'      | 90°00'00"  |
| C3    | 2.50'     | 3.93'  | 2.50'      | 90°00'00"  |
| C4    | 2.50'     | 3.93'  | 2.50'      | 90°00'00"  |
| C5    | 5.00'     | 7.85'  | 5.00'      | 90°00'00"  |
| C6    | 1.00'     | 1.57'  | 1.00'      | 90°00'00"  |
| C7    | 3.00'     | 4.71'  | 3.00'      | 90°00'00"  |
| C8    | 3.00'     | 4.71'  | 3.00'      | 90°00'00"  |
| C9    | 1.00'     | 1.57'  | 1.00'      | 90°00'00"  |
| C10   | 5.00'     | 7.85'  | 5.00'      | 90°00'00"  |
| C11   | 2.00'     | 3.14'  | 2.00'      | 90°00'00"  |
| C12   | 2.385,22' | 34.19' | 17.10'     | 00°49'17"  |
| C13   | 2.50'     | 3.93'  | 2.50'      | 90°00'00"  |
| C14   | 2.50'     | 3.93'  | 2.50'      | 90°00'00"  |
| C15   | 14.50'    | 21.05' | 12.87'     | 83°09'48"  |
| C16   | 2.00'     | 3.14'  | 2.24'      | 96°30'38"  |
| C17   | 2.50'     | 7.85'  | <infinite> | 180°00'00" |
| C18   | 5.00'     | 7.85'  | 5.00'      | 90°00'00"  |
| C19   | 2.00'     | 6.28'  | 144700.68' | 180°00'00" |
| C20   | 2.00'     | 3.14'  | 1.99'      | 89°50'13"  |
| C21   | 2.00'     | 3.14'  | 2.01'      | 90°09'47"  |
| C22   | 2.00'     | 3.14'  | 2.01'      | 90°09'47"  |
| C23   | 4.50'     | 7.06'  | 4.49'      | 89°50'13"  |
| C24   | 14.50'    | 22.78' | 14.50'     | 90°00'00"  |
| C25   | 2.00'     | 6.28'  | 789.46'    | 178°42'48" |
| C26   | 2.00'     | 6.28'  | 251313.17' | 180°00'00" |
| C27   | 2.00'     | 6.28'  | 218212.23' | 179°59'56" |
| C28   | 2.00'     | 6.28'  | 142773.25' | 179°59'56" |
| C29   | 2.00'     | 6.28'  | 183806.68' | 179°59'56" |
| C30   | 2.00'     | 6.28'  | 141875.51' | 180°00'00" |
| C31   | 2.00'     | 6.27'  | 802.77'    | 179°42'52" |
| C32   | 2.00'     | 6.28'  | 198808.97' | 180°00'00" |
| C33   | 2.00'     | 3.15'  | 2.01'      | 90°21'59"  |
| C34   | 15.00'    | 23.47' | 14.90'     | 89°38'01"  |
| C35   | 5.00'     | 7.52'  | 4.68'      | 89°12'48"  |
| C36   | 2.00'     | 1.12'  | 0.58'      | 320°07'14" |
| C37   | 2.00'     | 5.03'  | 6.18'      | 144°08'26" |
| C38   | 2.00'     | 3.17'  | 2.02'      | 90°40'19"  |
| C39   | 1.00'     | 2.48'  | 2.92'      | 142°12'04" |
| C40   | 4.00'     | 9.63'  | 10.39'     | 137°53'24" |
| C41   | 2.50'     | 3.93'  | 2.50'      | 90°00'00"  |
| C42   | 2.50'     | 3.93'  | 2.50'      | 90°00'00"  |
| C43   | 2.50'     | 7.52'  | <infinite> | 180°00'00" |
| C44   | 2.00'     | 3.15'  | 2.01'      | 90°09'47"  |
| C45   | 2.50'     | 3.93'  | 2.50'      | 90°00'00"  |
| C46   | 2.50'     | 3.92'  | 2.49'      | 89°50'13"  |
| C47   | 15.00'    | 17.77' | 10.10'     | 87°53'38"  |
| C48   | 2.00'     | 3.14'  | 2.00'      | 90°00'00"  |
| C49   | 12.00'    | 18.85' | 12.00'     | 90°00'00"  |
| C50   | 2.50'     | 3.92'  | 2.50'      | 90°00'00"  |
| C51   | 10.00'    | 15.68' | 9.97'      | 89°50'13"  |
| C52   | 10.00'    | 15.71' | 10.00'     | 90°00'00"  |


BECKER ENTERPRISES  
CITY OF LAS VEGAS

CONSULTING ENGINEERS • PLANNERS • LAND SURVEYORS  
2727 SOUTH RAINBOW BOULEVARD  
LAS VEGAS, NEVADA 89102-5148 PHONE (702) 873-7550 FAX (702) 362-2597



HORIZONTAL CONTROL PLAN

LAKESIDE VILLAGE II  
SAHARA / LAKE SAHARA DRIVE

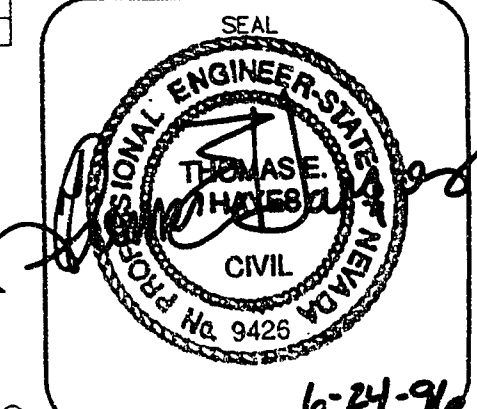

NO. 4962  
BY: CFA  
DATE: JAN. 1996  
SCALE: HORIZ. 1" = 30'  
SHEET: 2 OF 4 SHEETS

H:\246\LAND\246\346\34650\5013\5013.DWG

107-V2490