


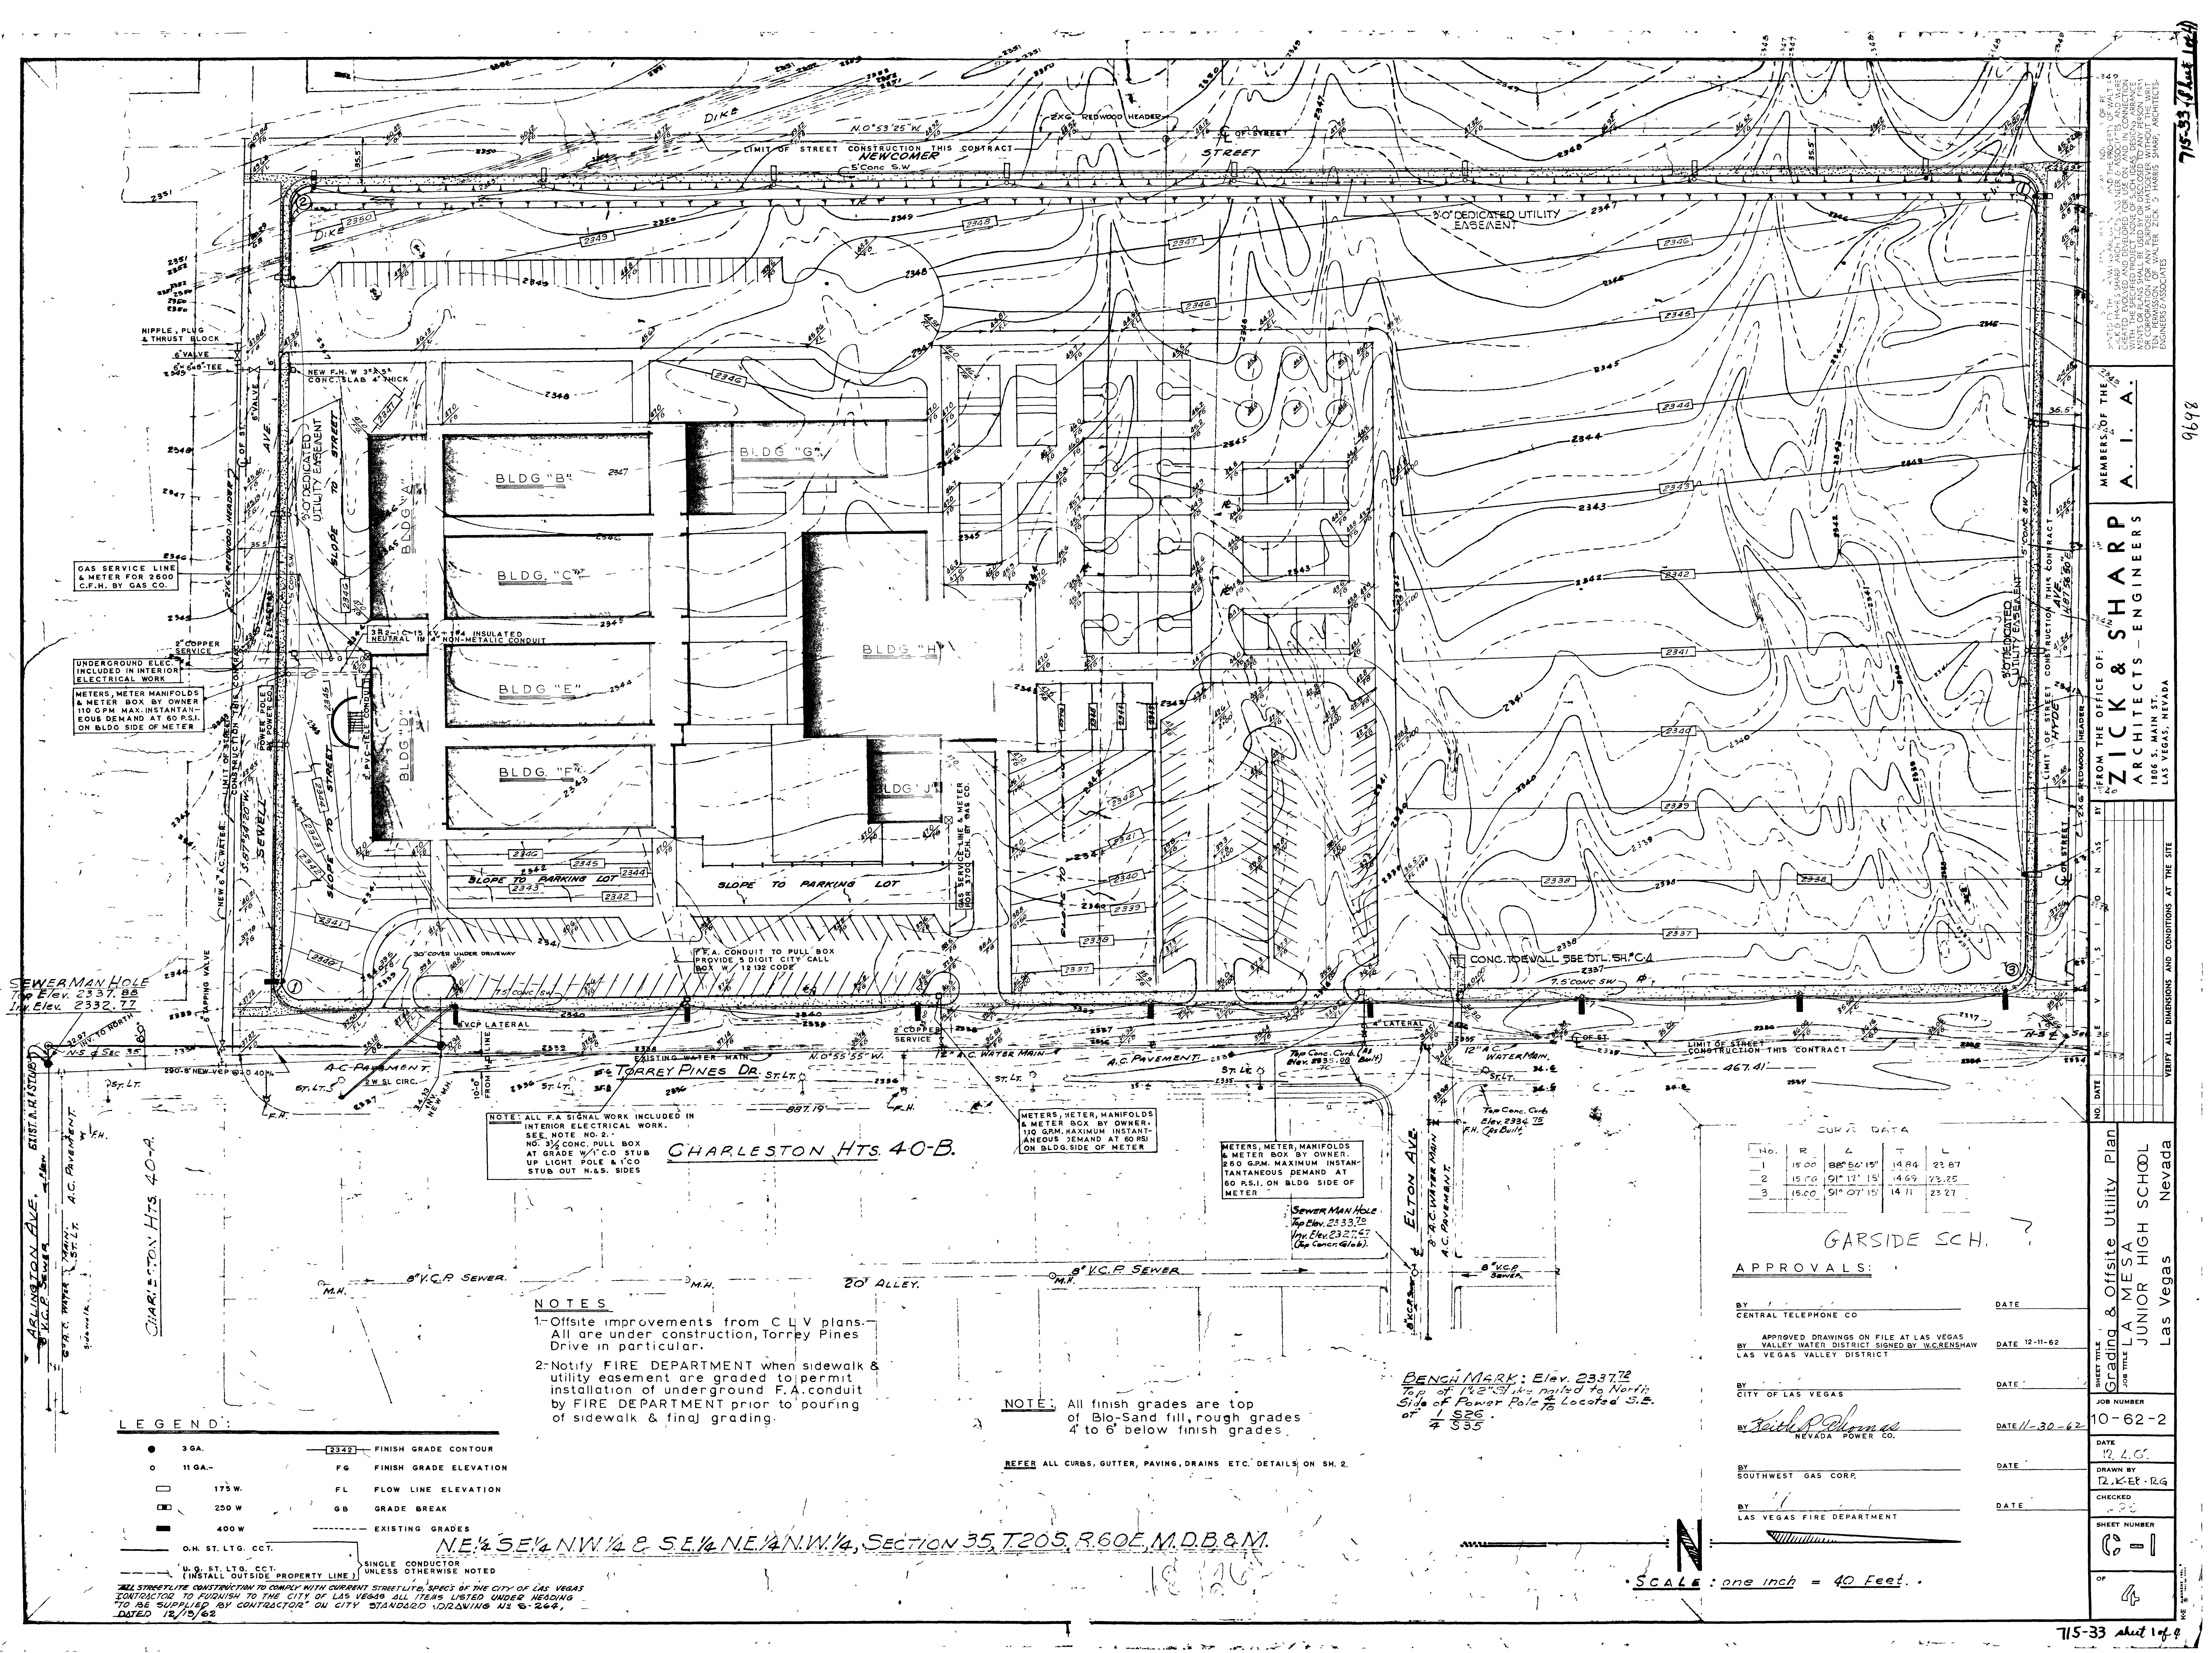

CURVE DATA

No.	R	Δ	T	L
1	15.00	88°56'15"	14.84	23.87
2	15.00	91°11'15"	14.69	23.25
3	15.00	91°07'15"	14.71	23.27

GARSDALE SCH.

APPROVALS:

BY: CENTRAL TELEPHONE CO. DATE: 12-11-62

APPROVED DRAWINGS ON FILE AT LAS VEGAS BY: VALLEY WATER DISTRICT SIGNED BY: W. CRENSHAW LAS VEGAS VALLEY DISTRICT

BY: CITY OF LAS VEGAS DATE: 11-30-62

BY: SOUTHWEST GAS CORP. DATE: 12-1-62

BY: LAS VEGAS FIRE DEPARTMENT DATE: 12-1-62

Grading & Offsite Utility Plan

LA ME SA JUNIOR HIGH SCHOOL Las Vegas Nevada

10-62-2

DATE: 12-1-62

DRAWN BY: R. K. R. R. G.

CHECKED: R. K. R. R. G.

SHEET NUMBER: 1

