
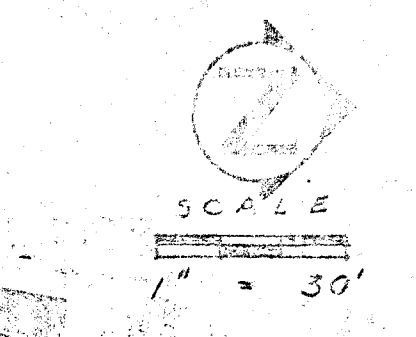


240
yds
3/4 x 1/4

18-75

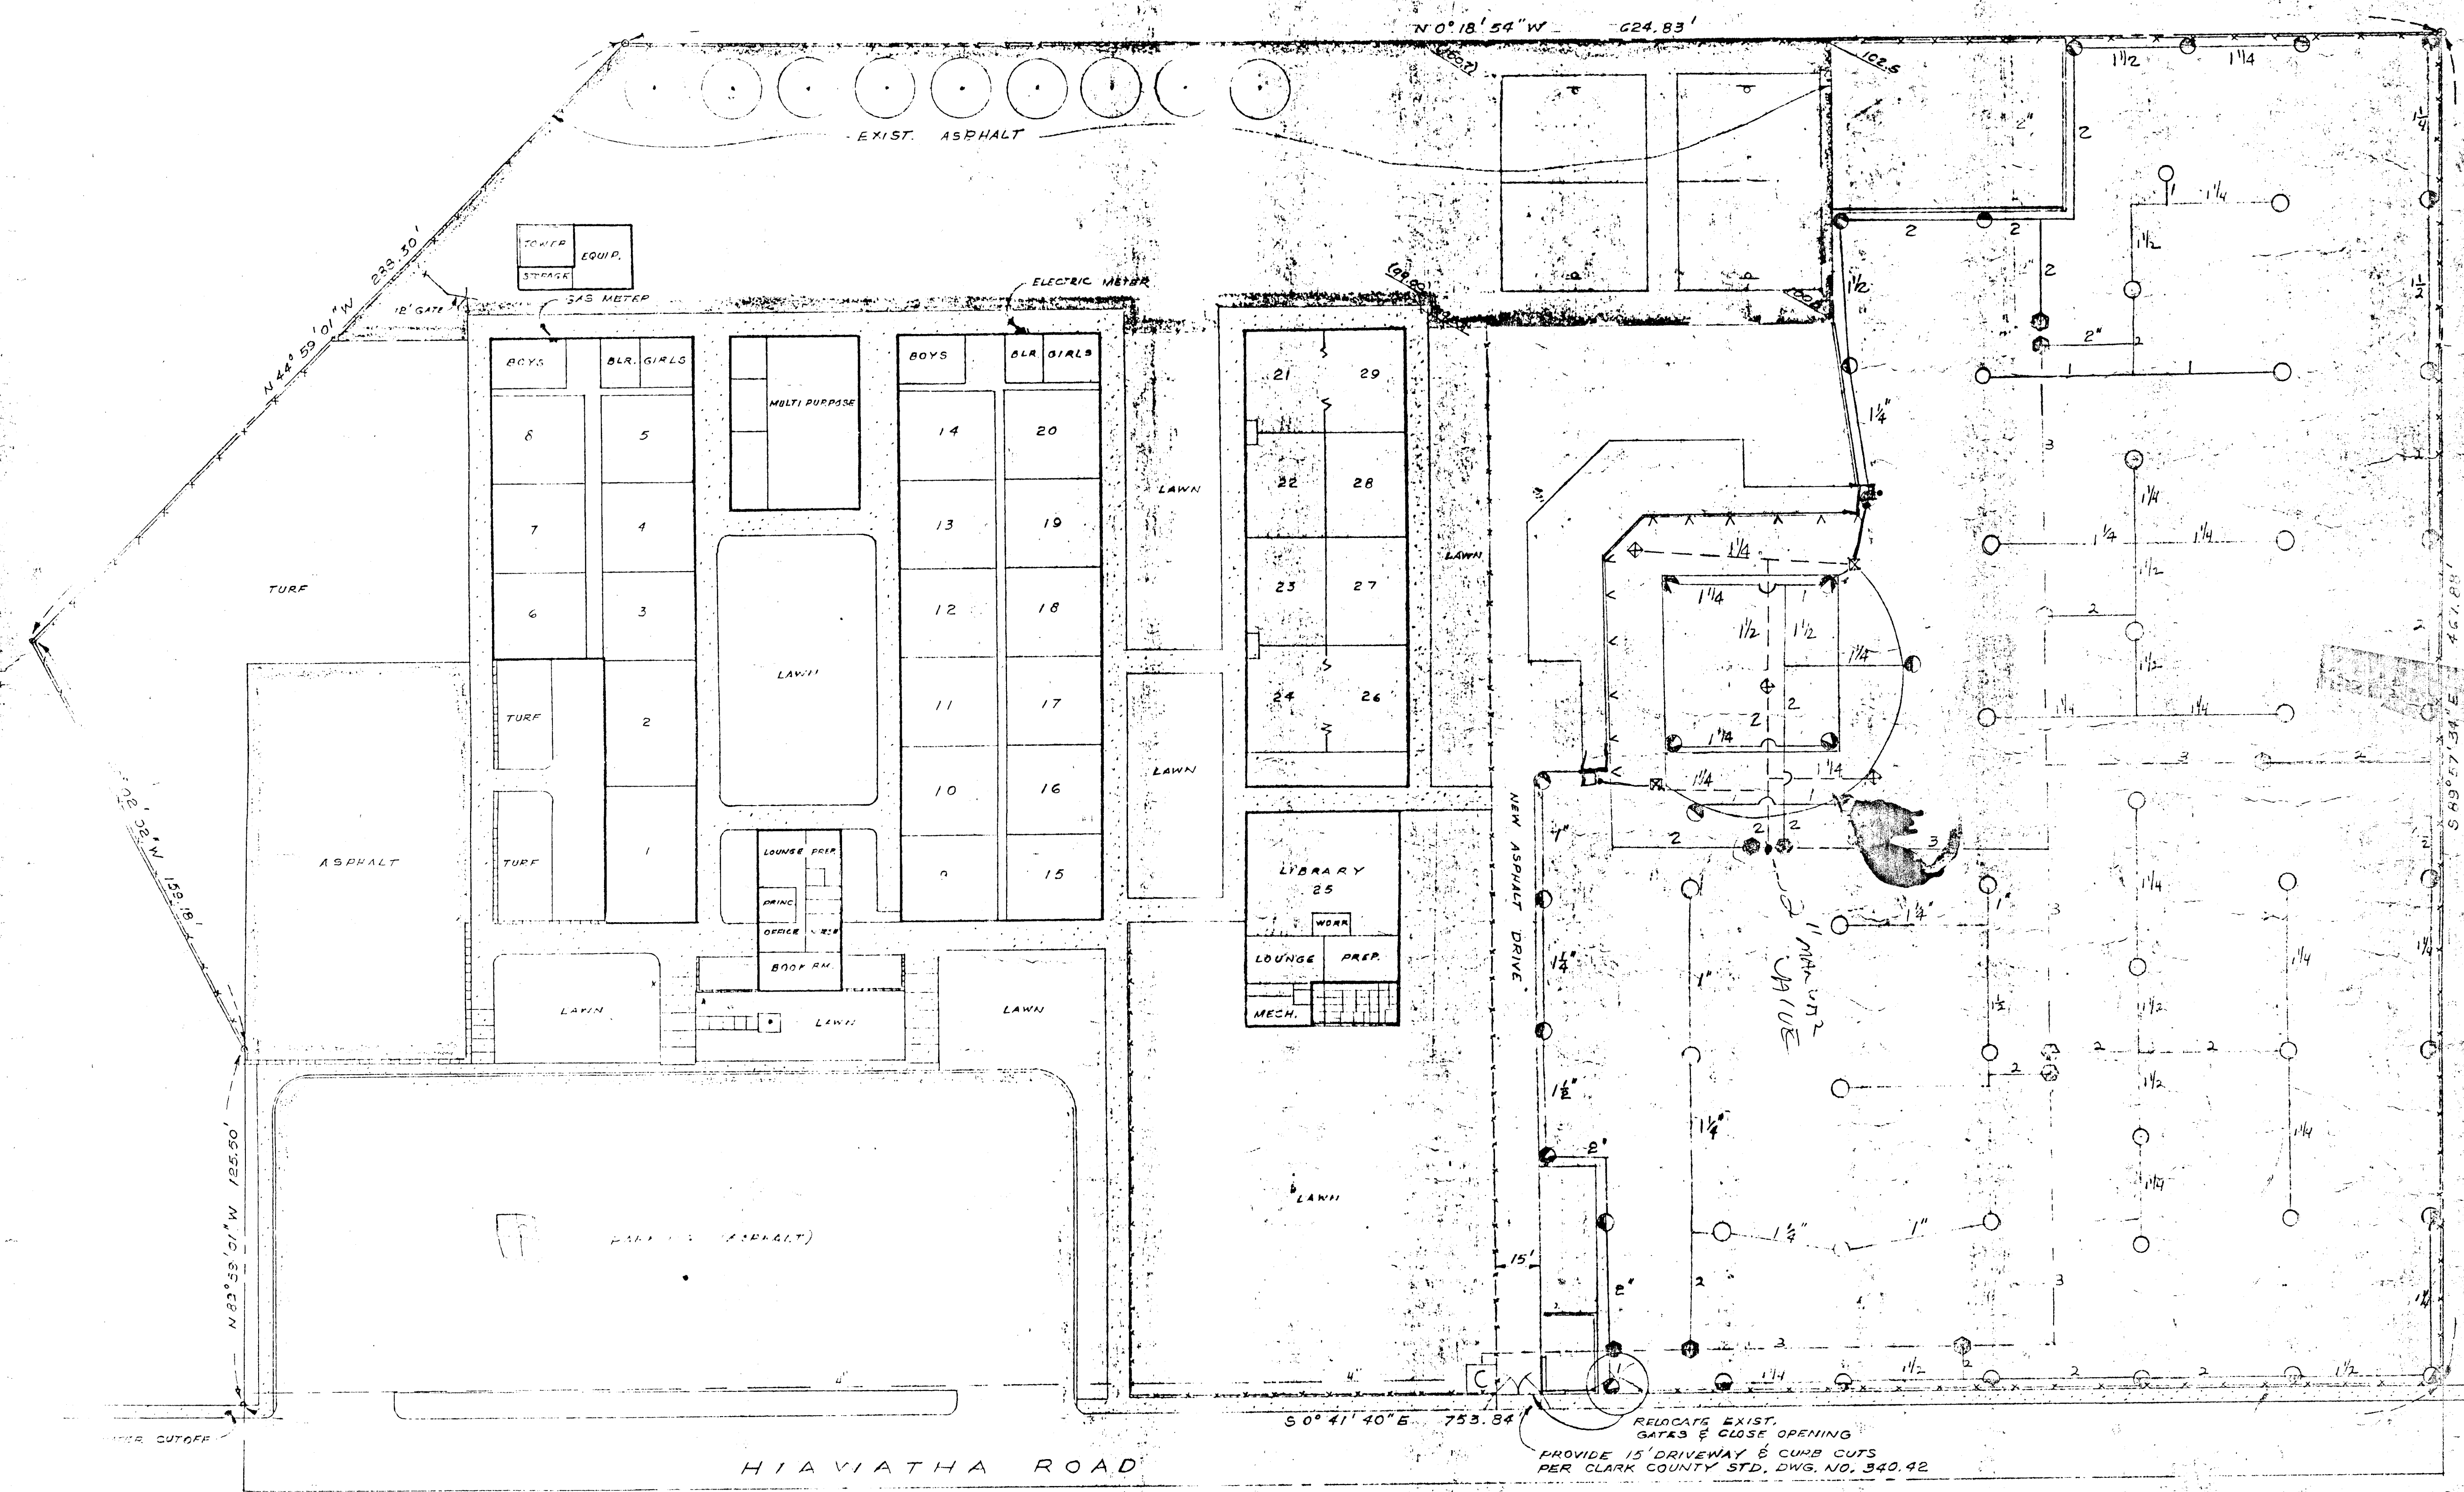

LEGEND
CONCRETE
7" CHAINLINK FENCE
EXISTING GRADES.
NEW GRADES.
1/2" NO. 13 - 15.4 1/2" NO. 14
45 LBS 7/32" NO. 14 1/2" NO. 15
NEED 70 LBS 11/2"

SITE PLAN
J. T. MCWILLIAMS

715-54 A

3647

J. T. MCWILLIAMS F.E.
SPRINKLER PLAN

school architect