CONSTRUCTION NOTES

1. CONSTRUCT 24" "L" TYPE CURB AND GUTTER PER STD DWG NO 216
2. CONSTRUCT "A" TYPE CURB PER STD DWG NO 219
3. CONSTRUCT SIDEWALK RAMP PER STD DWG NO 235 CASE 1 A = B = 8' TYPICAL UNLESS OTHERWISE NOTED
4. CONSTRUCT PUBLIC SIDEWALK PER STD DWG NO 234
5. CONSTRUCT ON-SITE SIDEWALK PER DETAIL 'T' SHEET 22 (C7.04)
6. CONSTRUCT TROPICAL PARKWAY AND BRADLEY ROAD PER DETAIL 'A' SHEET 5 (C3.02)
7. CONSTRUCT BULLRING AVENUE PER DETAIL 'B' SHEET 5 (C3.02)
8. CONSTRUCT ASPHALT CONCRETE PER DETAIL 'C' PARKING AND BUS AREA SHEET 5 (C3.02)
9. CONSTRUCT ASPHALT CONCRETE PER DETAIL 'D' PLAYGROUND AREA SHEET 5 (C3.02)
10. CONSTRUCT CONCRETE PAVING PER DETAIL 'E' SHEET 5 (C3.02)
11. CONSTRUCT 8' CROSS GUTTER PER STD DWG NO 228
12. CONSTRUCT 8' HALF STREET CROSS GUTTER PER STD DWG NO 229
13. CONSTRUCT COMMERCIAL DRIVEWAY (OPTION B) PER STD DWG NO 225 AND 222A
22. CONSTRUCT SIDEWALK DRAIN PER STD DWG NO 236
23. INSTALL CHAIN LINK FENCE PER DETAIL 'Q' SHEET 22 (C7.04)
24. INSTALL MAZE PER DETAIL 'R' SHEET 22 (C7.04)
25. CONSTRUCT WALL SEE DETAIL 118 SHEET S5.03
26. CONSTRUCT TRASH ENCLOSURE
27. CONSTRUCT 2' CURB OPENING SEE DETAIL 'V' SHEET 22 (C7.04)
28. INSTALL GATES
29. CONSTRUCT COMMERCIAL DRIVEWAY (OPTION A) PER STD DWG NO 224
30. CONSTRUCT BLOCK WALL OPENING PER DETAIL 'U' SHEET 22 (C7.04)
31. CONSTRUCT OUTLET PER DETAIL 'Y' SHEET 23 (C7.05)
32. CONSTRUCT CONCRETE STRIP PER DETAIL 'X' SHEET 23 (C7.05)
35. CONSTRUCT CONCRETE MOW STRIP PER DETAIL 'F' SHEET 20 (C7.02)
36. CONSTRUCT 2' RETAINING WALL PER DETAIL 'CC' SHEET 23 (C7.05)

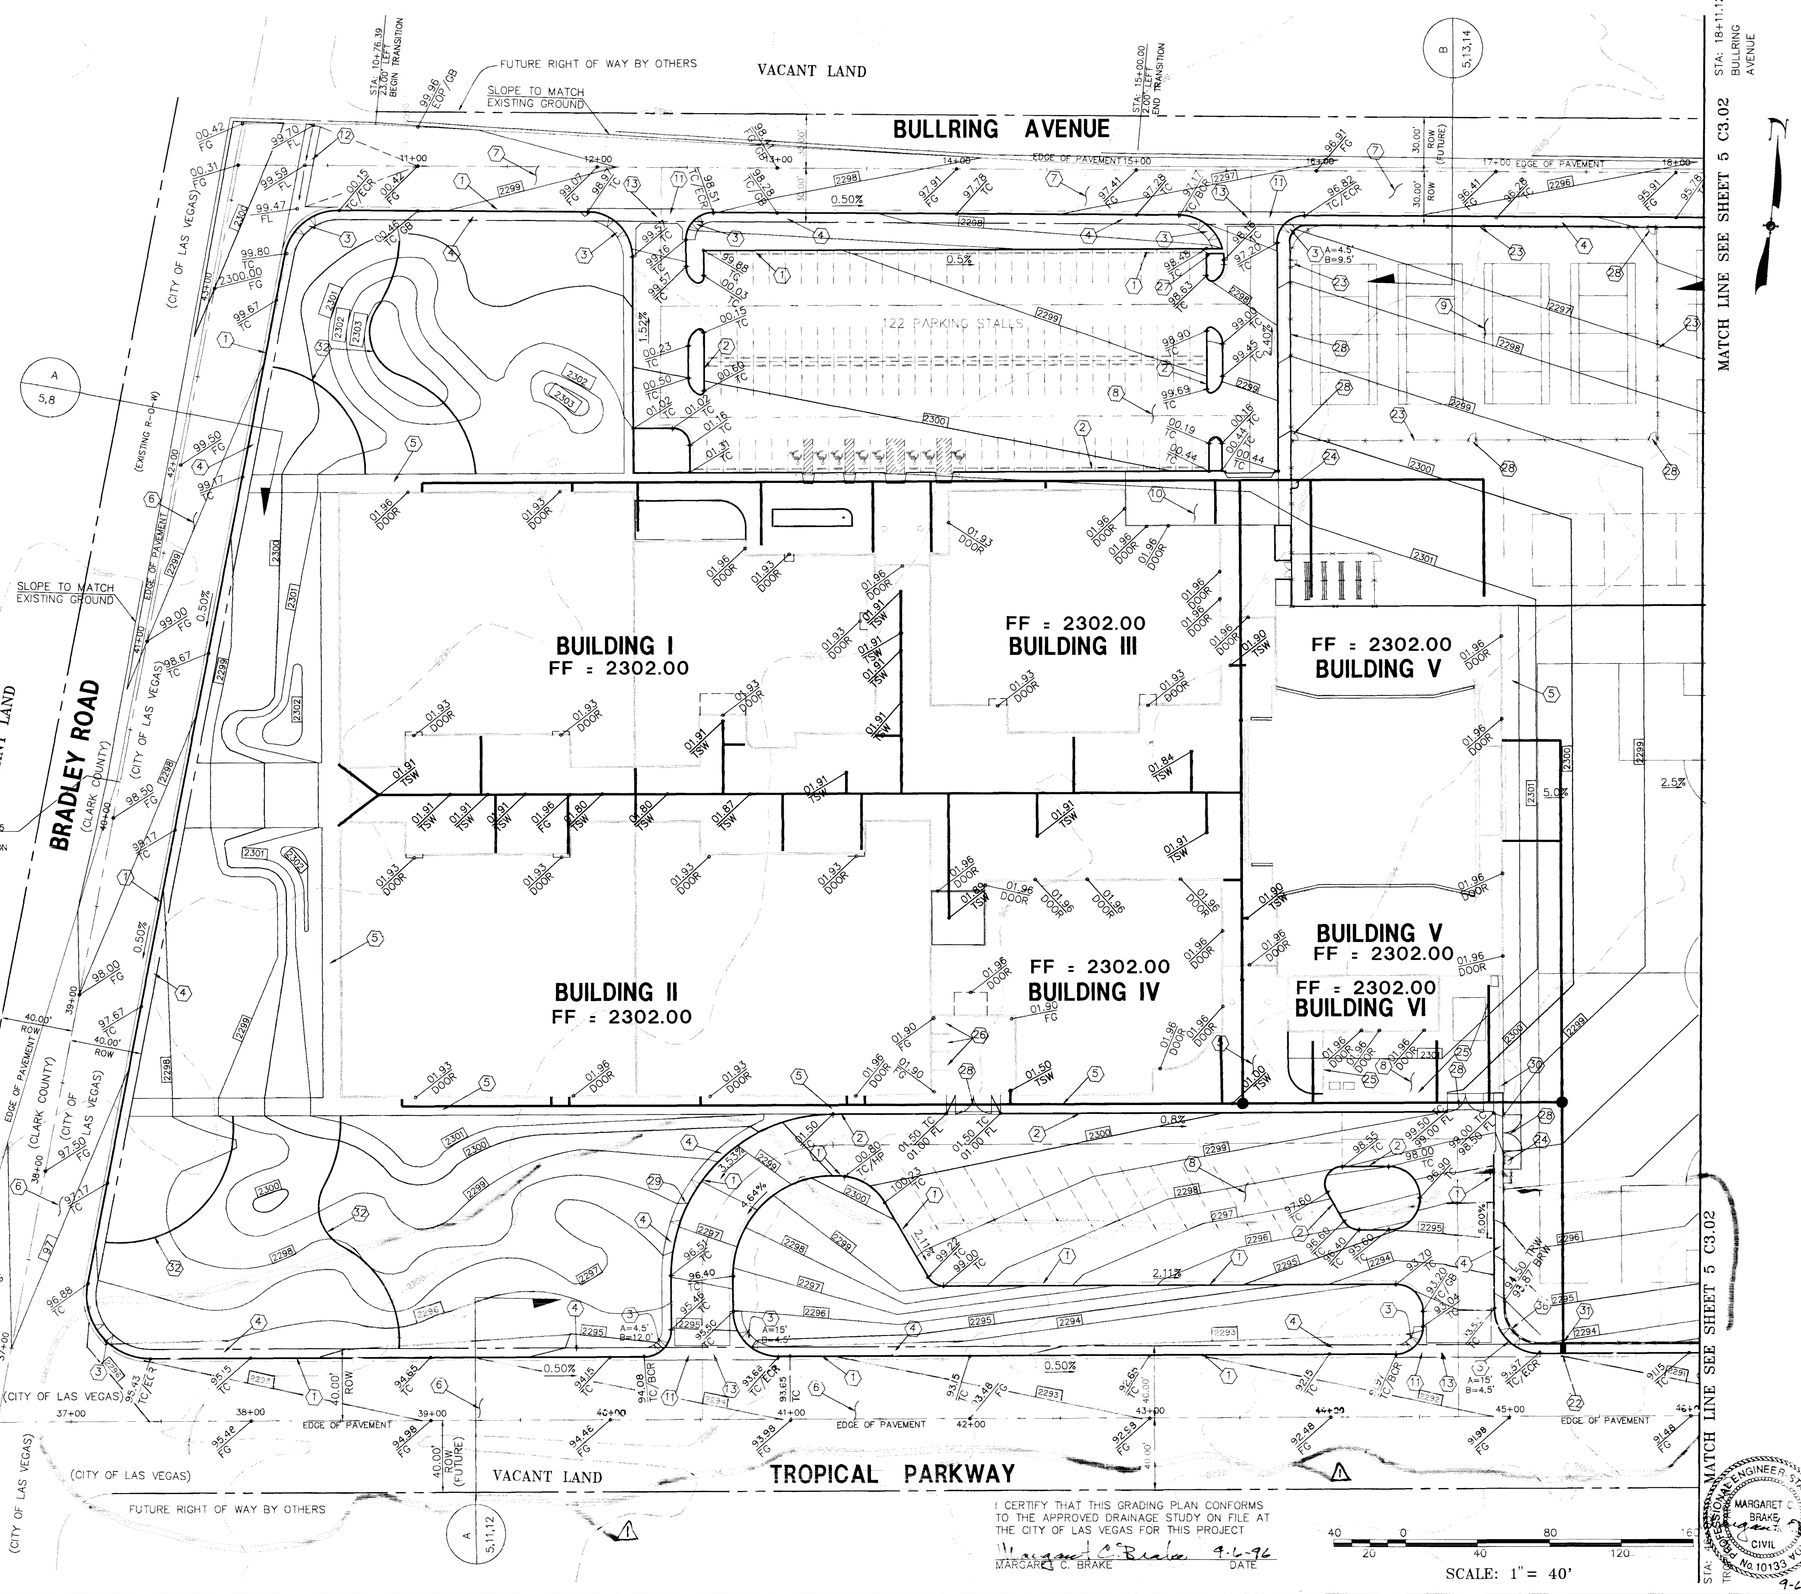

NOTE:

FINISHED FLOOR ELEVATION OF 2302.00 ON CIVIL DRAWINGS CORRESPONDS TO FINISHED FLOOR ELEVATION OF 100.00 ON BUILDING DRAWINGS.

UTILITY NOTE

UTILITY LOCATIONS SHOWN HEREON ARE APPROXIMATE ONLY. IT SHALL BE THE CONTRACTOR'S RESPONSIBILITY TO DETERMINE THE EXACT HORIZONTAL AND VERTICAL LOCATION OF ALL EXISTING UNDERGROUND UTILITIES PRIOR TO COMMENCING CONSTRUCTION. NO REPRESENTATION IS MADE THAT ALL EXISTING UTILITIES ARE SHOWN HEREON. THE ENGINEER ASSUMES NO RESPONSIBILITY FOR UTILITIES NOT SHOWN OR UTILITIES NOT SHOWN IN THEIR PROPER LOCATION.

Avoid cutting underground utility lines. It's costly. Call before you Dig 1-800-227-2600 UNDERGROUND SERVICE (USA)

I CERTIFY THAT THIS GRADING PLAN CONFORMS TO THE APPROVED DRAINAGE STUDY ON FILE AT THE CITY OF LAS VEGAS FOR THIS PROJECT

Margaret C. Brake 9-6-96
MARGARET C. BRAKE DATE

SCALE: 1" = 40'

MARGARET C. BRAKE — STATE OF NEVADA — PROFESSIONAL ENGINEER — CIVIL — No. 10133 — 9-6-96

SUMMIT™ ENGINEERING CORPORATION
CONSULTING ENGINEERS AND SURVEYORS
3684 SOUTH HIGHLAND, LAS VEGAS, NEVADA 89103
PHONE: (702) 252-5338 FAX: (702) 252-5247

DESIGNED BY: M.C.B.
DRAWN BY: E.W.A.
CHECKED BY: M.C.B.
APR. 15, 1996

LIED MIDDLE SCHOOL
CCSD #0844
GRADING PLAN - WEST HALF

REV.	DATE	DESCRIPTION	BY	APP'D
1	11-26-97	REV TC & FG ELEVS	M.C.B.	12/12/97

SCALE: HORIZ. 1" = 40' VERT. N/A
JOB NO. 710174
P:\ DWGS\710174\GRAD.dwg (VIEW: SHT-1)
LAS VEGAS NEVADA

SHEET 4 OF 23

3014

715-97

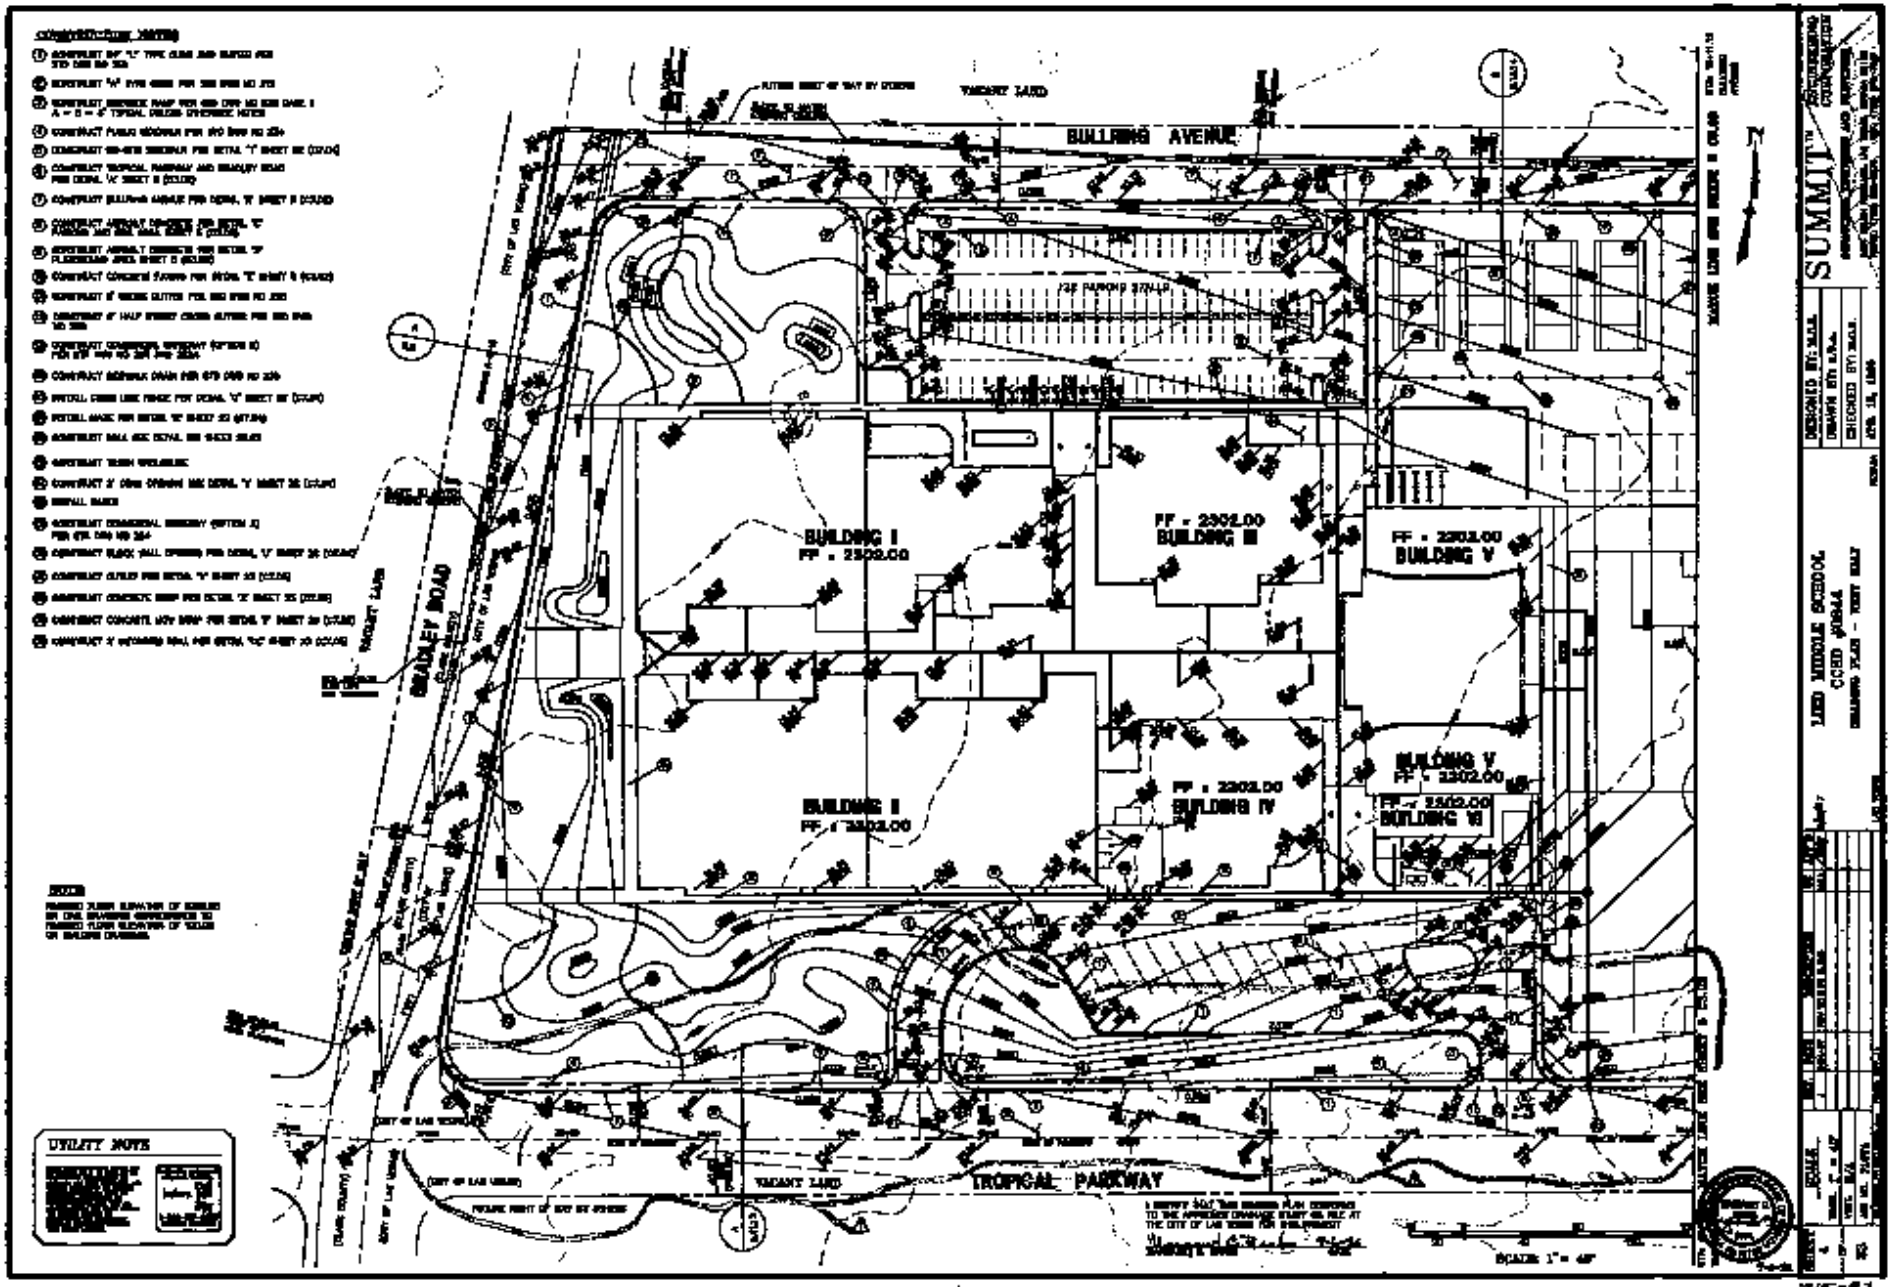
BUILDING I
FF = 2302.00
BUILDING II
FF = 2302.00
BUILDING III
FF = 2302.00
BUILDING IV
FF = 2302.00
BUILDING V
FF = 2302.00
BUILDING VI
FF = 2302.00
BRADLEY ROAD
TROPICAL PARKWAY
VACANT LAND
UTILITY NOTE
SUMMIT
CCED #0844
SCALE 1" = 40'