

PROJECT BENCHMARK

CITY OF LAS VEGAS BM#1LV90 36N4: A RIVET & PLATE IN TOP OF CURB ON SOUTH SIDE ANN ROAD AT ANGLE POINT IN CURB AT BRADLEY ROAD.
ELEVATION = 696.2262 METERS (NAVD 88) 2284.20 FEET


BASIS OF BEARINGS

NORTH 84°38'03" EAST, BEING THE SOUTH LINE OF THE NE1/4 OF SECTION 25, T19 S., R60 E., M.D.M., AS SHOWN IN FILE 52 OF SURVEYS, PAGE 70, CLARK COUNTY, NEVADA RECORDER'S CUMULATIVE MAP INDEX.

UTILITY NOTE


UTILITY LOCATIONS SHOWN HEREON ARE APPROXIMATE ONLY. IT SHALL BE THE CONTRACTOR'S RESPONSIBILITY TO DETERMINE THE EXACT HORIZONTAL AND VERTICAL LOCATION OF ALL EXISTING UNDERGROUND UTILITIES PRIOR TO COMMENCING CONSTRUCTION. NO REPRESENTATION IS MADE THAT ALL EXISTING UTILITIES ARE SHOWN HEREON. THE ENGINEER ASSUMES NO RESPONSIBILITY FOR UTILITIES NOT SHOWN OR UTILITIES NOT SHOWN IN THEIR PROPER LOCATION.

Avoid cutting underground utility lines. It's costly.
Call before you dig
1-800-227-2600
UNDERGROUND SERVICE (USA)

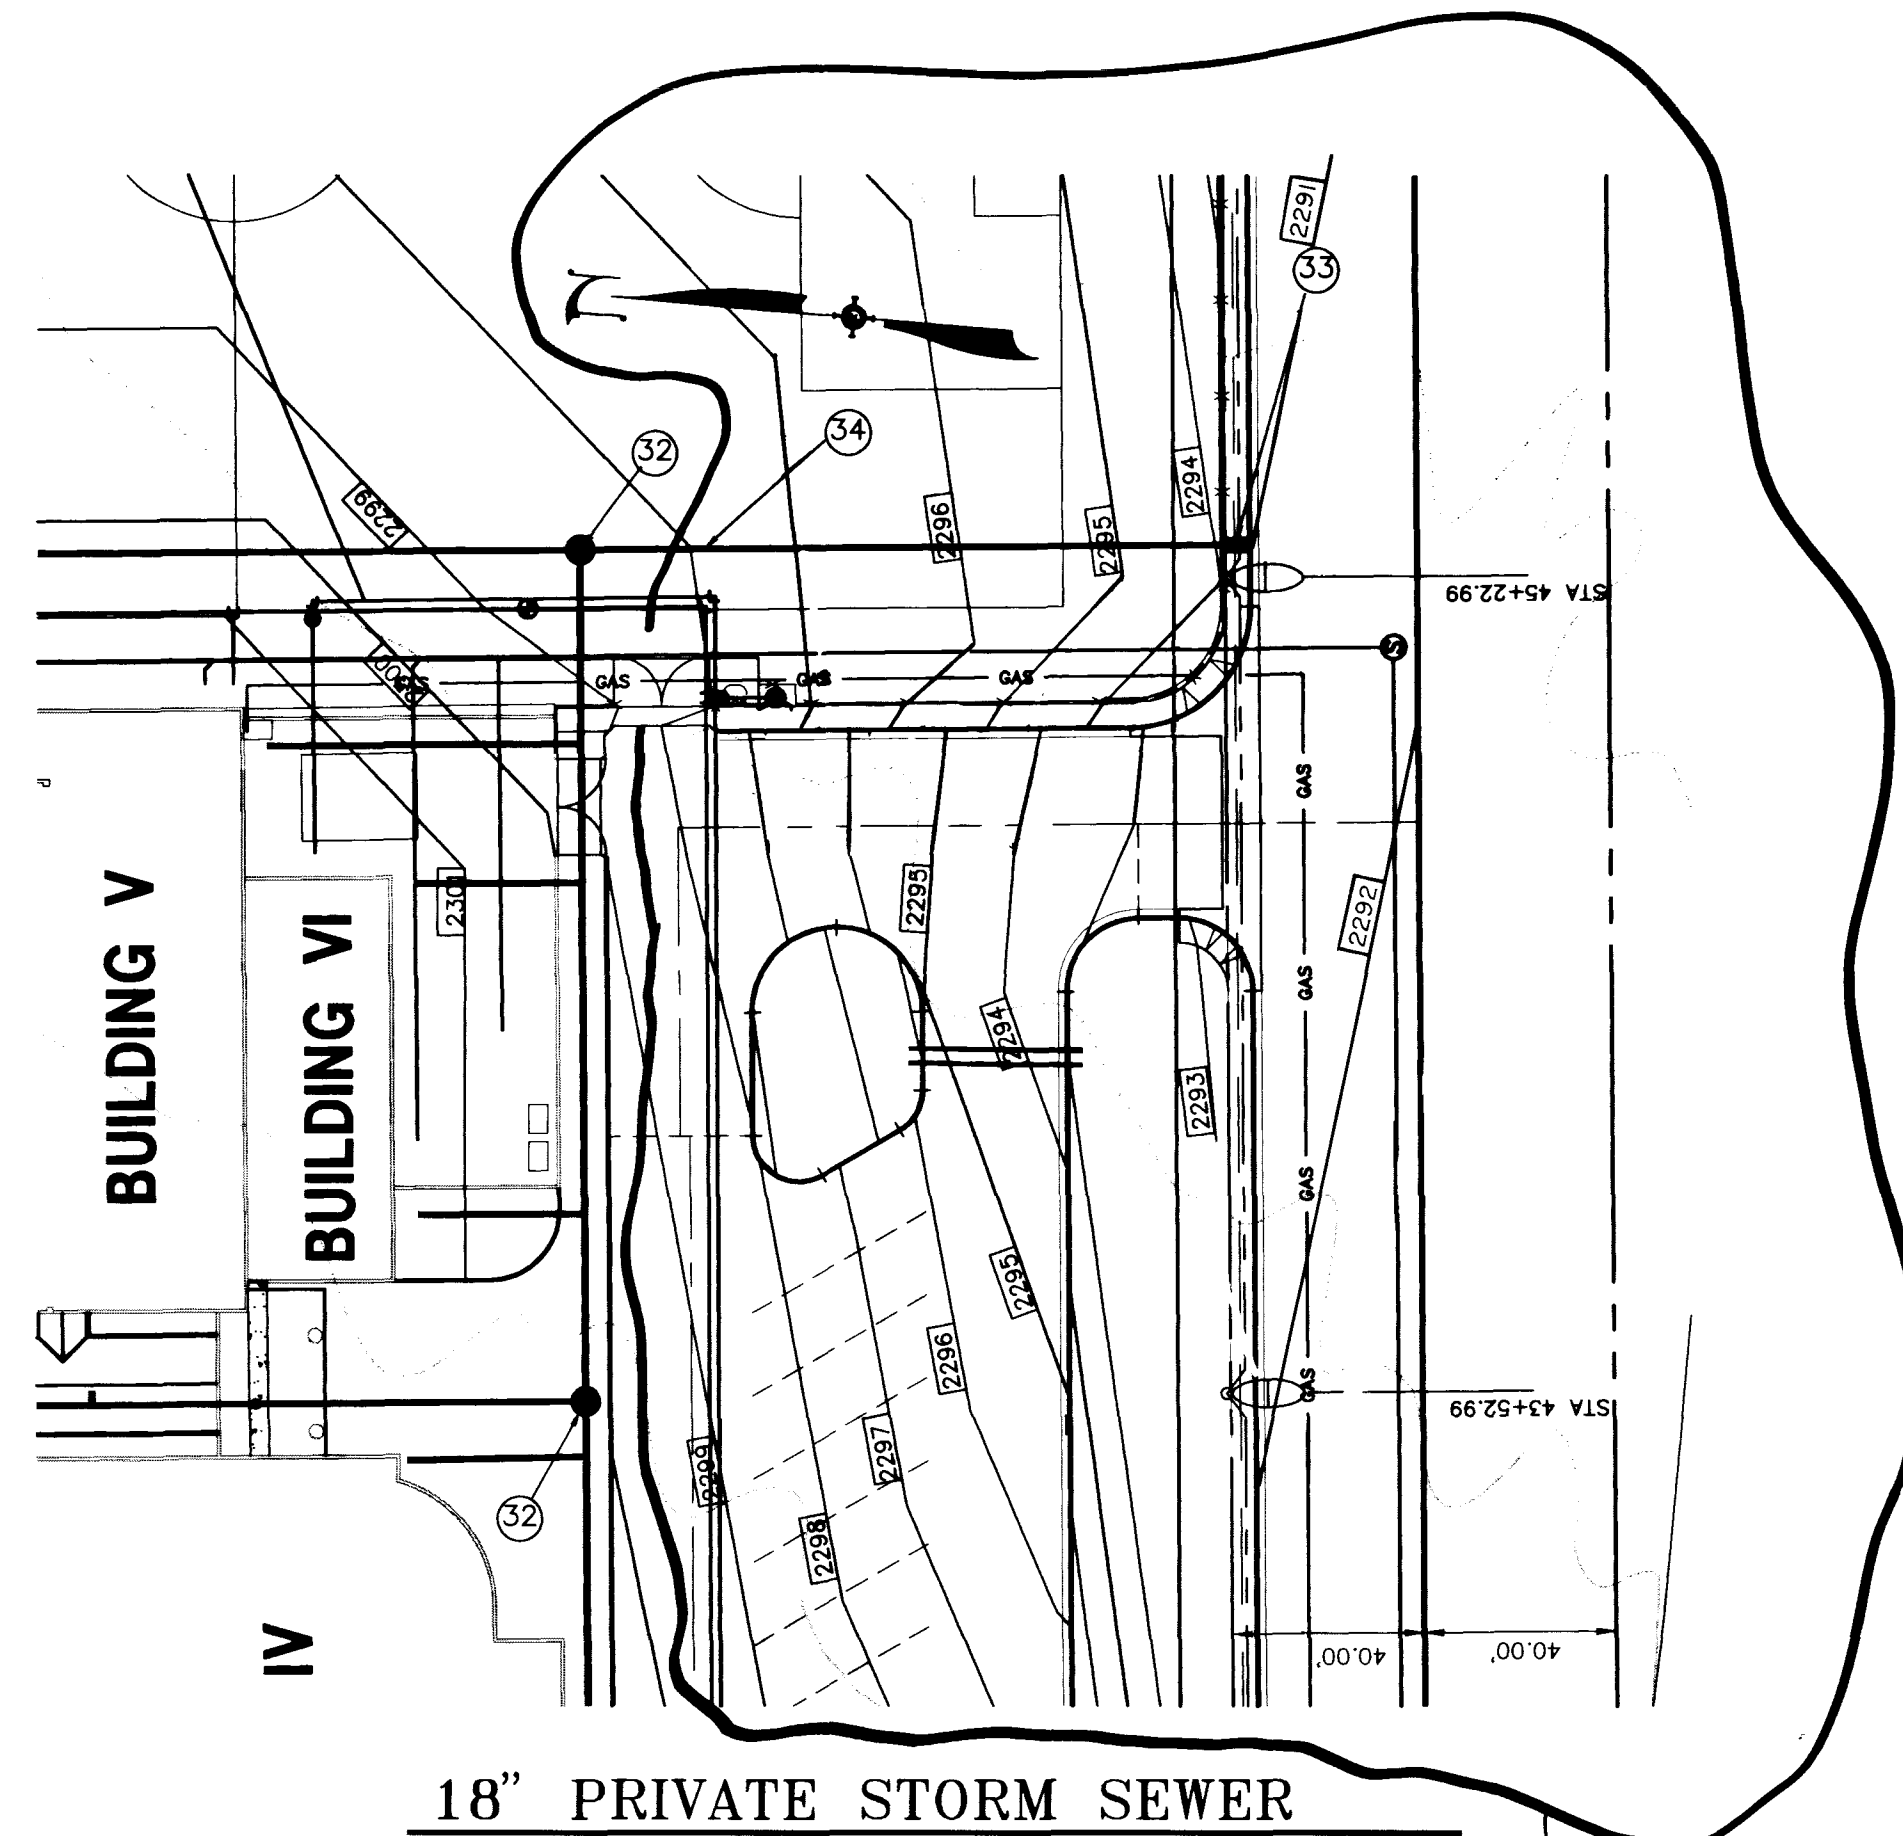

18" PRIVATE STORM SEWER

SCALE = 1" = 40' HORIZONTAL
SCALE = N/A VERTICAL

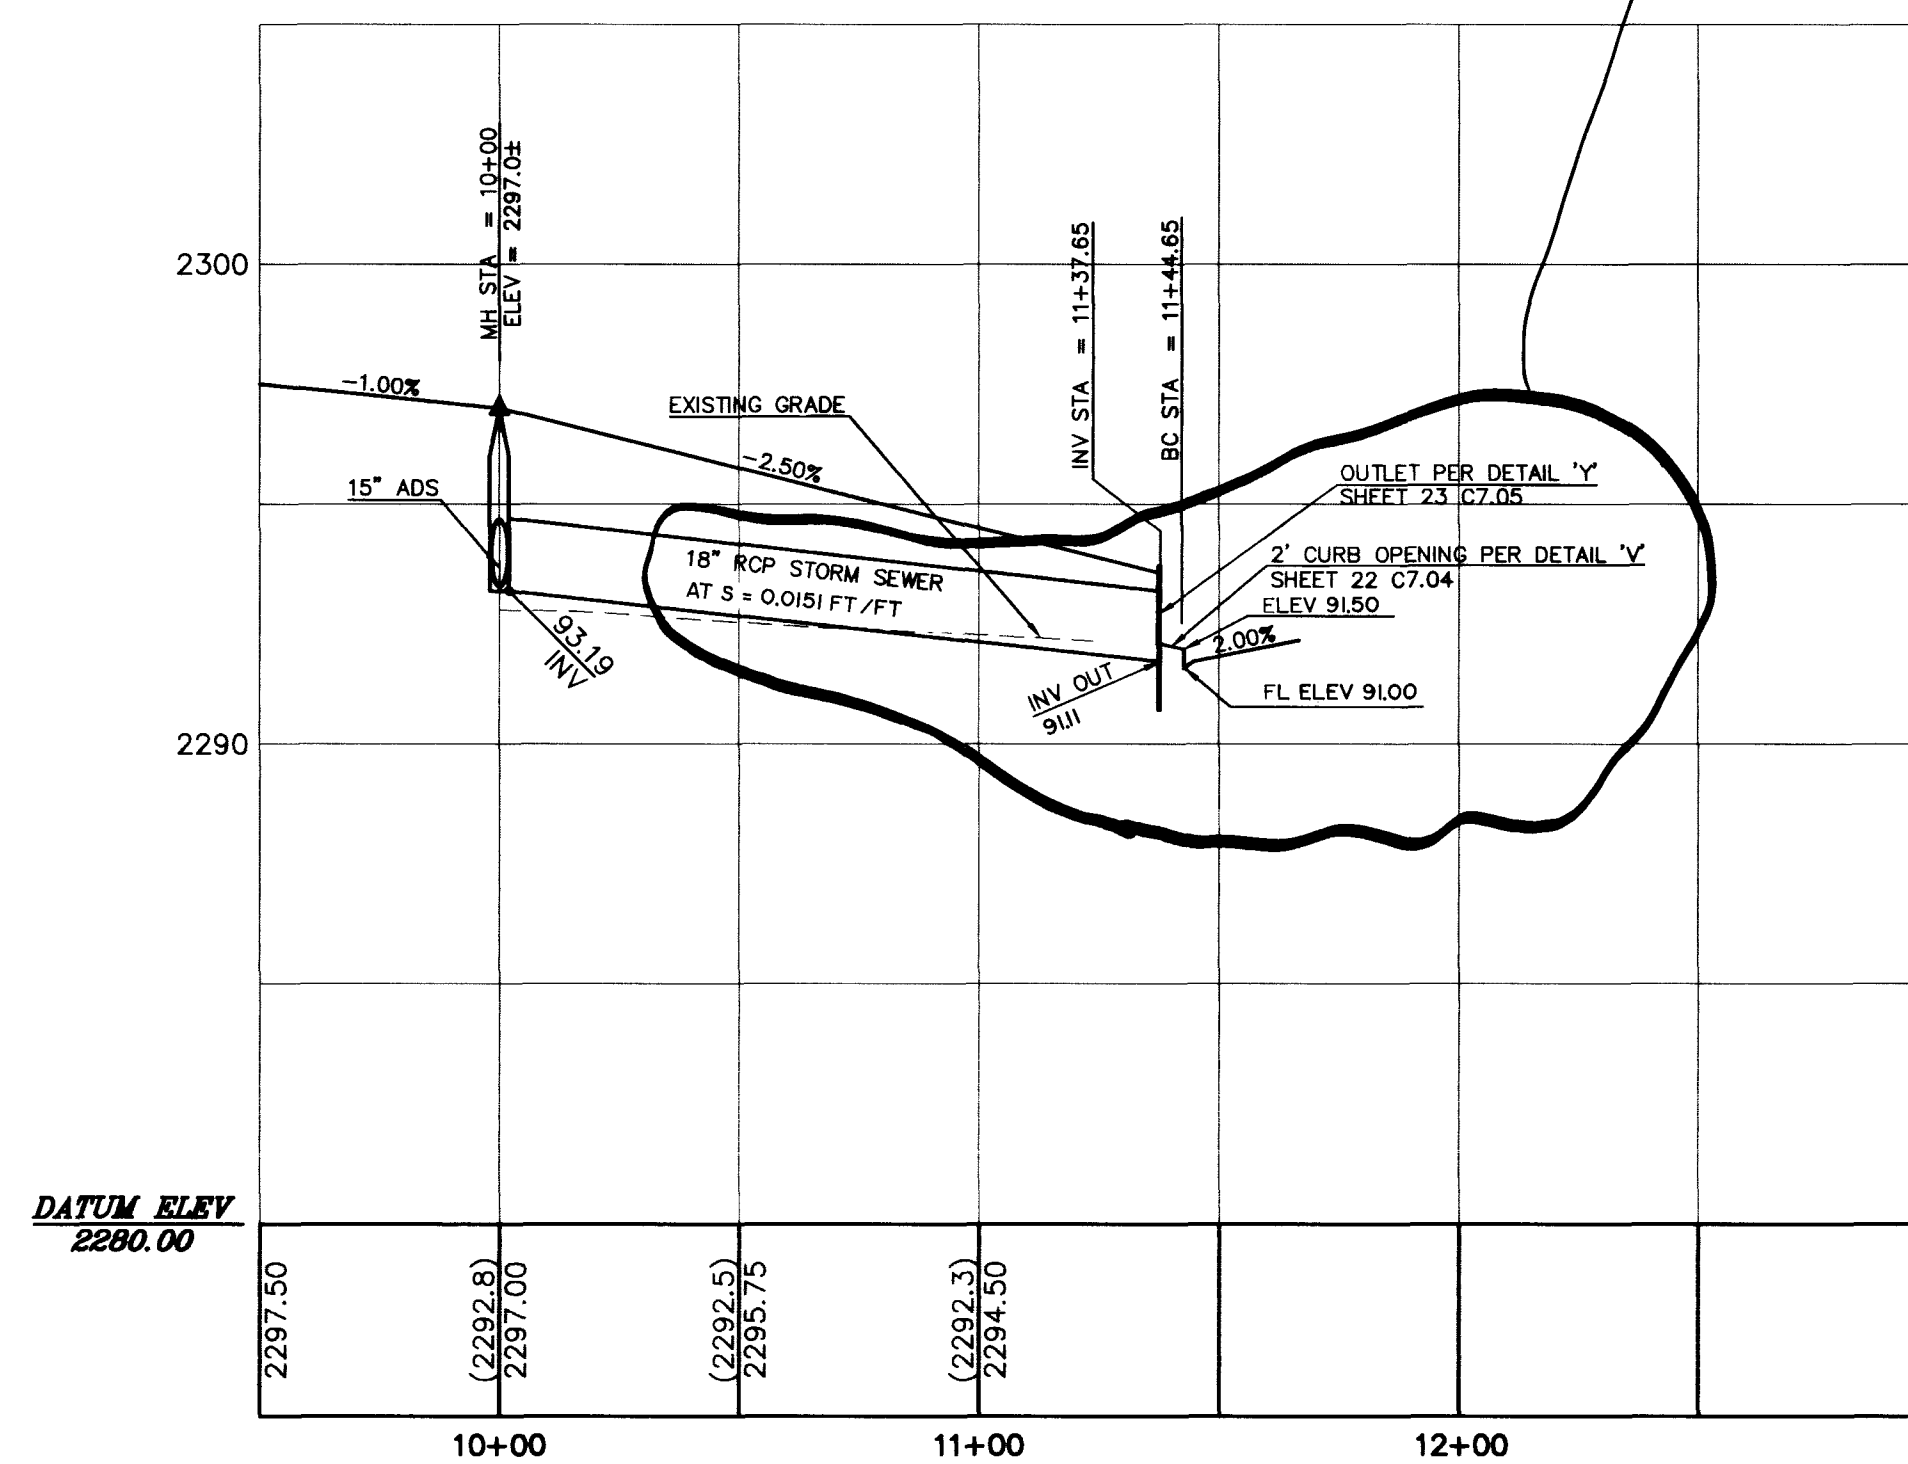


18" PRIVATE STORM SEWER

SCALE = 1" = 40' HORIZONTAL
SCALE = 1" = 4' VERTICAL

UTILITY NOTES:


- 32 - INSTALL 48" STORM DRAIN MANHOLE
- 33 - INSTALL OUTLET PER DETAIL "Y" SHEET 23 C7.05
- 34 - INSTALL 18" RCP

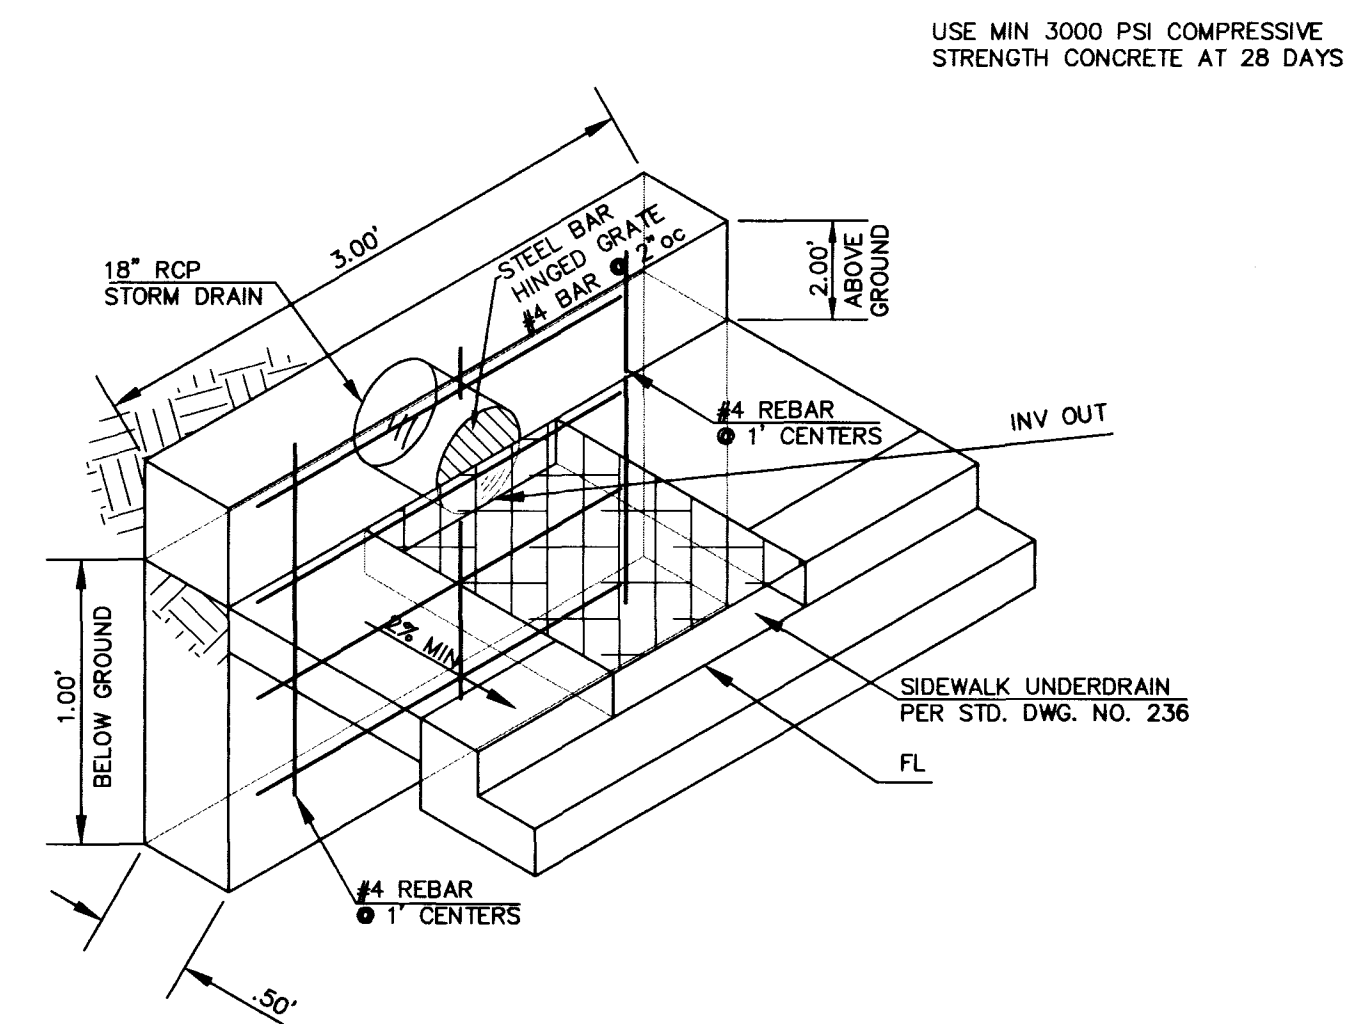

OUTLET DETAIL
N.T.S.



SCALE: 1" = 40'

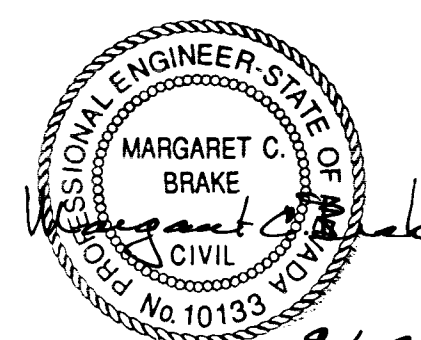

SHEET 15 OF 23	SCALE HORIZ. 1" = 40' VERT. 1" = 4'	REV.	DATE	DESCRIPTION	BY	APP'D	LIED MIDDLE SCHOOL CCSD #0844 PRIVATE STORM DRAIN	LAS VEGAS NEVADA	DESIGNED BY: C.S.S. DRAWN BY: C.S.S. CHECKED BY: M.C.B. APR. 15, 1996	SUMMIT™ ENGINEERING CORPORATION CONSULTING ENGINEERS AND SURVEYORS 3644 SOUTH HIGHLAND, LAS VEGAS, NEVADA 89103 PHONE: (702) 252-3238 FAX: (702) 252-3247
7/15/97										

