



CITY OF LAS VEGAS BM#1LV90 25N4
CAP ON REBAR, PLS 6201, CENTENNIAL PKWY. AND BRADLEY
ELEVATION = 701.8865 METERS (NAVD 88) 2302.772 FEET

NORTH 84°38'03" EAST, BEING THE SOUTH LINE OF THE NE1/4 OF SECTION 25,
T.19 S., R.60 E., M.D.M., AS SHOWN IN FILE 52 OF SURVEYS, PAGE 70, CLARK
COUNTY, NEVADA RECORDER'S CUMULATIVE MAP INDEX.

- ① CONSTRUCT 24" "L" TYPE CURB AND GUTTER PER STD DWG NO 216
- ② CONSTRUCT 5' SIDEWALK PER STD DWG NO 234
- ③ CONSTRUCT THOM BOULEVARD = 3" A.C. PAVING OVER 12" TYPE II BASE PER STD DWG 205

	EXISTING GRADE
	PROPOSED GRADE
	PROPOSED GRADE PER OTHER APPROVED PLANS
	PROPOSED ASPHALTIC CONCRETE
	EXISTING STREETLIGHT
	PROPOSED STREETLIGHT PER OTHER APPROVED PLANS
	EXISTING EDGE OF ASPHALT

1. SUMMIT ENGINEERING SHALL BE NOTIFIED IMMEDIATELY OF ANY DISCREPANCIES IN THE PLANS OR CONDITIONS IN THE FIELD
2. PRIOR TO CONSTRUCTION THE CONTRACTOR SHALL BE RESPONSIBLE FOR VERIFYING ALL EXISTING IMPROVEMENT LOCATIONS AND ELEVATIONS AND SHALL CONTACT THE ENGINEER IF ANY DISCREPANCIES ARE FOUND.

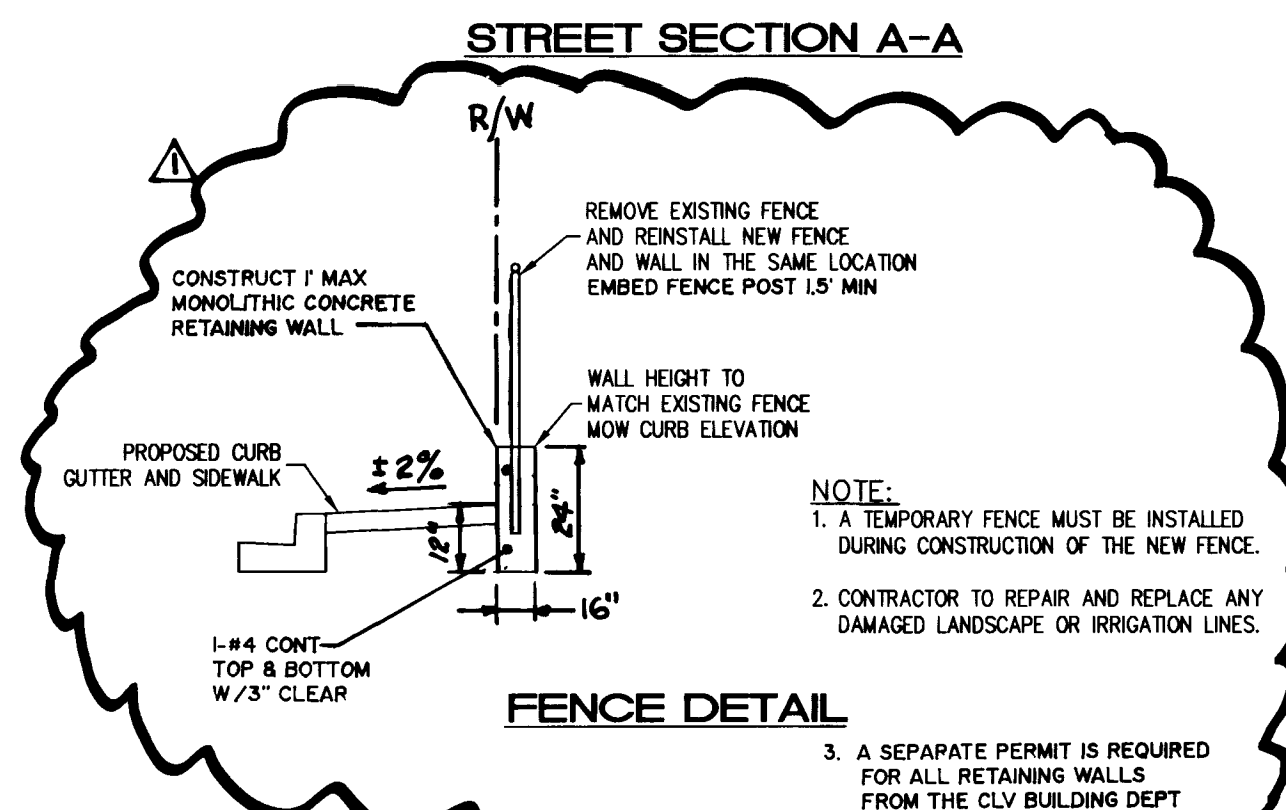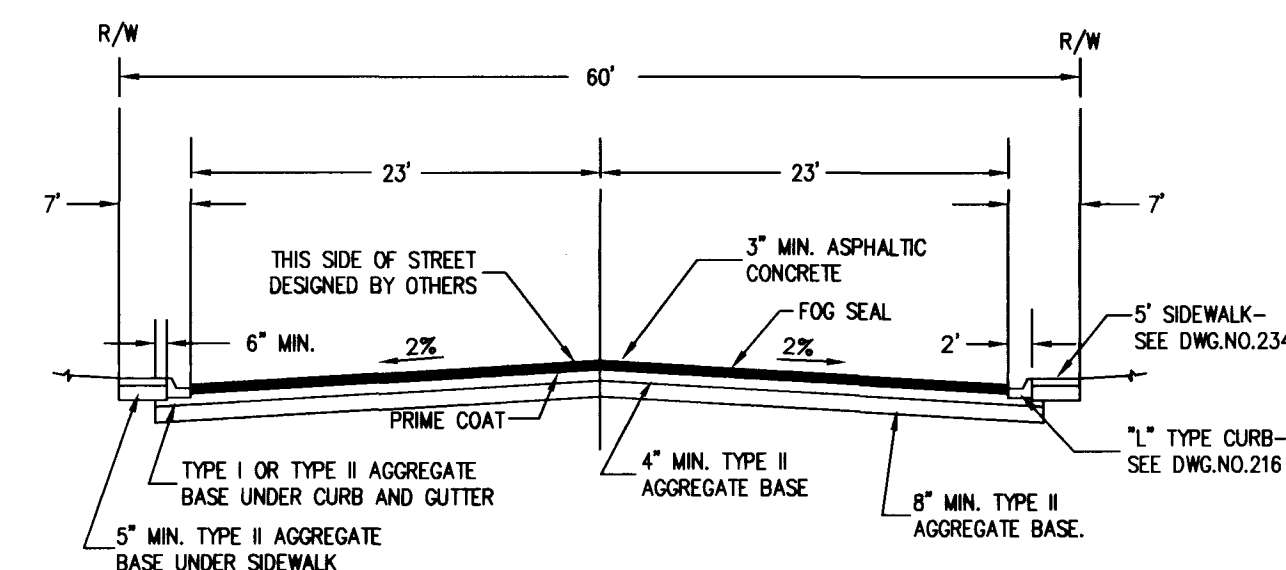

UTILITY LOCATIONS SHOWN HEREON ARE APPROXIMATE ONLY. IT SHALL BE THE CONTRACTOR'S RESPONSIBILITY TO DETERMINE THE EXACT HORIZONTAL AND VERTICAL LOCATION OF ALL EXISTING UNDERGROUND UTILITIES PRIOR TO COMMENCING CONSTRUCTION. NO REPRESENTATION IS MADE THAT ALL EXISTING UTILITIES ARE SHOWN HEREON. THE ENGINEER ASSUMES NO RESPONSIBILITY FOR UTILITIES NOT SHOWN OR UTILITIES NOT SHOWN IN THEIR PROPER LOCATION.	Avoid cutting underground utility lines. It's costly. Call before you Dig 1-800-227-2600 UNDERGROUND SERVICE (USA)	AVOID HITTING OVERHEAD POWER LINES. IT'S COSTLY. CALL BEFORE YOU OVERHEAD  CALL 1-702-593-6111
---	--	---

CONSULTING ENGINEERS AND SURVEYORS
368 S. SOUTH HIGHLAND, LAS VEGAS, NEVADA 89103
PHONE: (702) 252-3236 FAX: (702) 252-3247

SCALE	HOR.	1"=40'
	VER.	1"=4'
SCALE No.		

LIED MIDDLE SCHOOL, CCSD #0844
PLAN + PROFILE THOM BOULEVARD


DESCRIPTION	BY	APP'D
FINANCE DETAIL	EWA	mg 4/15/12

REV.	DATE	REV.
1	4/13/99	REV.

15A OF 23

7

715-95

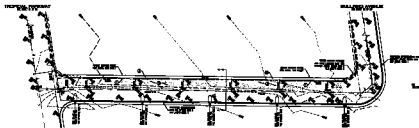

THOM BOULEVARD








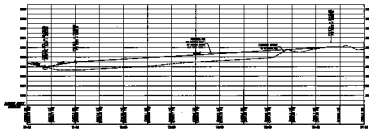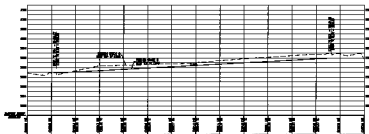




