


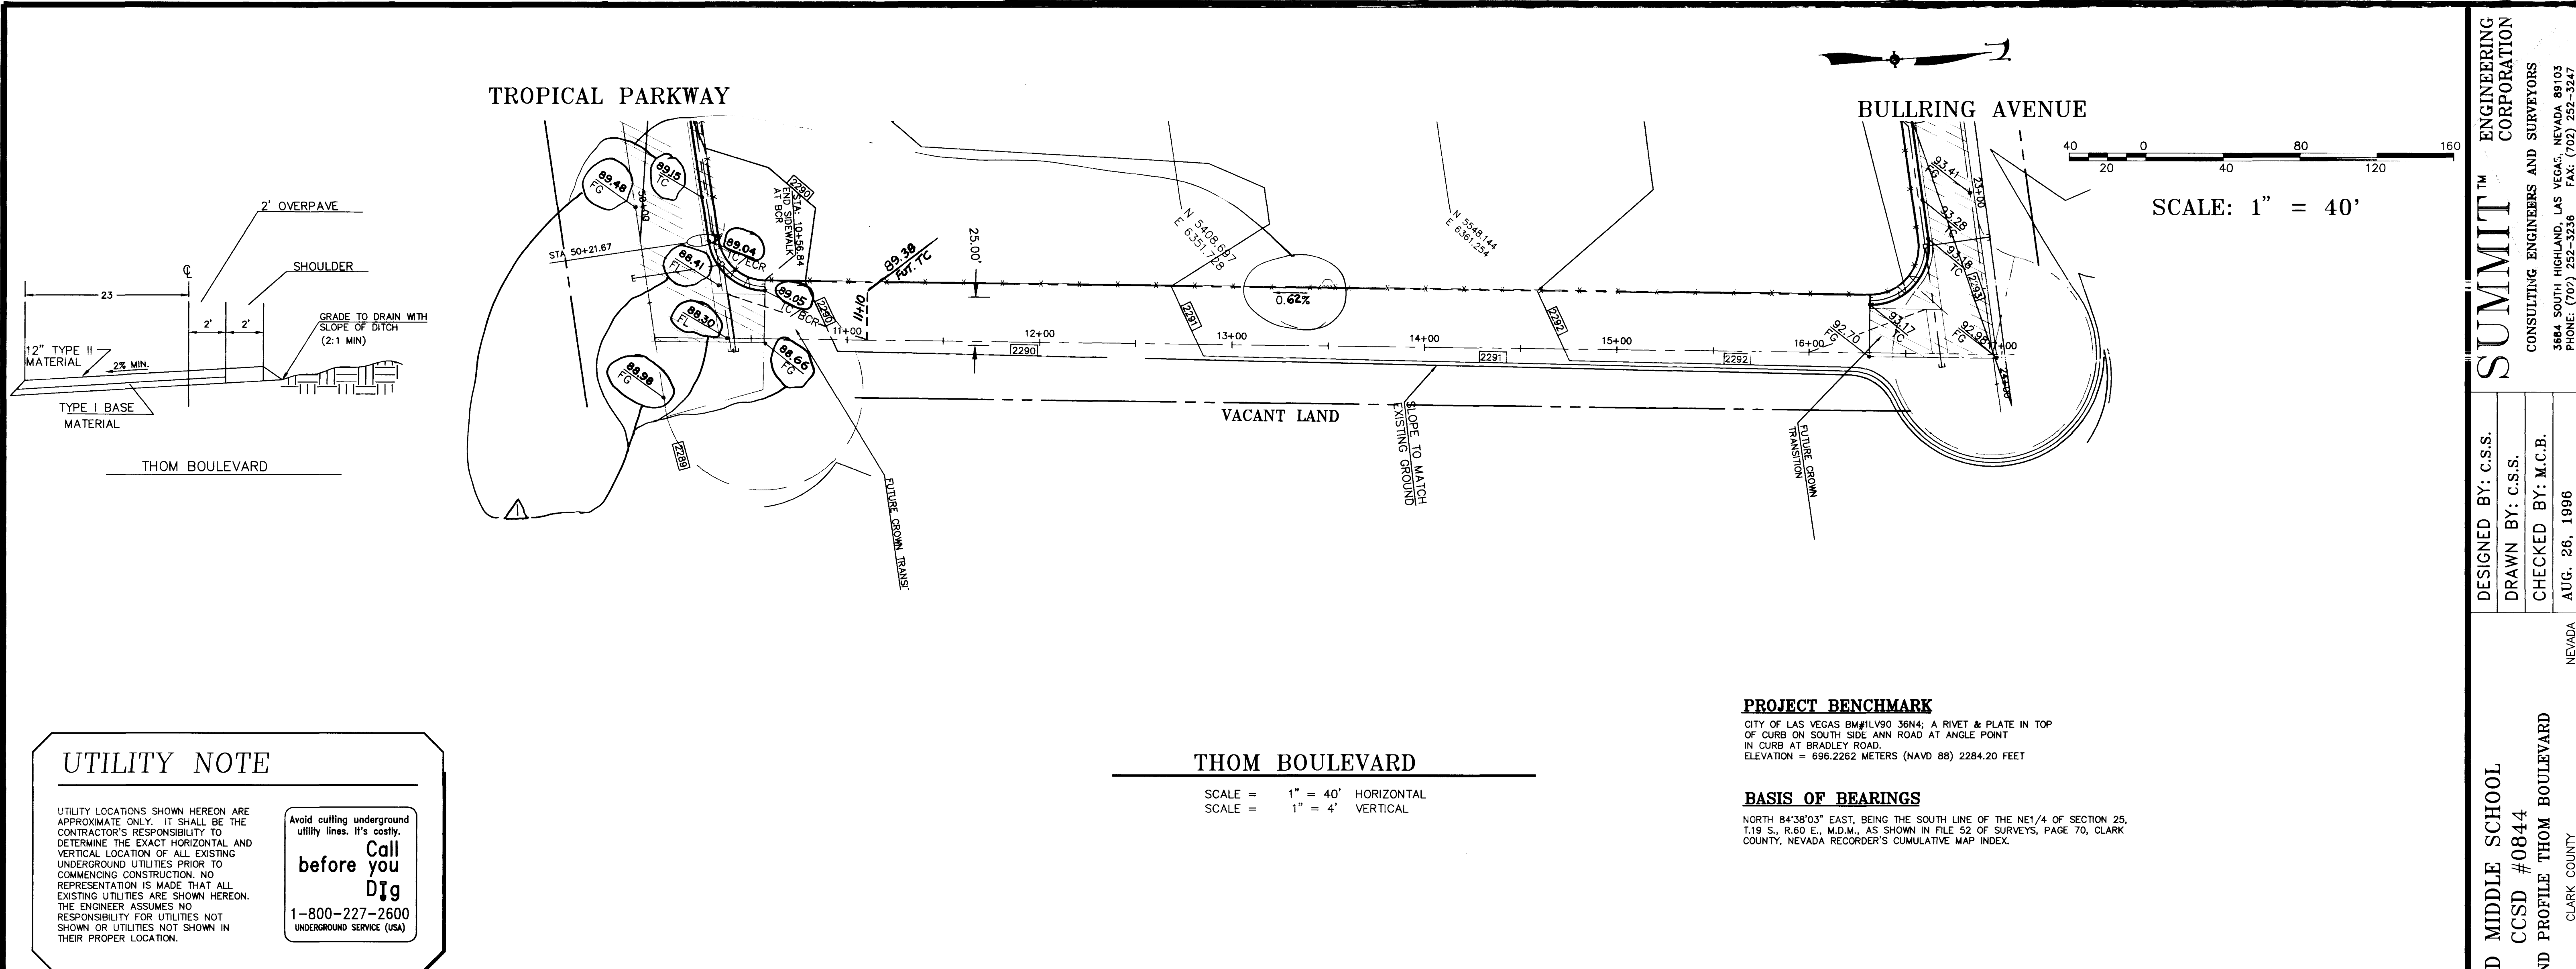


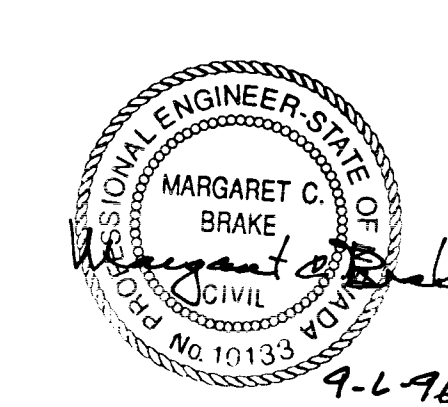

PLAN AND PROFILE SHOWN FOR CLARITY ONLY NOT TO BE BUILD WITH THIS CONTRACT

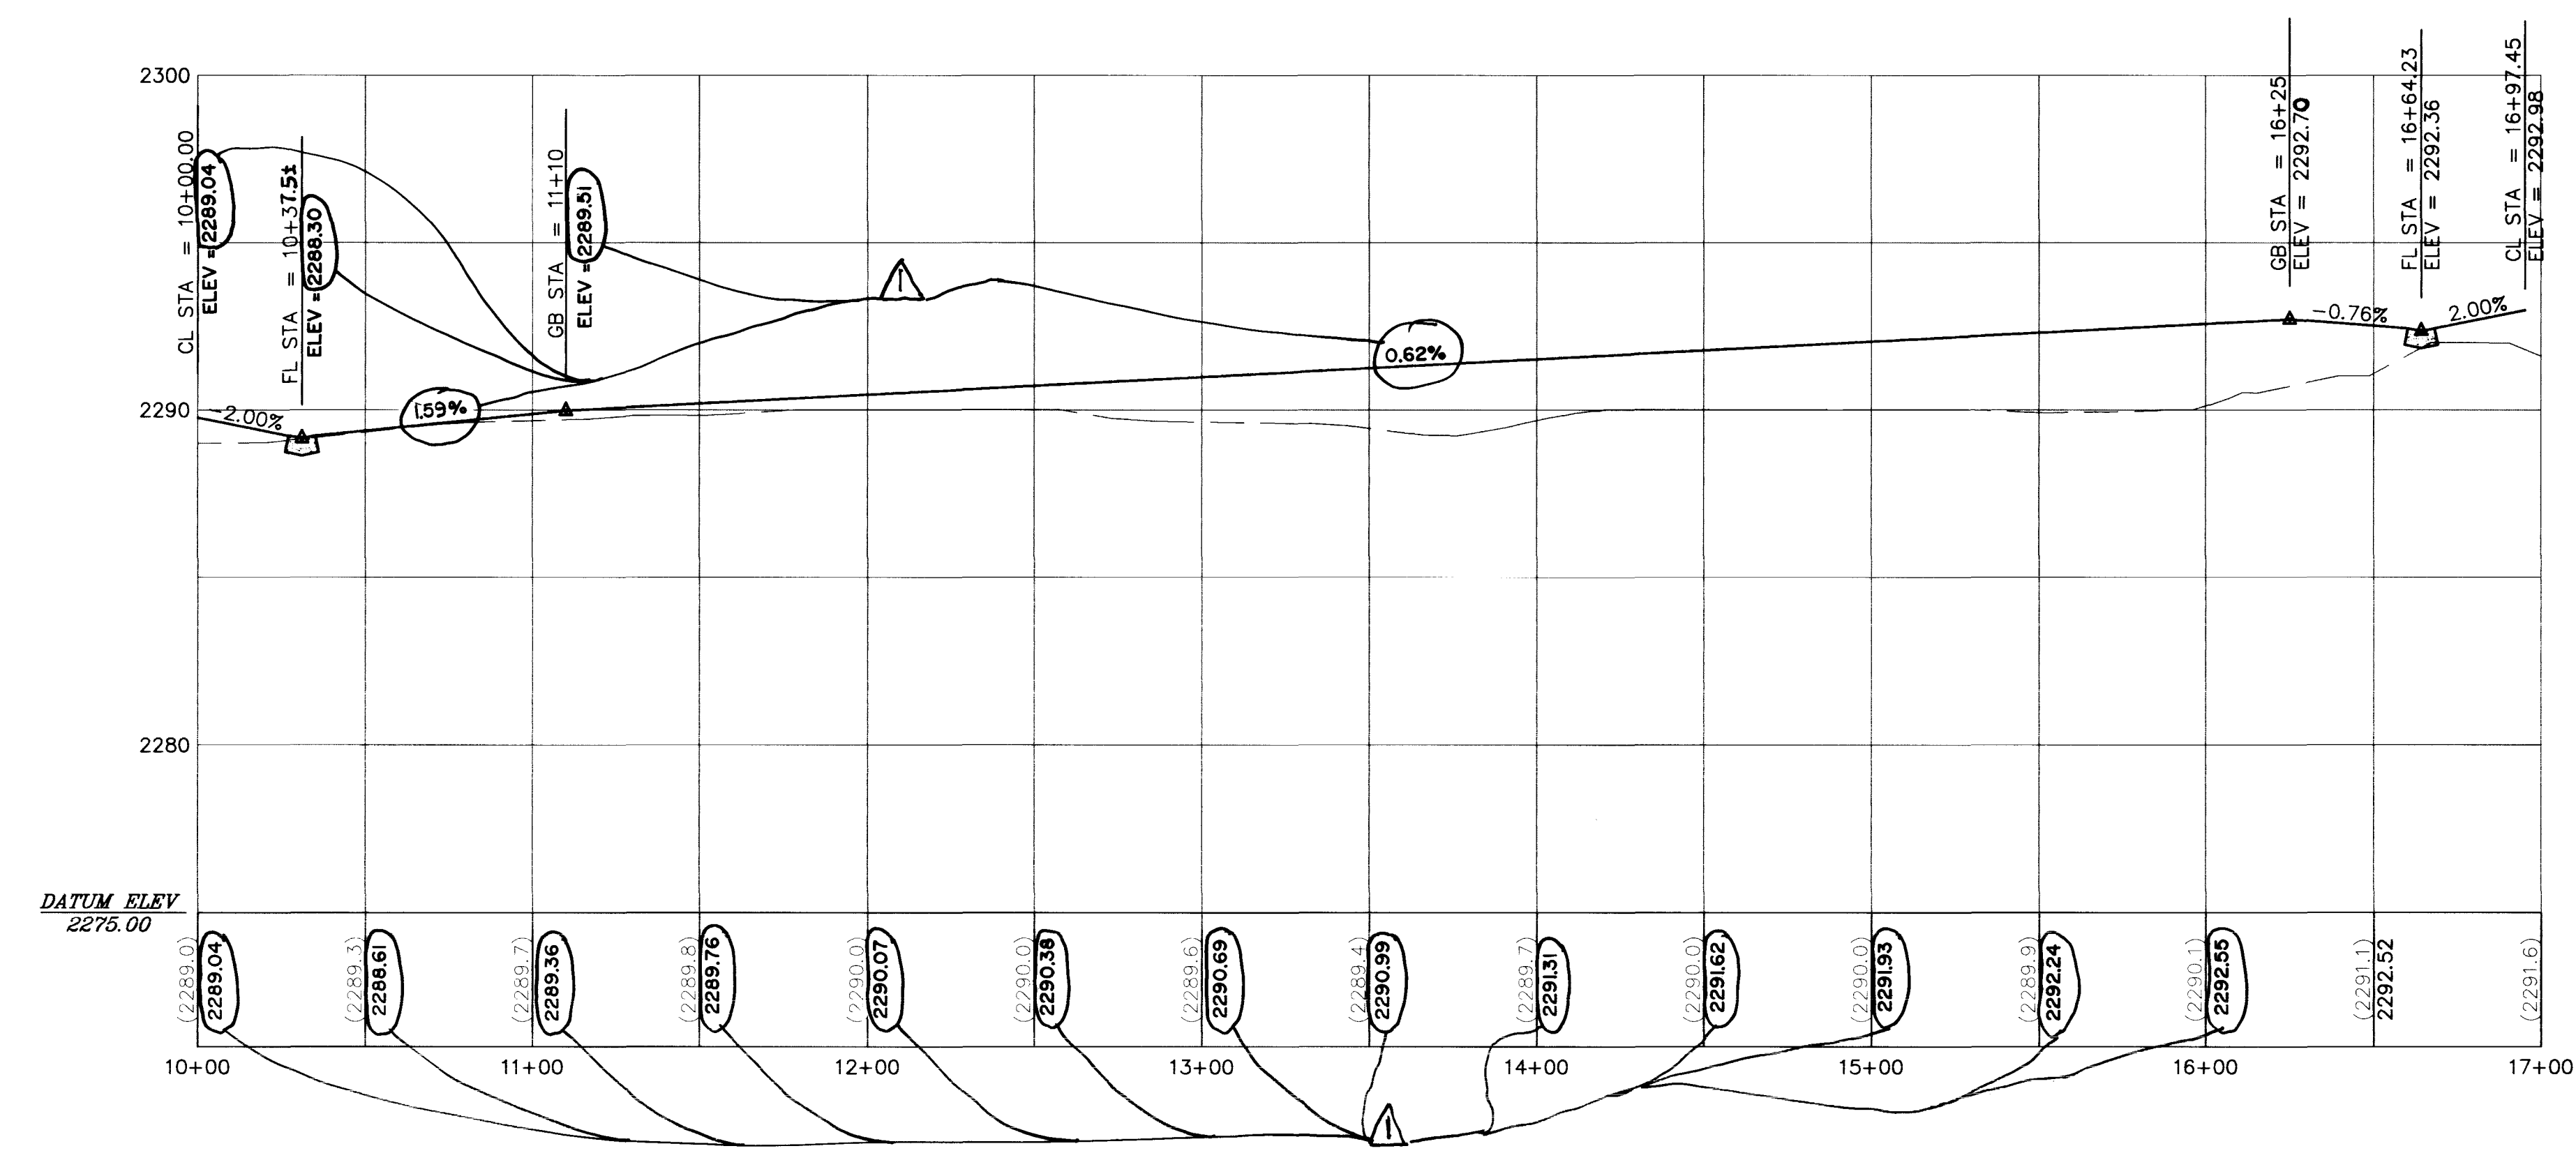

SHEET 15A	SCALE HORIZ. 1"=40' VERT. 1"=4'	REV.	DATE	DESCRIPTION	BY	APP'D	2/12/97	LIED MIDDLE SCHOOL CCSD #0844 PLAN AND PROFILE THOM BOULEVARD	CLARK COUNTY	LAS VEGAS	NEVADA	AUG. 26, 1996	CHECKED BY: M.C.B.	DRAWN BY: C.S.S.	DESIGNED BY: C.S.S.	SUMMIT ENGINEERING CORPORATION CONSULTING ENGINEERS AND SURVEYORS 3684 SOUTH HIGHLAND, LAS VEGAS, NEVADA 89103 PHONE: (702) 252-3236 FAX: (702) 252-3247

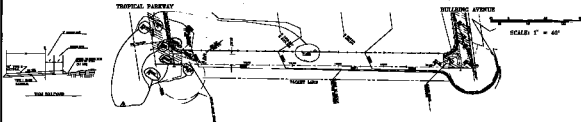

UTILITY NOTE




THOM BOULEVARD








PLAN AND PROFILE SHOWN FOR CLARITY ONLY NOT TO BE BUILT WITH THIS CONTRACT

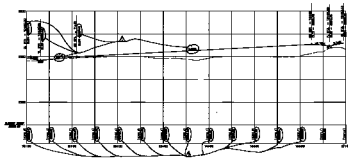

