



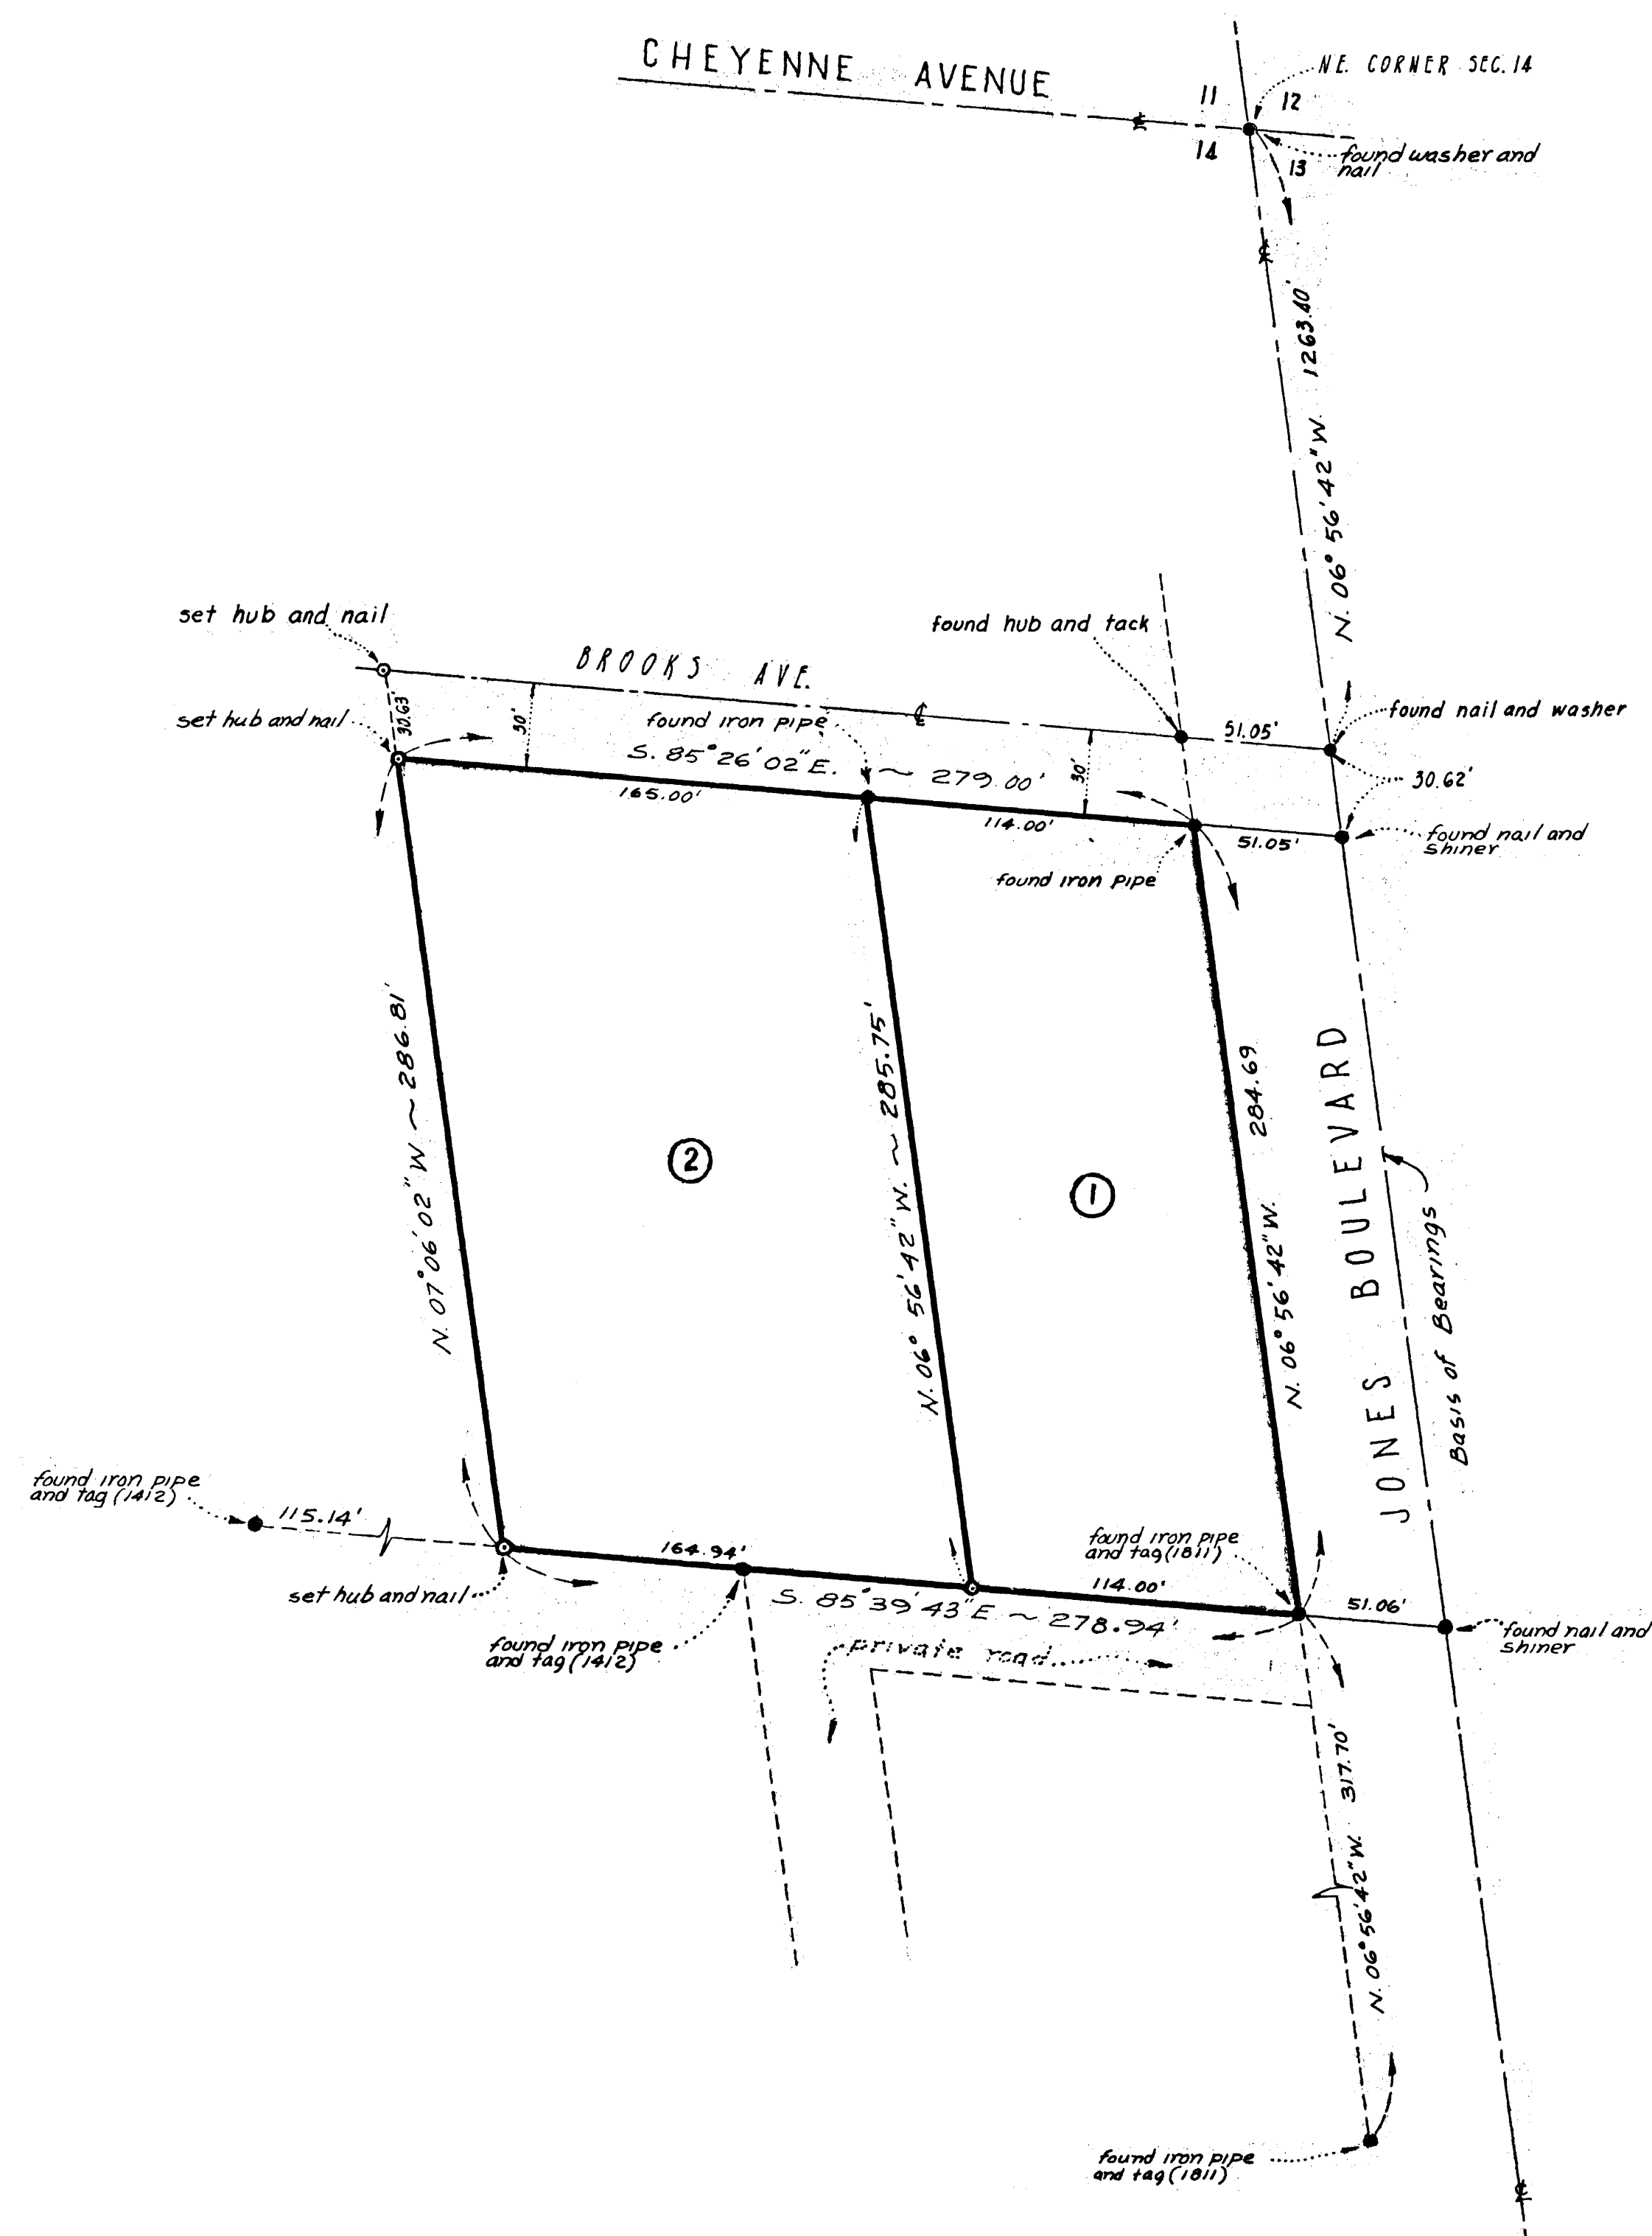


ENGINEERS' CERTIFICATE

I, Robert J. McNutt, Professional Engineer and Registered Land Surveyor, do hereby certify that this map is a true and accurate representation of the lands shown hereon and surveyed under my supervision on the 25 day of May 1973 at the instance of Lorraine & Ralph Clarkson and Lester & Madaleen Wiley Taylor. All points found or set are correctly designated hereon. This map does not constitute a subdivision as defined by Nevada State Law.

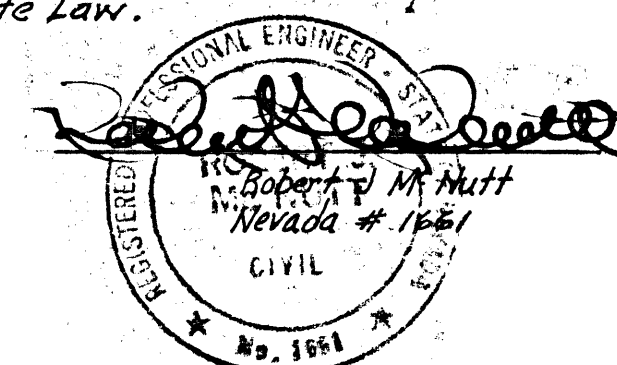

LEGEND

- Point found - as described hereon
- Point set - hub & nail - tagged RLS 1661

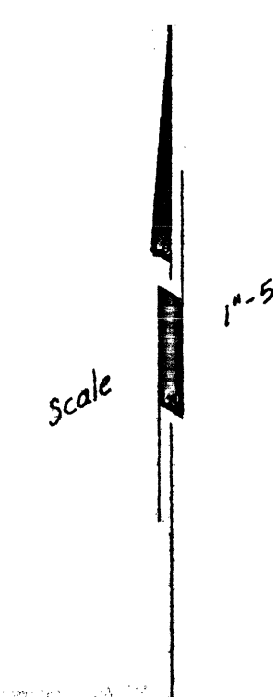

BASIS OF BEARING

Basis of Bearings - N. 06° 56' 42\" W. the east of the North-east quarter of Section 14, Township 20 S., Range 60 East, M.D.B. & M. of the City of Las Vegas, Nevada as shown on page 82, Book 15, engineers file as recorded in the office of the Clark County Recorder.

APPROVAL

Approved and accepted as meeting the requirements of Chapter 28.32, Clark County code, and the conditions of approval as imposed by the Clark County Planning Commission. Minor Subdivision.

George C. Mahan 6-18-73
George C. Mahan
Director of Public Works

E.J. Doherty 6-18-73
E.J. Doherty
Director of Planning

No. 298664
Filed at the request of
ROBERT J. MCNUTT
Date 6-21-73 at 11:02 A.M.
FILE 26 PAGE 3
OF SURVEYS
Official Record Book No. 339
Clark County, Nevada records
Paul F. Horn - Recorder EF
Feb 22, 66 AN Deputy

MAP FOR RECORD OF SURVEY
A PORTION OF THE NE 1/4 OF SECTION 14
T. 20 S. - R 60 E. - M.D.M.
CLARK COUNTY NEVADA
for
LORRAINE C. & RALPH E. CLARKSON
and
LESTER & MADALEEN WILEY TAYLOR
SCALE - 1" = 50'

FILE 26 PAGE 3

055-536