


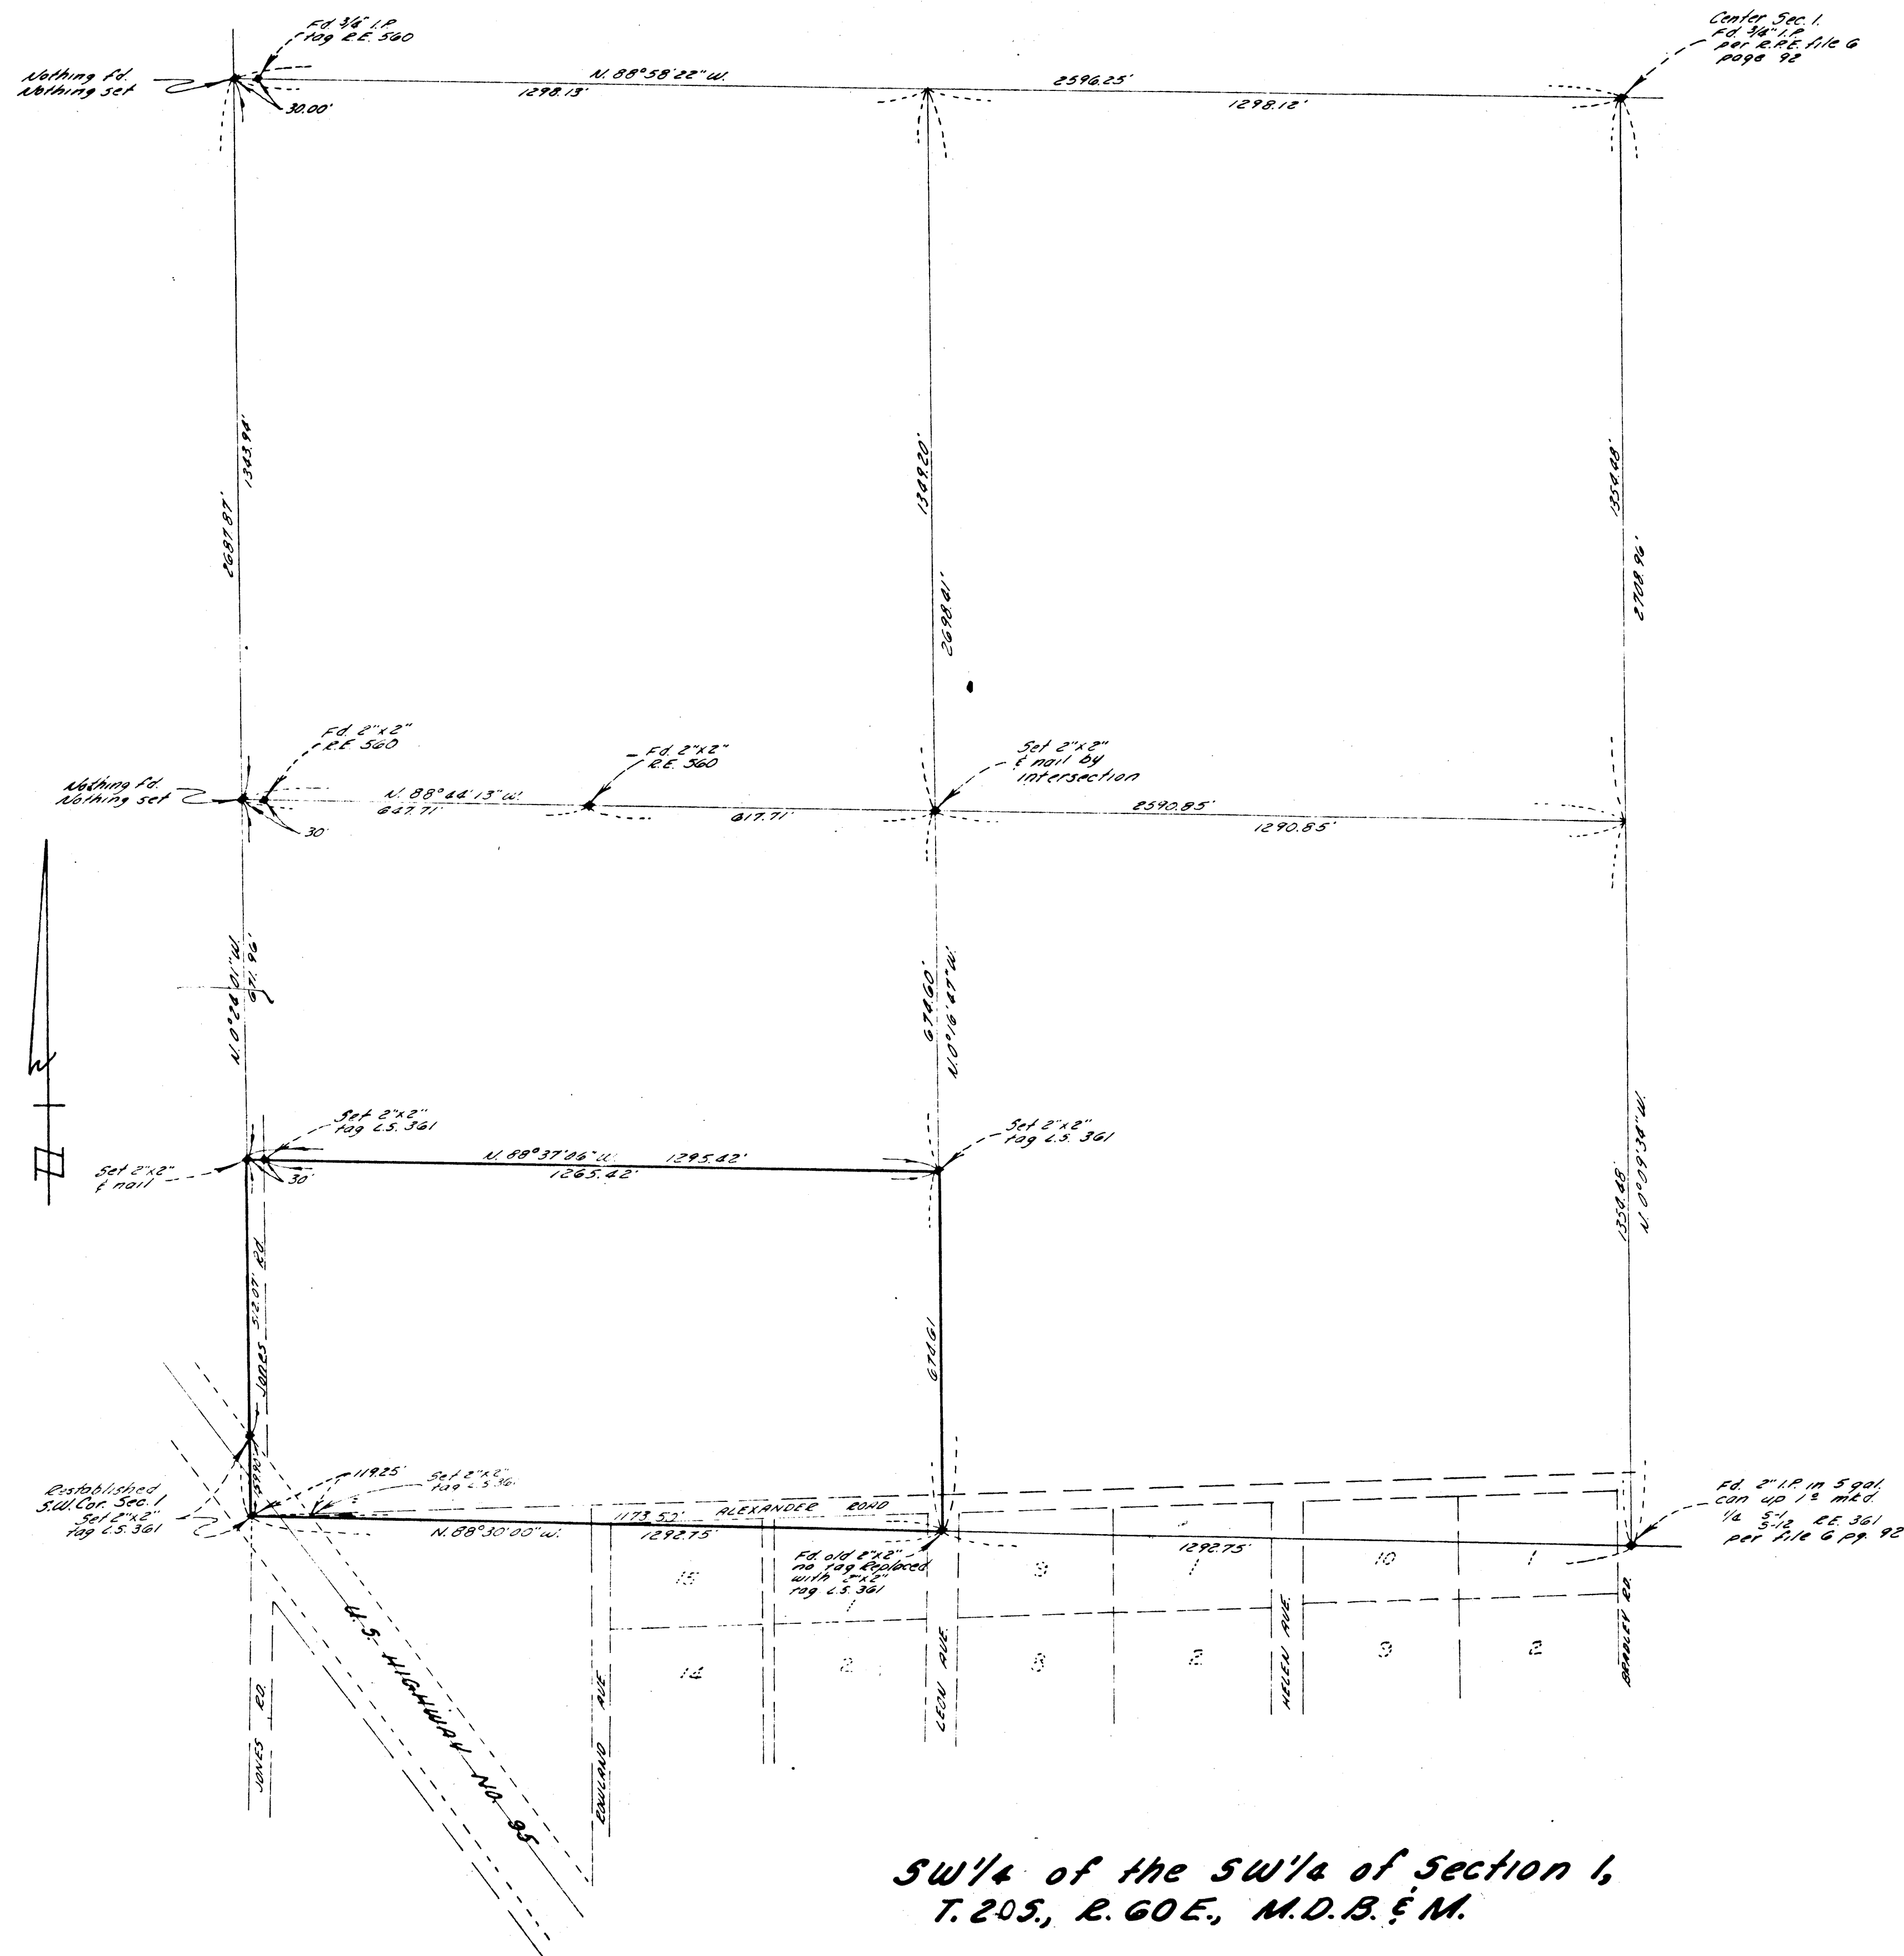


## Basis of Bearings

The Basis of Bearings for this survey is the bearing of the south line of Section 1, T. 20S, R. 60E, as shown on Record of Survey file 6 page 92, Clark County, Nevada.

## Engineer's Certificate

This is to certify that this map, consisting of one sheet, accurately delineates the results of a survey made under my supervision at the instance of Larry Lapenta and was completed on the 14th day of March, 1963, that the points found and the points set are correctly shown herein, and that this is not intended to be a subdivision.

Frank D. Rathbun Jr.  
Registered Land Surveyor  
Nevada Certificate 361

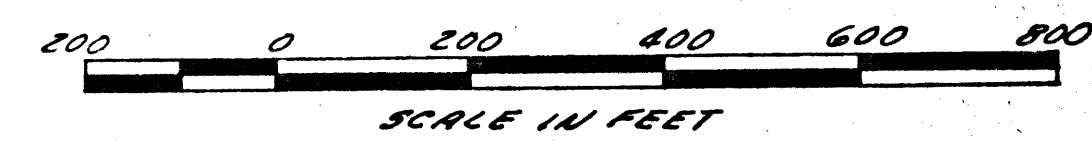

NO. 346081  
FILED AT THE  
FRANK D. RATHBUN JR.  
5-15-63 2:15 P.M.  
1/2 12 69  
429  
RECORD  
FEE \$2.50 S.S. Deputy

MAP FOR RECORD OF SURVEY  
FOR  
LARRY LAPENTA  
OF  
THE 5/8 OF THE SW 1/4 OF THE SW 1/4  
SECTION 1, T. 20S, R. 60E, M.D.B. & M.  
CLARK COUNTY, NEVADA.  
TRI-CO SURVEYORS INC.  
511 LAS VEGAS BLVD. 50.  
LAS VEGAS, NEVADA.