
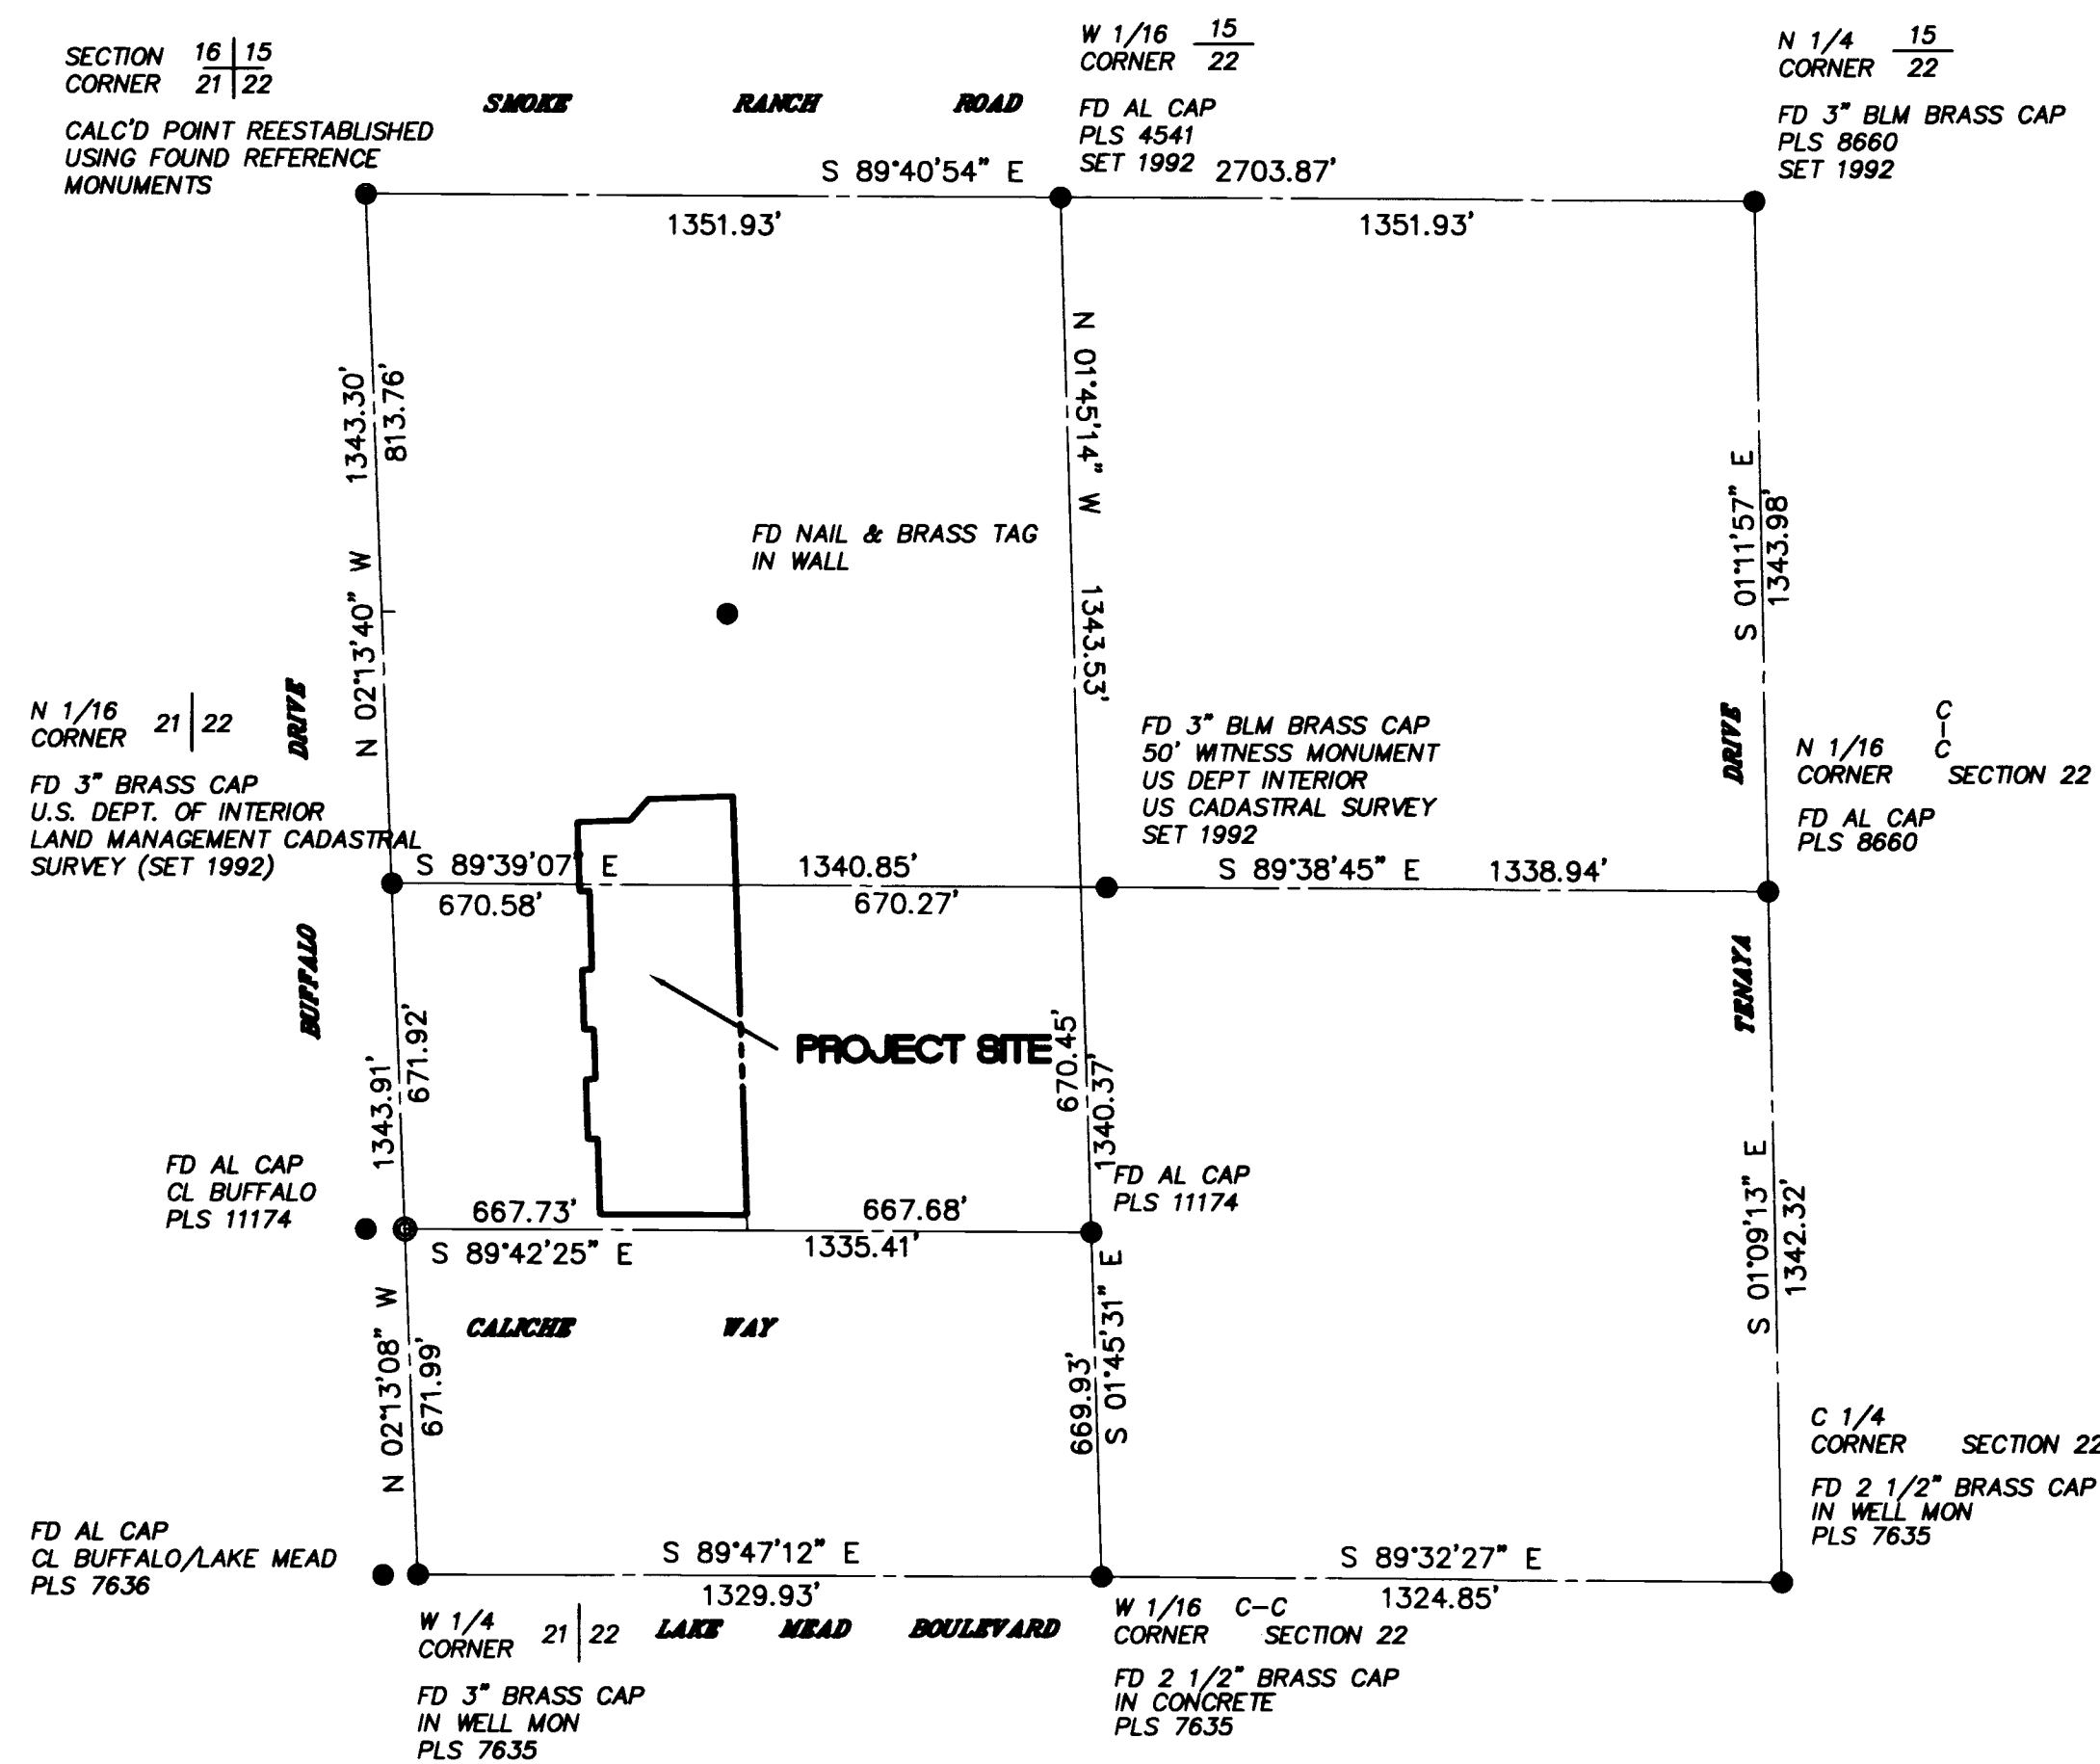


MONUMENTATION TIE MAP
OF
LAKE MEAD CONDOMINIUMS
A COMMON INTEREST CONDOMINIUM COMMUNITY
A PORTION OF THE WEST HALF (W 1/2) OF THE NORTHWEST QUARTER (NW 1/4) OF
SECTION 22, TOWNSHIP 20 SOUTH, RANGE 60 EAST, M.D.M., CLARK COUNTY, NEVADA.


SURVEYOR'S CERTIFICATE:

I, BRENT ROSS WOOLSEY A PROFESSIONAL LAND SURVEYOR, REGISTERED IN THE
STATE OF NEVADA, CERTIFY THAT THE MONUMENTS ARE OF THE CHARACTER SHOWN AND
OCCUPY THE POSITIONS INDICATED HEREON.

BRENT ROSS WOOLSEY
PROFESSIONAL LAND SURVEYOR
NEVADA CERTIFICATE NO. 4301

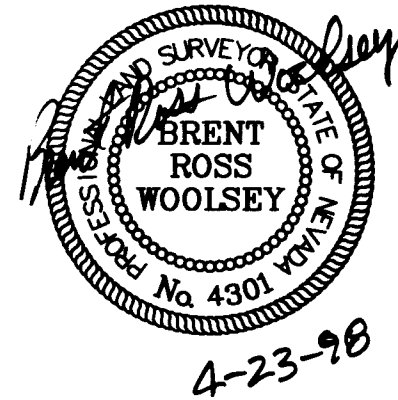

VICINITY MAP
NO SCALE

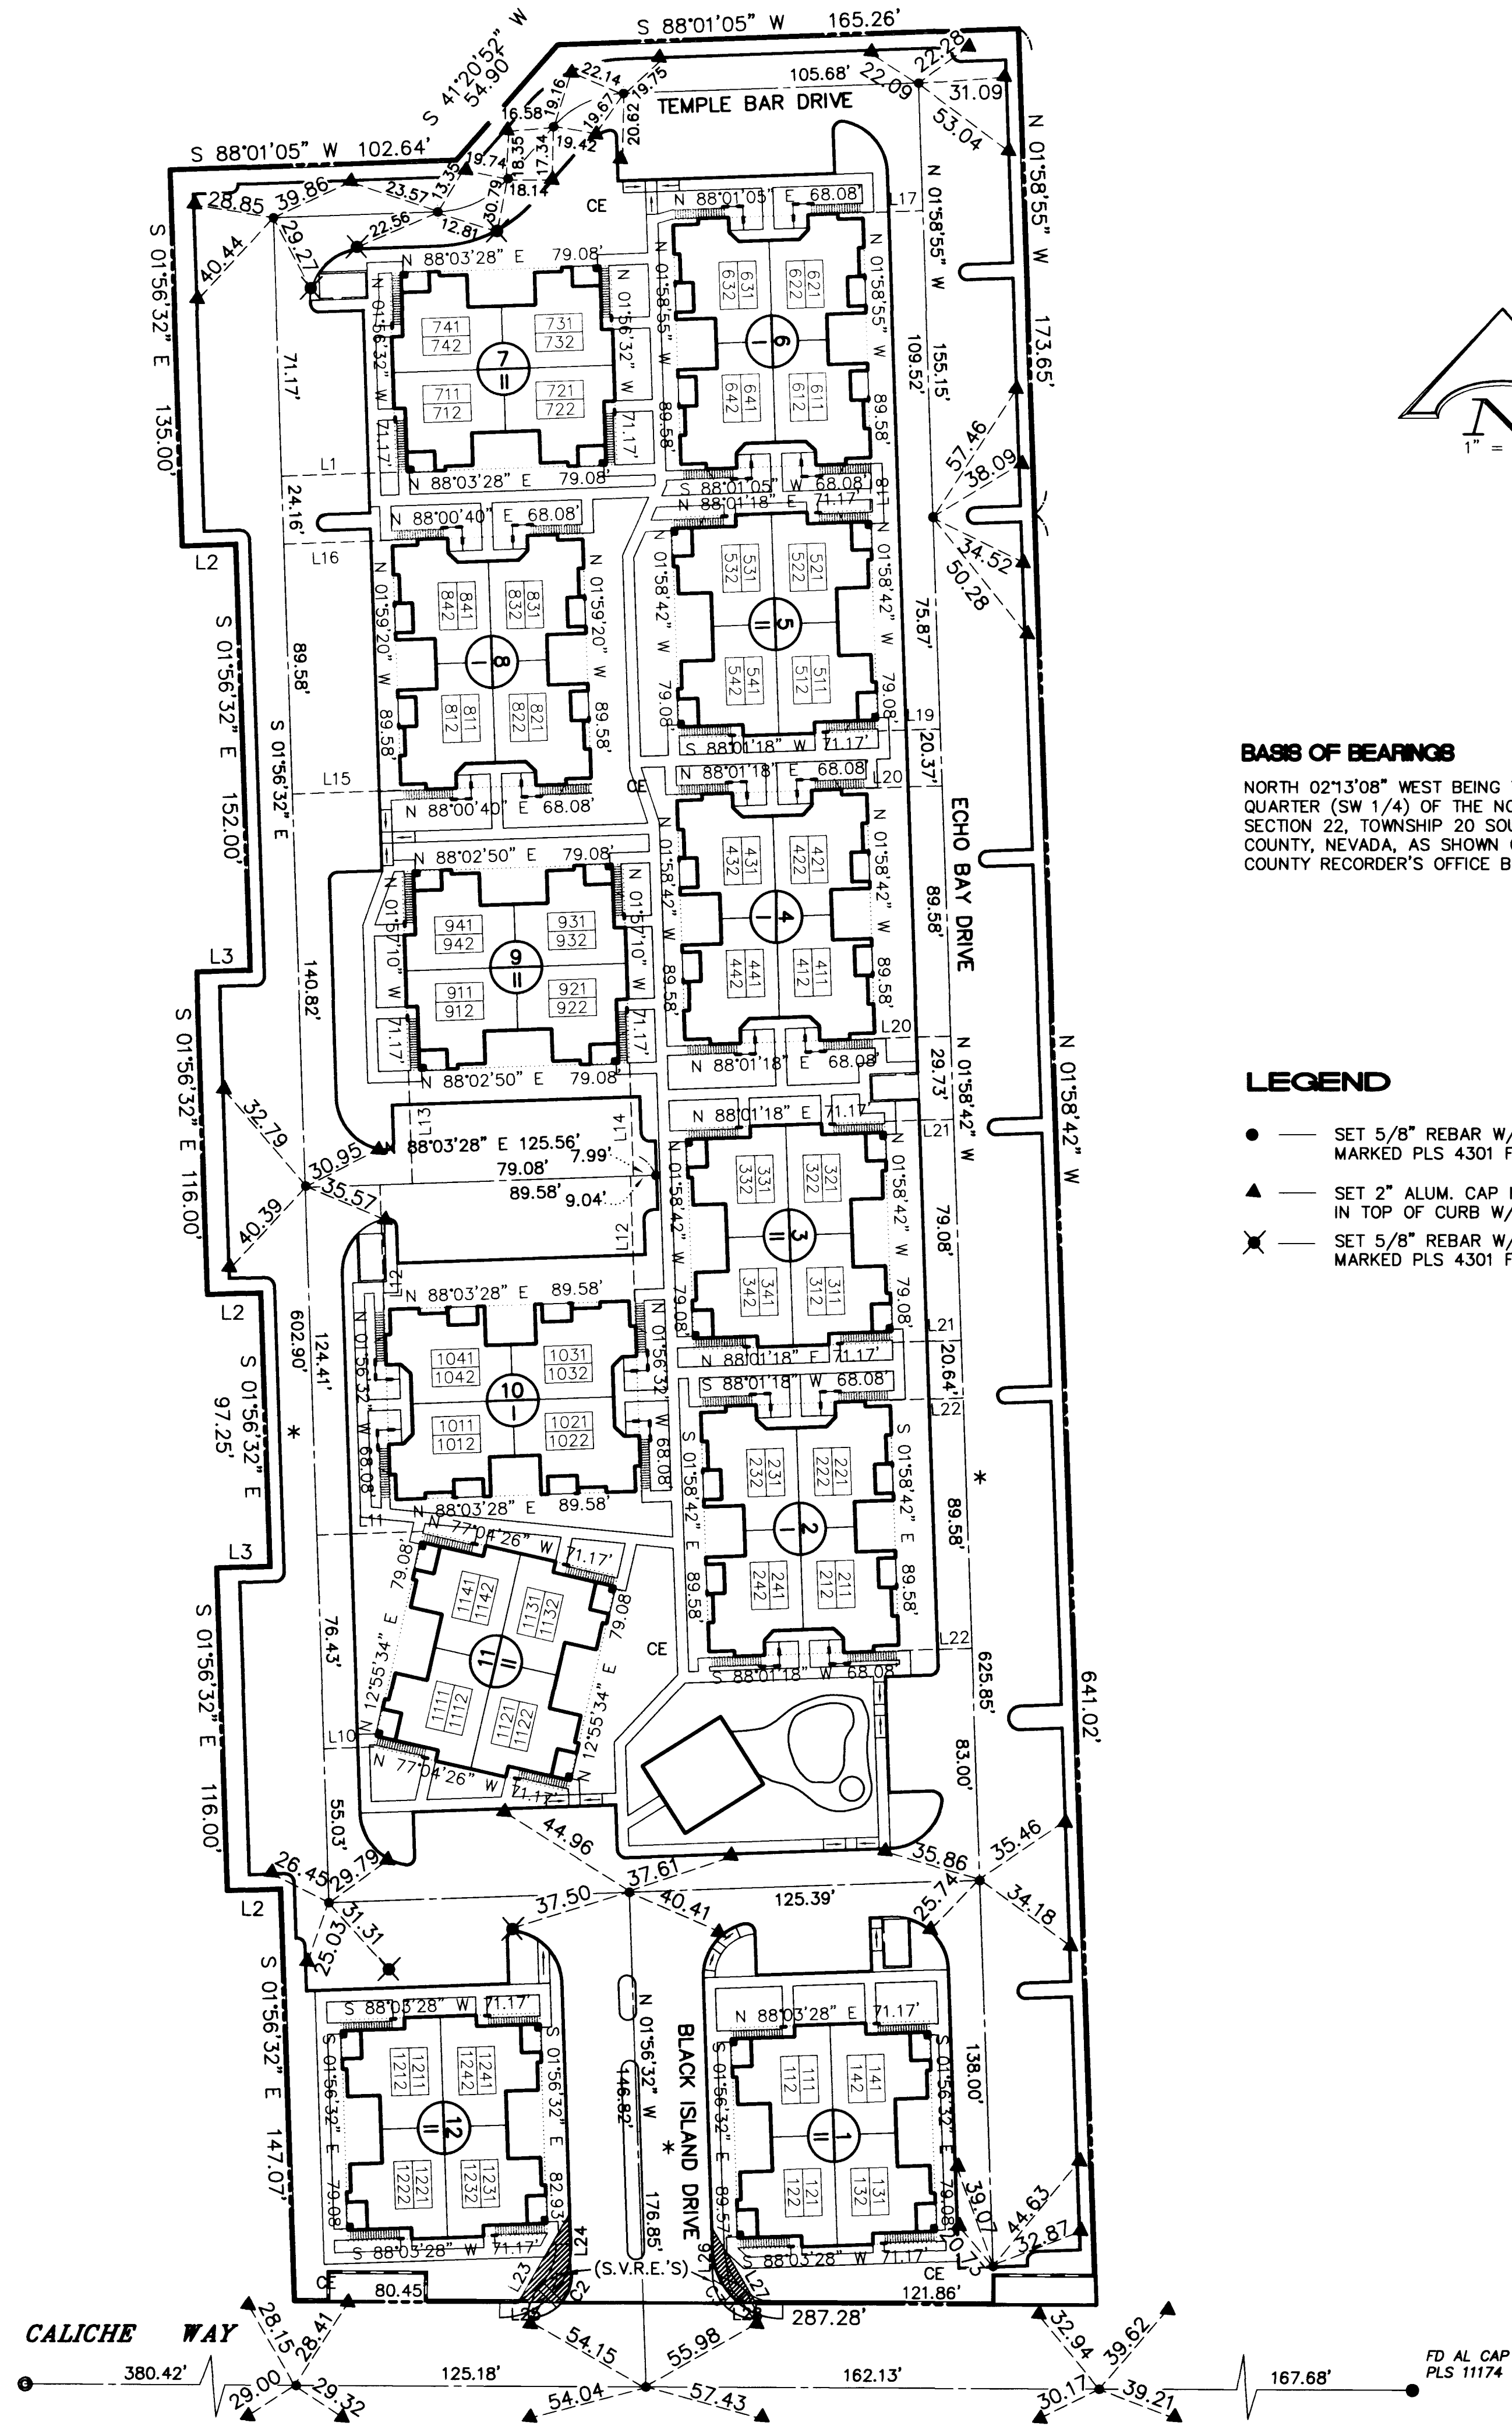

BASIS OF BEARINGS

NORTH 02°13'08" WEST BEING THE WEST LINE OF THE SOUTHWEST
QUARTER (SW 1/4) OF THE NORTHWEST QUARTER (NW 1/4) OF
SECTION 22, TOWNSHIP 20 SOUTH, RANGE 60 EAST, M.D.M. CLARK
COUNTY, NEVADA, AS SHOWN ON A MAP ON FILE IN THE CLARK
COUNTY RECORDER'S OFFICE BOOK 44, PAGE 07 OF PLATS.

LEGEND

- SET 5/8" REBAR W/ 1-1/2" ALUM. CAP
MARKED PLS 4301 FLUSH W/ ASPHALT
- ▲ SET 2" ALUM. CAP MARKED R.M. PLS 4301
IN TOP OF CURB W/ EPOXY IN DRILL HOLE
- ✕ SET 5/8" REBAR W/ 1-1/2" ALUM. CAP
MARKED PLS 4301 FLUSH W/ GROUND FOR R.M.

L. R. NELSON CONSULTING ENGINEERS, INC.

3035 East Patrick Lane
Las Vegas, Nevada 89120
(702) 798-7978
(702) 451-2296 FAX

MONUMENTATION TIE MAP
OF
LAKE MEAD CONDOMINIUMS

CLARK COUNTY
WARMINGTON HOMES
NEVADA

SHEET NUMBER
1
OF 1 SHEETS
812-002-963



Ties for 107-V2686

MONUMENTATION TIE MAP OF LAKE MEAD CONDOMINIUMS

A COMMON INTEREST CONDOMINIUM COMMUNITY



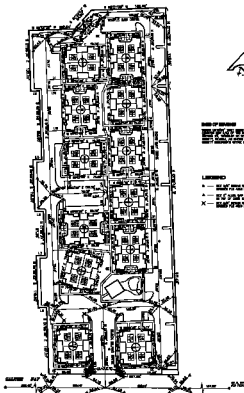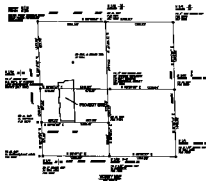



