
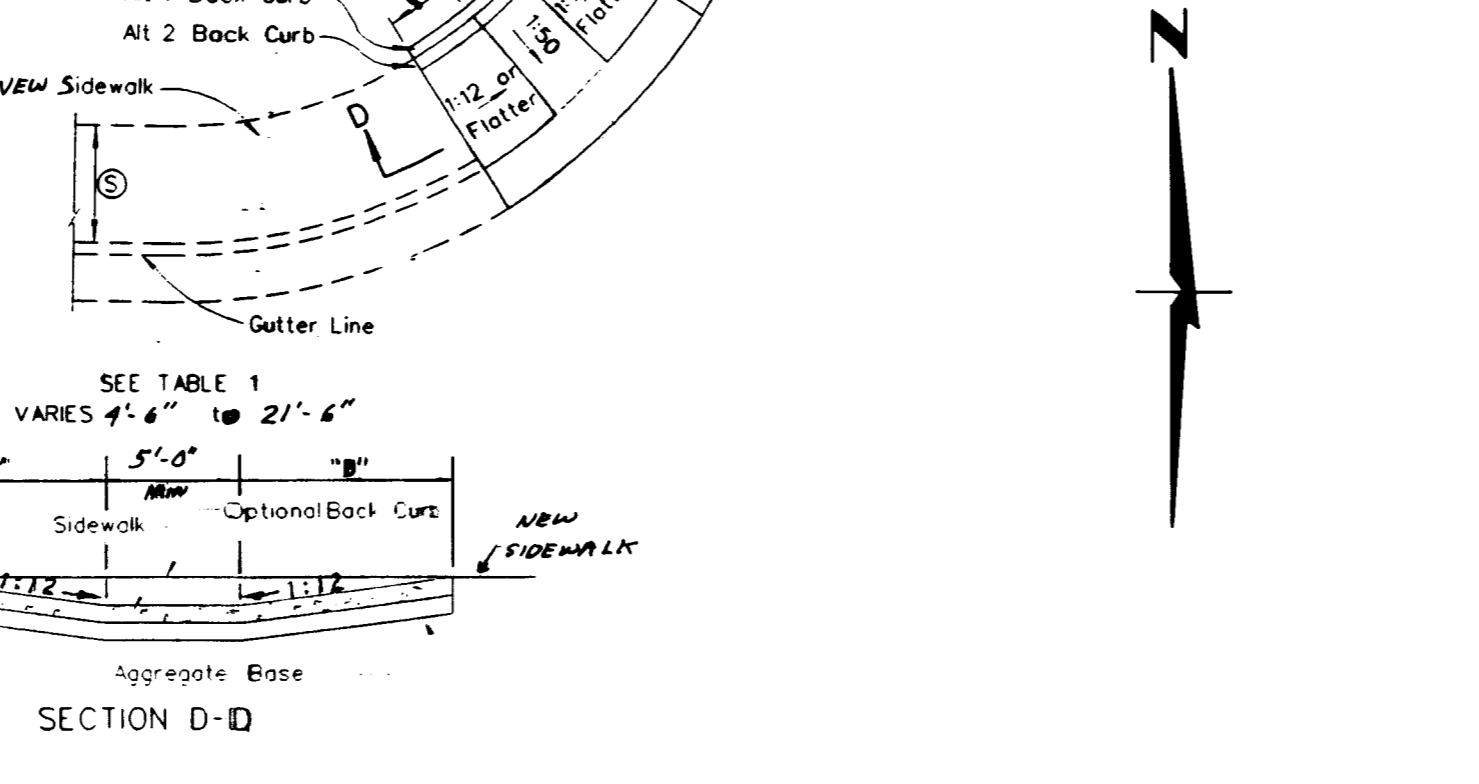
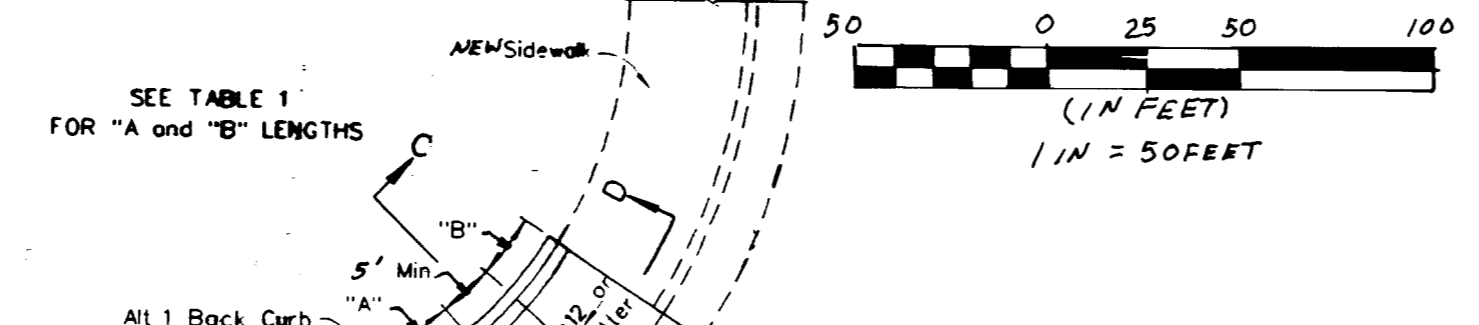
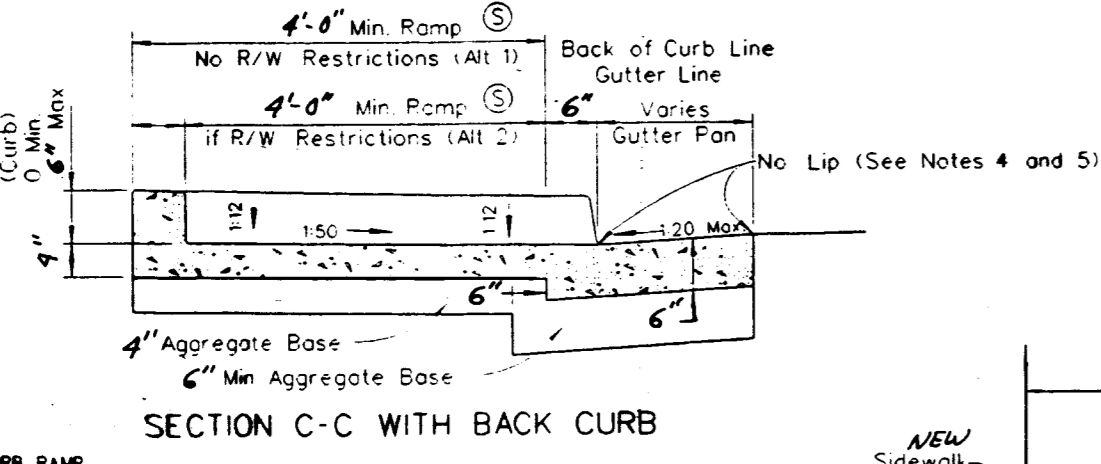



GRADE 'B' TO 'A'	'A' (FT) MIN.	'B' (FT) MIN.
-6 TO -5.01	4.5	21.5
-5 TO -4.01	4.5	15.0
-4 TO -3.01	4.5	12.0
-3 TO -2.01	4.5	9.5
-2 TO 2	8.0	8.0
2.01 TO 3	9.5	4.5
3.01 TO 4	12.0	4.5
4.01 TO 5	15.0	4.5
5.01 TO 6	21.5	4.5

TABLE 1
TRANSITION LENGTHS FOR 1/2 SIDE SLOPES


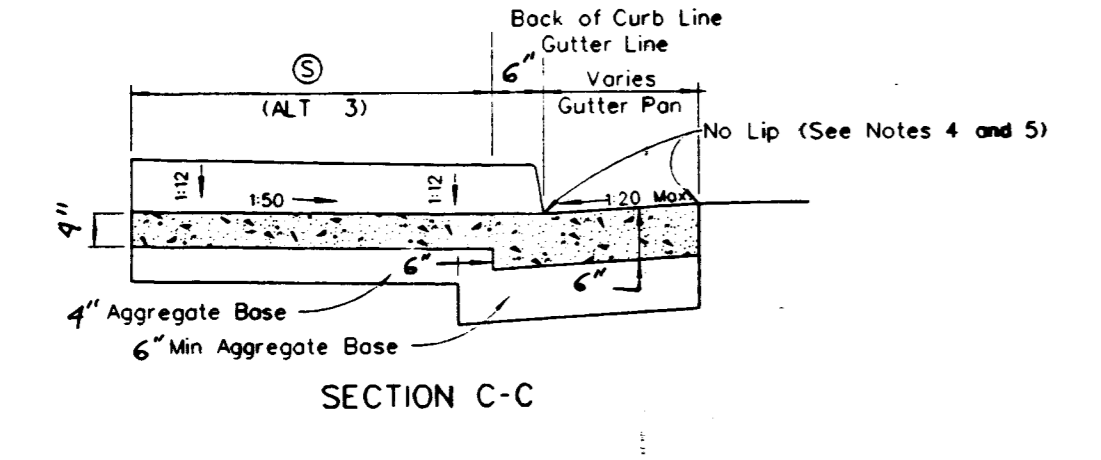


- GENERAL NOTES
- IF RIGHT OF WAY IS AVAILABLE, USE TYPE A CURB RAMP.
 - SEE STRUCTURE LIST AND PLAN SHEETS FOR (A), (B), (C), (Z).
 - GRATINGS OR SIMILAR ACCESS SHALL NOT BE LOCATED IN AREA AT THE BASE OF THE CURB RAMP OR LANDING AREA.
 - NO LIP SHALL BE PERMITTED AT THE CURB RAMP SLOPE TO GUTTER PAN.
 - PLANTING BITUMINOUS OPEN-GRADED SURFACE SHALL BE FLOSH WITH THE EDGE OF THE GUTTER PAN IN THE AREA OF THE CURB RAMP.
 - ROUGH BROOM TEXTURE ON CURB RAMPS AND WINGS. TEXTURE SHALL PROVIDE A VISUAL CONTRAST TO THE SIDEWALK.
 - ALL RAMPS SHALL BE 1:12 OR FLATTER.
 - ALL SLOPE RATES ARE RELATIVE TO LEVEL.


HANDICAPPED RAMPS
PER STD DWG 235
CASE I

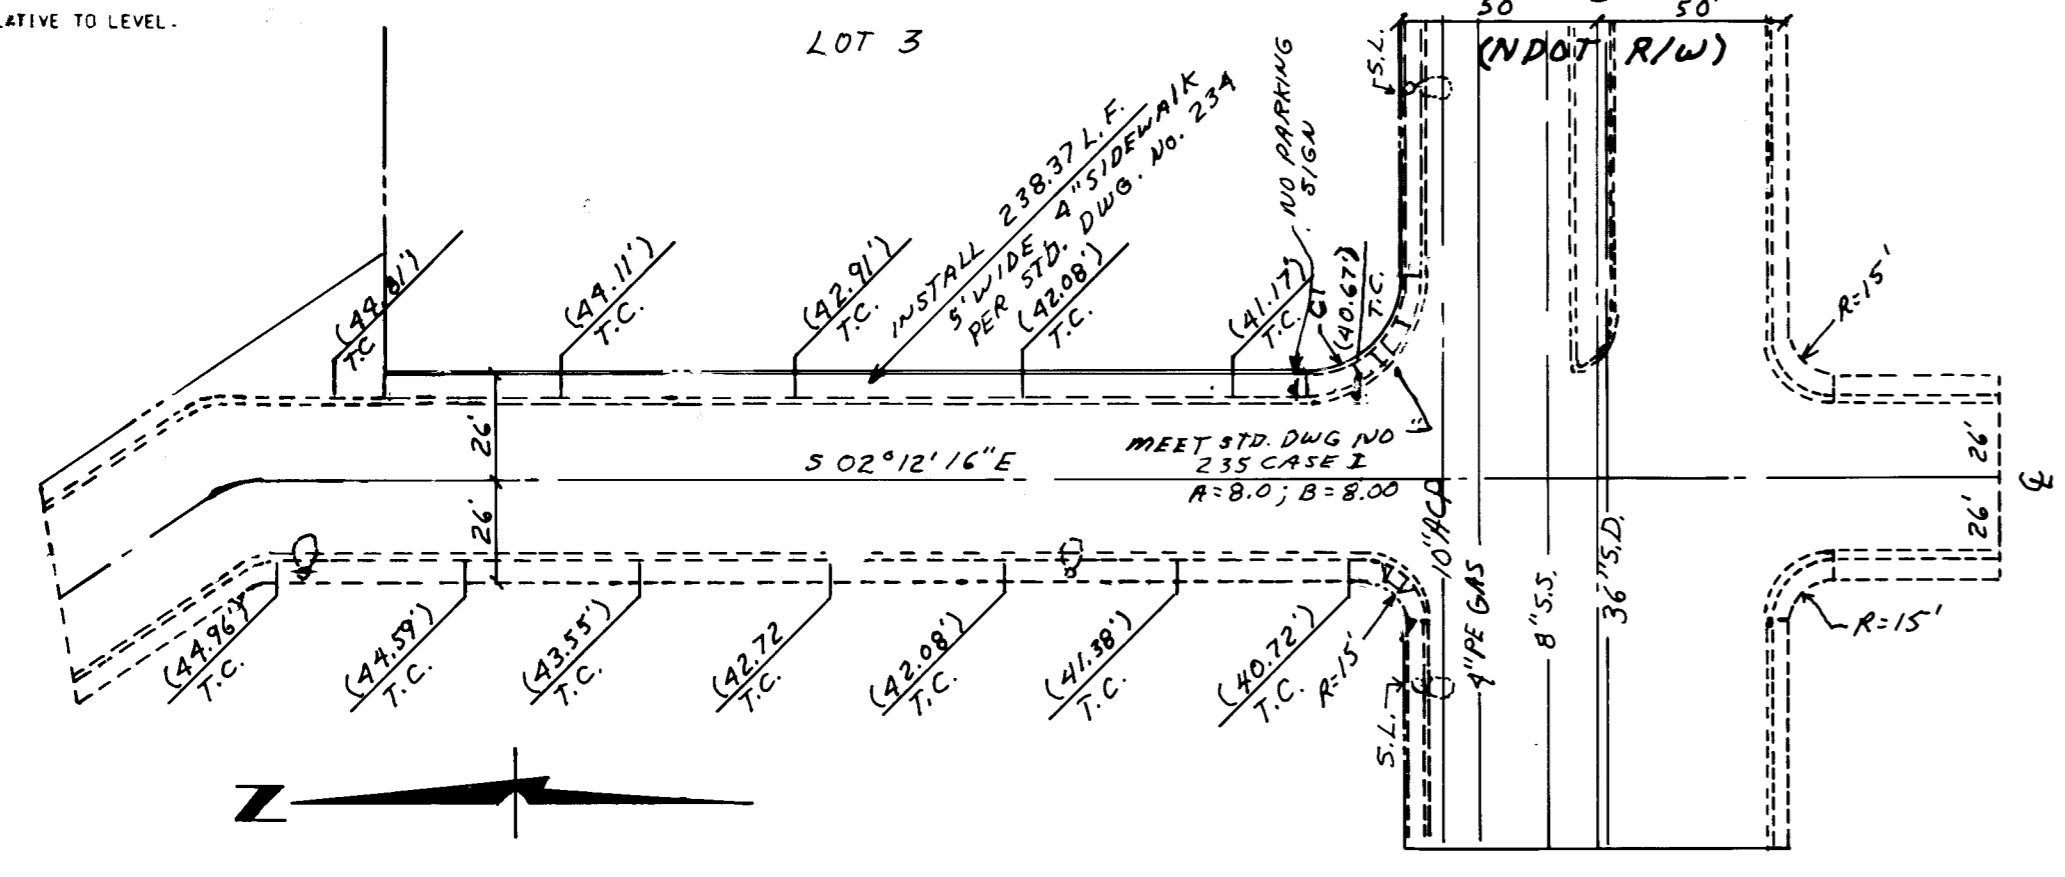



JOANN WAY
PUBLIC STREET

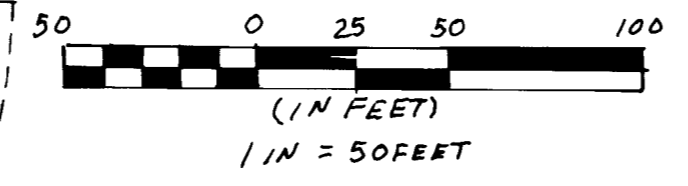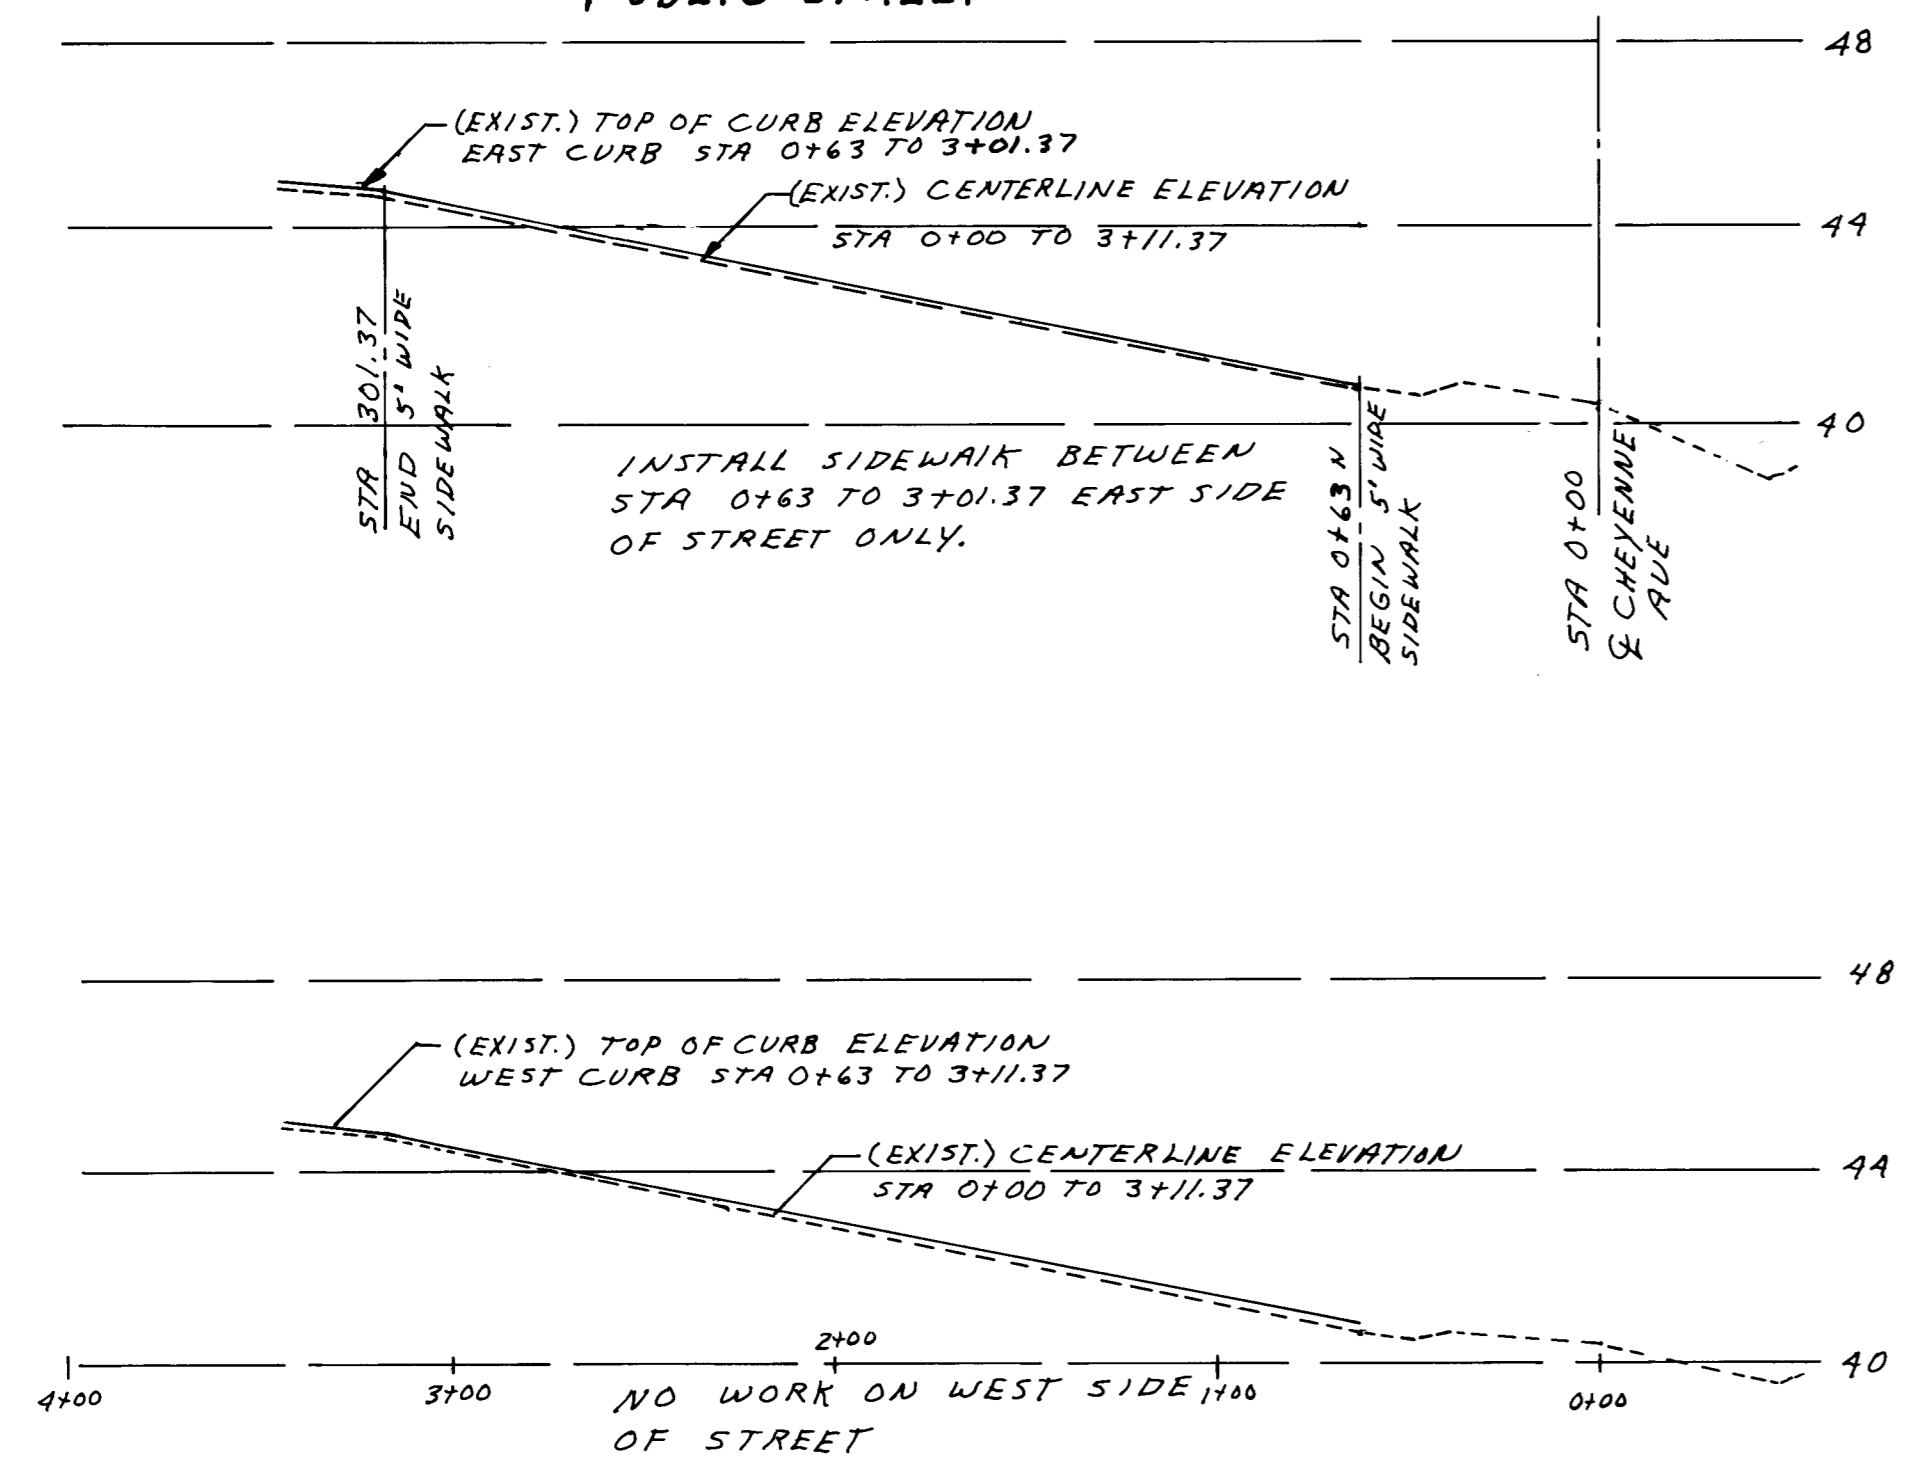

CURVE	RADIUS	DELTA	LENGTH	TANGENT	A	B
C1	25'	90°	39.27'	25.00'	8.0'	8.0'
C2	20'	90°	31.42'	20.00'	4.5'	9.5'
C3	25'	90°	39.27'	25.00'	9.5'	4.5'
C4	15'	141°22'45\"	37.13'	42.81'	8.0'	8.0'
C5	25'	55°47'17\"	24.23'	13.24'	8.0'	8.0'

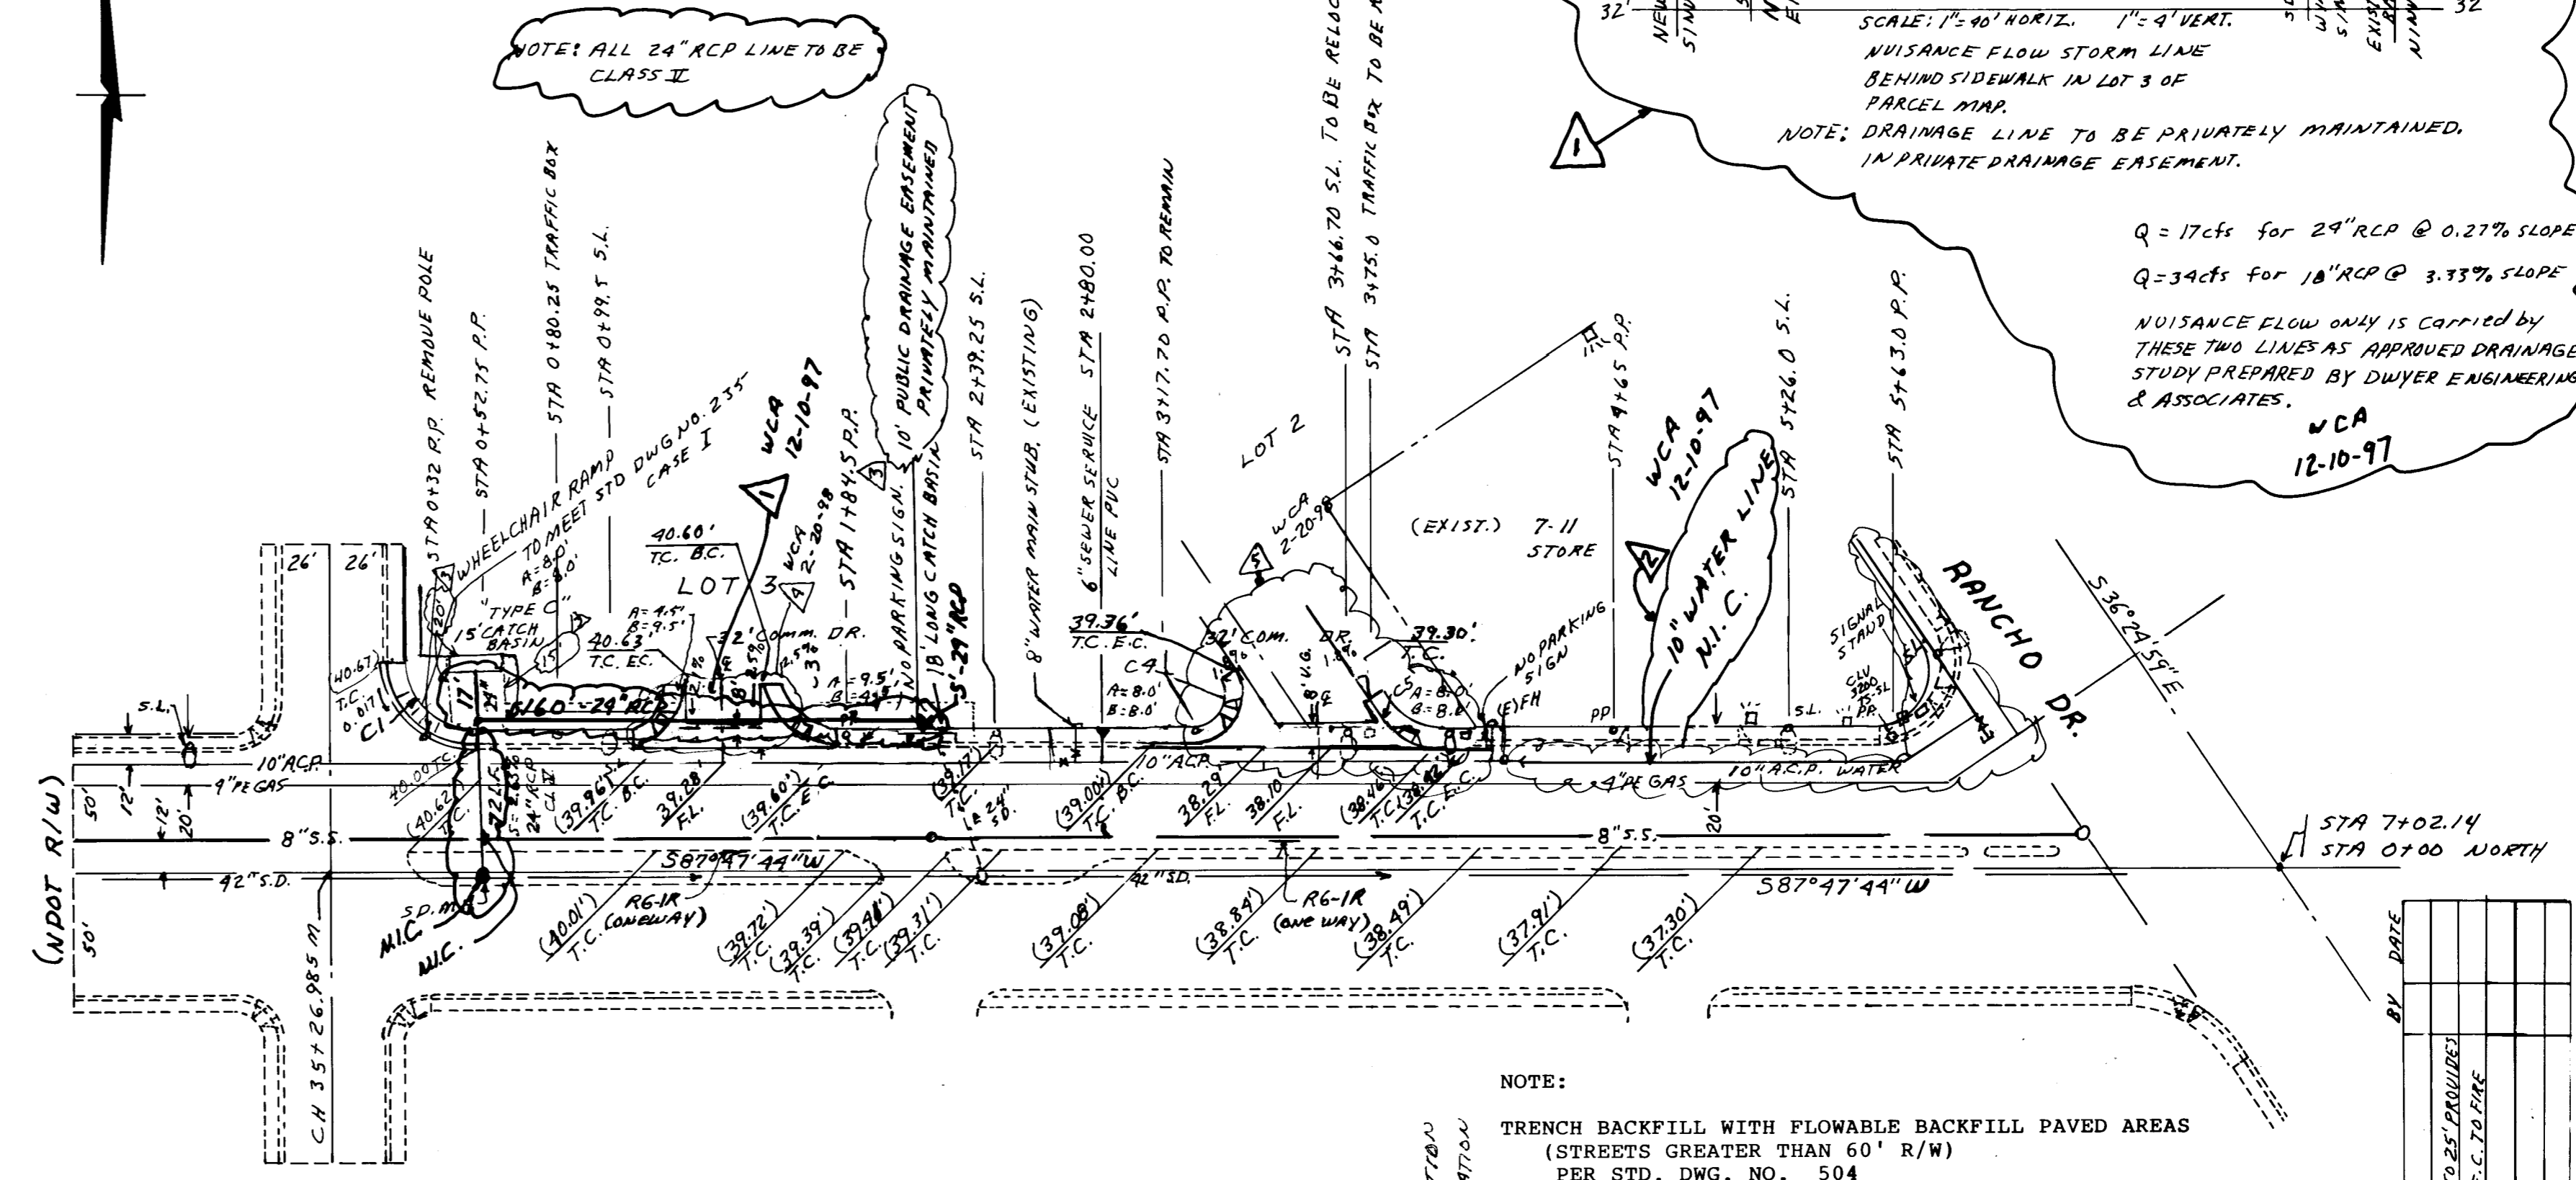

CHEYENNE AVENUE
(NDOT R/W)

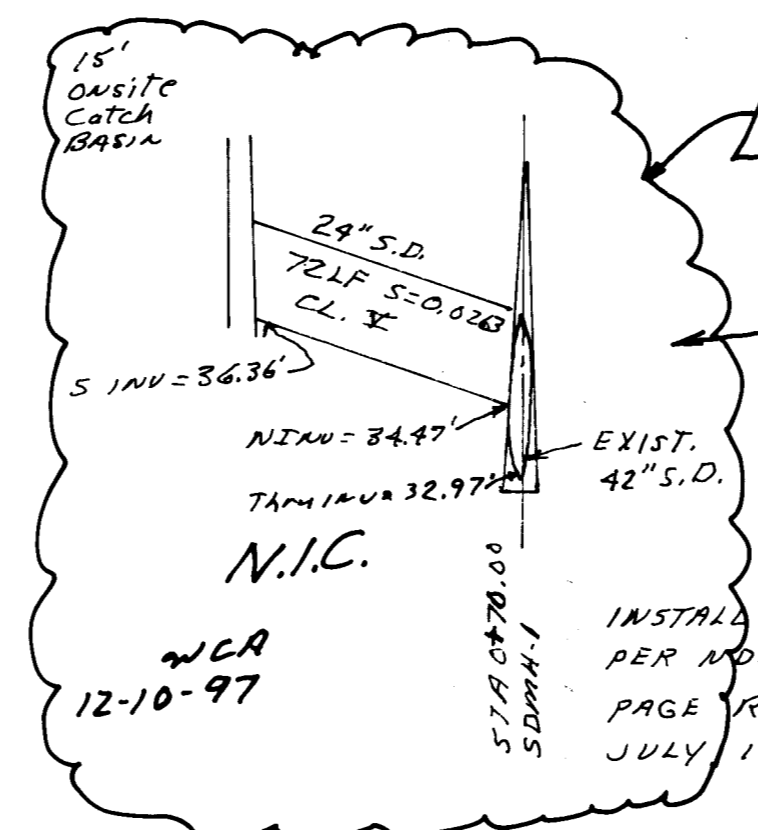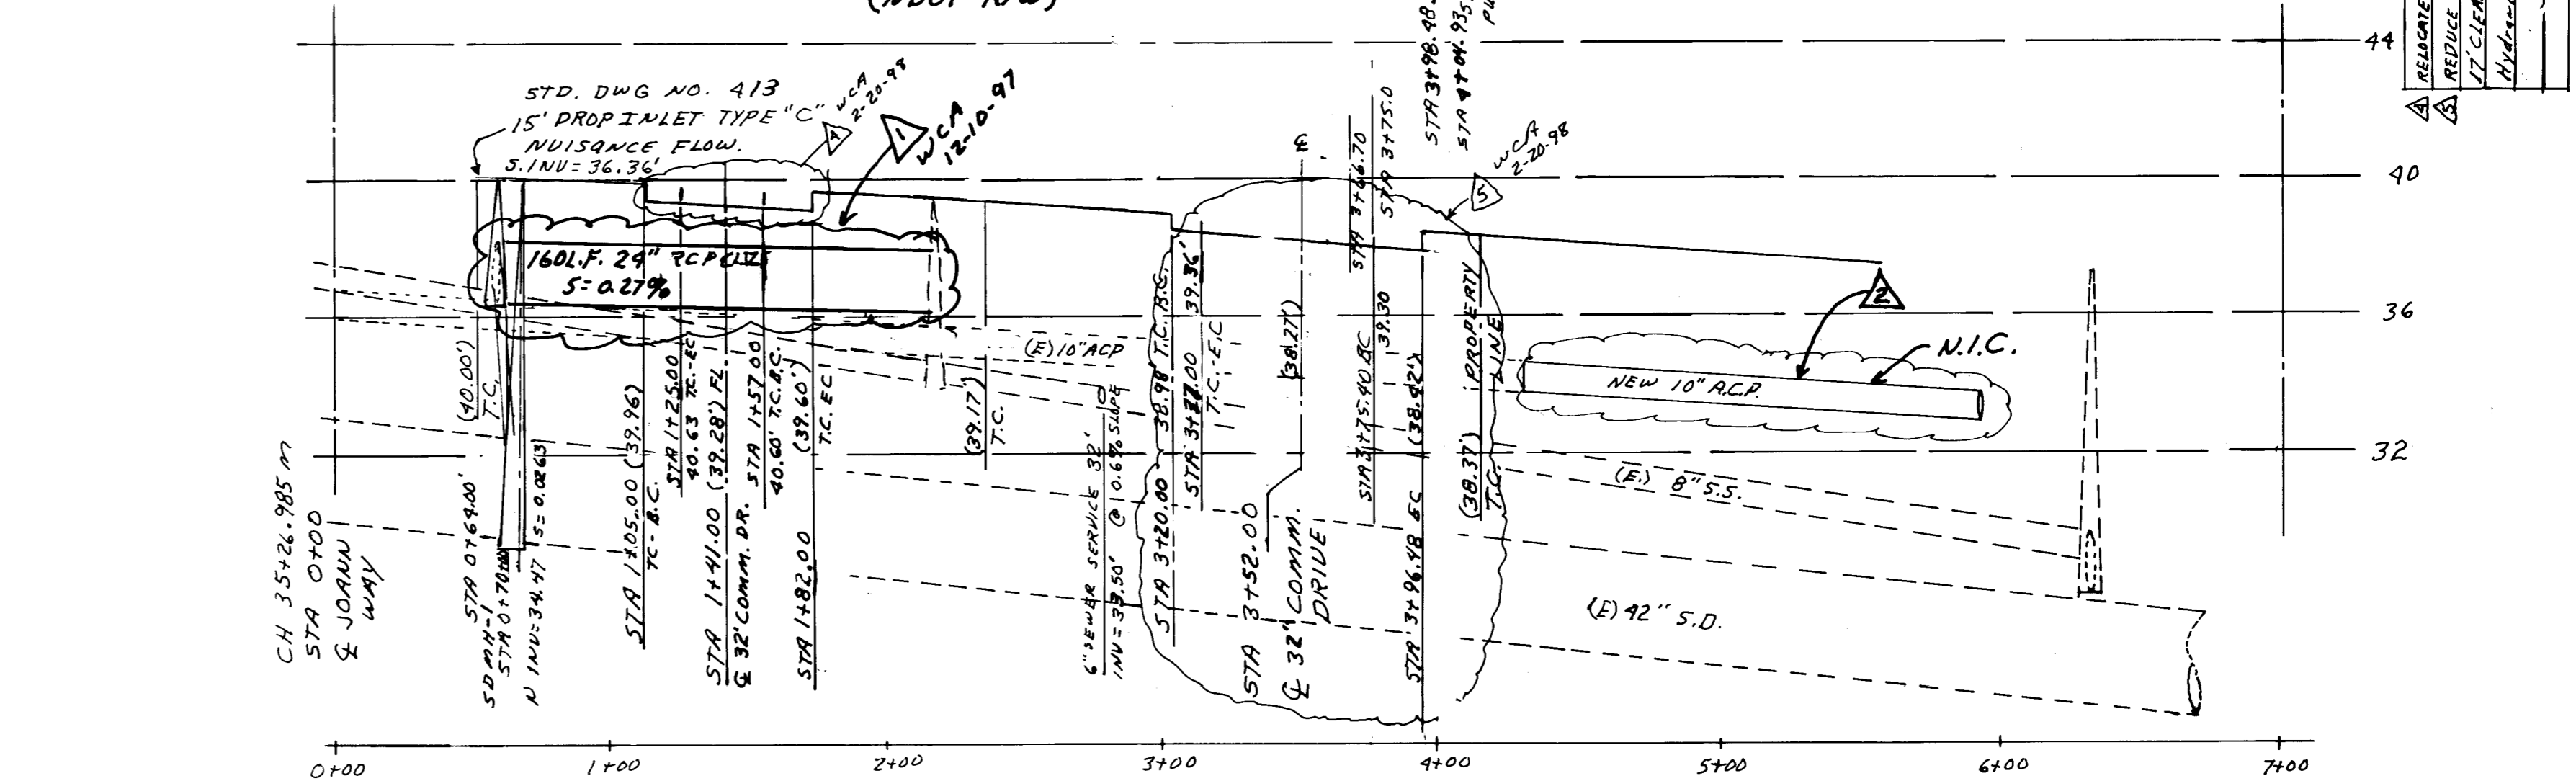

NOTE: 1\"/>

COMMERCIAL DRIVE

SEE UPPER RIGHT FOR REVISION

INSTALL TYPE 4 MANHOLE
PER NDOT R-9.7.2
PAGE R-36 STANDARD PLANS
JULY 1996

- NOTE:
- TRENCH BACKFILL WITH FLOWABLE BACKFILL PAVED AREAS (STREETS GREATER THAN 60' R/W) PER STD. DWG. NO. 504
 - PIPE TRENCH BEDDING METHODS PER STD. DWG. NO. 505 USE CLASS "B" BEDDING


APPROVED FOR CONSTRUCTION

(NDOT) NEVADA DEPARTMENT OF TRANSPORTATION DATE PUBLIC HIGHWAY

A NDOT PERMIT IS REQUIRED FOR ALL IMPROVEMENTS WITHIN THE NDOT R/W.

BENCHMARK:

CITY OF LAS VEGAS VERTICAL CONTROL: NAVD 88: STATION: CCBM, 12SSE6, 2,241.203 FEET, RIVET & PLATE IN TOP OF CURB, NW RETURN OF CHEYENNE AVE. AND RANCHO ROAD.

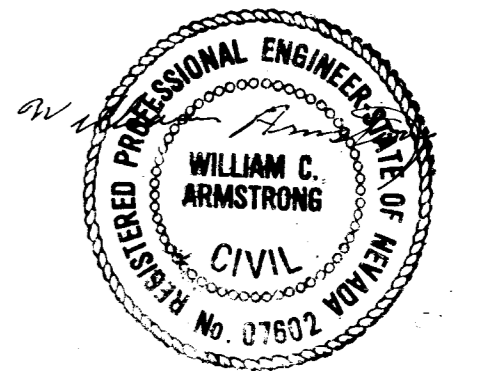

Sept. 3, 1997

REVISIONS	BY	DATE
1	WCA	12-10-97
2	WCA	12-10-97
ARMSTRONG ENGINEERING & DEVELOPMENT, LTD.
3840 N. BRUCE STREET
LAS VEGAS, NEVADA 89130
(702) 220-7220

RONALD REISS TRUST
3625 SO. MOJAVE, SUITE 1
LAS VEGAS, NV 89121

SIDEWALK - JOANN WAY
COMMERCIAL DRIVES - CHEYENNE AVE.

