


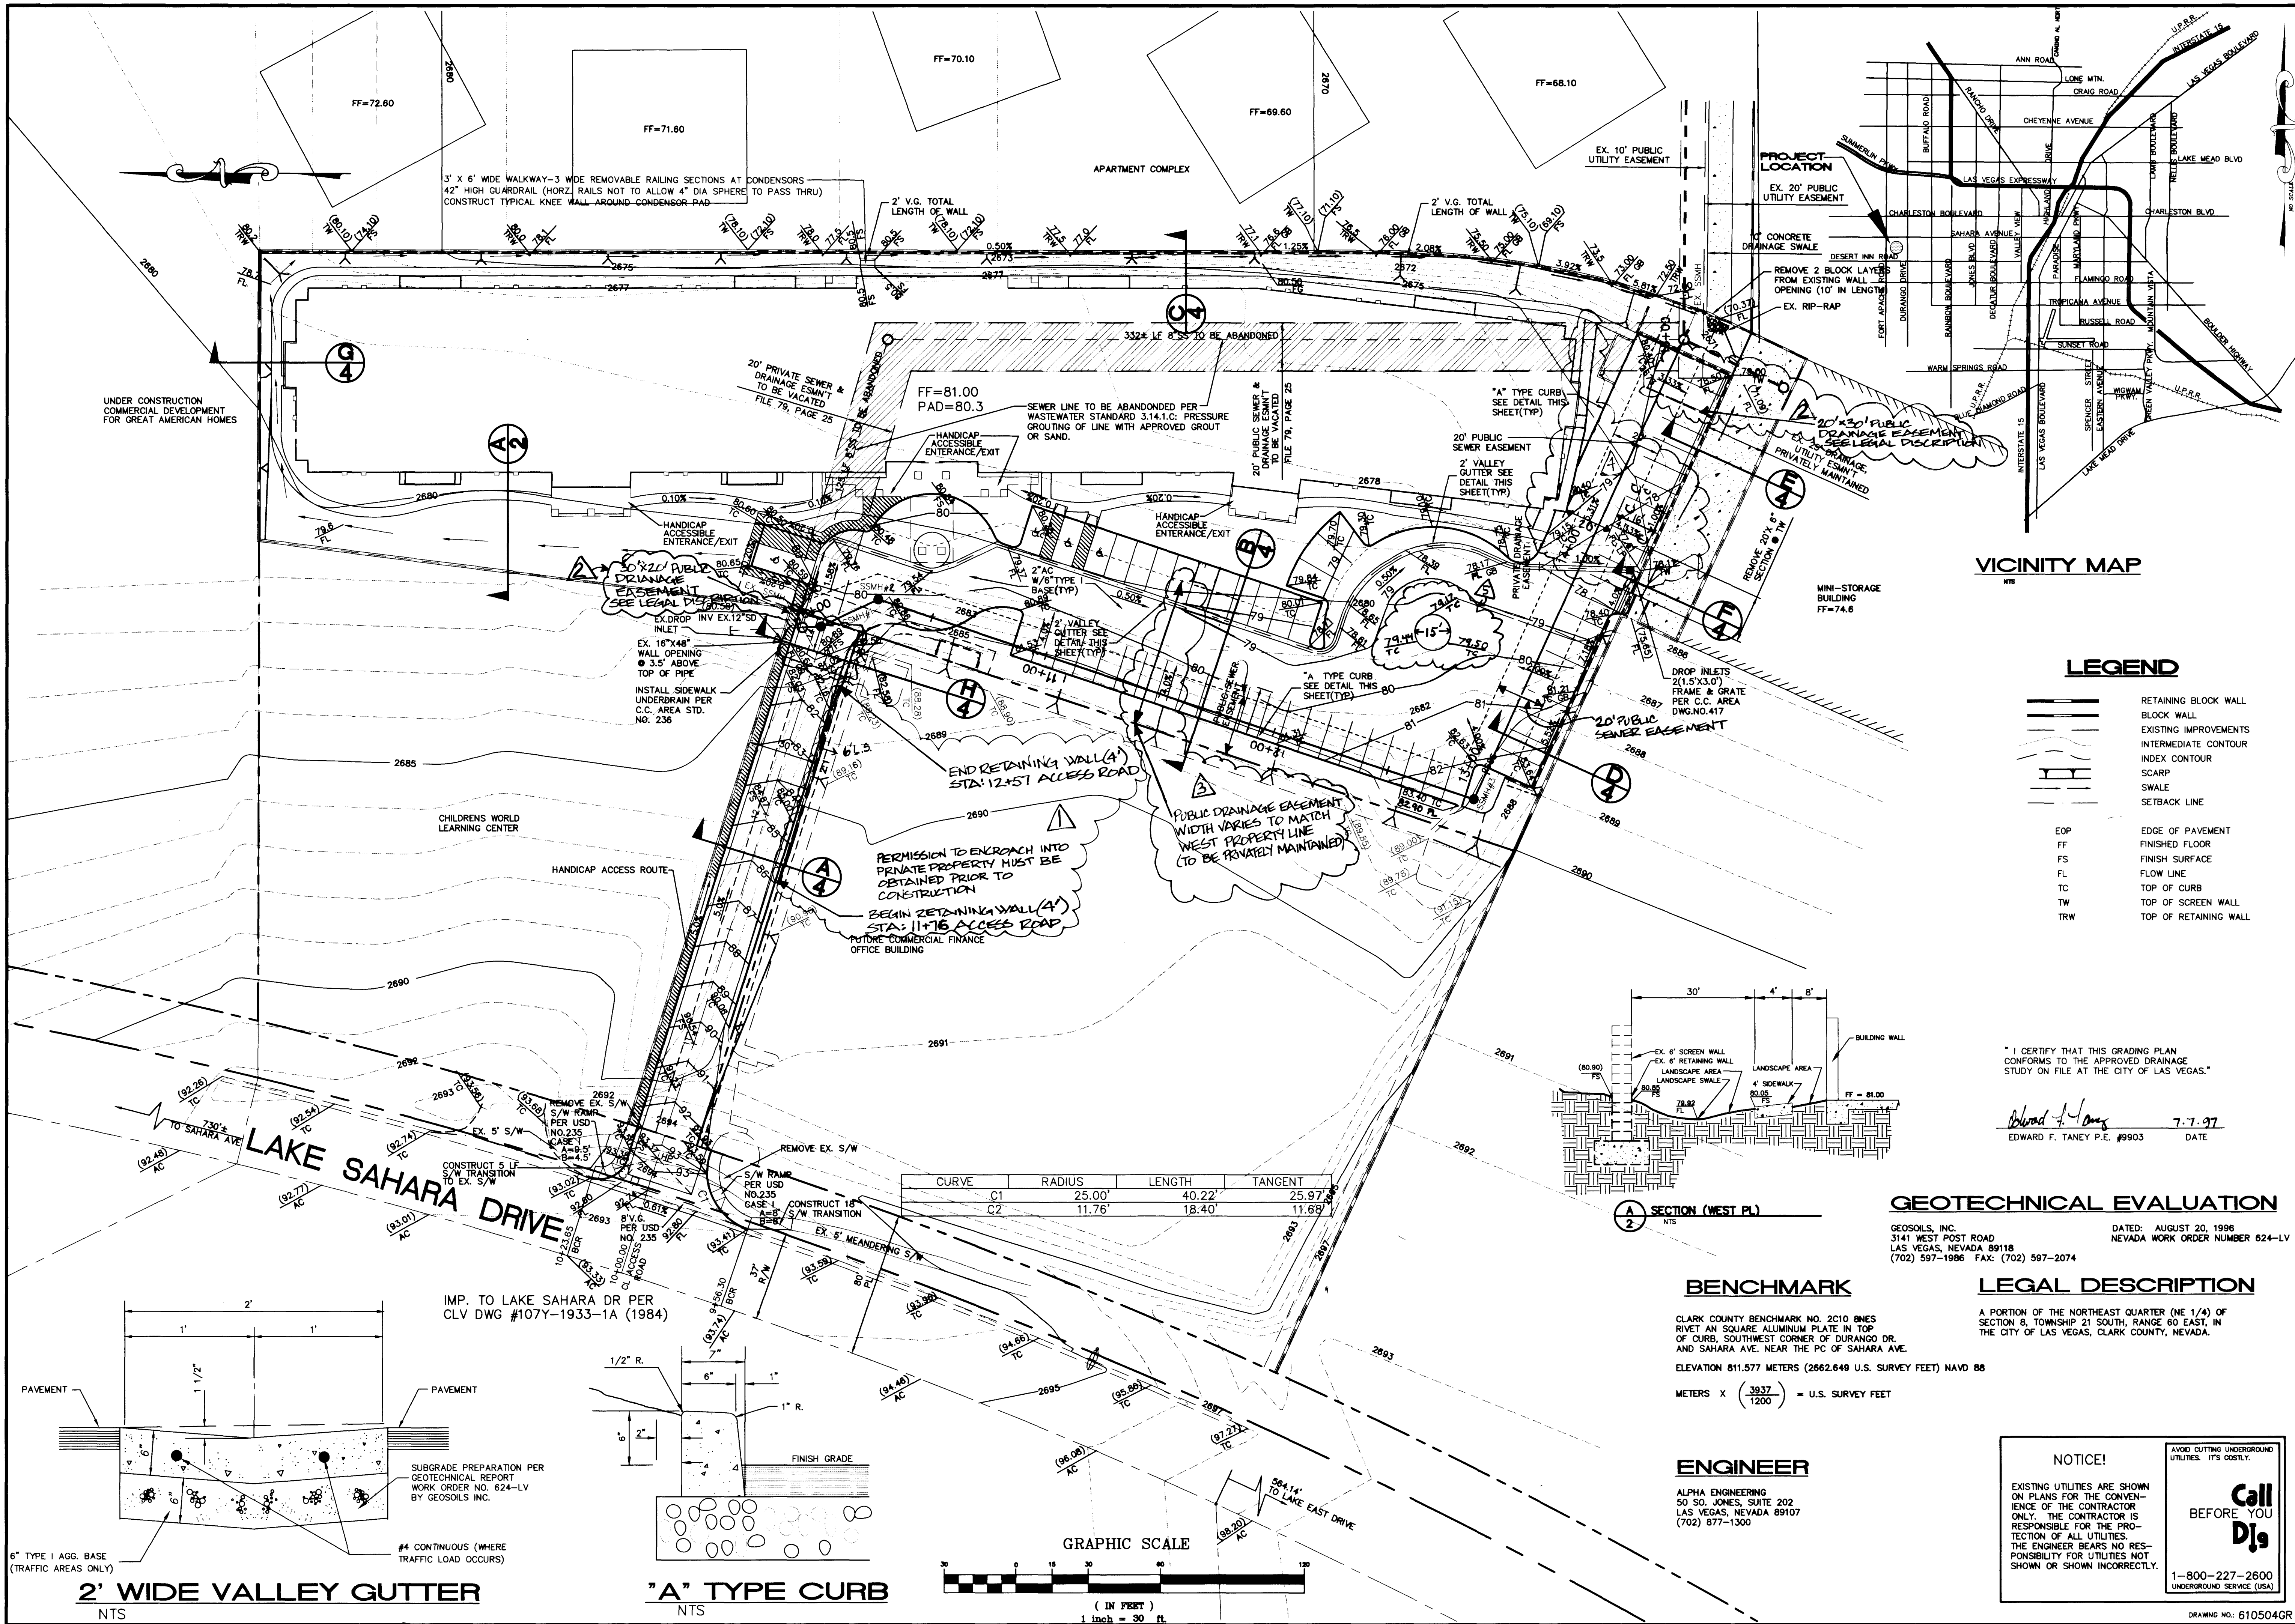

VICINITY MAP

LEGEND

- RETAINING BLOCK WALL
- BLOCK WALL
- EXISTING IMPROVEMENTS
- INTERMEDIATE CONTOUR
- INDEX CONTOUR
- SCARP
- SWALE
- SETBACK LINE
- EOP
- FF
- FS
- FL
- TC
- TW
- TRW
- EDGE OF PAVEMENT
- FINISHED FLOOR
- FINISH SURFACE
- FLOW LINE
- TOP OF CURB
- TOP OF SCREEN WALL
- TOP OF RETAINING WALL

GEOTECHNICAL EVALUATION

GEOSOLS, INC.
3141 WEST POST ROAD
LAS VEGAS, NEVADA 89118
(702) 597-1986 FAX: (702) 597-2074
DATED: AUGUST 20, 1996
NEVADA WORK ORDER NUMBER 624-LV

BENCHMARK

CLARK COUNTY BENCHMARK NO. 2C10 QUES
RIVET AN SQUARE ALUMINUM PLATE IN TOP
OF CURB, SOUTHWEST CORNER OF DURANGO DR.
AND SAHARA AVE. NEAR THE PC OF SAHARA AVE.
ELEVATION 811.577 METERS (2662.649 U.S. SURVEY FEET) NAVD 88
METERS X $\left(\frac{3937}{1200}\right)$ = U.S. SURVEY FEET

ENGINEER

ALPHA ENGINEERING
5050 S. JONES, SUITE 202
LAS VEGAS, NEVADA 89107
(702) 877-1300

NOTICE!
EXISTING UTILITIES ARE SHOWN
ON PLANS FOR THE CONVENIENCE
OF THE CONTRACTOR ONLY. THE CONTRACTOR IS
RESPONSIBLE FOR THE PROTECTION
OF ALL UTILITIES. THE ENGINEER BEARS NO RESPONSIBILITY FOR UTILITIES NOT
SHOWN OR SHOWN INCORRECTLY.

Call BEFORE YOU Dig
1-800-227-2600
UNDERGROUND SERVICE (USA)

REVISION

NO.	DATE	BY	APPROVED	REVISION
1	8-22-96	KD		ADDED RETAINING WALL ALONG ACCESS ROAD
2	8-20-96	KD		ADDED DRAINAGE EASEMENTS ALONG PER FLOOR CONTOUR
3	8-21-96	KD		ADDED DRAINAGE EASEMENT EXHIBIT
4	9-26-96	KD		TRAFFIC - PARKING ADJUSTMENT 1 (WITH 3' COMPACT SPACES)
5	3-27-97	ED		Modified Plan to City of Las Vegas Fire Department Request

SUBMITTED BY:

ALPHA & ENGINEERING COMPANY
90 S. Jones Blvd., Las Vegas, NV 89107
Telephone: (702) 877-1300

PROJECT: LAKE SAHARA DRIVE ASSISTED CARE

TITLE: GRADING PLAN

JOB NO.: 610504


NAME: TJD

DATE: 3/7/97

SCALE: 1"=30'

PAGE: 2

OF: 5

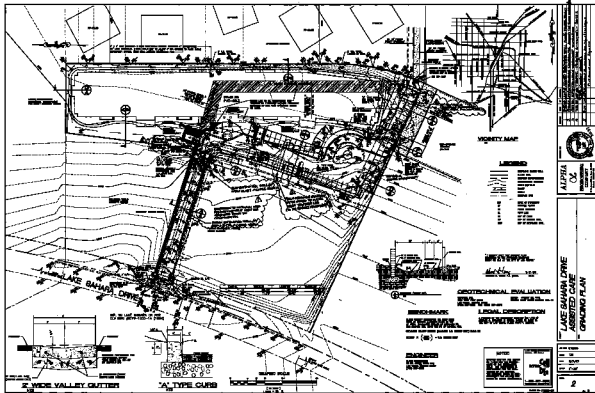

ALPHA & OMEGA ENGINEERING COMPANY


 BY: [Signature]
 FOR: [Signature]

VOID