



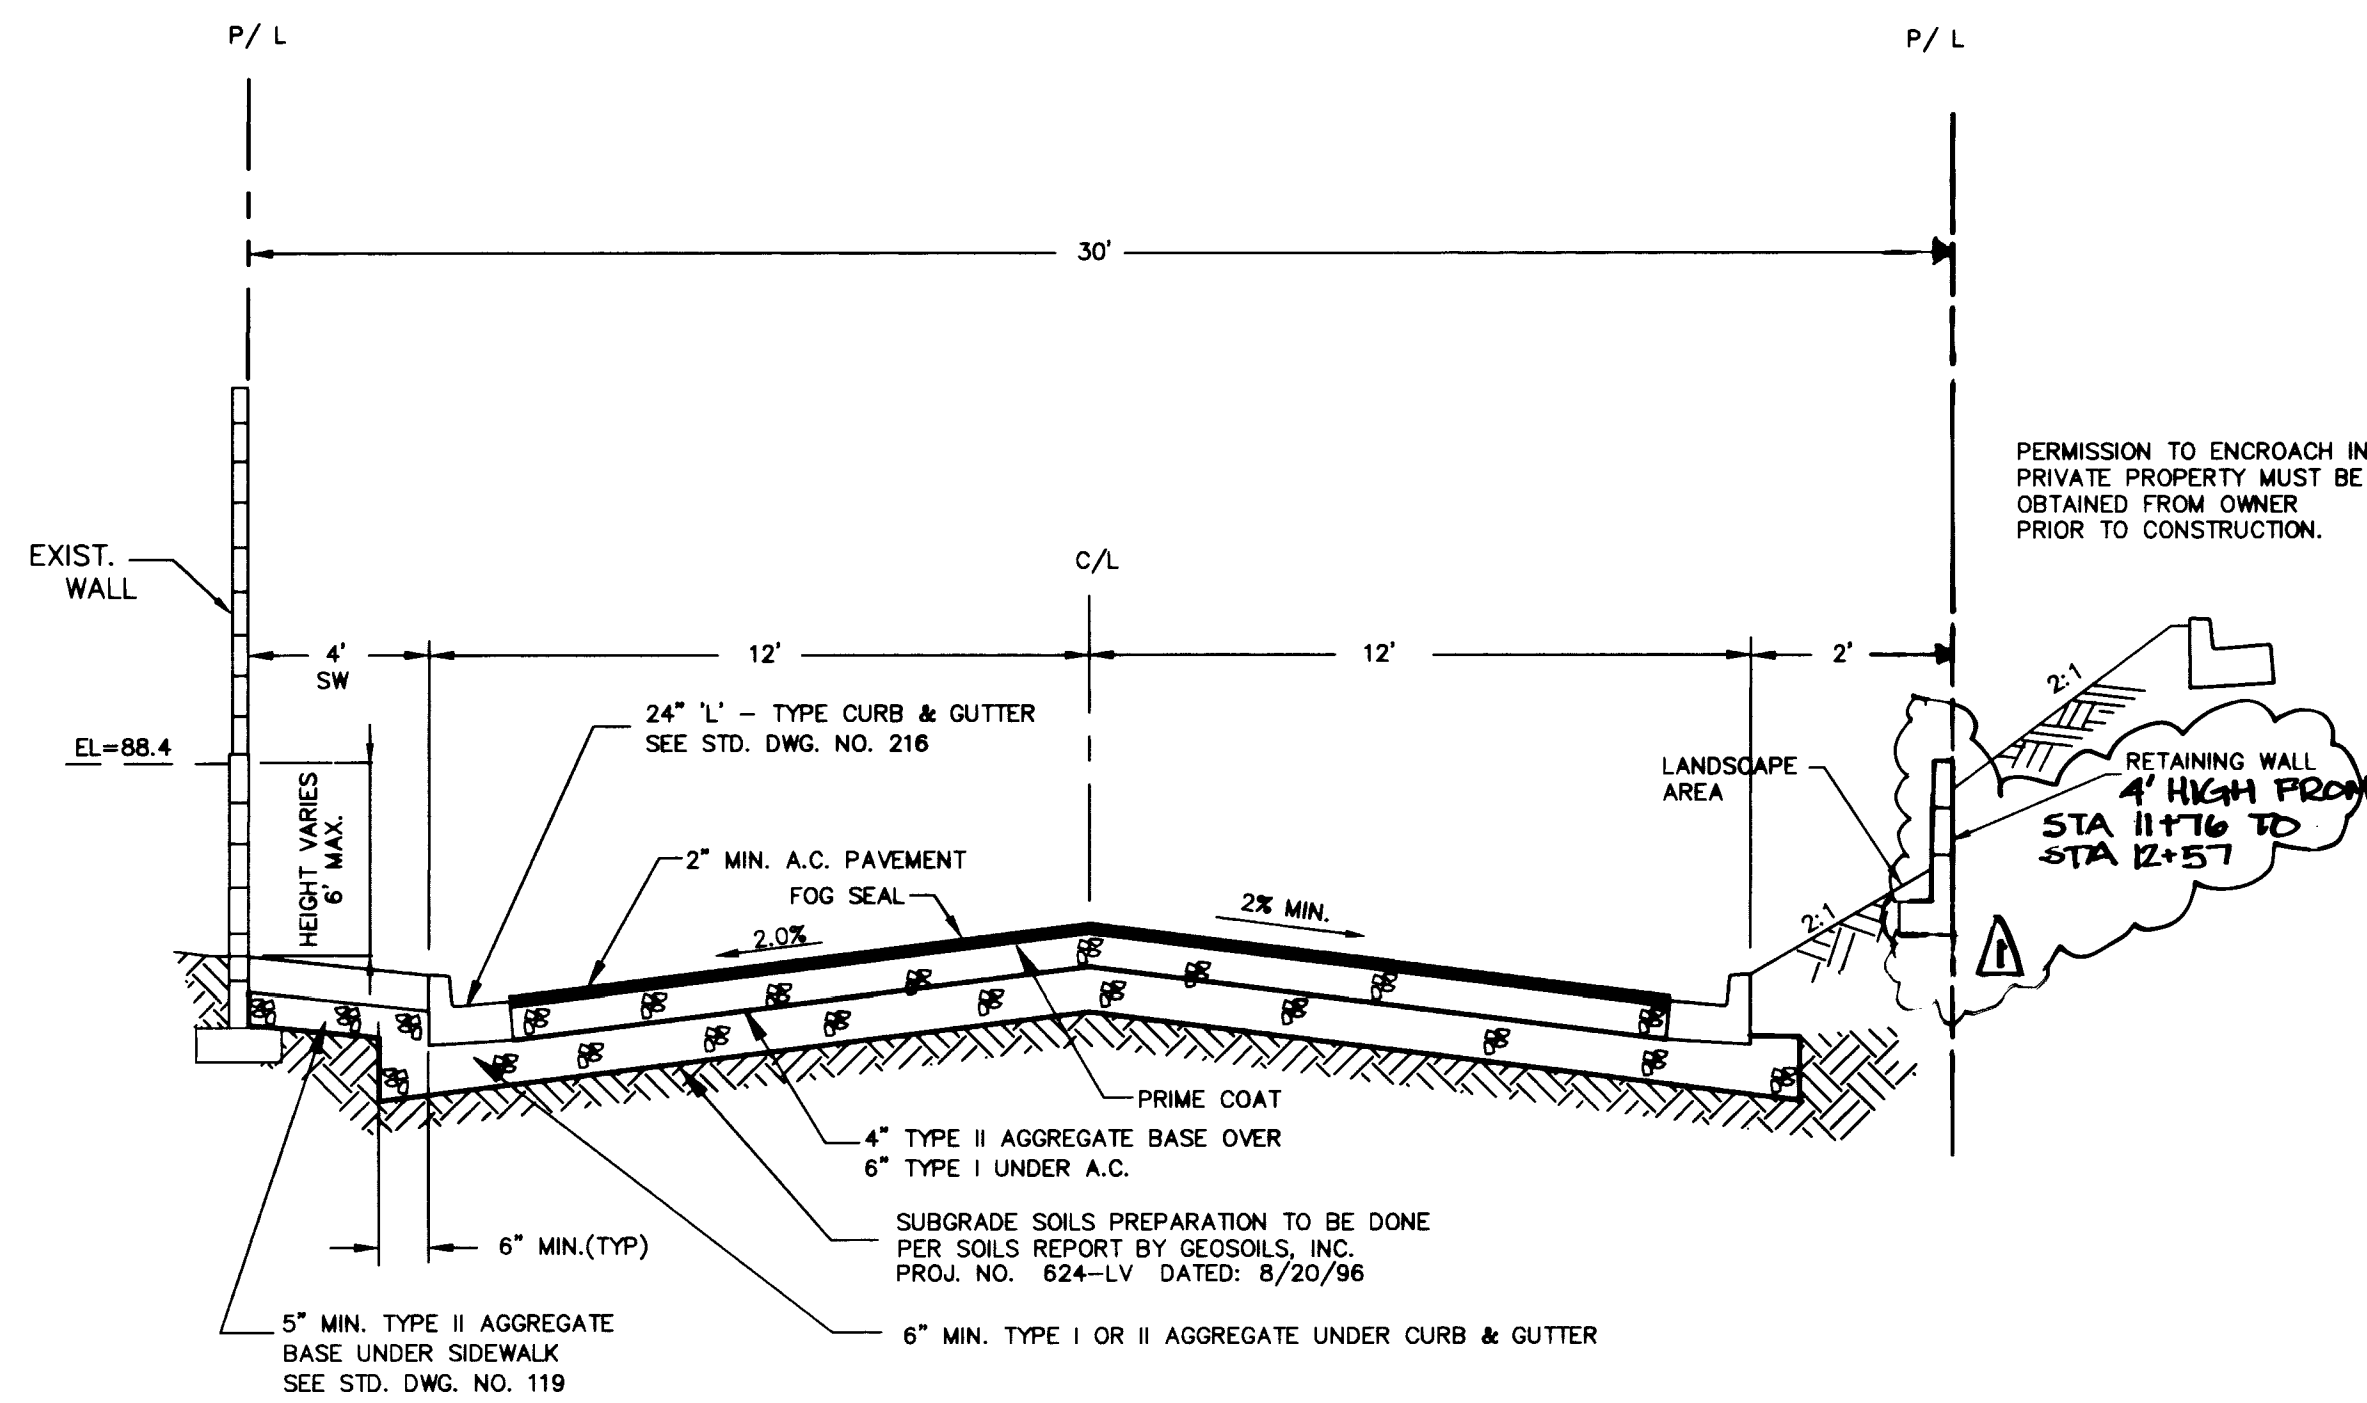


- NOTES:
1. FINAL A.C. PAVEMENT SURFACE SHALL BE 1/2" ABOVE LIP OF GUTTER.
 2. THE GRADE BREAK OCCURRING IN THE CROSS SECTION SHALL FALL BETWEEN THE DRIVING LANES.
 3. STRUCTURAL SECTION SHOWN IS BASED ON A SUBGRADE "R" VALUE OF 20. OTHER STRUCTURAL SECTIONS MAY BE REQUIRED BASED ON ENGINEERING ANALYSIS OF "R" OR "CBR" VALUES DETERMINED BY SOIL TESTING.


A STREET SECTION (ENTRY DWY)
NTS

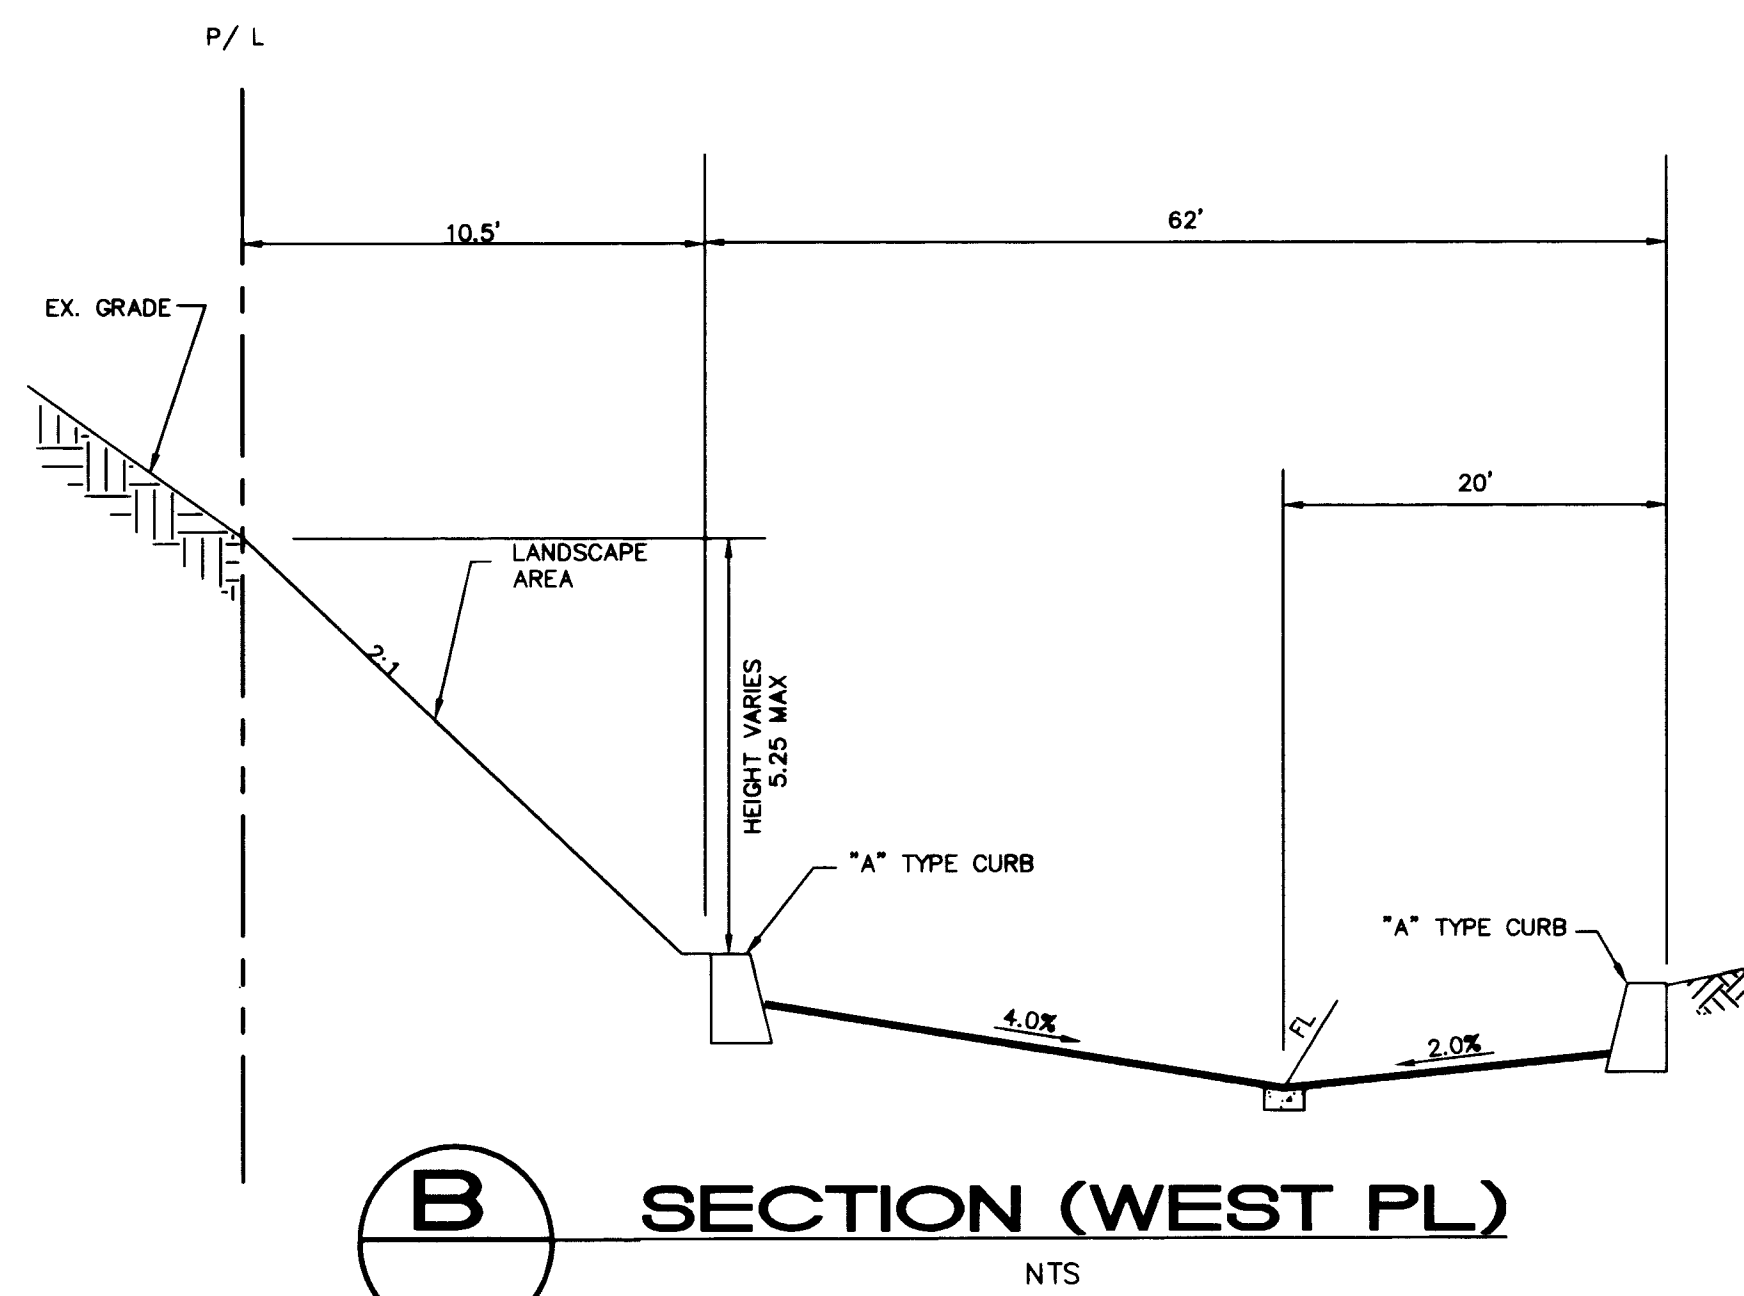


B SECTION (WEST PL)
NTS

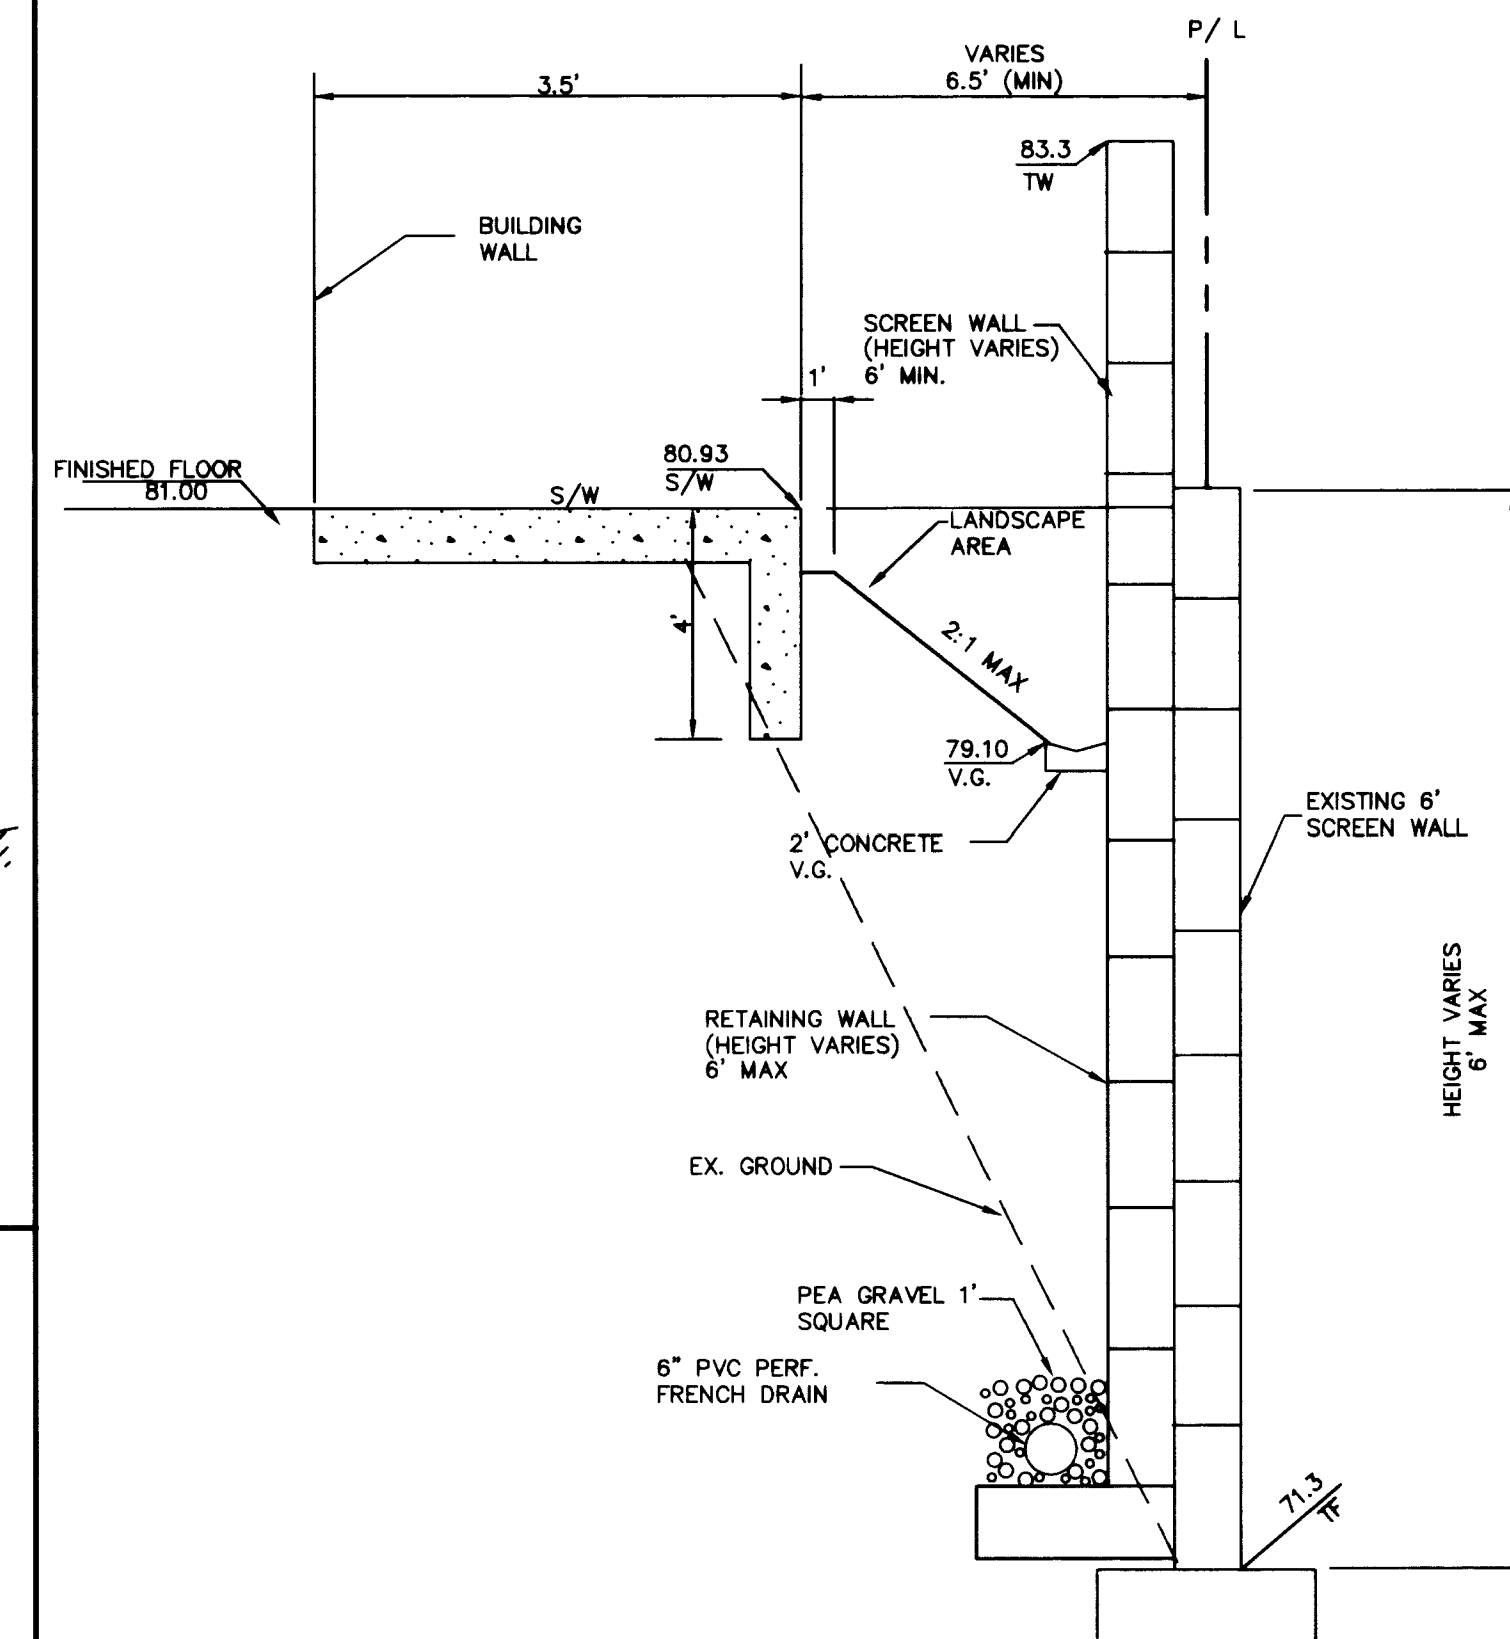


C SECTION (EAST PL)
NTS

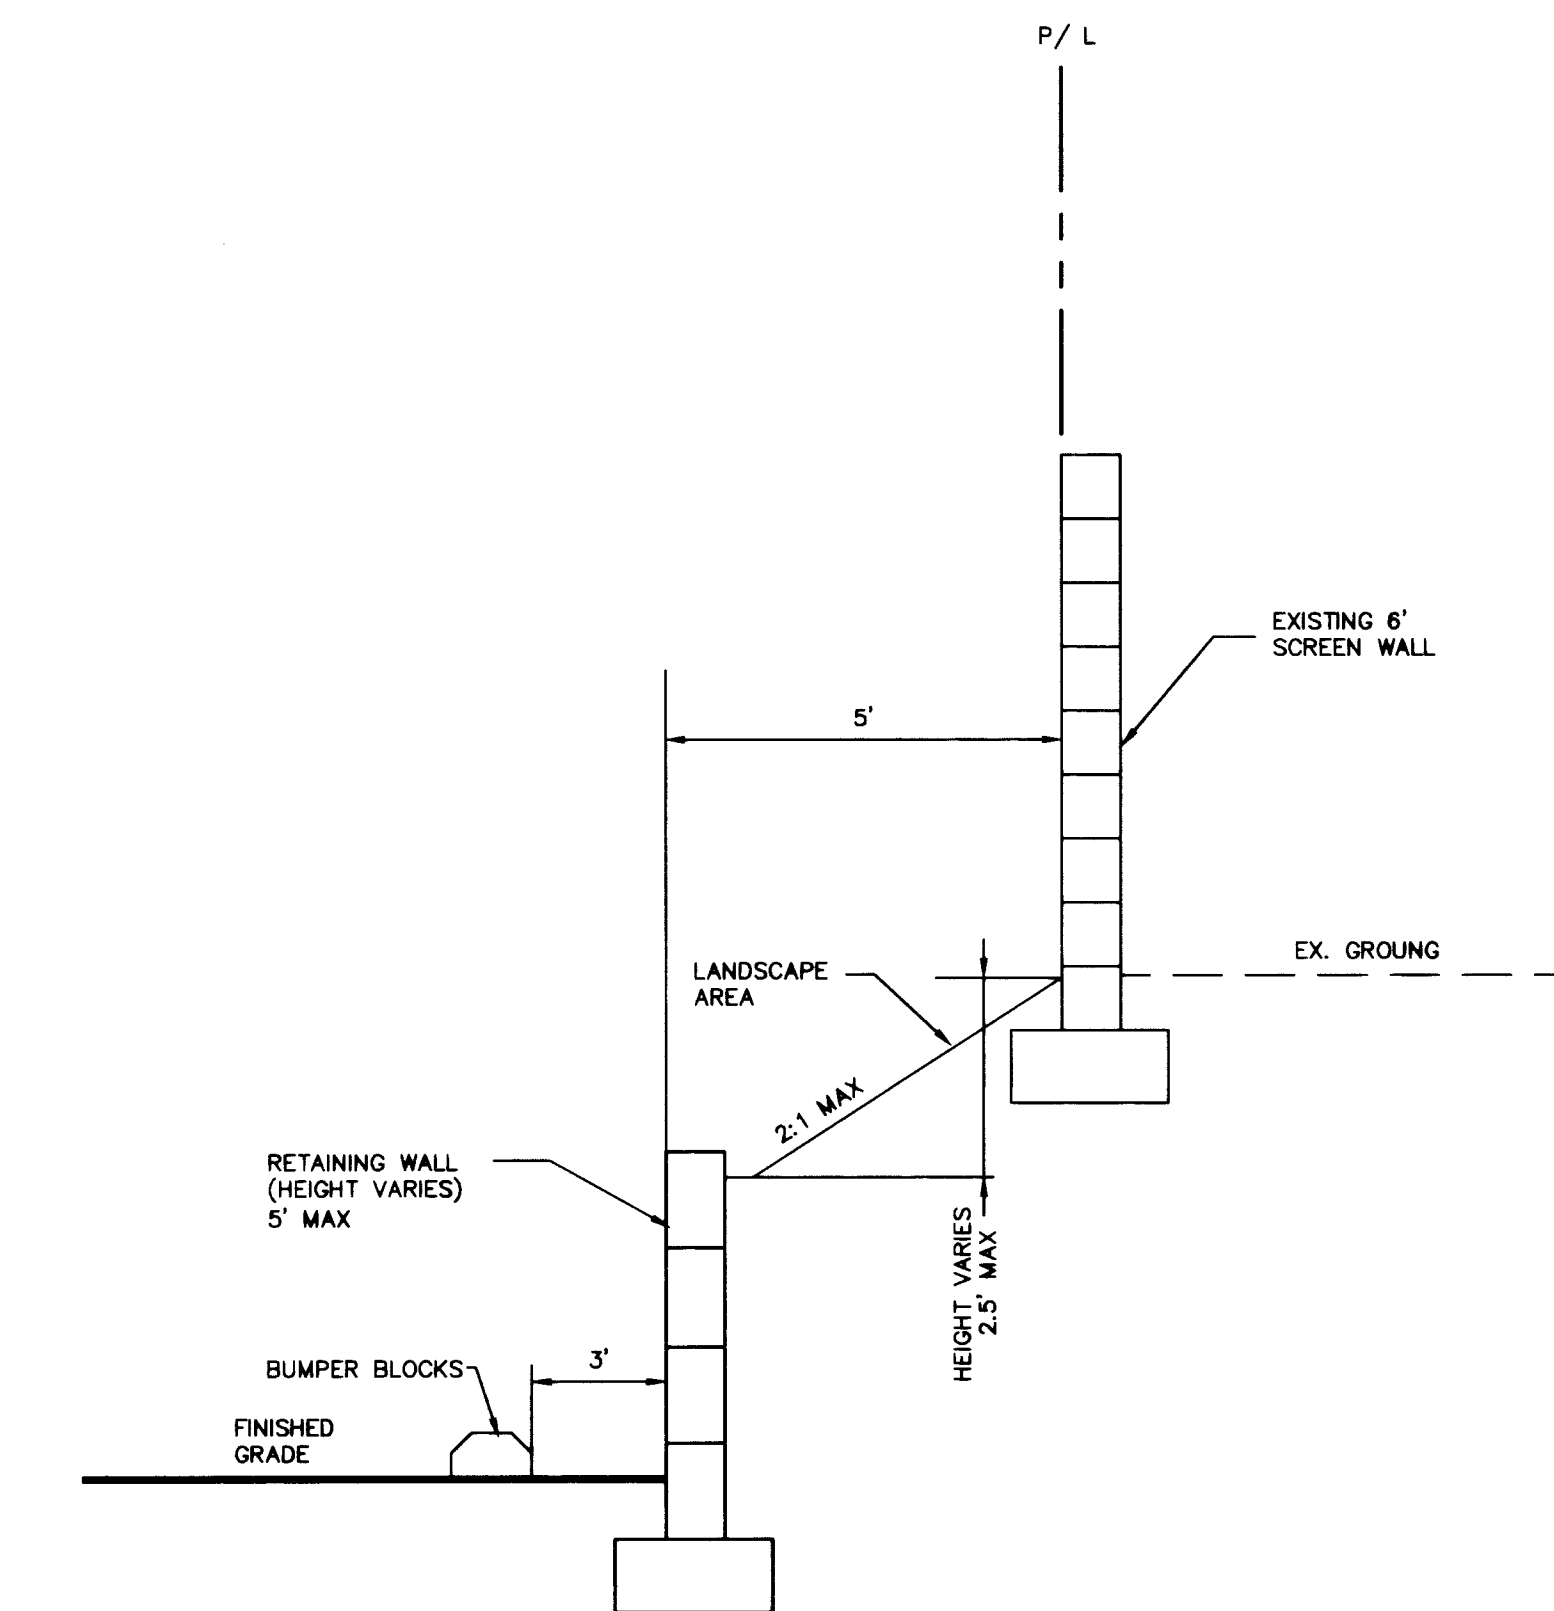


D SECTION (SOUTH PL)
NTS

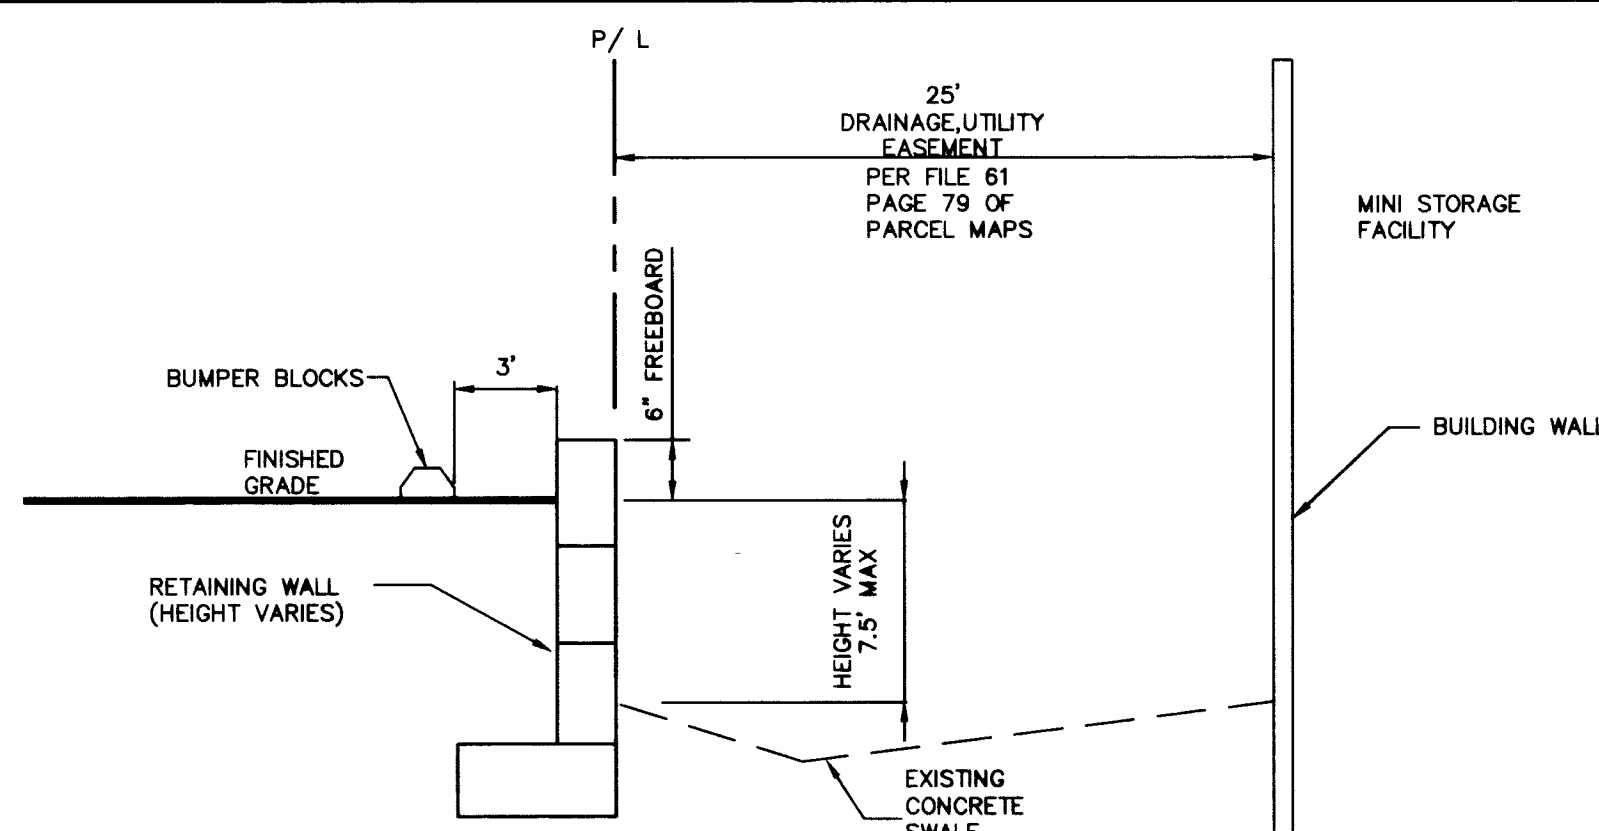

E SECTION (SOUTH PL)
NTS

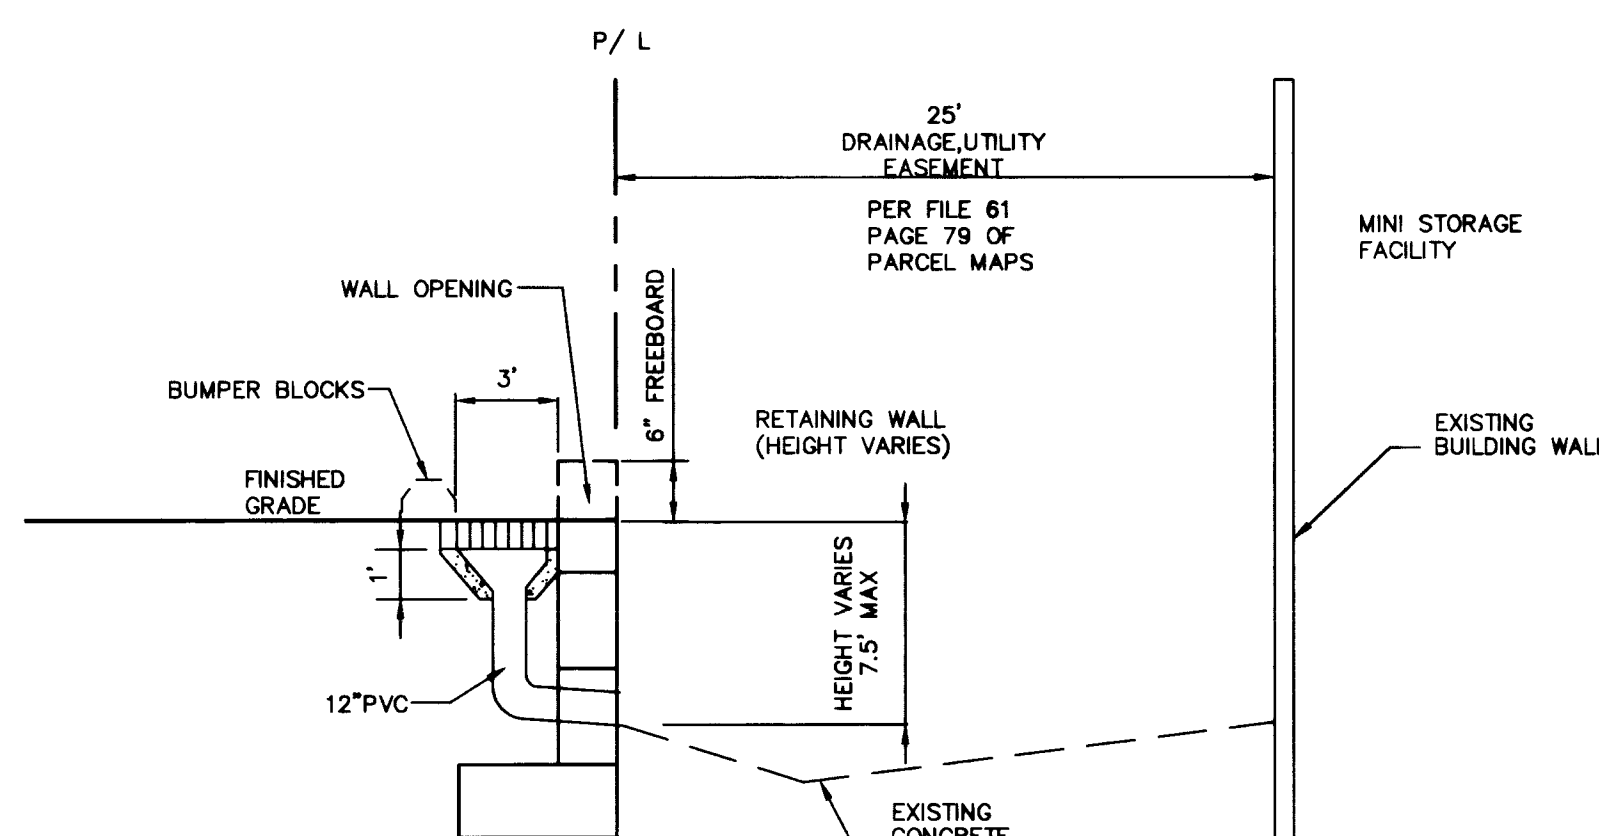

F SECTION (SOUTH PL)
NTS

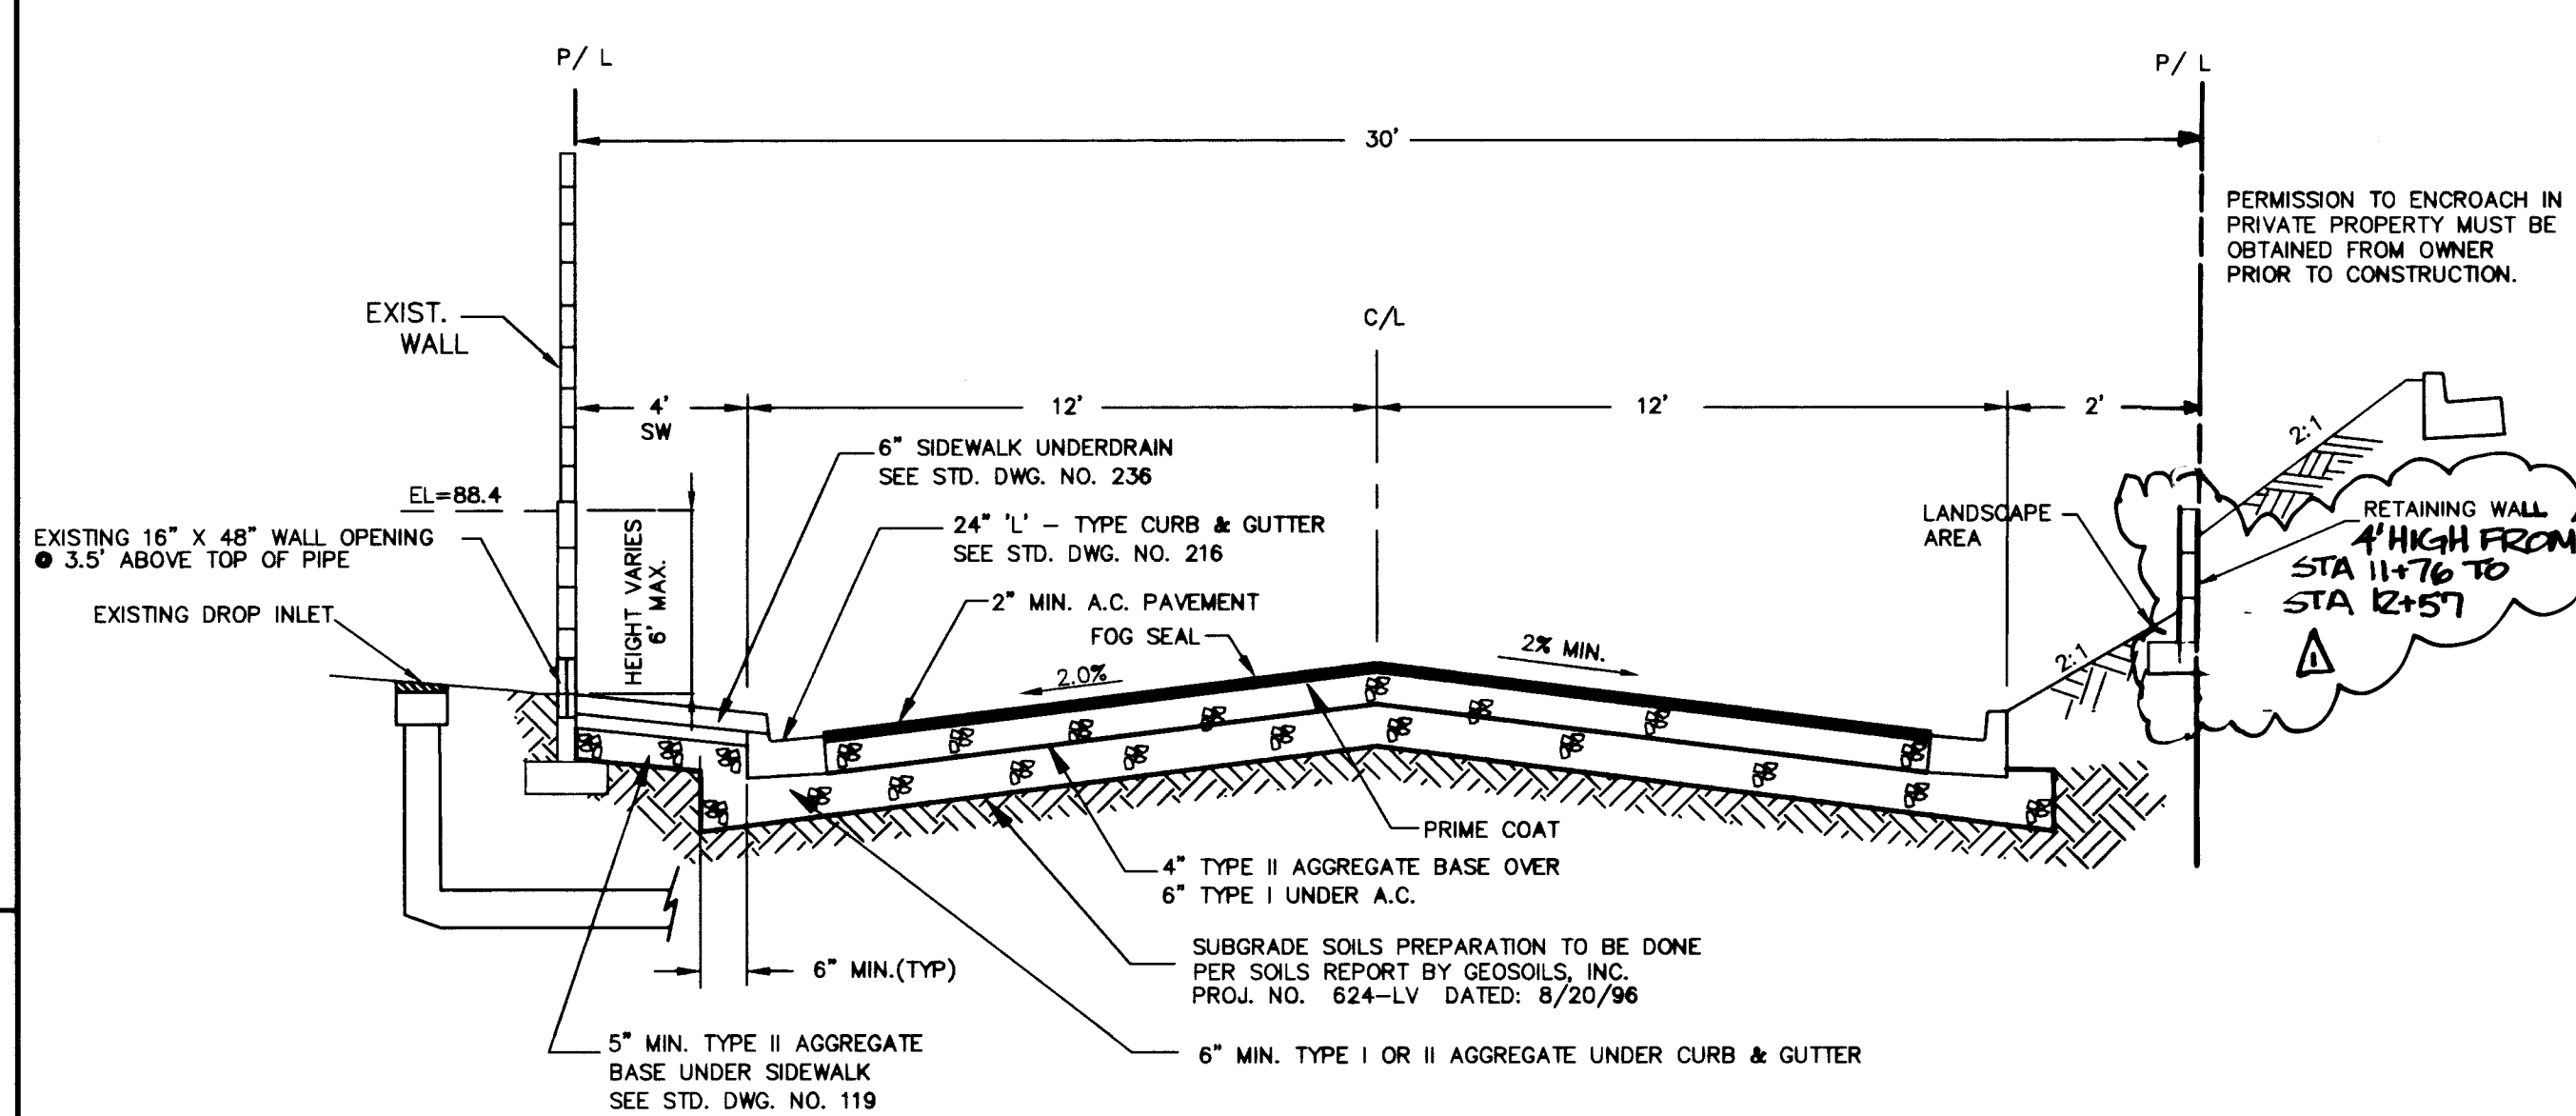


- NOTES:
1. FINAL A.C. PAVEMENT SURFACE SHALL BE 1/2" ABOVE LIP OF GUTTER.
 2. THE GRADE BREAK OCCURRING IN THE CROSS SECTION SHALL FALL BETWEEN THE DRIVING LANES.
 3. STRUCTURAL SECTION SHOWN IS BASED ON A SUBGRADE "R" VALUE OF 20. OTHER STRUCTURAL SECTIONS MAY BE REQUIRED BASED ON ENGINEERING ANALYSIS OF "R" OR "CBR" VALUES DETERMINED BY SOIL TESTING.


H STREET SECTION (ENTRY DWY)
NTS

PROJECT	LAKE SAHARA DRIVE ASSISTED CARE DETAIL SHEET		
JOB NO.	610504		
NAME	TJD		
DATE	3/10/97		
SCALE	N/A		
PAGE	4		


107-V2690

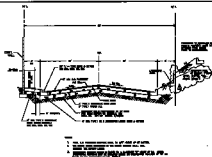


A STREET SECTION (ENTRY DRIVE)

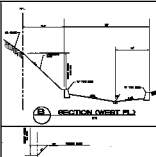


B SECTION (WEST PL.)

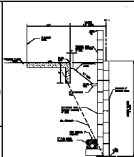


C SECTION (EAST PL.)

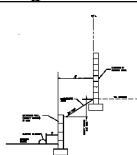


D SECTION (SOUTH PL.)

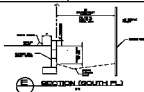

E SECTION (SOUTH PL.)

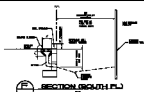

F SECTION (SOUTH PL.)

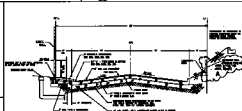

H STREET SECTION (ENTRY DRIVE)






4