


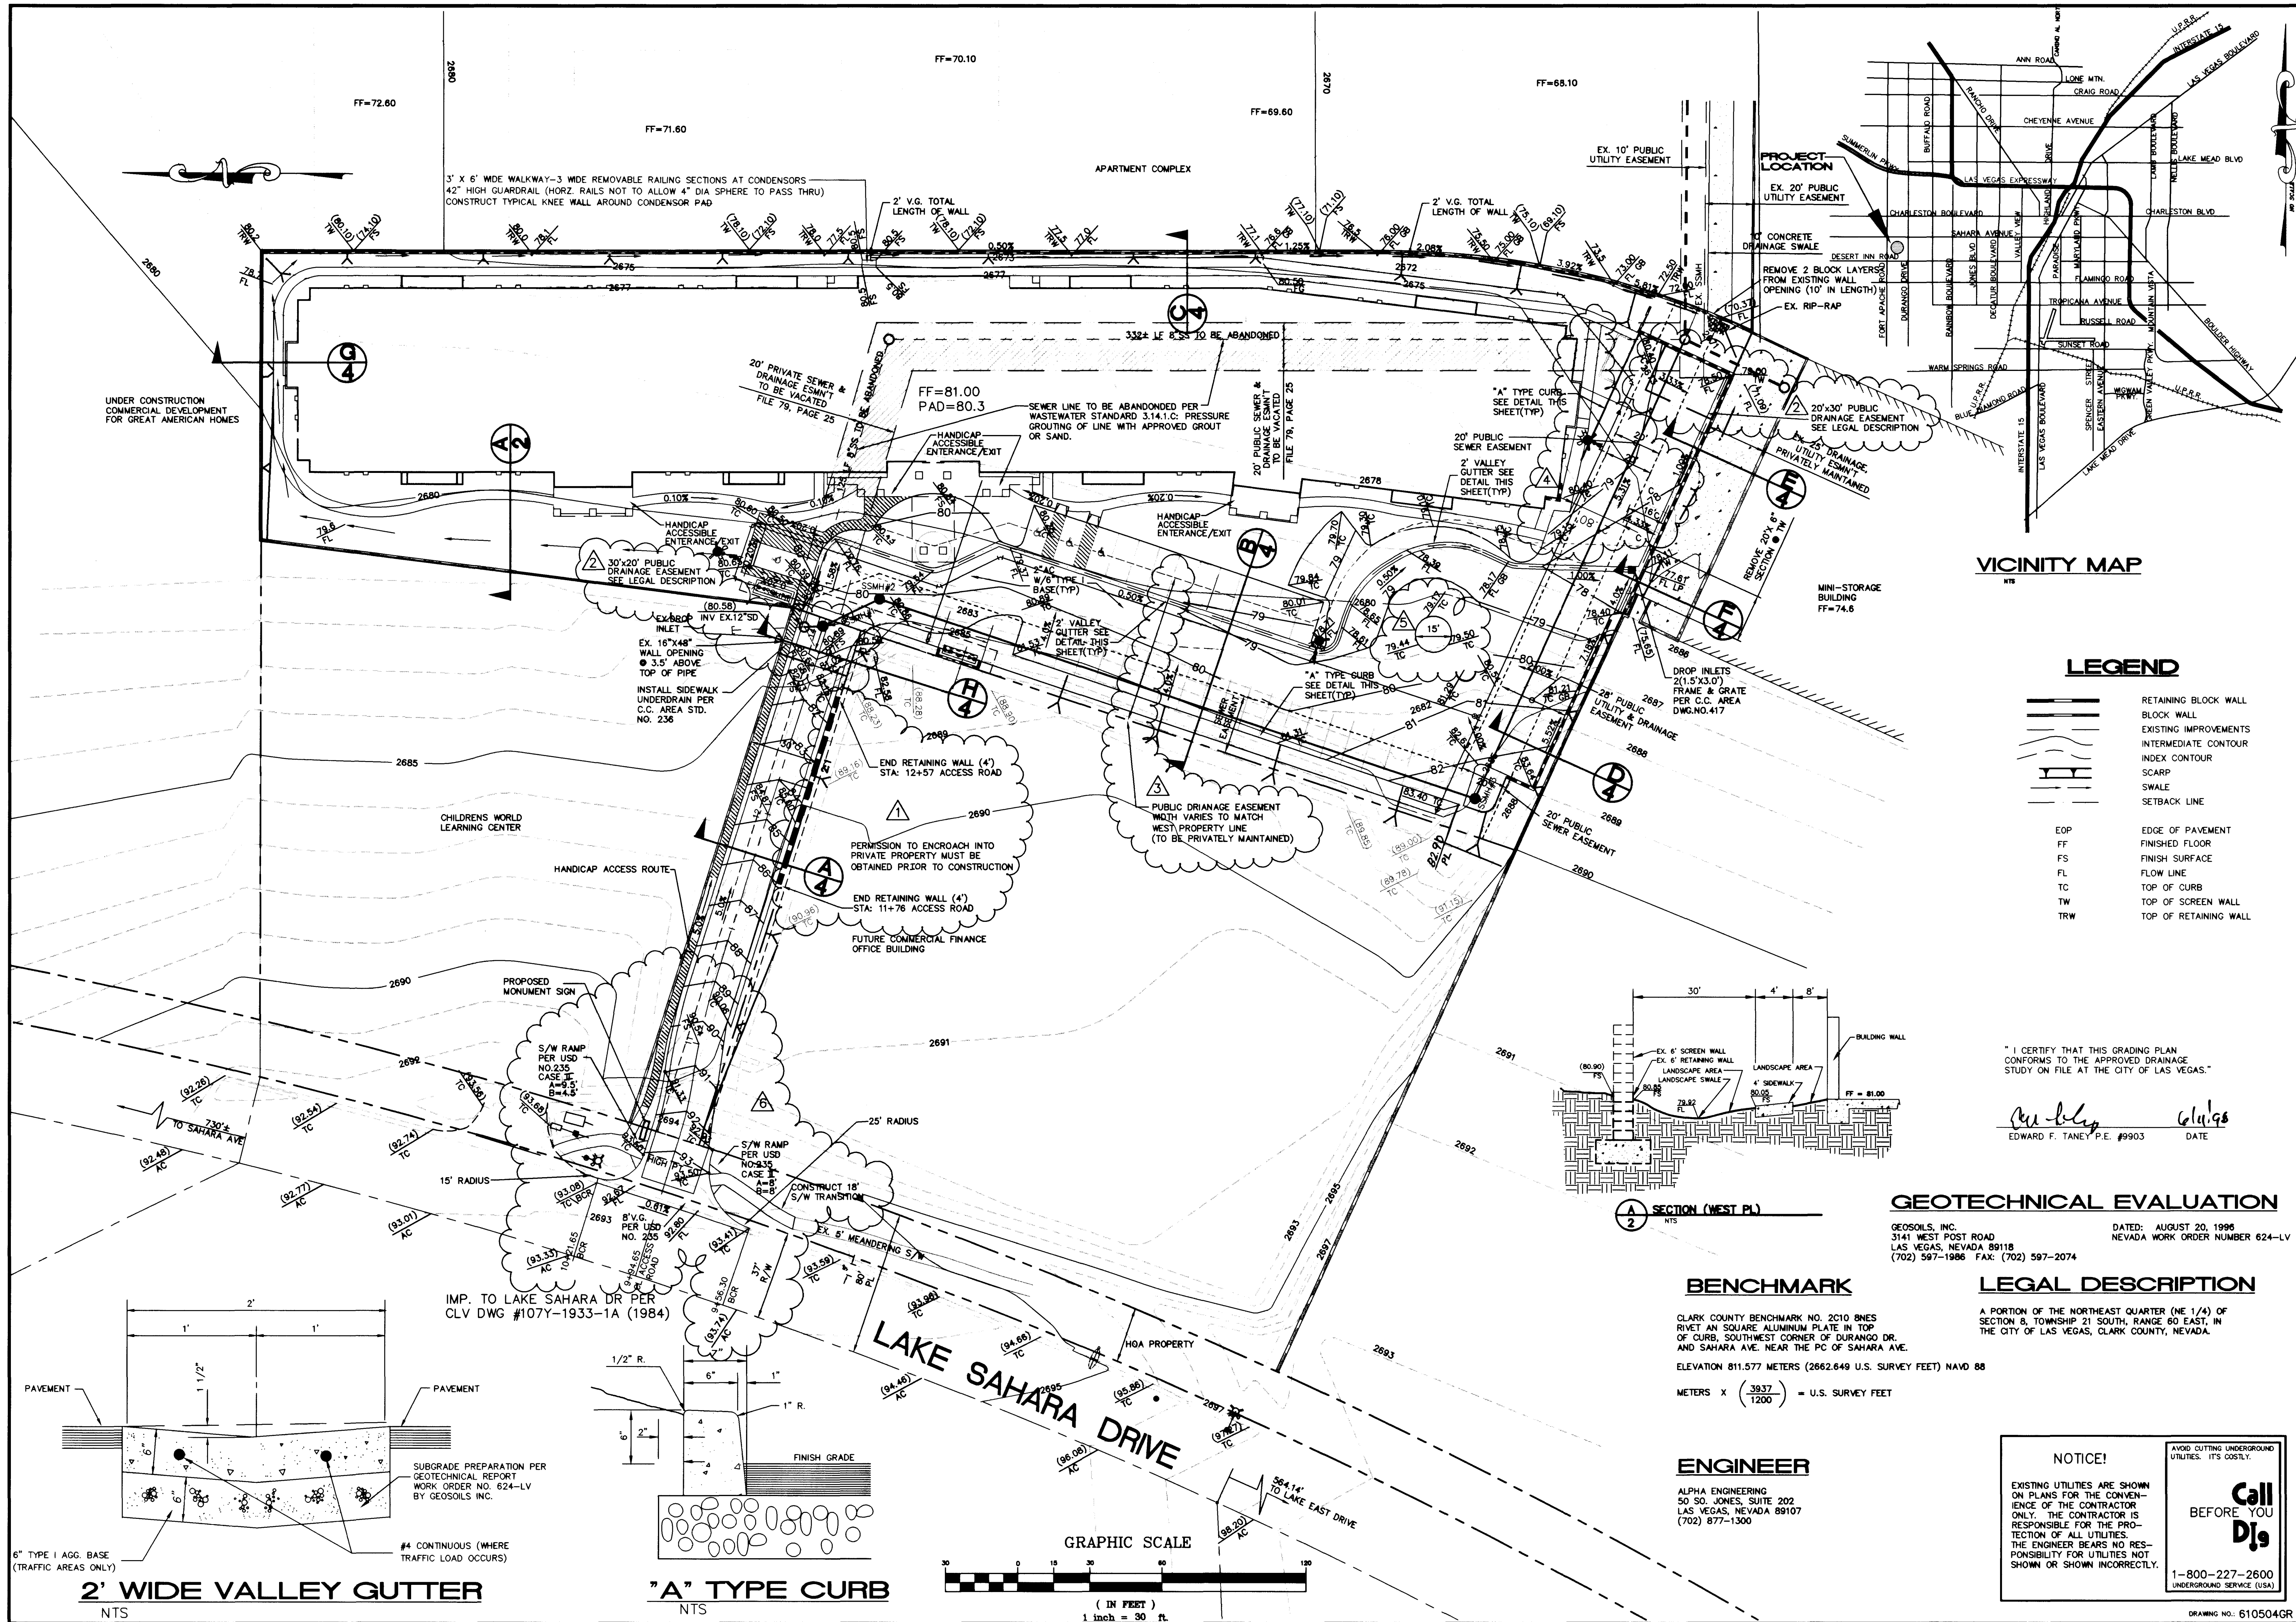

DATE	8/20	BY	KCP	APPROVED	ADDED RETAINING WALL ALONG ACCESS ROAD
REVISION	8/20	RC	KCP		DRAINAGE EASEMENTS ADDED PER FLOOD CONTROL (CLV)
	8/27	RC	KCP		DRAINAGE EASEMENT EXPANDED
	9/26	RC	KCP		TRAFFIC PARKING ADJUSTMENT (WITH 3 COMPACT SPACES)
	3/27	RC	KCP		MODIFIED PLANTER SIZE PER CITY OF LAS VEGAS
	5/7	SFC	KCP		FIRE DEPARTMENT REQUEST
					ADJUST DRIVEWAY ENTRANCE TO CREATE SPACE FOR MONUMENT SIGN

SUBMITTED BY:

ALPHA ENGINEERING COMPANY

LAKE SAHARA DRIVE
ASSISTED CARE
GRADING PLAN

JOB NO.: 610504
NAME: TJD
DATE: 3/7/97
SCALE: 1"=30'
PAGE: 2
OF: 5

Revised 107-V2690

