

NOTE
 SEE SHEET 2 FOR EXISTING POINT OF DIVERSION.
 PROPOSED POINT OF DIVERSION ON THIS APPLICATION ALSO COVERED BY APPLICATION NO'S. 20156 AND 20157.


STATE OF NEVADA } ss
 COUNTY OF CLARK }

I, WARREN L. JAUBERT, BEING FIRST DULY SWORN, DEPOSE AND SAY THAT THIS MAP, CONSISTING OF 2 SHEETS HAS BEEN CORRECTLY DRAWN TO THE DESIGNATED SCALE FROM FIELD NOTES OF A SURVEY MADE UNDER MY SUPERVISION AND DIRECTION BETWEEN THE 28TH DAY OF SEPTEMBER AND THE 15TH DAY OF OCTOBER, 1970; THAT IT TRULY AND CORRECTLY REPRESENTS THE LOCATION AND EXTENT OF WORKS USED TO DIVERT WATER FROM THE LAS VEGAS VALLEY WATER BASIN IN CLARK COUNTY BY THE CITY OF LAS VEGAS, NEVADA FOR RECREATION PURPOSES. THAT THE POINTS OF DIVERSION ARE FULLY AND CORRECTLY SHOWN HEREON.


Warren L. Jaubert
 STATE WATER RIGHTS SURVEYOR, NO. 526

SUBSCRIBED AND SWORN TO BEFORE ME THIS 26TH DAY OF APRIL, 1972

Frederic L. McDonald
 NOTARY PUBLIC IN AND FOR CLARK COUNTY, NEVADA
 MY COMMISSION EXPIRES FEB. 4, 1976

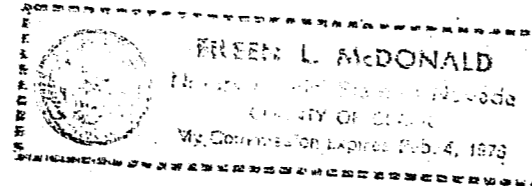

BASIS OF BEARING
 THE EAST LINE OF THE NE 1/4 OF SEC. 25, T. 20S., R. 60E., M.D.P. & M. AS SHOWN BY PLAT OF GOLF RIDGE TERRACE UNIT NO. 7-E., BOOK 6, PAGE 74, CLARK COUNTY NEVADA RECORDS. BEARING N00° 41' 40" W.

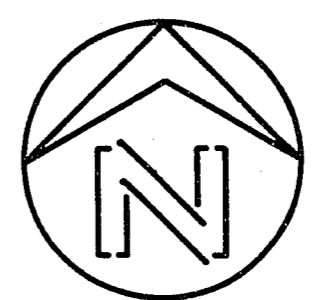

SCALE
 1" = 200'

MAD TO ACCOMPANY APPLICATION FOR CHANGE IN POINT OF DIVERSION, MANNER OF USE AND PLACE OF USE FOR RECREATION BY THE CITY OF LAS VEGAS, NEV. FROM THE LAS VEGAS VALLEY WATER BASIN