BOOK _____ NO. _____

LEWIS HOMES — CHARLESTON UNIT NO. 3 ℄ TIE SHEET

BEING A SUBDIVISION WITHIN A PORTION OF THE N.W. 1/4 OF SEC. 35, T.20S., R.60E., M.D.M. CITY OF LAS VEGAS, CLARK COUNTY, NEVADA

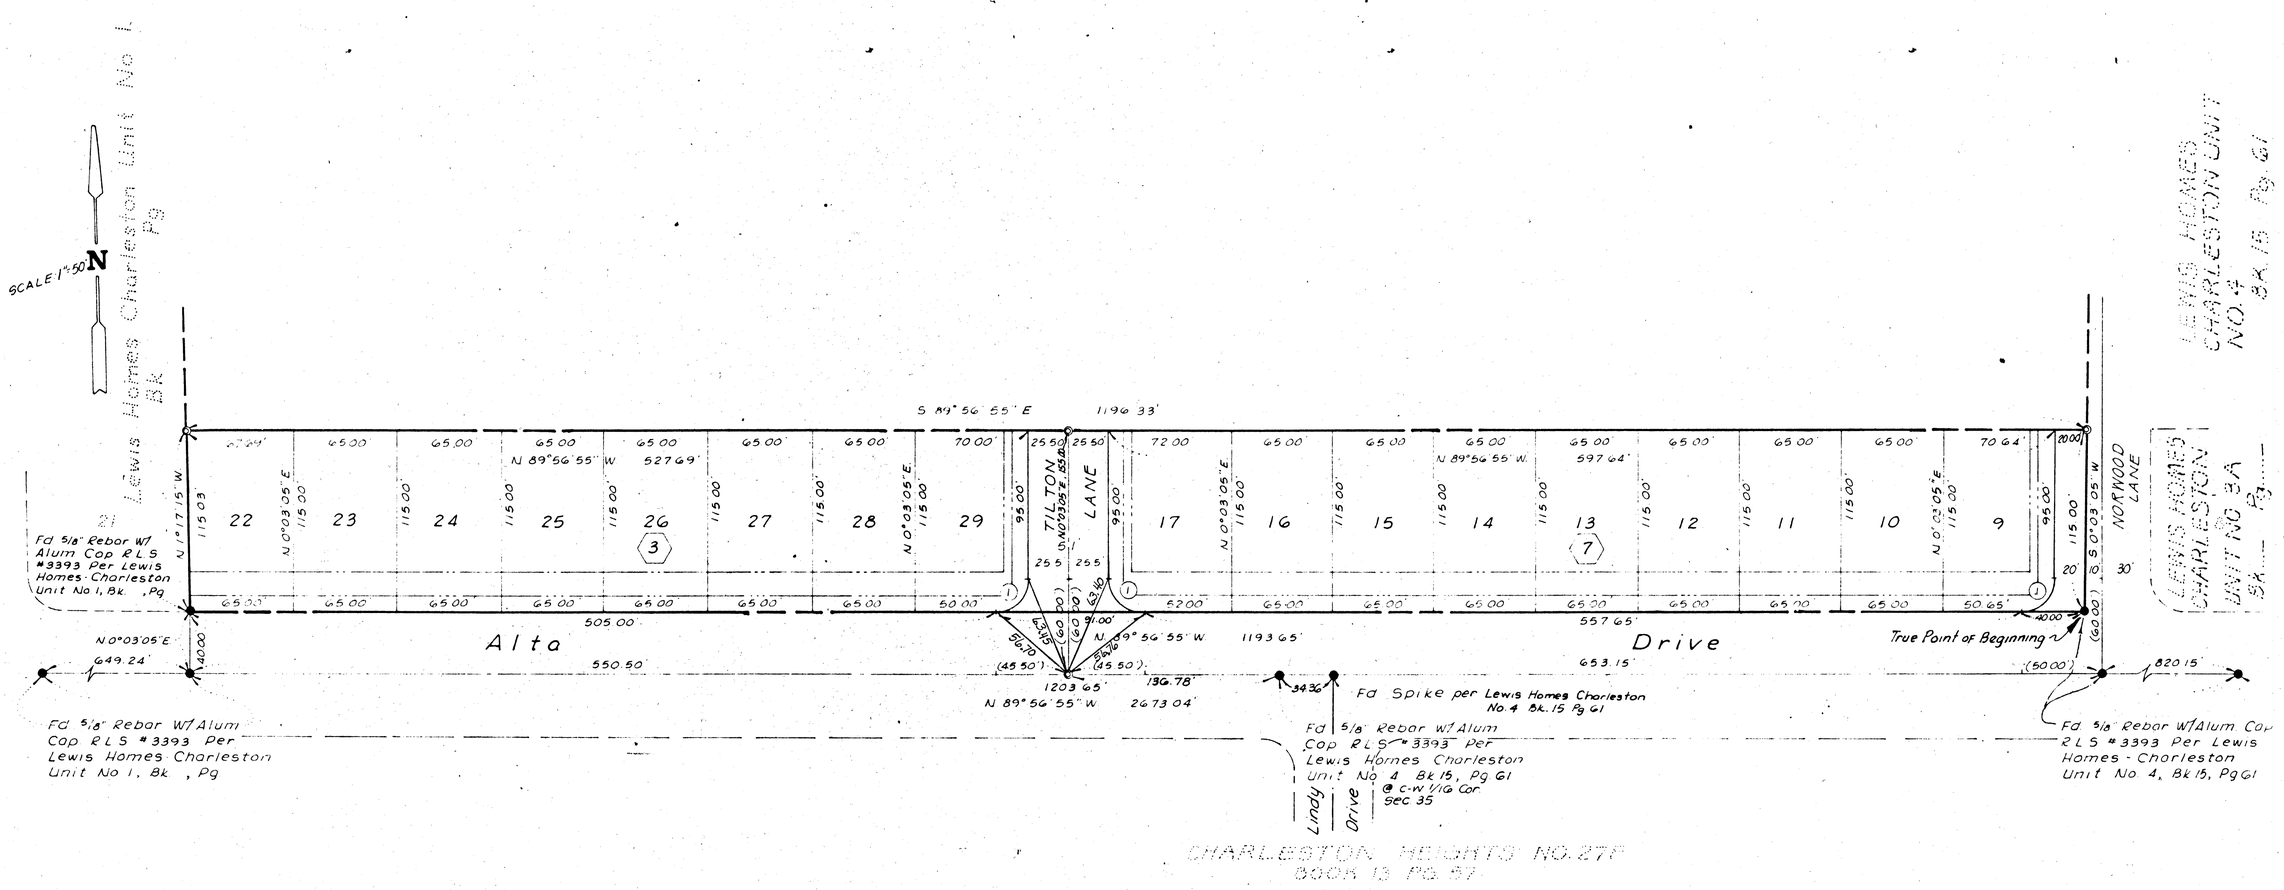

Curve Data					
No	Δ	R	T	C	L
1	90°00'00"	20.00'	20.00	28.28'	31.42'

Legend

- ● Point Found As Shown
- ⊙ Set 5/8" Rebar W/ Alum Cap Stamped R.L.S #3393
- 7 Lot Number
- (N8) Block Number
- ——·—— Bldg Setback Line · 25' Front Yard, 15' Side Yard Abutting R/W
- ——··—— 5' Utility Easement In Back Of And Abutting All R/W Lines (SHOWN NOT TO SCALE)
- (1) Curve Data Number

Note

3' Utility Easement On Each Side Of Each Side Lot Line Not Abutting R/W.

1. Concrete nails at curb returns
2. + in top of curb at Front ℄'s
3. All ties are to nails in top of curb

℄ TIE SHEET

FOR REFERENCE ONLY

5-6-156

SHEET 2 OF 4

058-2026-3