


# AMENDED PLAT OF LEWIS HOMES - CHARLESTON UNIT NO. 5 @ Tie Sheet

BEING A SUBDIVISION WITHIN A PORTION OF  
THE N.W. 1/4 OF SEC. 35, T.20S., R.60E., M.D.M.  
CITY OF LAS VEGAS, CLARK COUNTY, NEVADA

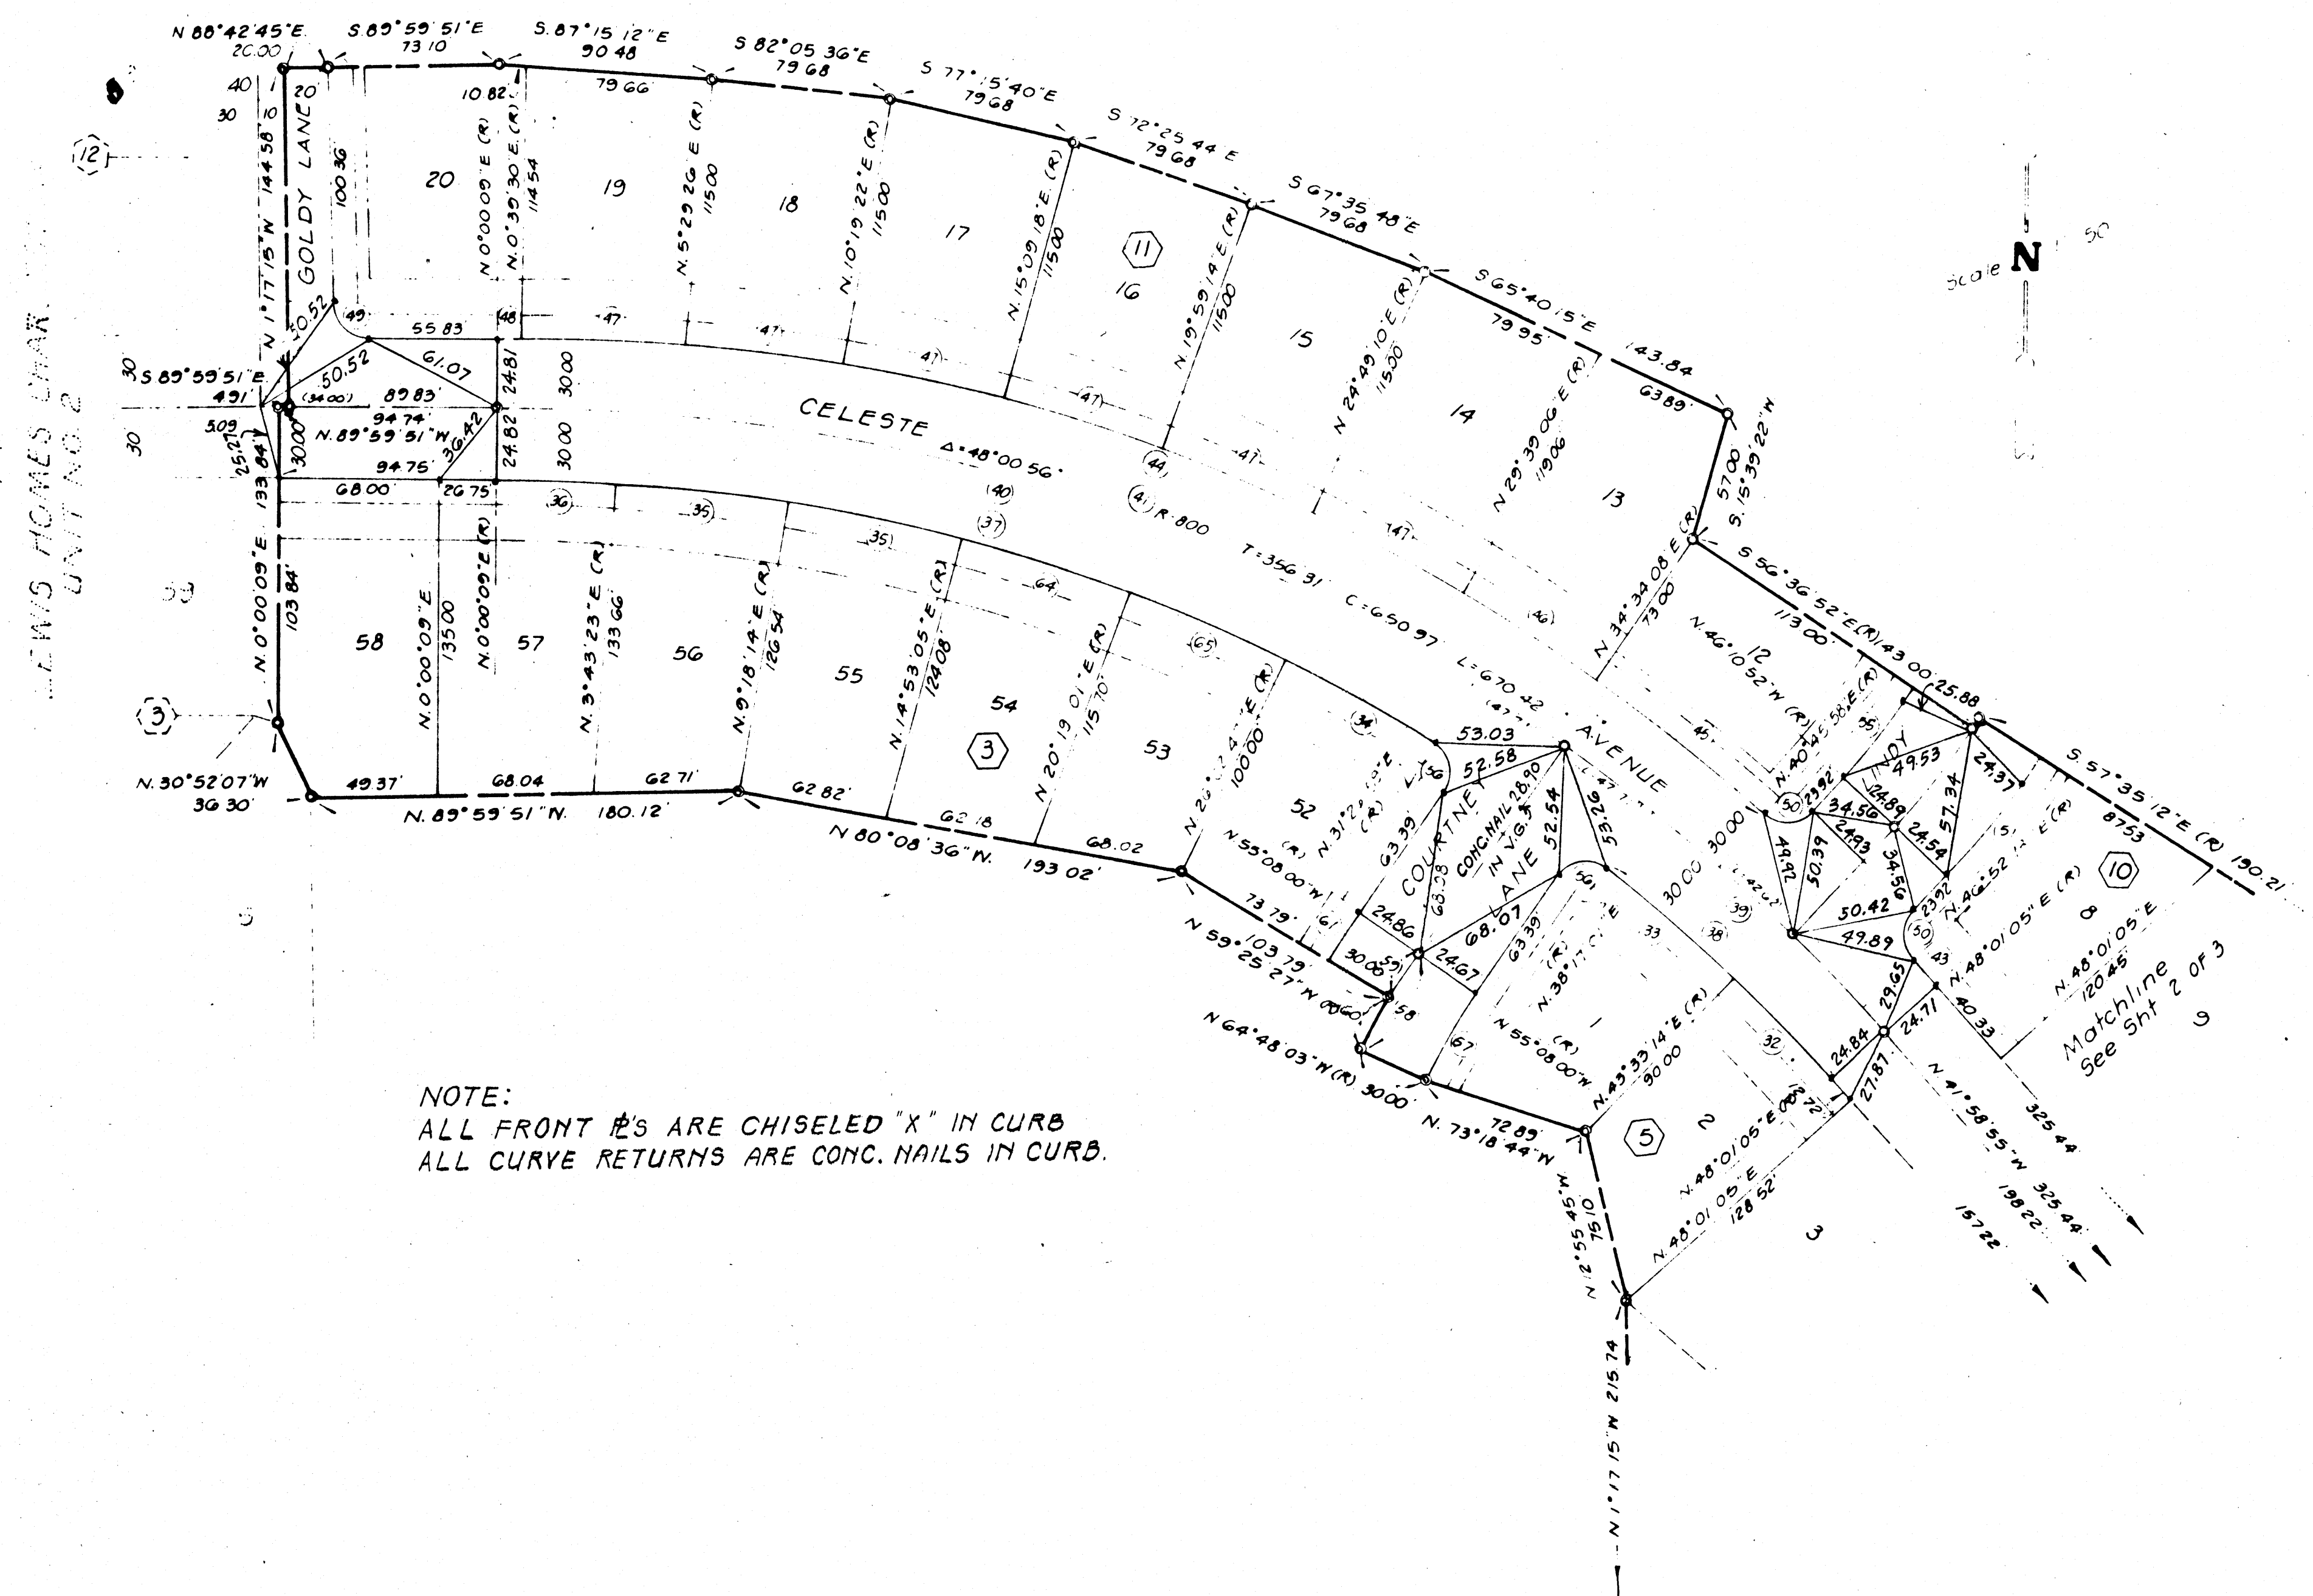


NOTE:  
ALL FRONT R'S ARE CHISELED "X" IN CURB  
ALL CURVE RETURNS ARE CONC. NAILS IN CURB.

FOR SURVEY USE ONLY

AMENDED PLAT OF  
LEWIS HOMES - CHARLESTON UNIT NO. 5 of Tie Sheet

BEING A SUBDIVISION WITHIN A PORTION OF  
THE N.W. 1/4 OF SEC. 35, T.20S., R.80E., M.D.M.  
CITY OF LAS VEGAS, CLARK COUNTY, NEVADA

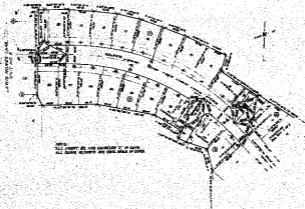

NOTE:  

FOR SURVEY USE ONLY