


LEWIS HOMES — CHARLESTON UNIT NO. 6
 BEING A SUBDIVISION WITHIN A PORTION OF
 THE N.W. 1/4 OF SEC. 35, T.20S., R.60E., M.D.M.
 CITY OF LAS VEGAS, CLARK COUNTY, NEVADA

NO	DELTA	RADIUS	TANGENT	CHORD	LENGTH
1	90° 00' 00"	15.00	15.00	21.21'	23.56'
2	88° 39' 40"	15.00	14.65'	20.96'	23.21'
4	88° 39' 40"	25.00	24.42'	34.94'	38.69'
5	44° 14' 57"	25.00	10.16'	18.83'	19.31'
6	52° 35' 00"	45.50	22.46'	40.28'	41.73'
7	53° 31' 25"	45.50	22.95'	40.98'	42.50'
8	57° 19' 23"	45.50	24.87'	43.65'	45.52'
9	268° 29' 54"	45.50	∞	—	213.22'
10	36° 52' 12"	25.00	8.33'	15.81'	16.09'
11	26° 31' 31"	25.00	5.89'	11.47'	11.57'
12	17° 40' 16"	70.00	10.88'	21.50'	21.59'
13	40° 48' 10"	70.00	26.03'	48.80'	49.85'
14	40° 39' 26"	70.00	25.93'	48.64'	49.67'
15	52° 55' 31"	70.00	34.84'	62.39'	64.66'
16	152° 03' 23"	70.00	281.34'	135.86'	185.77'

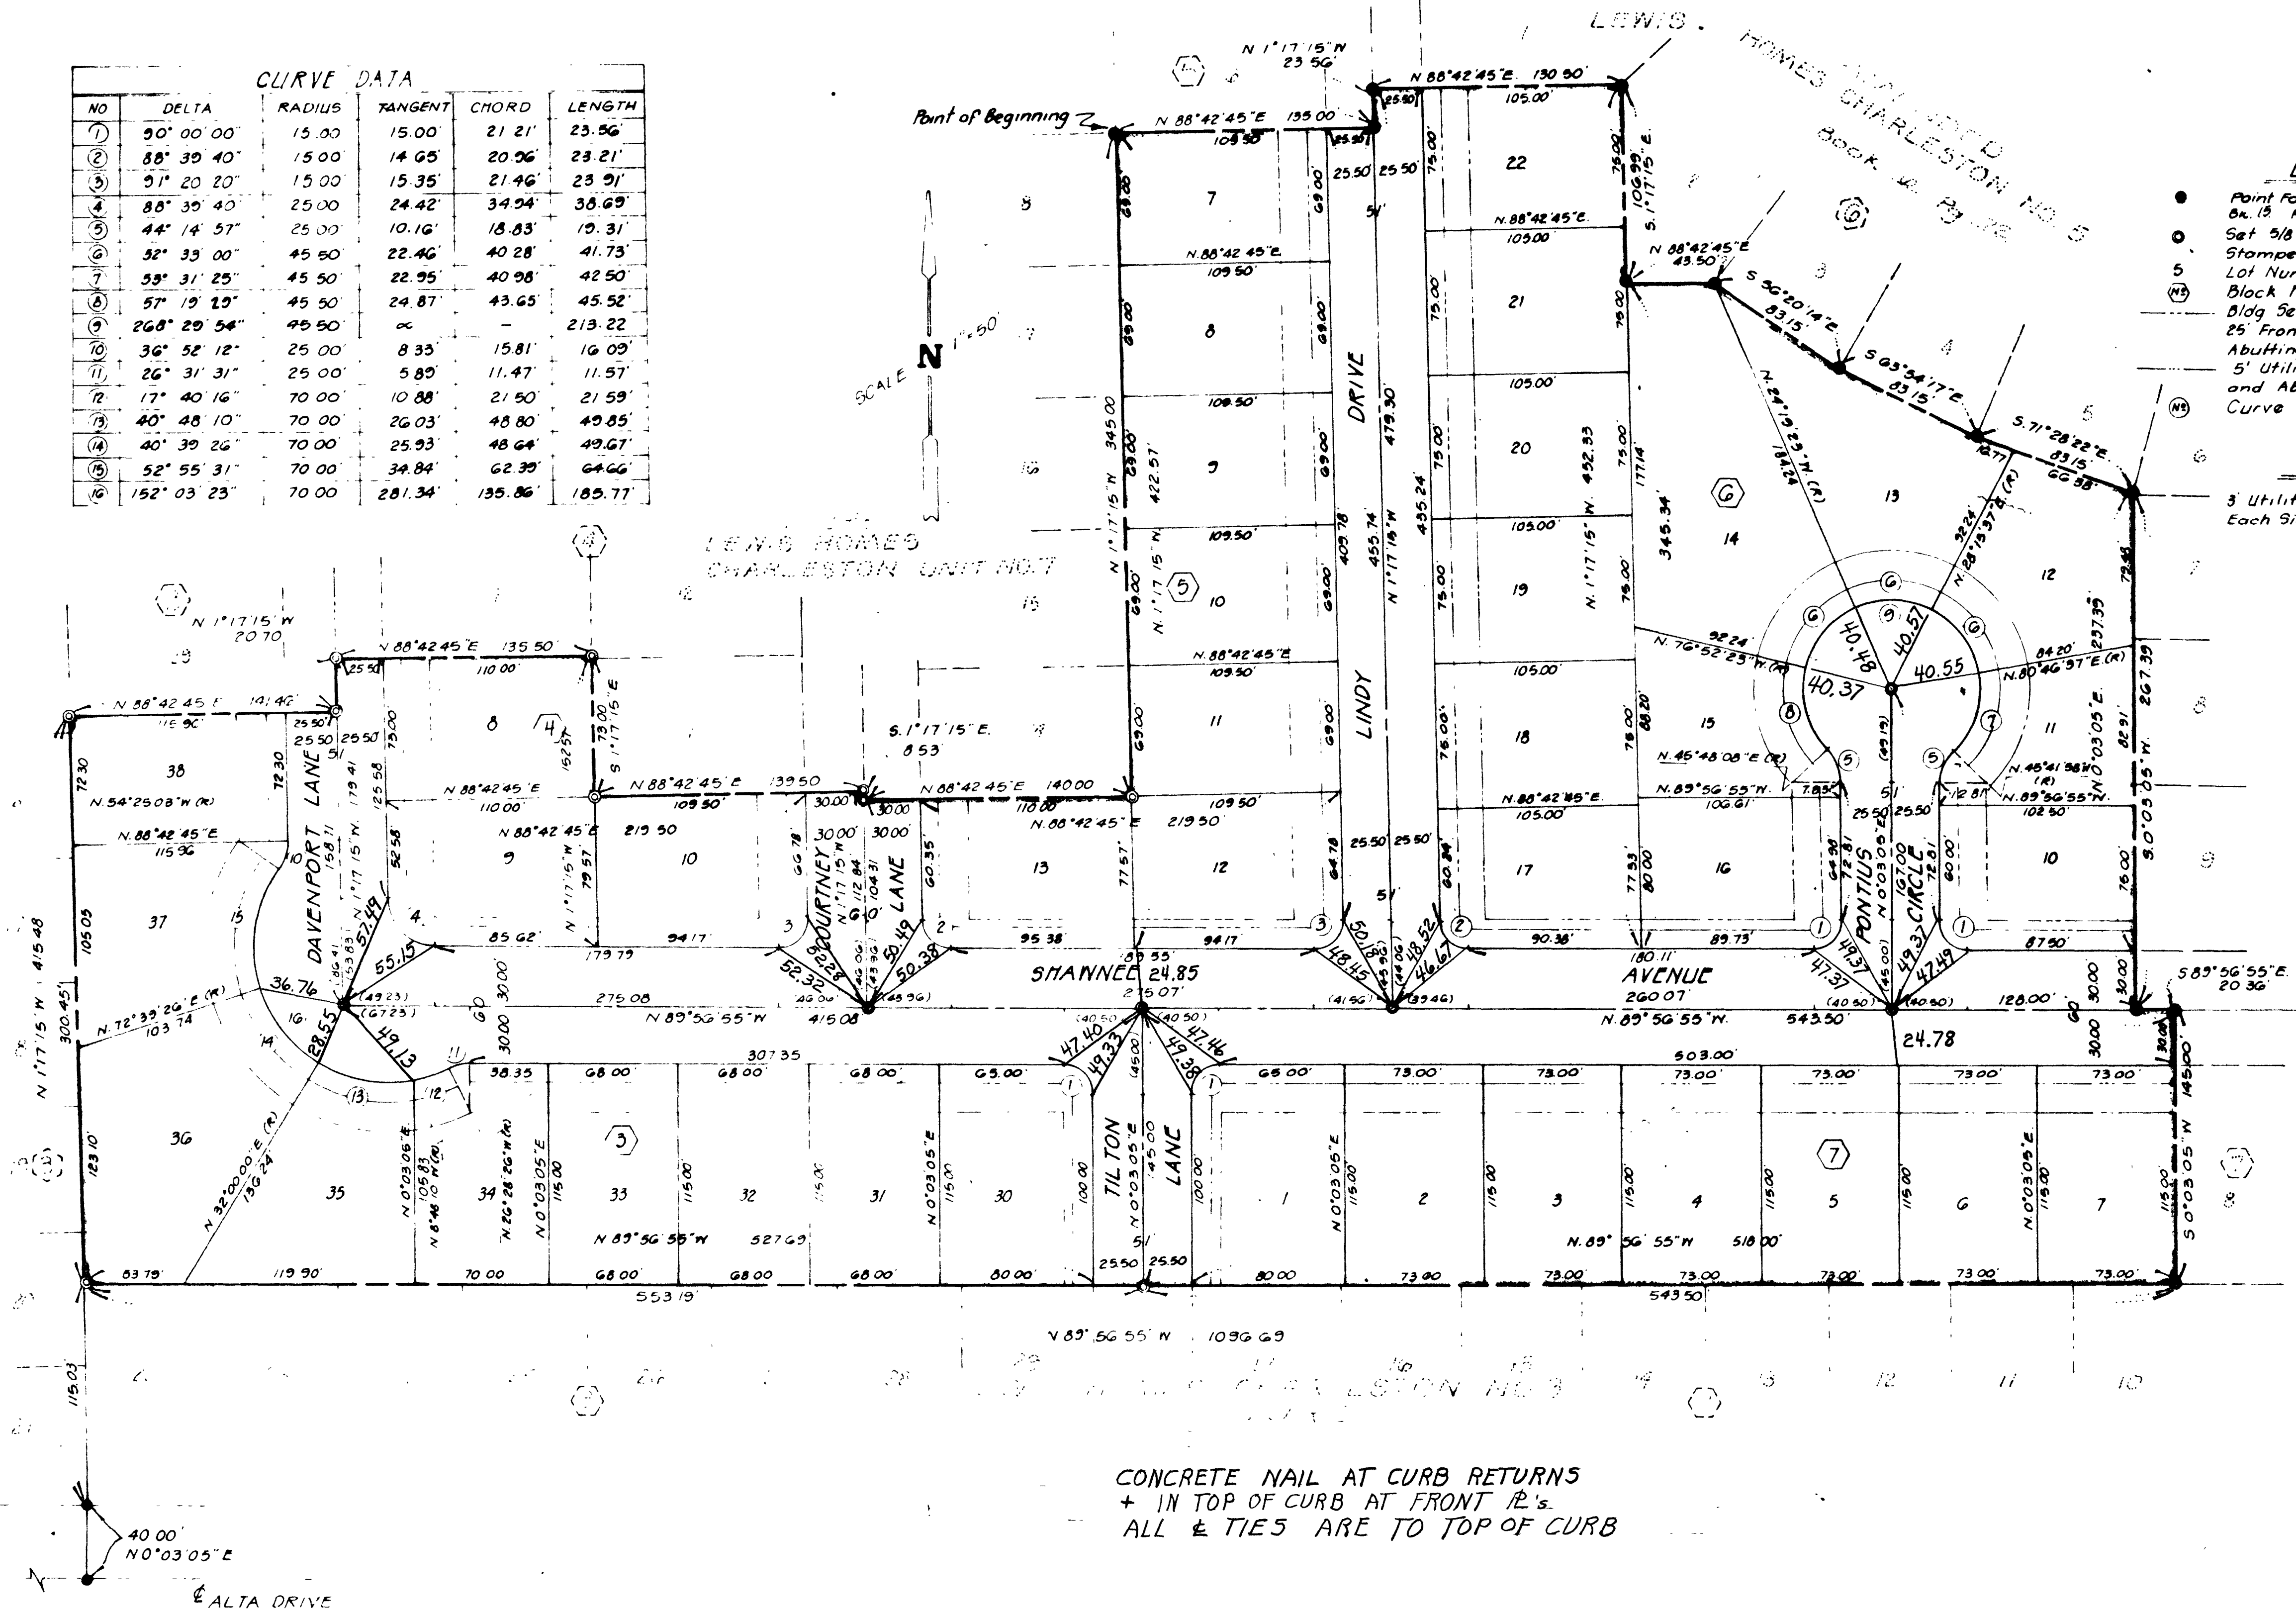

- Legend**
- Point Found per Lewis Homes Charleston Unit No. 1
 - Stamped RLS 3399-3046
 - Lot Number
 - Block Number
 - Bldg Setback Line
 - 25' Front Yard, 15' Side Yard
 - Abutting R/W
 - 5' Utility Easement in Back of and Abutting All R/W Lines (SHOWN NOT TO SCALE)
 - Curve Data Number

NOTES

3' Utility Easement On Each Side of Each Side Lot Line Not Abutting R/W

CONCRETE NAIL AT CURB RETURNS
 + IN TOP OF CURB AT FRONT R.L.'s.
 ALL TIES ARE TO TOP OF CURB

CENTER LINE TIE SHEET

LEWIS HOMES — CHARLESTON UNIT NO. 6

BEING A SUBDIVISION WITHIN A PORTION OF
THE N.W. 1/4 OF SEC 35, T.20S., R.90E., M.D.M.
CITY OF LAS VEGAS, CLARK COUNTY, NEVADA

