
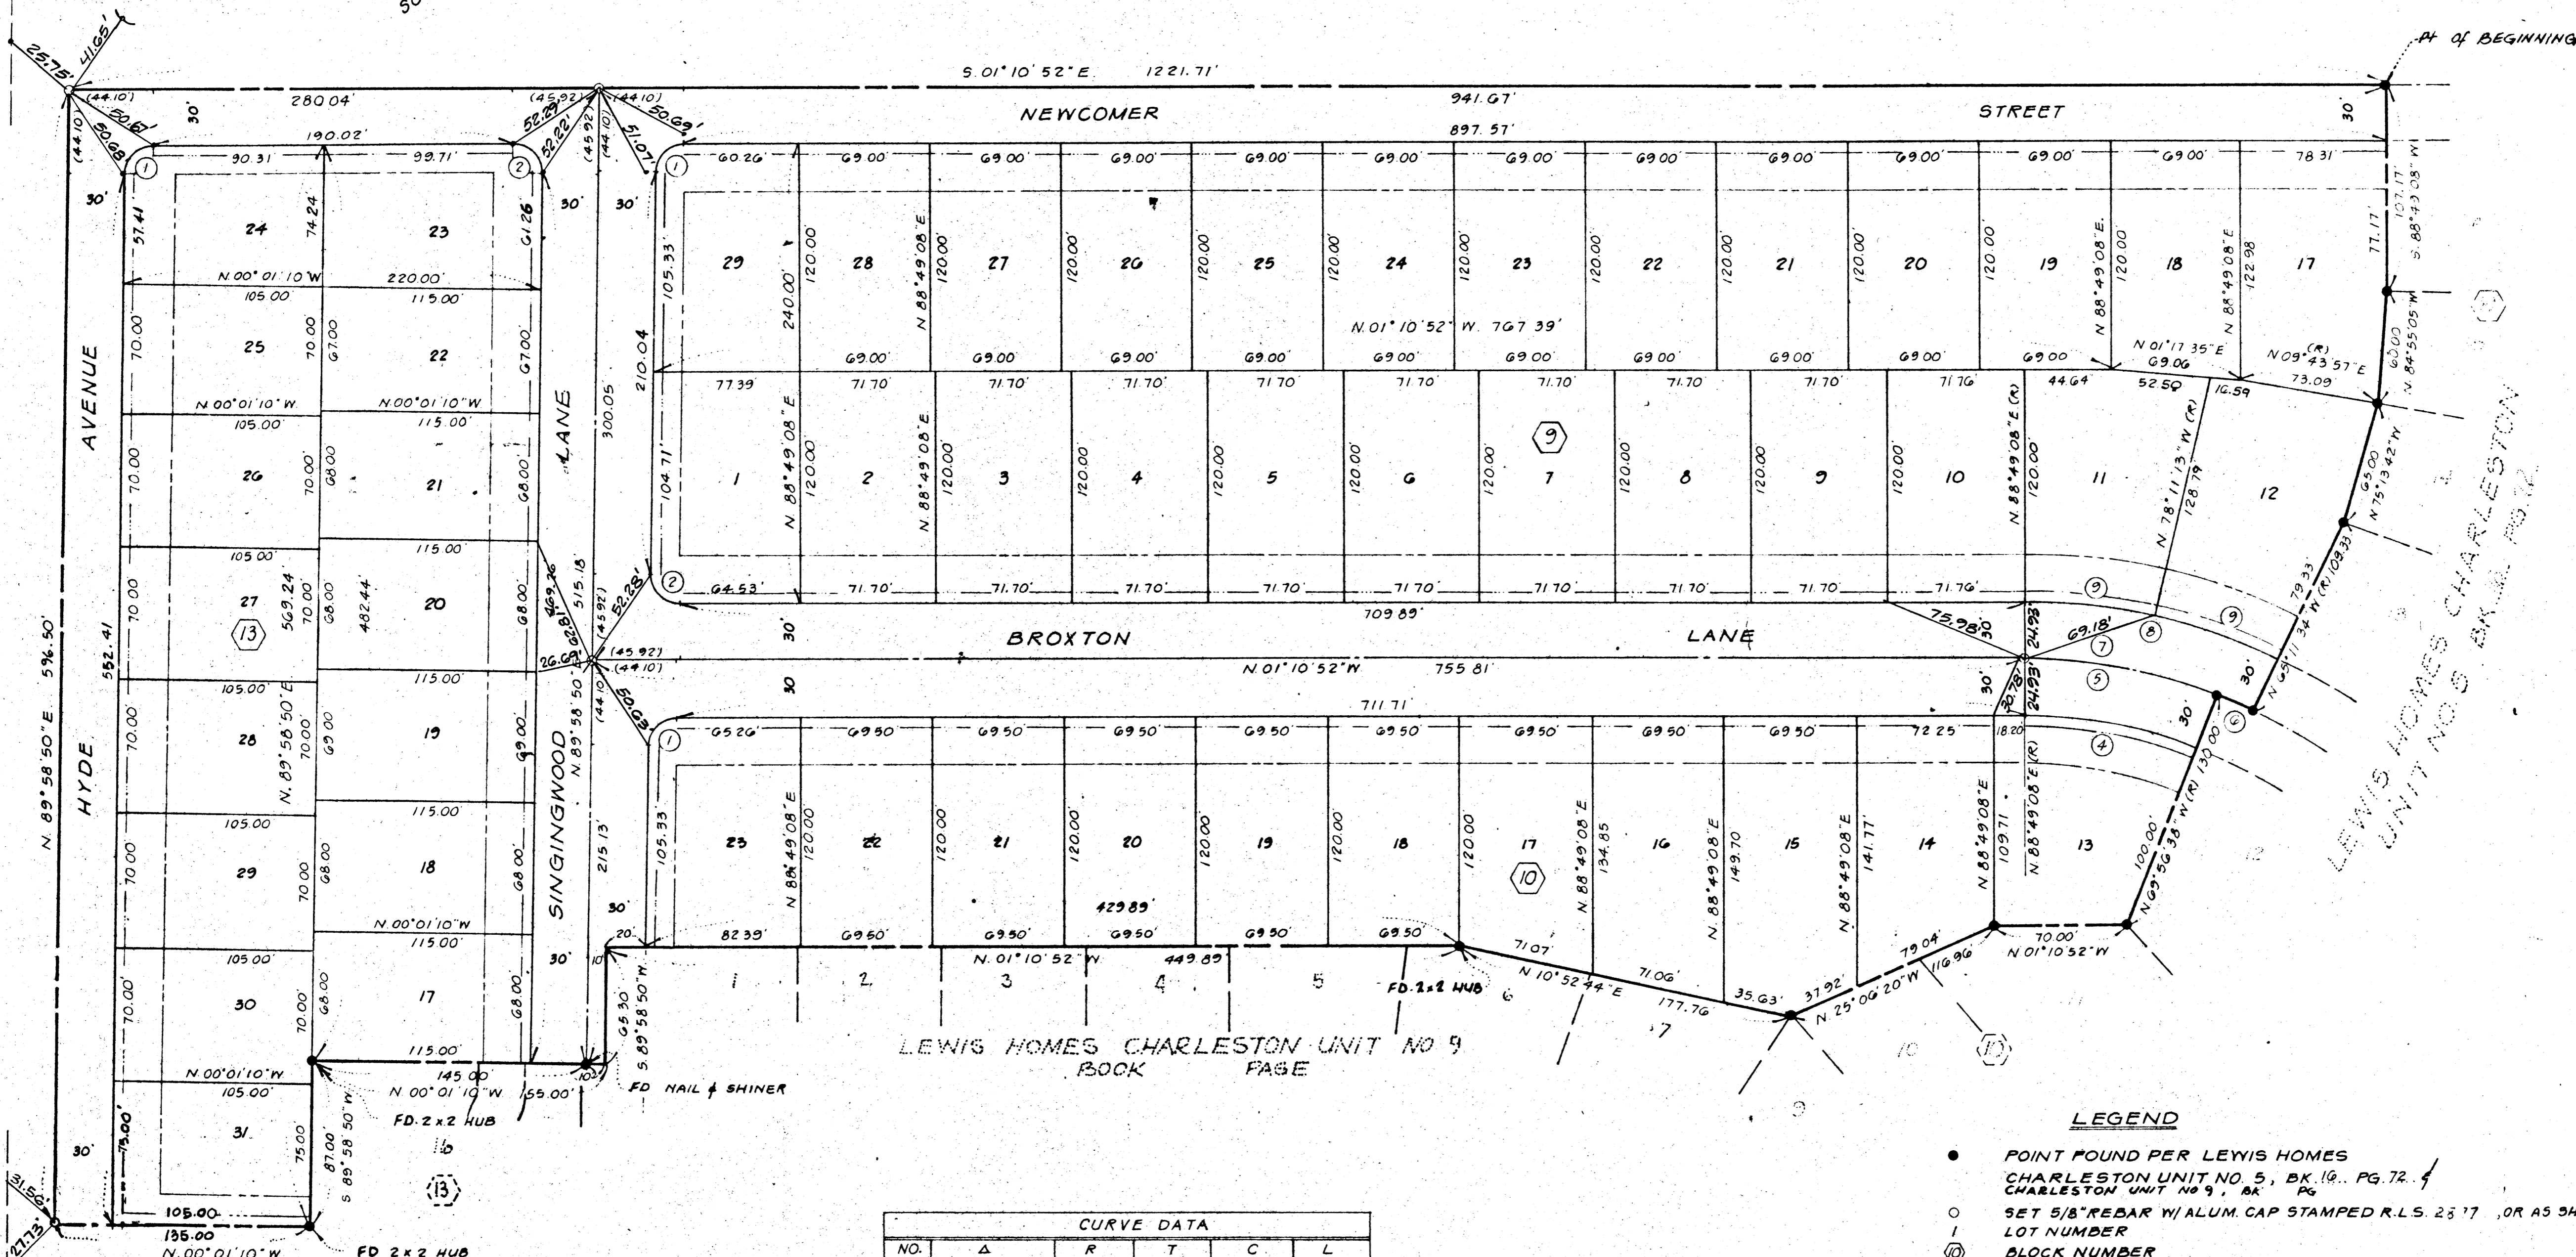


& TIE SHEET FOR
LEWIS HOMES - CHARLESTON UNIT NO. 8

BEING A SUBDIVISION WITHIN A PORTION OF
 THE N.W. 1/4 OF SEC. 35, T.20S., R.60E., M.D.M.
 CITY OF LAS VEGAS, CLARK COUNTY, NEVADA

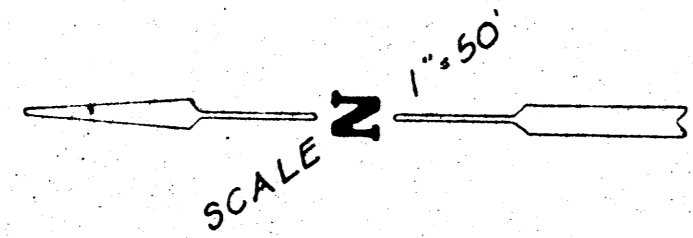

CURVE DATA					
NO.	Δ	R	T	C	L
1	88° 50' 18"	15.00'	14.70'	21.00'	23.26'
2	91° 09' 42"	15.00'	15.31'	21.43'	23.87'
4	21° 14' 14"	243.00'	45.56'	89.56'	90.07'
5	21° 14' 14"	273.00'	51.18'	100.61'	101.19'
6	04° 45' 04"	273.00'	11.33'	22.63'	22.64'
7	25° 59' 18"	273.00'	63.00'	122.77'	123.83'
8	25° 59' 18"	303.00'	69.92'	136.26'	137.44'
9	12° 59' 39"	303.00'	34.51'	68.57'	68.72'

- LEGEND**
- POINT FOUND PER LEWIS HOMES CHARLESTON UNIT NO. 5, BK. 19, PG. 72 & CHARLESTON UNIT NO. 9, BK. 19, PG. 73
 - SET 5/8" REBAR W/ ALUM. CAP STAMPED R.L.S. 23 17, OR AS SHOWN
 - ① LOT NUMBER
 - ② BLOCK NUMBER
 - ③ BLDG. SETBACK LINE
 - ④ 25' FRONT YARD, 15' SIDE YARD
 - ⑤ ABUTTING R/W
 - ⑥ 5' UTILITY EASEMENT IN BACK OF AND ABUTTING ALL R/W LINES
 - ⑦ CURVE DATA NUMBER

NOTES

3' UTILITY EASEMENT ON EACH SIDE OF EACH SIDE LOT LINE NOT ABUTTING R/W

All property lines chiselled "X" top of curb.
 All B.C.'s and curb returns concrete nail in top of curb.

56-150